


Door Type C3 : Bar/ BOH Kitchen (non-escape)


GENERAL NOTE

To be read in conjunction with Schedule of Works, Door Schedule and GA plans.


DOOR 2D.19
950 X 2100
54MM THICK
RAL TBC
LOCK ACCESS CONTROL
FD30
DOOR & FRAME TO COLOUR MATCH PARTITION
CONCEALED CLOSER
NO SIGNAGE

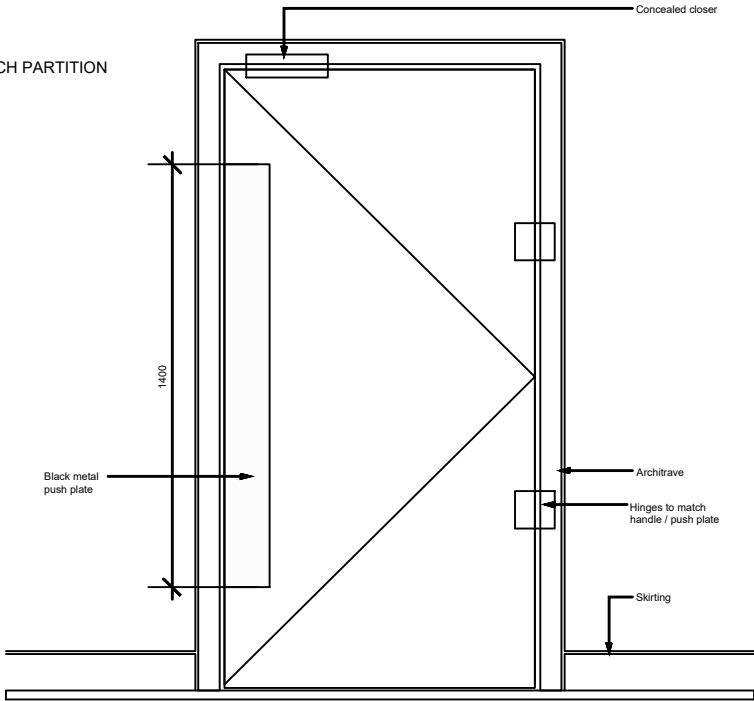

1 Type C3 : Front Elevation, Single Arrangement
1:25 @ A3

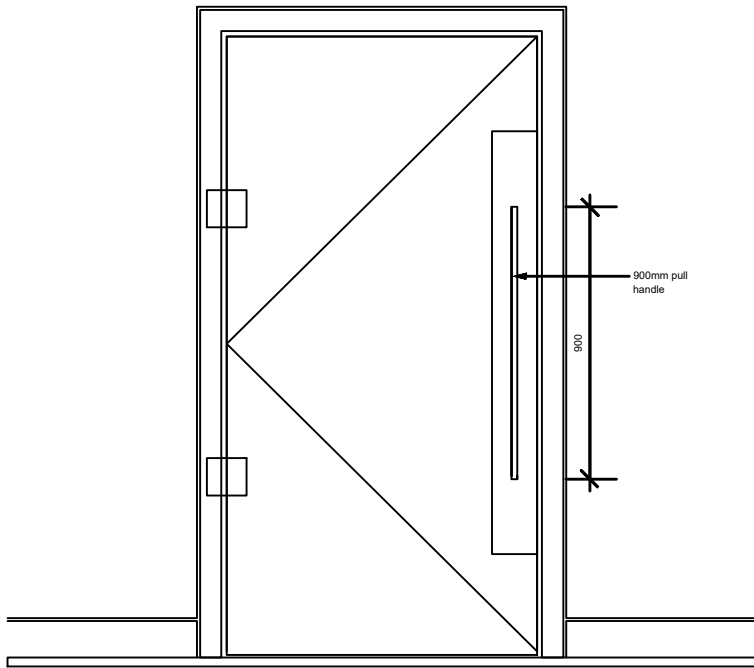

2 Type C3 : Rear Elevation, Single Arrangement
1:25 @ A3

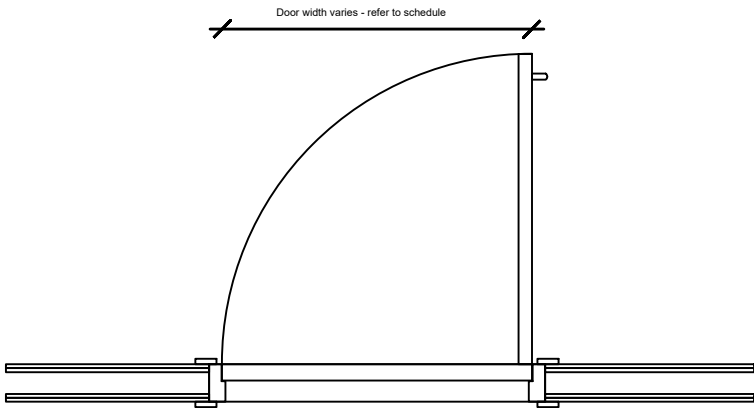

3 Type C3 : Plan, Single Arrangement
1:25 @ A3

Door Type C3 : FOH Core Door (non-escape)

Lacquered Faced Timber Door

NOTES:
54mm thick solid core door.
Black metal ironmongery
Fire rating: Refer to door schedule DP_sD

Signage Design: Refer to drawing series DP_SI

Notes:

Do not scale from this drawing. All dimensions to be checked on-site by contractor to ensure accuracy prior to any installation. All design work produced by Amspec Ltd is for indicative purposes only. It is the client and contractors responsibility to ensure that building control and fire officer approval have been met prior to commencement of site work

REV:	DESCRIPTION:	BY:	DATE:
STATUS: AS BUILT			
amspec DESIGN & BUILD SOLUTIONS 1 : 01942 621342 f : 01942 226552 www.amspec.co.uk			
CLIENT:	OBI 80 MOSLEY STREET MANCHESTER M2 3FX		
ARCHITECT:			
SITE:	18 LOWER BYROM STREET MANCHESTER		
TITLE:	BAR/ BOH KITCHEN		
SCALE AT A3: 1:25	DATE: 02.12.19	DRAWN: CR	CHECKED: MS
PROJECT NO: 1683	DRAWING NO: 02(32)401	REVISION:	