


Do not scale from this drawing. All dimensions to be checked on-site by contractor to ensure accuracy prior to any installation. All design work produced by Ampsec Ltd is for indicative purposes only. It is the client and contractors responsibility to ensure that building control and fire officer approval have been met prior to commencement of site work

Existing exposed brickwork walls are to be left as existing and unfinished.

Contractor to verify that existing partitions and doors achieve the required fire rating. Refer to Fire Engineer's fire strategy plans. If they do not comply with the requirements, an allowance for demolition and replacement of affected partitions/doors should be included in the tender.

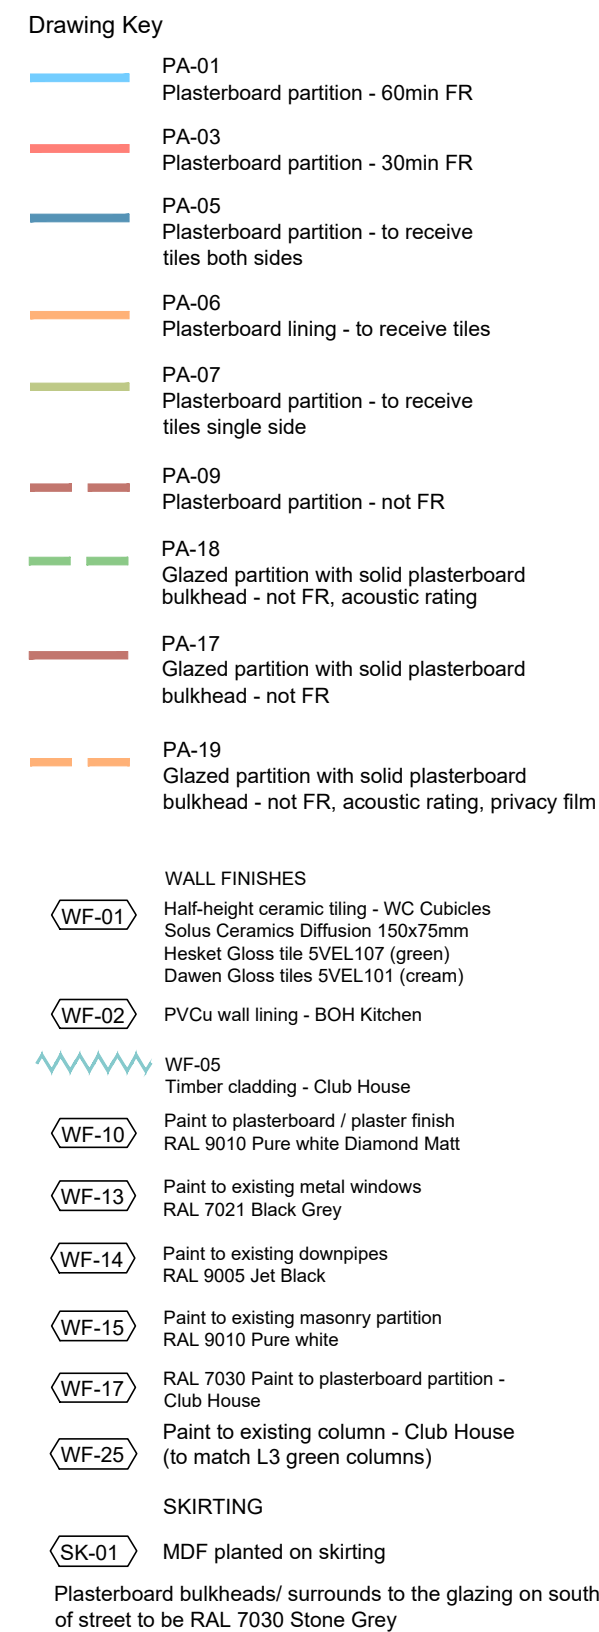

REV:	DESCRIPTION:	BY:	DATE:
STATUS:		AS BUILT	
 			
DESIGN & BUILD SOLUTIONS			
t: 01942 421342 f: 01942 226552			
www.amspec.co.uk			
CUSTOMER:	OBI 80 MOSELEY STREET MANCHESTER M2 3FX		
ARCHITECT:			
SITE:	18 LOWER BYROM STREET MANCHESTER		
TITLE:	LEVEL 2 PARTITIONS & WALL FINISHES		
SCALE: AT A1:	DATE:	DRAWN:	CHECKED:
1:100	28.10.19	CR	MS
PROJECT NO:	DRAWING NO:	REVISION:	
1683	02(42)130		