



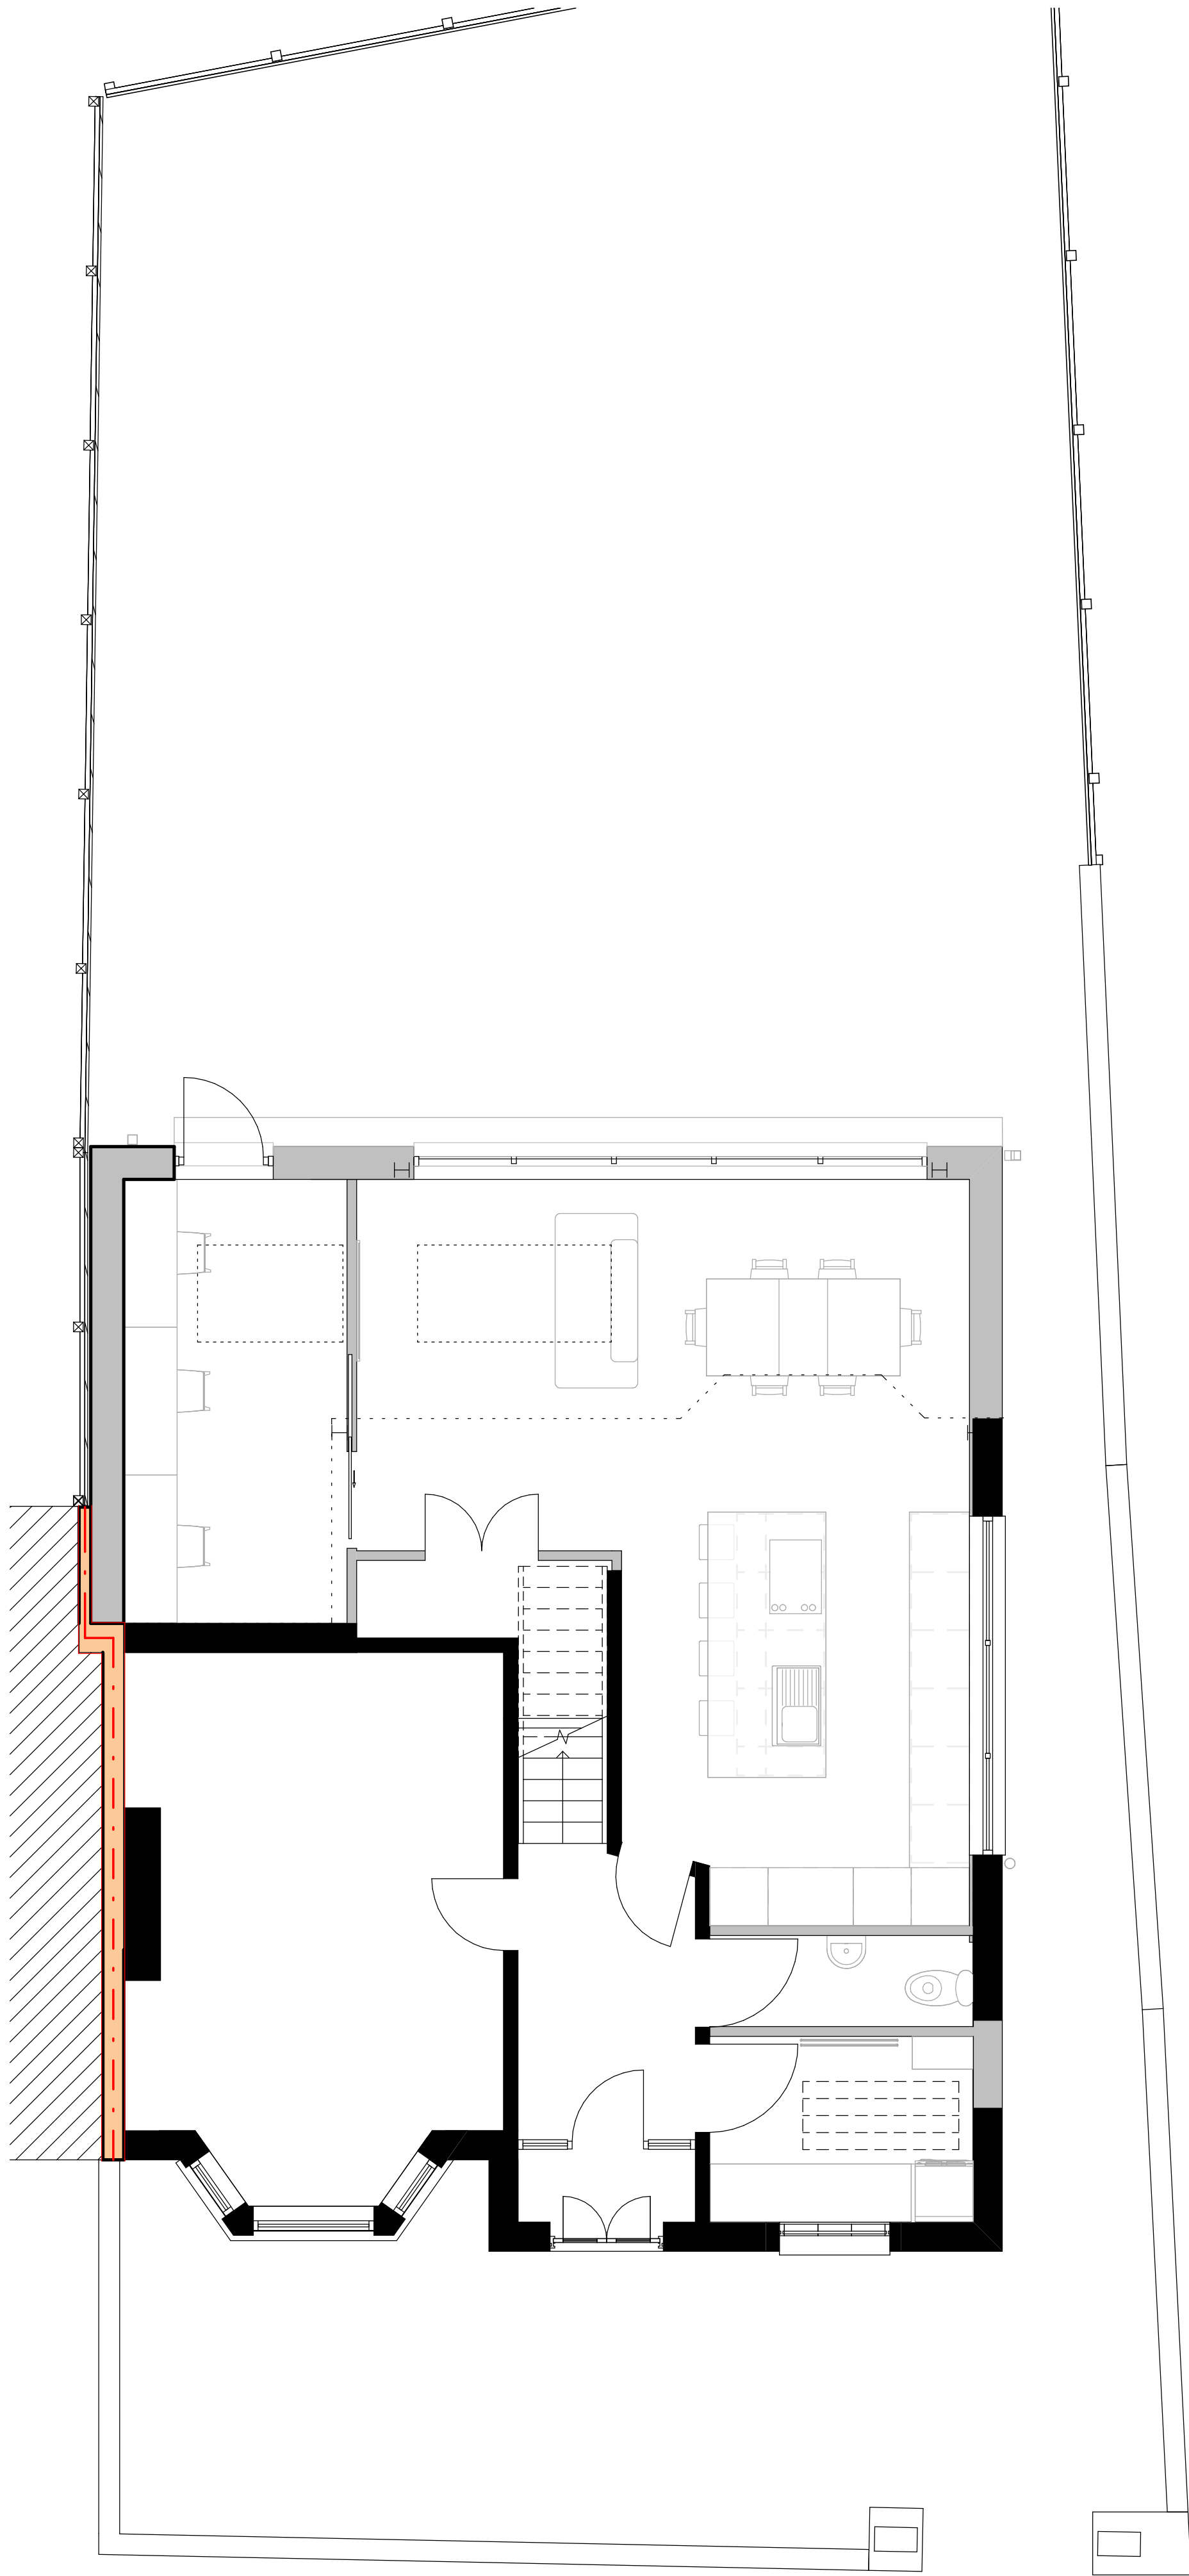


FLOOR PLANS - GROUND FLOOR

1 : 50

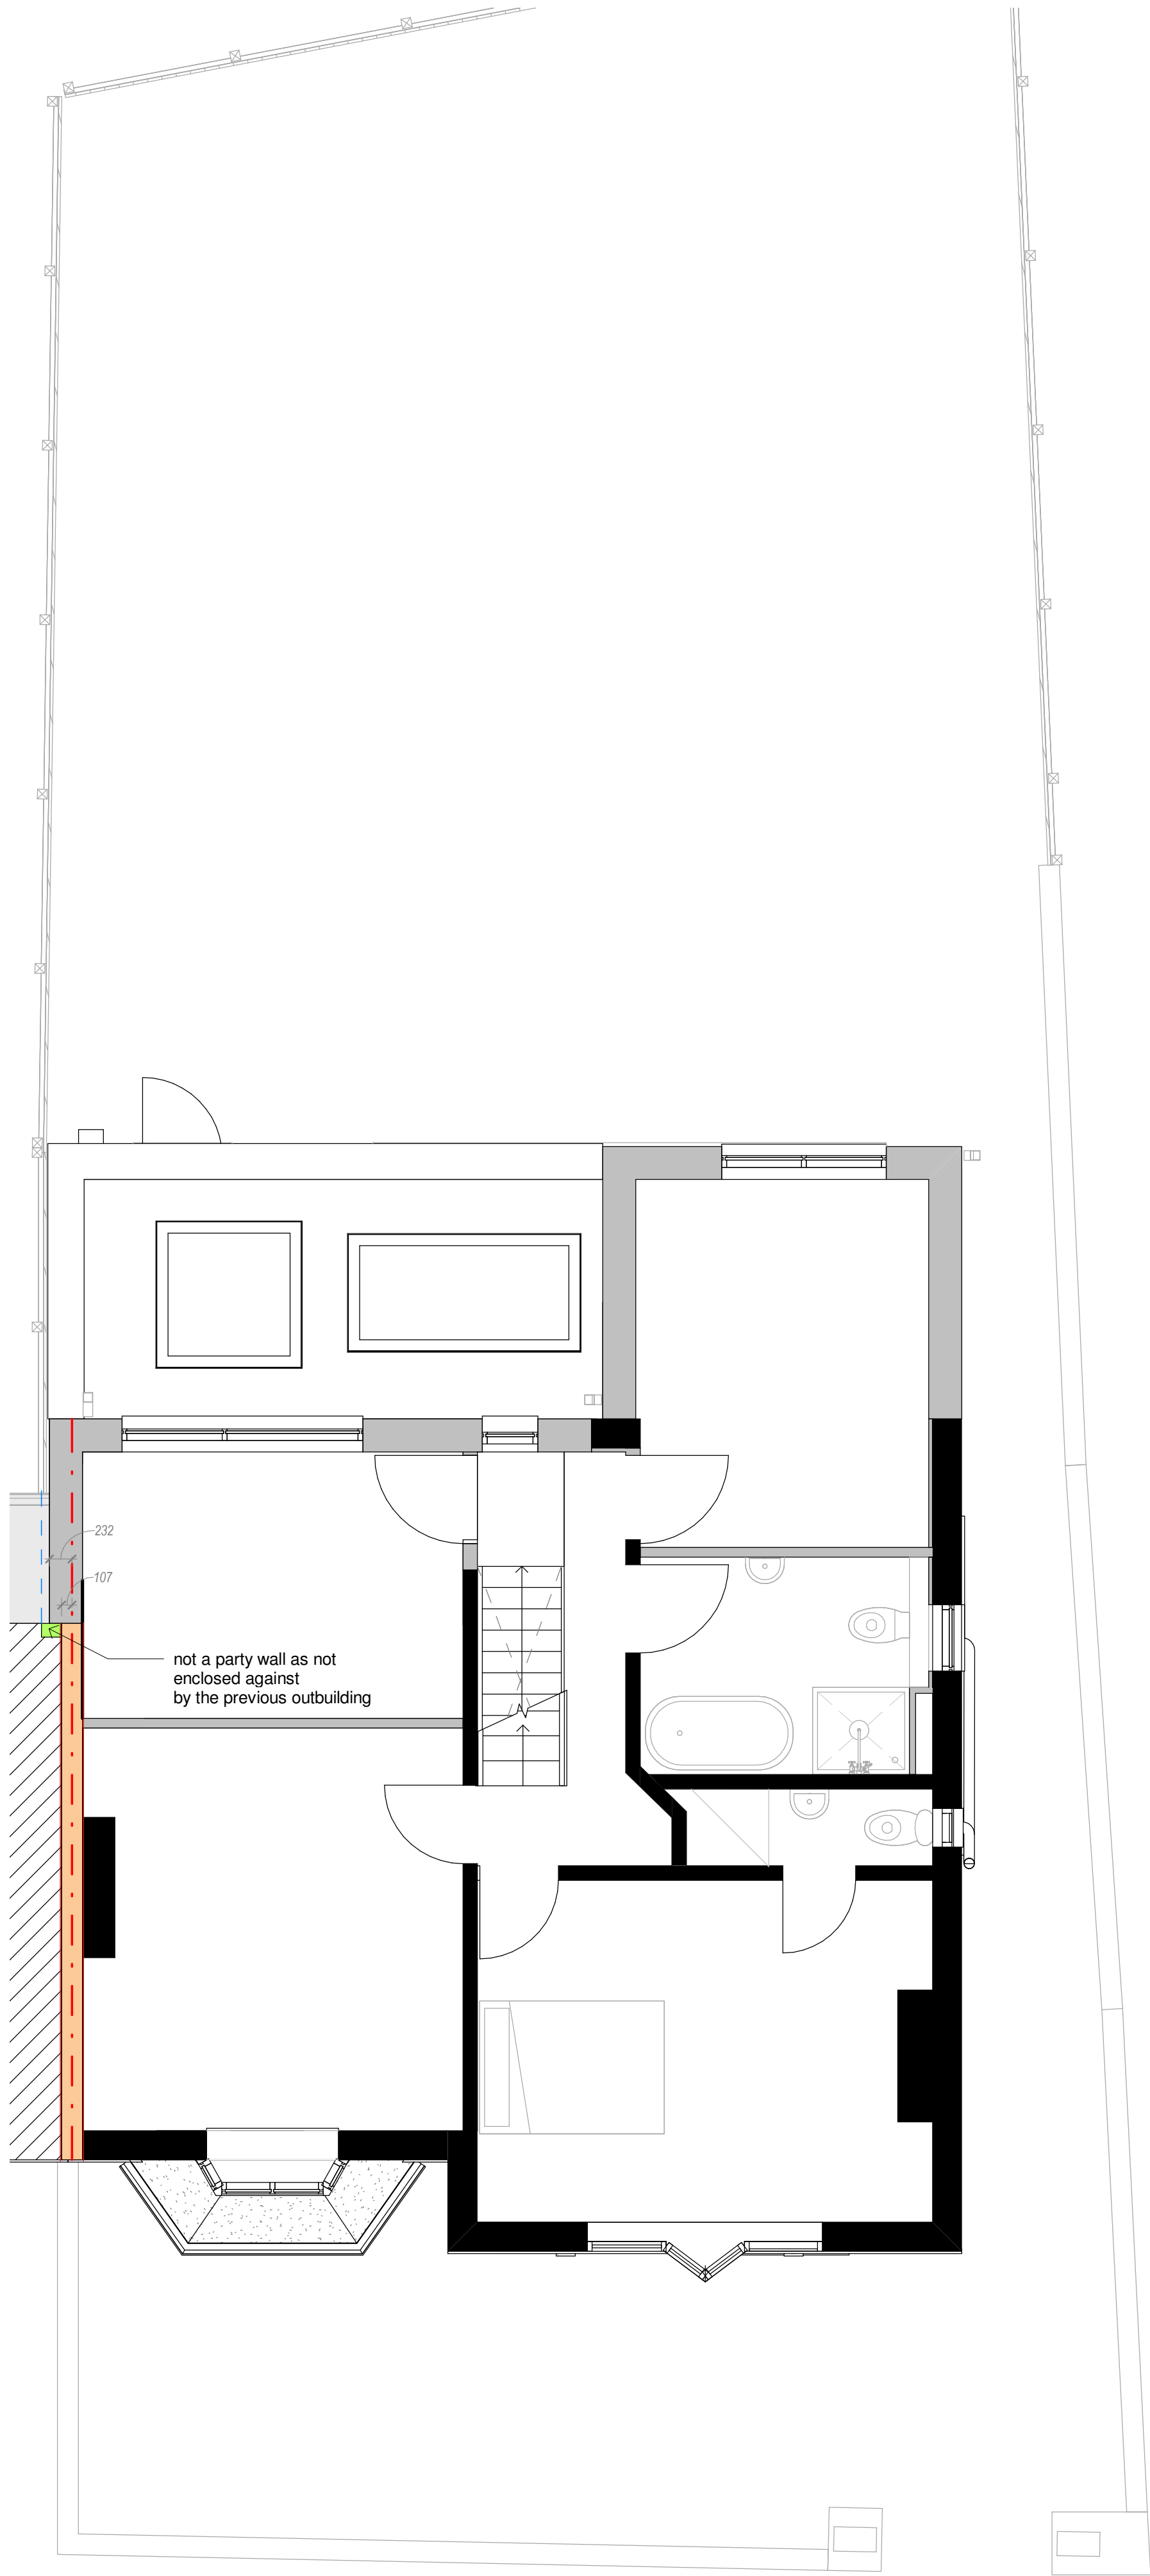


FLOOR PLANS - FIRST FLOOR

1 : 50

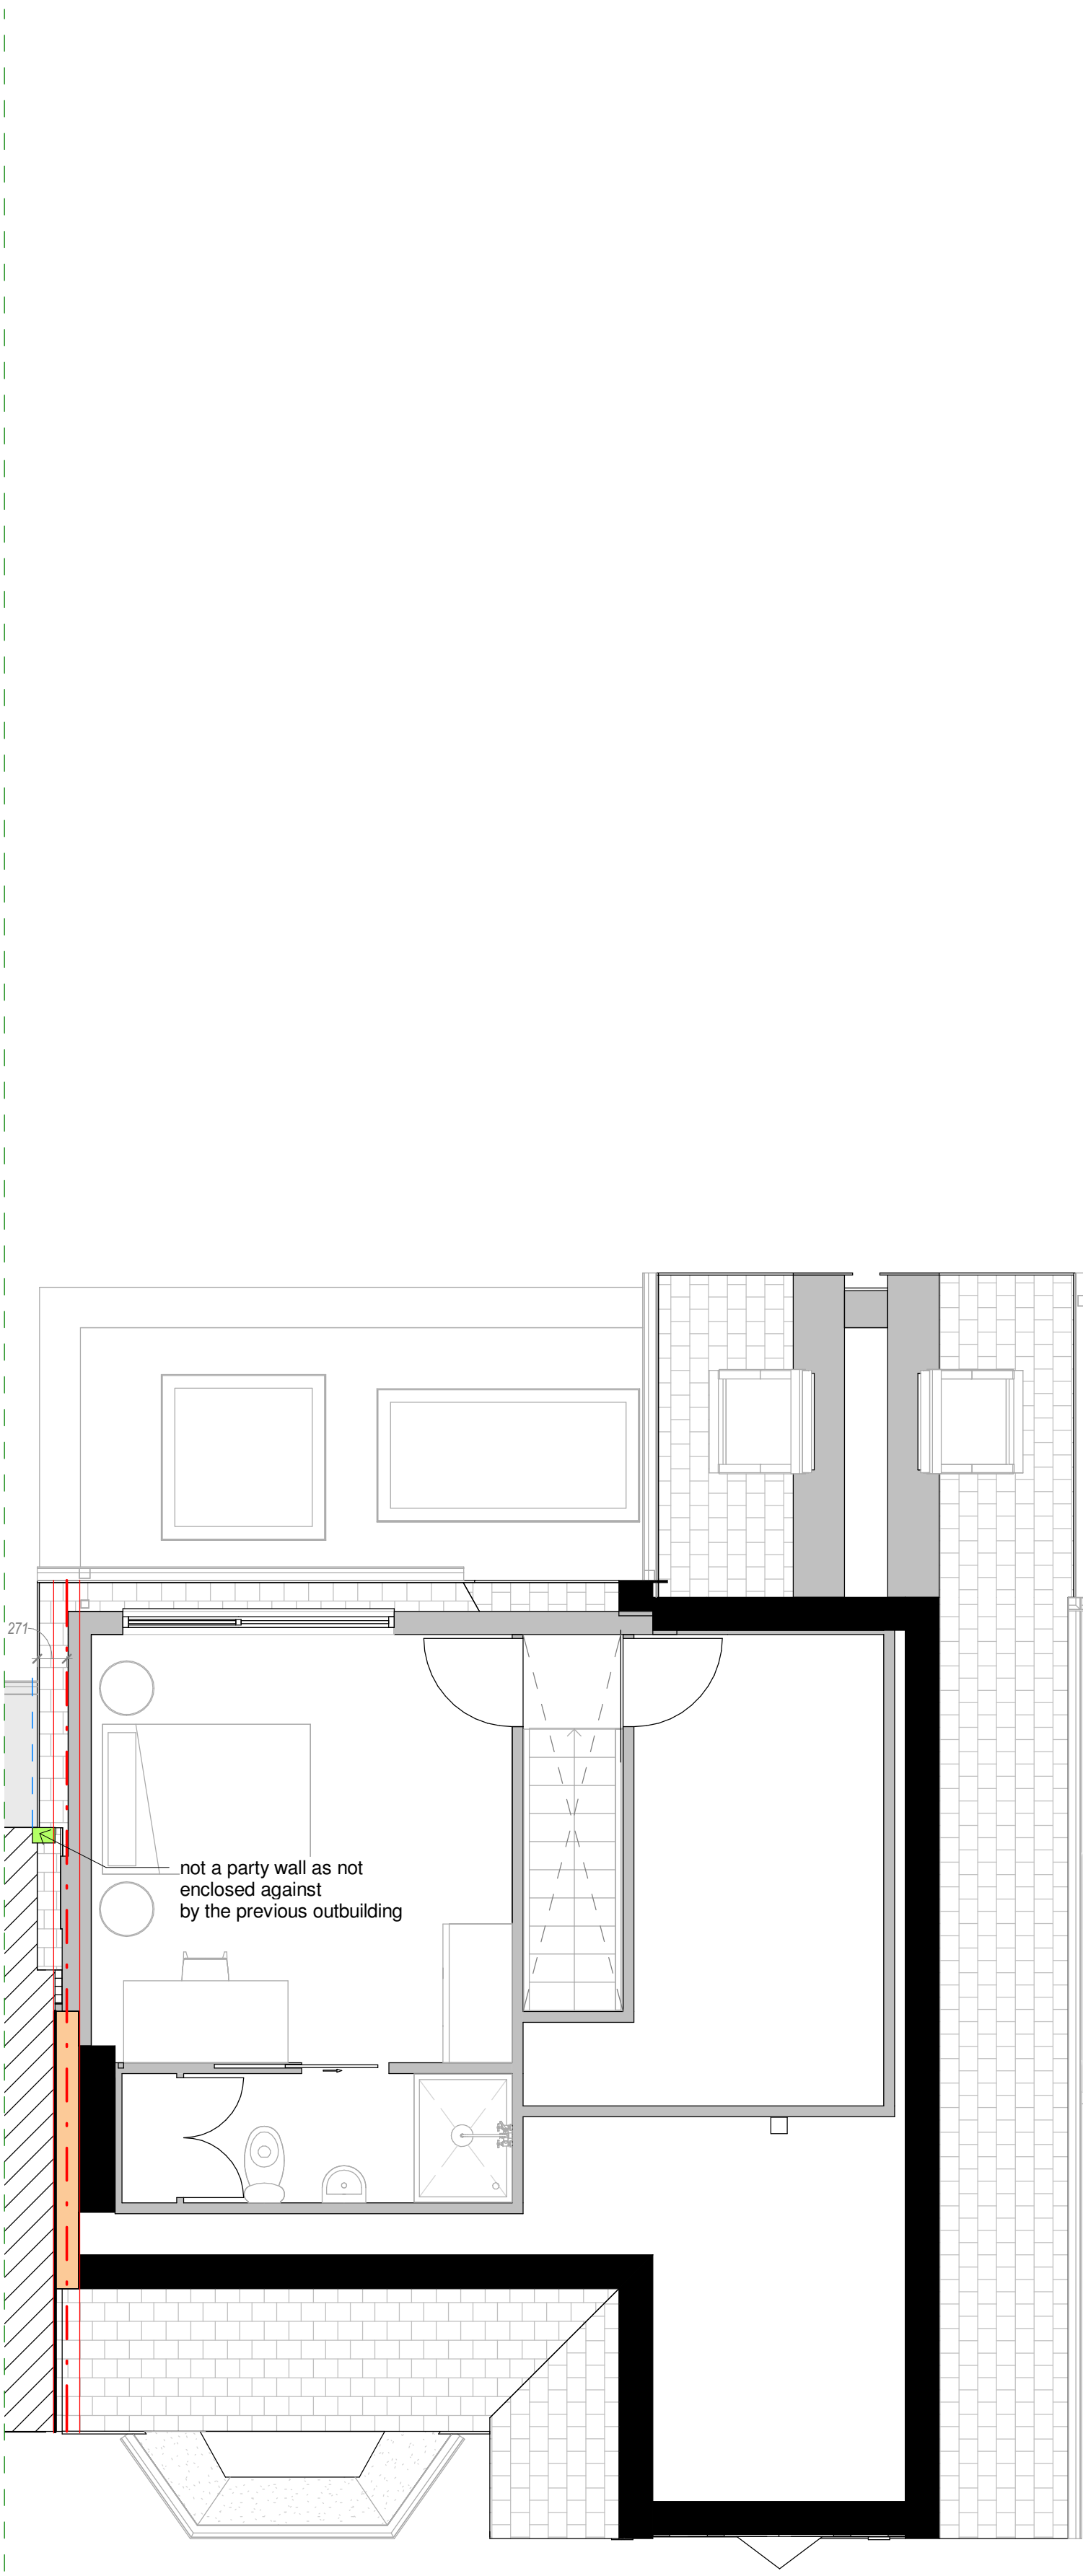

FLOOR PLANS - ATTIC

1 : 50

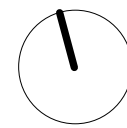

Location Plan

North Point

The contractor must verify all dimensions on site before commencing any work or fabrication drawings. If this drawing exceeds the quantities taken in any way GTA North are to be informed before the work is initiated. Only figured dimensions are to be taken from this drawing. Do not scale off this drawing. Drawings are based on Ordnance Survey and / or existing record drawings - design and drawing content is subject to detailed Site Survey, Structural Survey, Site Investigations, Planning and Statutory Requirements and Approvals. Authorised reproduction from Ordnance Survey Map with permission of the Controller of Her Majesty's Stationery Office. Crown Copyright reserved. GTA North Limited Copyright. Guy Taylor Associates is a trading name of GTA North Limited.

Drawing Notes:

RED LINE DENOTES OUTSIDE FACE OF PARTY WALL

DASHED RED LINE DENOTES CENTRE LINE OF PARTY WALL JUNCTION

DASHED BLUE LINE DENOTES LINE OF JUNCTION AS PER THE GROUND FLOOR

Rev:	Description:	Revised By:	Issue Date:
R02	LINE OF JUNCTION	CR	20/05/2022
R03	LINE OF JUNCTION	CR	25/05/2022

Project:
2 GLENCROSS AV,
CHORLTON,
M21 9NF

Drawing Title:
FLOOR PLANS

Scale: 1 : 50@A1	Original Issue Date:
Original Drawn By: CR	Original Checked by: CR

Drawing Number: 20-0010-99-901	Revision: R03
-----------------------------------	------------------

Reason For Issue:

LINE OF JUNCTION

Trafalgar House
5-7 High Lane, Chorlton, Manchester M21 9DU
T: 0161 826 1042 M: 07914 402 101
manchester@guytaylorassociates.co.uk
www.guytaylorassociates.co.uk

GUY
TAYLOR
ASSOCIATES