


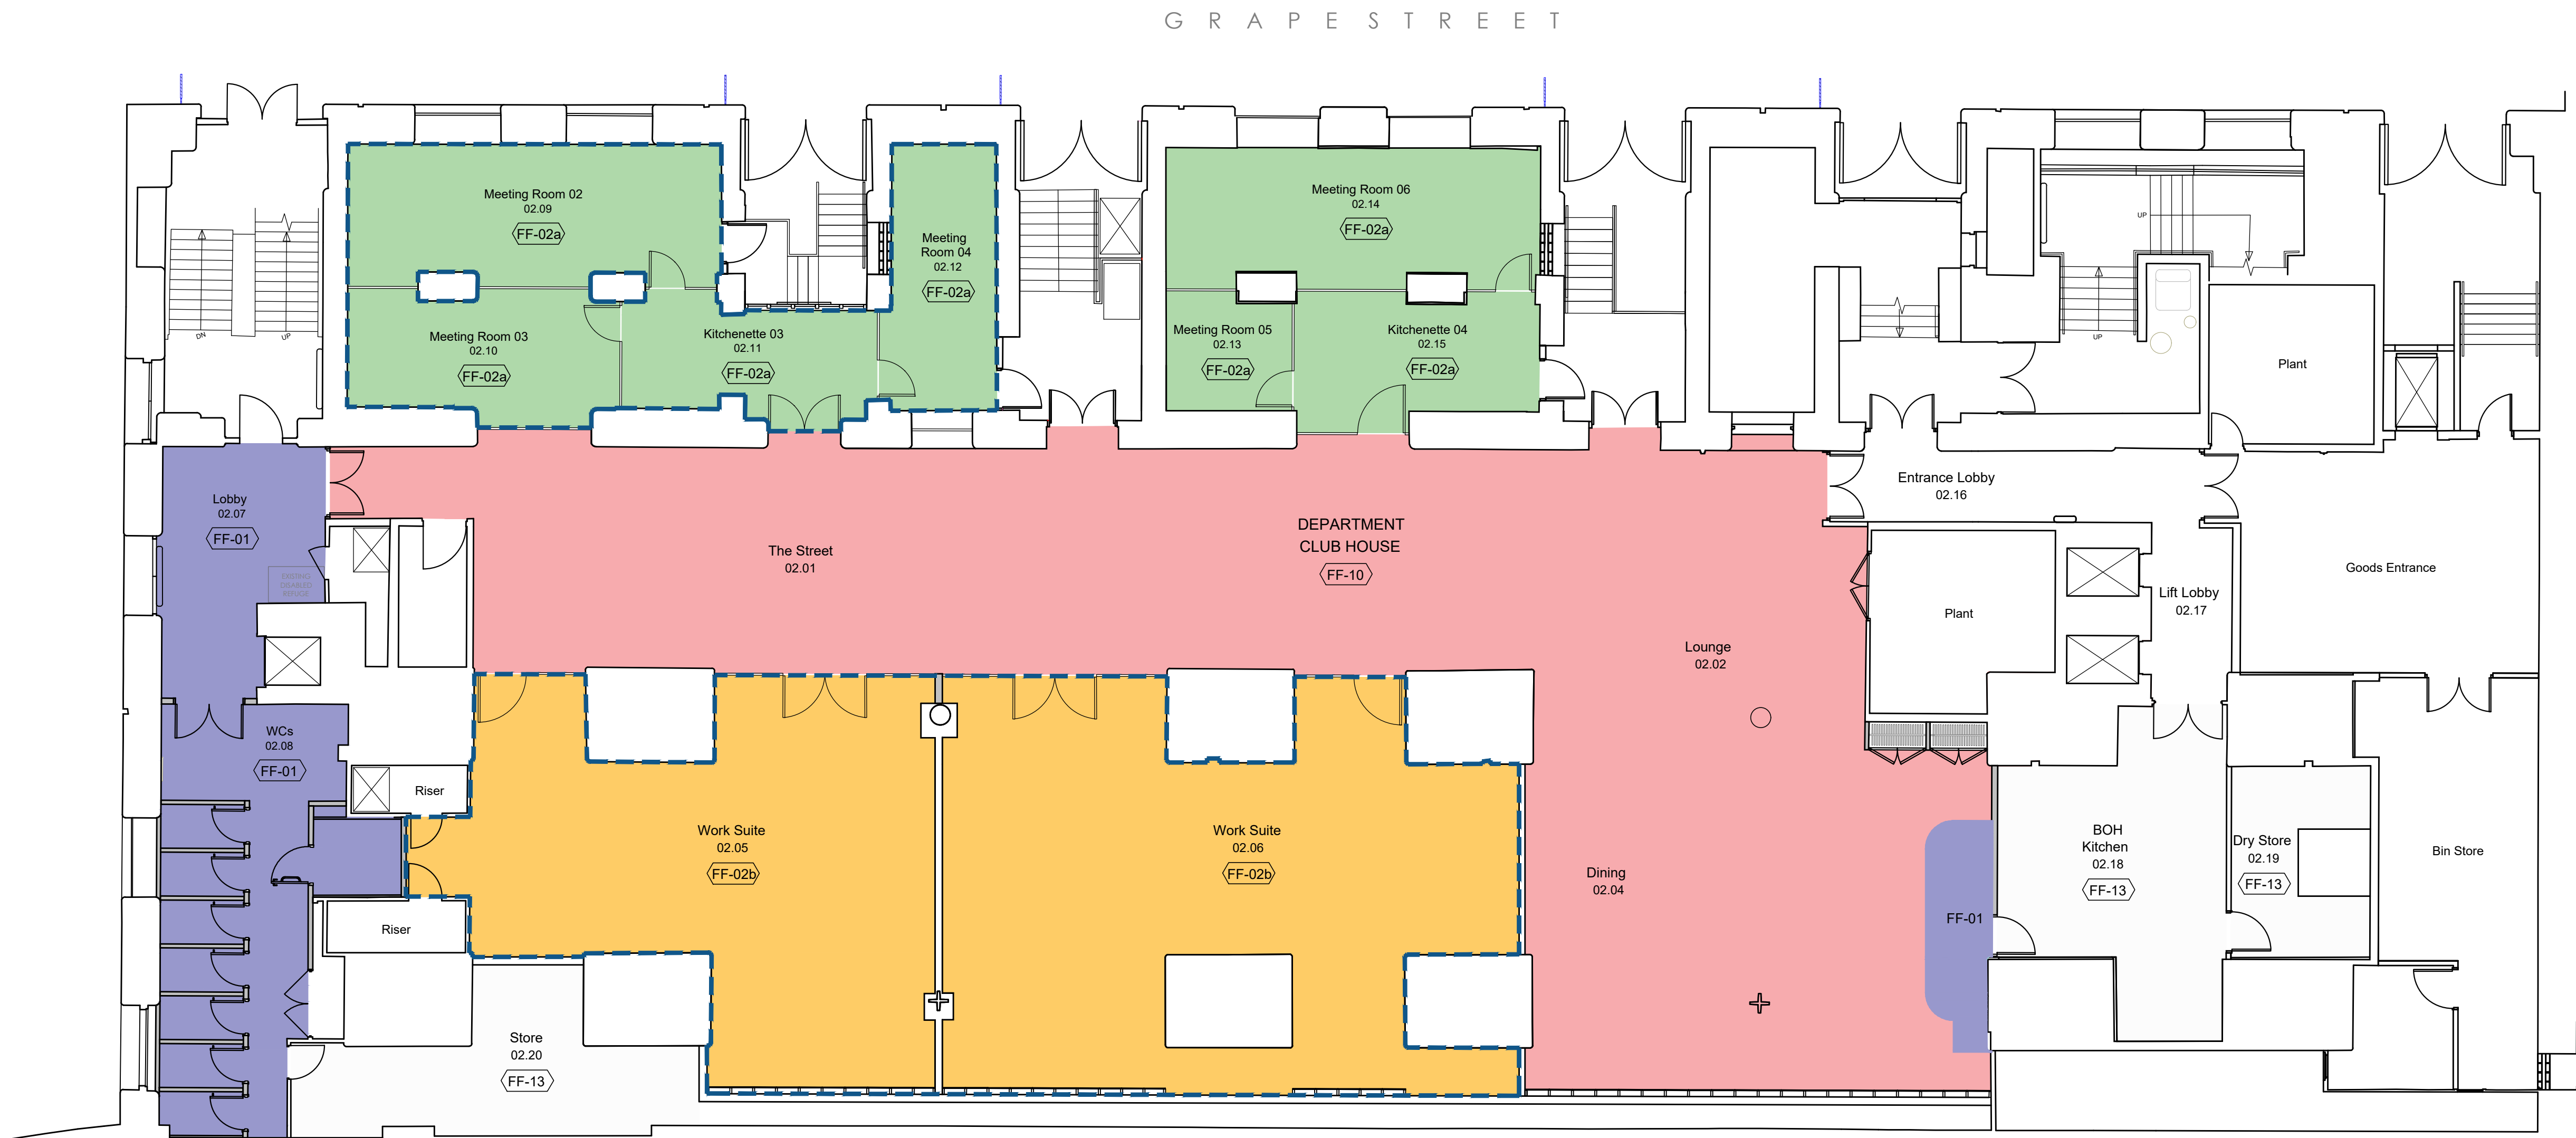

Notes:

Do not scale from this drawing. All dimensions to be checked on-site by contractor to ensure accuracy prior to any installation. All design work produced by Amspec Ltd is for indicative purposes only. It is the client and contractors responsibility to ensure that building control and fire officer approval have been met prior to commencement of site work.

Drawing Key

- FF-01 Vinyl flooring - WC / WC Lobby / Bar / Coffee Counter - Altro Loam SU2047 Suprema
- FF-02a Rubber floor tiles - Meeting rooms, work suites Round Stud Tile in Aqua Green from Rubber Floor Store
- FF-02b Rubber floor tiles - Meeting rooms, work suites Norament 926 in colour 6191
- FF-10 Engineered timber - Club house Havwoods BP3880 Aspen Raw Bespoke Collection
- Extent of acoustic floor treatment
- FF-13 Anti-slip vinyl flooring - BOH Kitchen / FOH Kitchen / Counter - Altro Stronggold 30 Cannon

REV: DESCRIPTION: BY: DATE:

STATUS: AS BUILT



CLIENT: OBI
80 MOSELEY STREET
MANCHESTER
M2 3FX

ARCHITECT:

SITE: 18 LOWER BYROM STREET
MANCHESTER

TITLE: LEVEL 2
FLOOR FINISHES

SCALE: AT A1: 1:100	DATE: 28.10.19	DRAWN: CR	CHECKED: MS
PROJECT NO: 1683	DRAWING NO: 02(43)130	REVISION:	