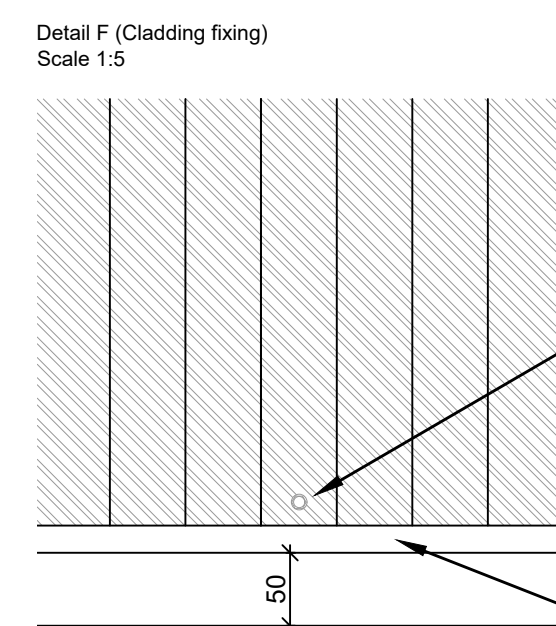
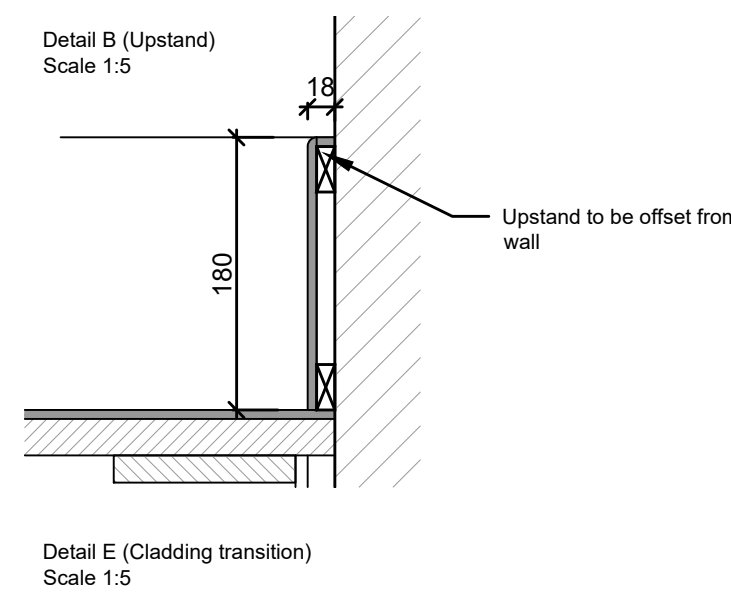
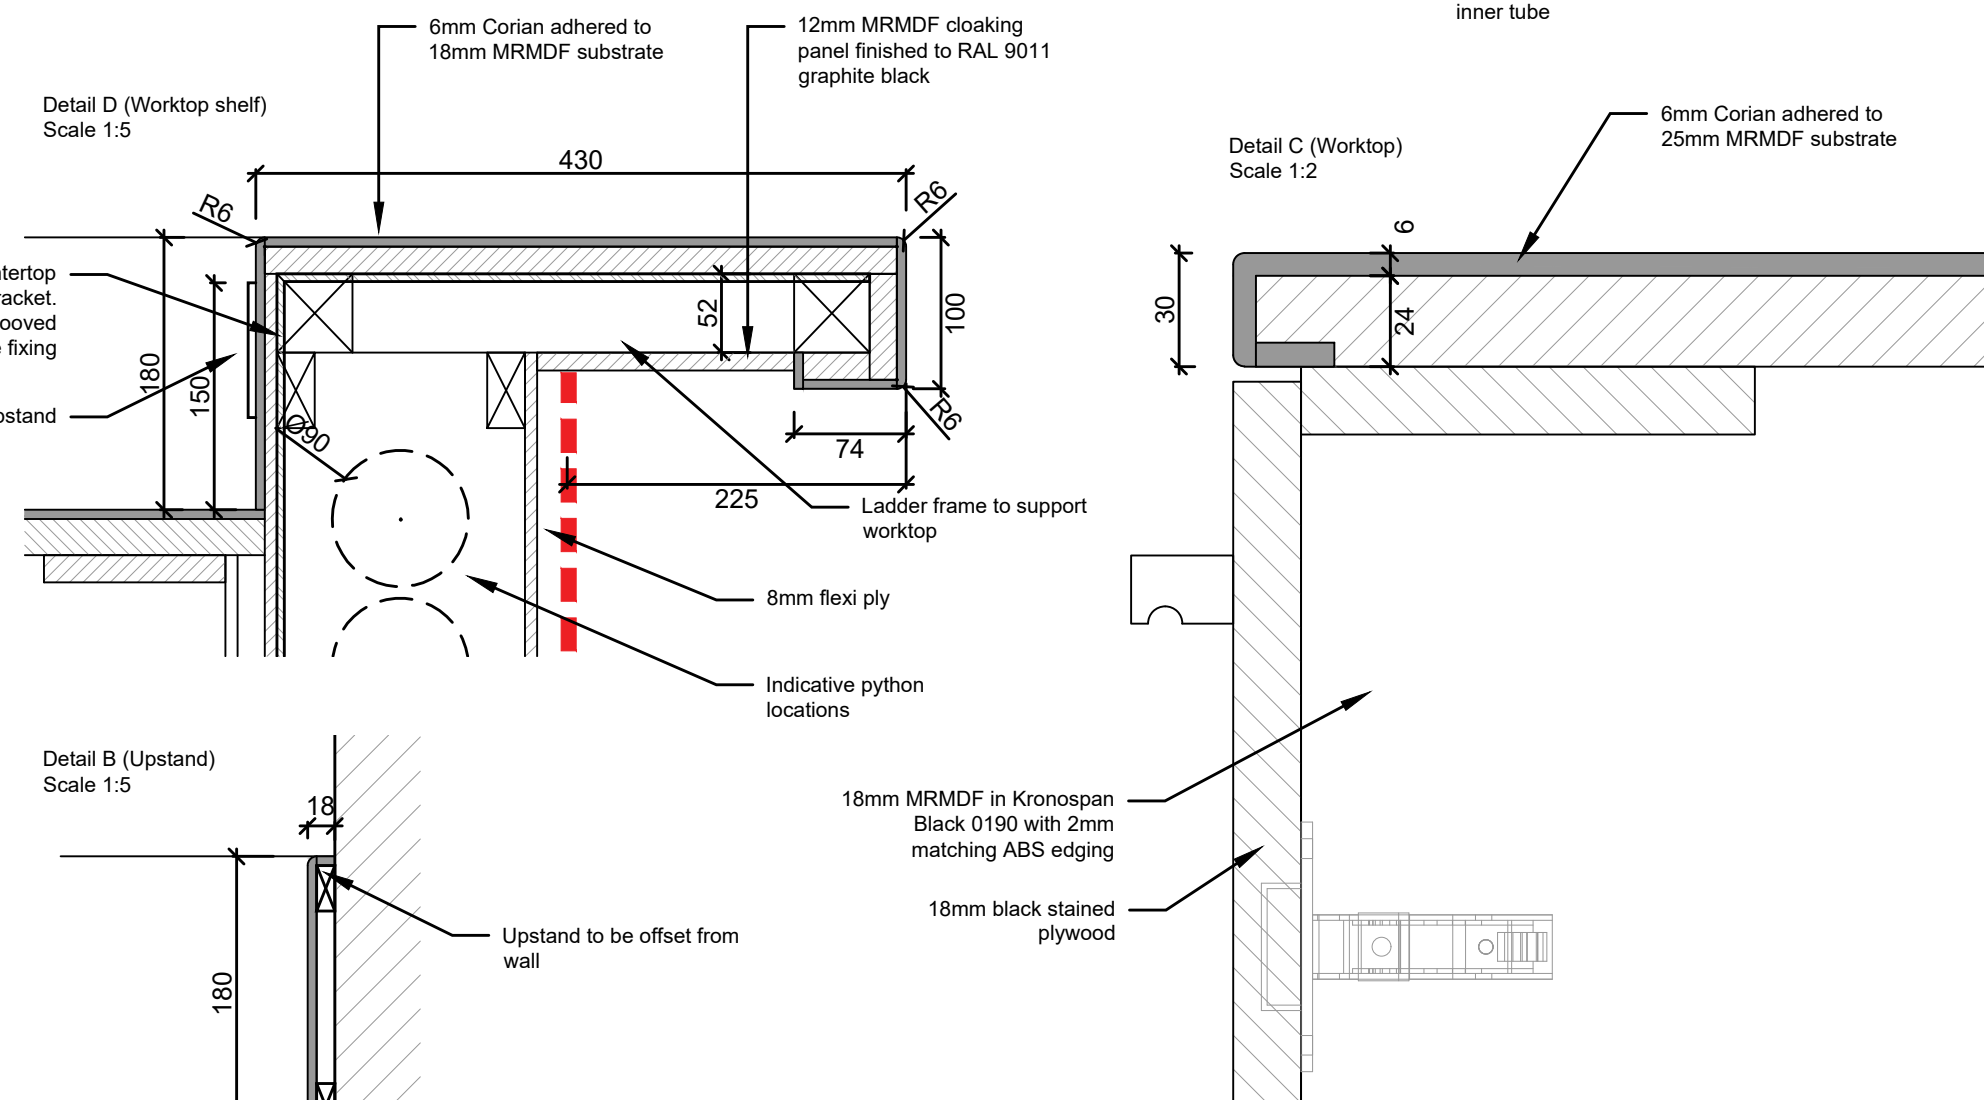
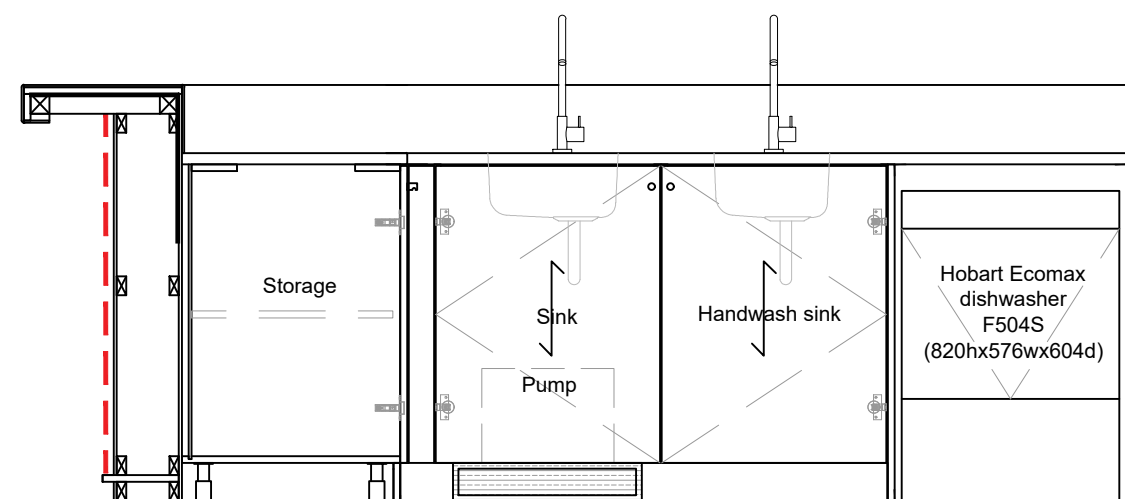
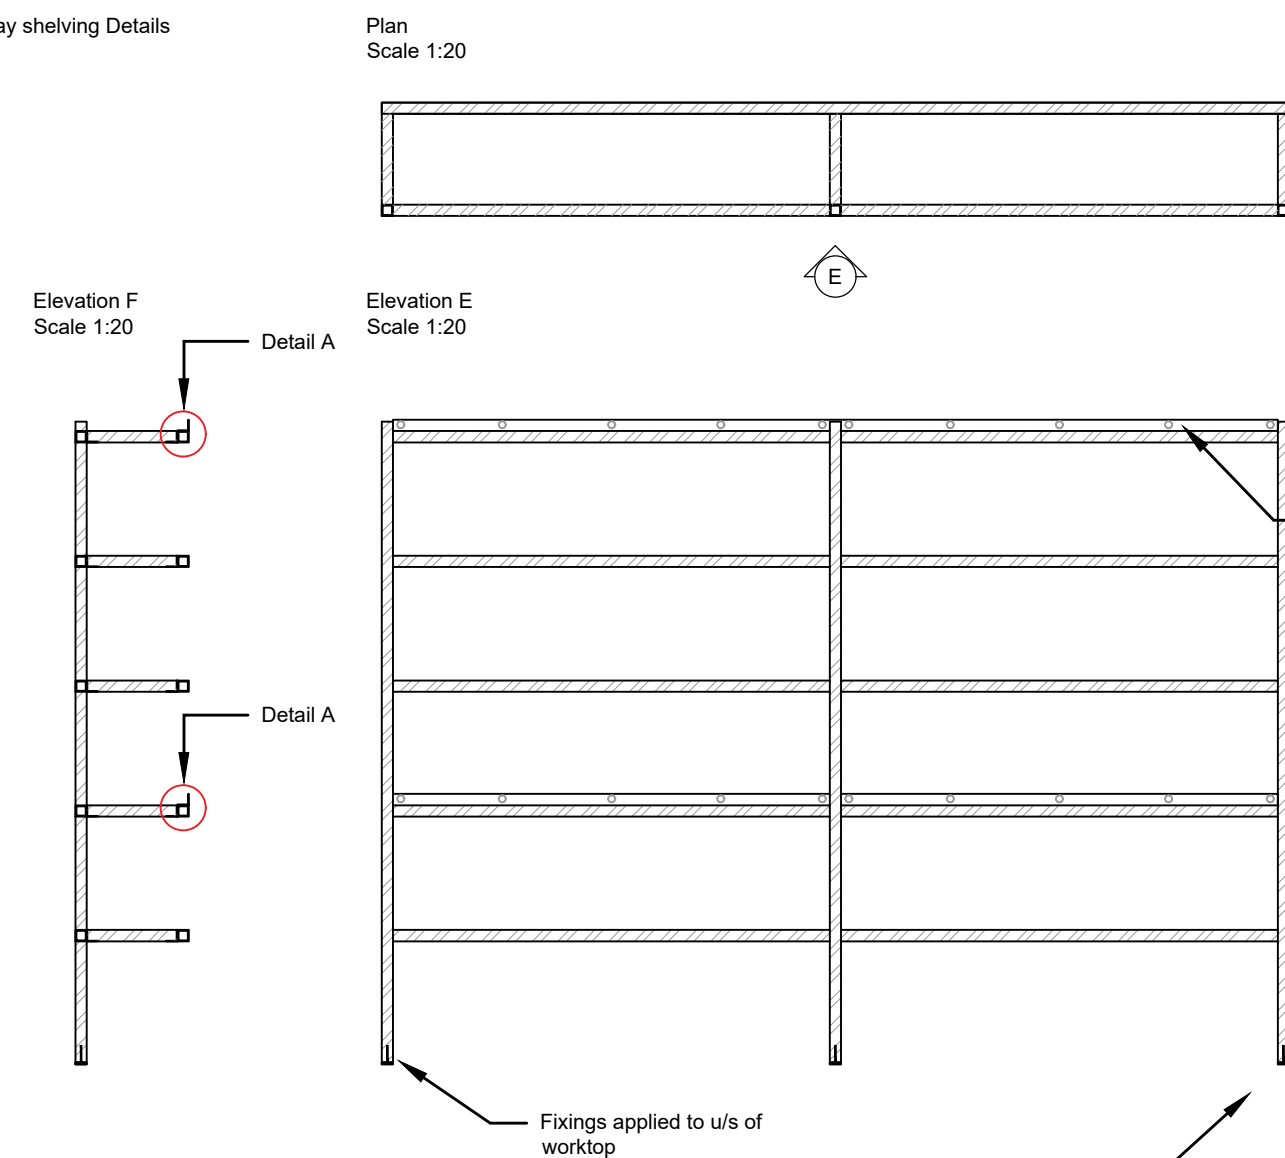
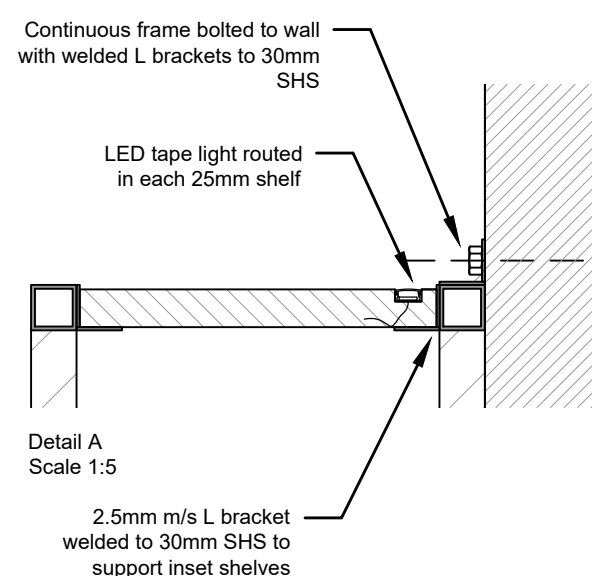
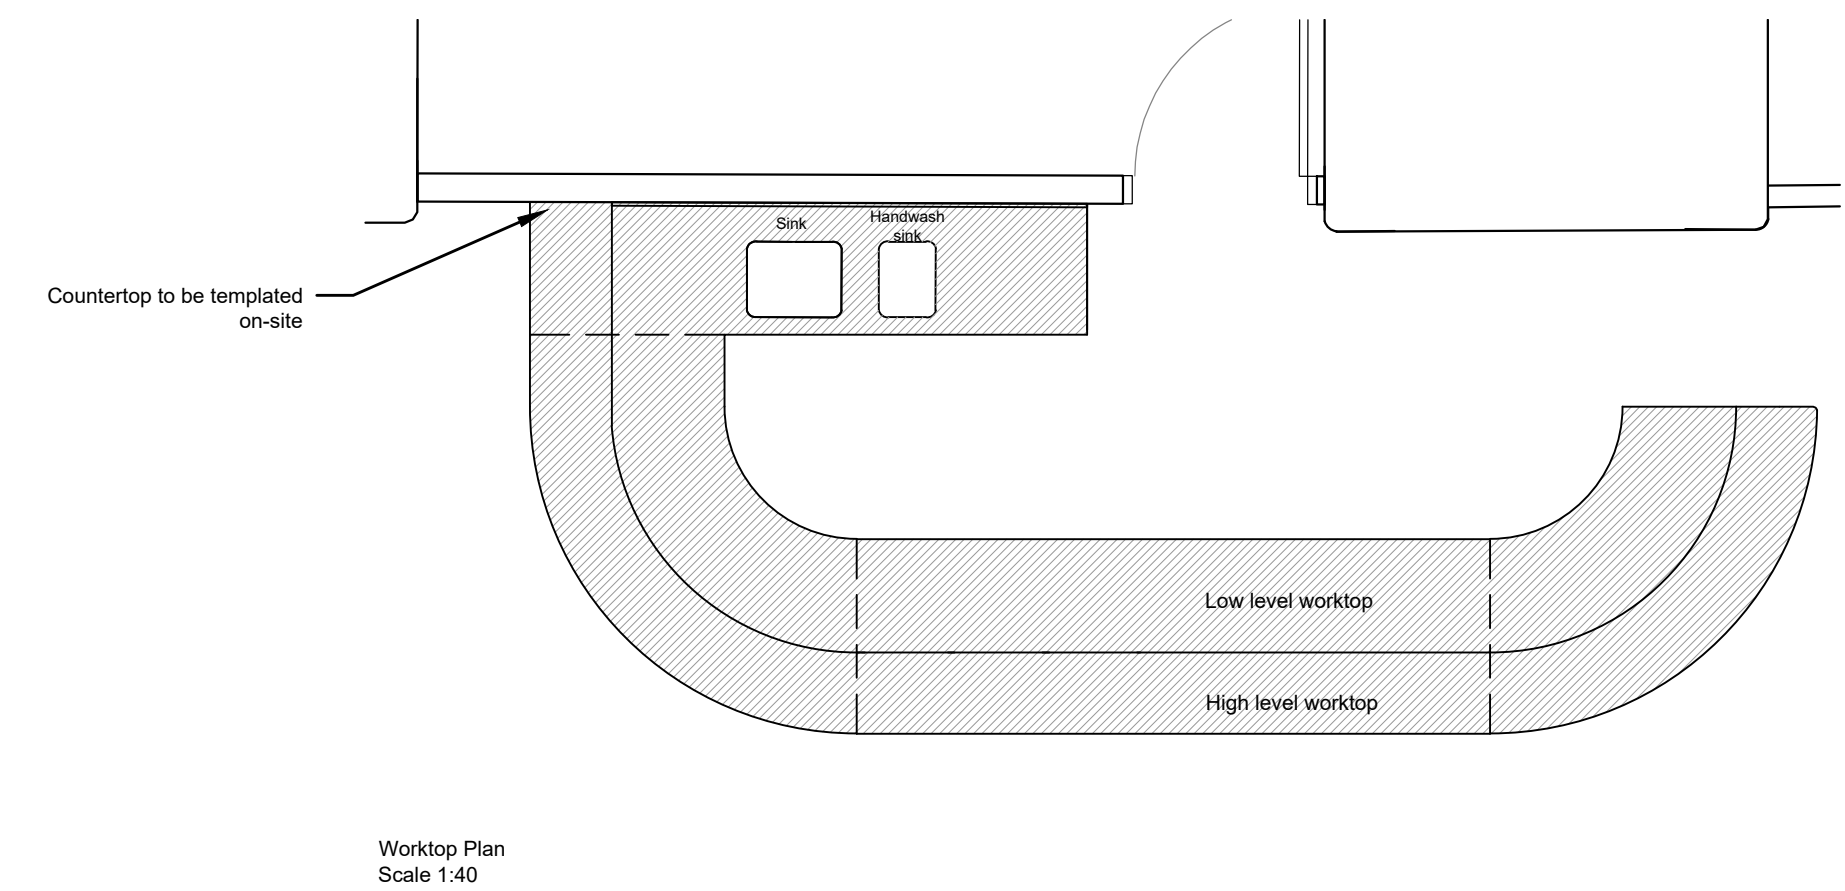


 0.5mm Corrugated metal sheet locations


Dimensions in accordance with clients DWG. Dimensions to be confirmed on-site

Client to confirm specification of appliances. Type and quantity of power outlets to be co-ordinated with services engineer

Contracts manager to check and confirm all measures on-site. Any discrepancies to be reported to the designer

Panel finishes (doors & plywood) to be provided for client approval

Client to note: Moisture resistant MDF to be used throughout bar

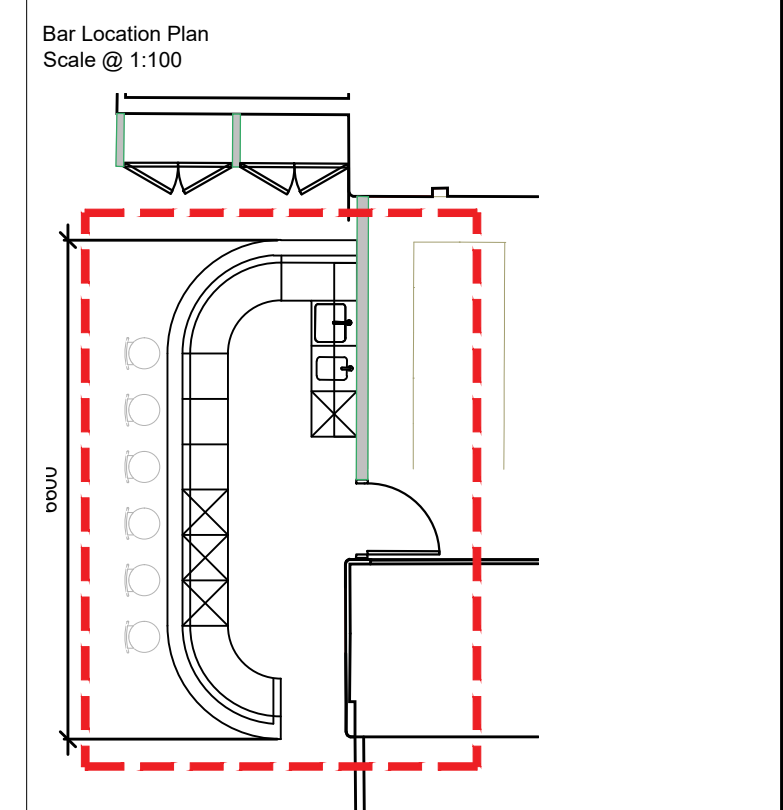

REV:	DESCRIPTION:	BY:	DATE:
STATUS: AS BUILT			
 DESIGN & BUILD SOLUTIONS			
T : 01942 421342 F : 01942 226552 www.amspec.co.uk			
CLIENT:	OBI 80 MOSLEY STREET MANCHESTER M2 3FX		
ARCHITECT:			
SITE:	18 LOWER BYROM STREET MANCHESTER		
TITLE:	LEVEL 2 BAR DETAILS		
SCALE AT A1: VARIES	DATE: 30/10/19	DRAWN: CR	CHECKED: IC
PROJECT NO: 1683	DRAWING NO: 02(71)510		REVISION: