


Door Type E8 : Internal glazed pivot doors to Suites on Level 02


GENERAL NOTE

To be read in conjunction with Schedule of Works, Door Schedule and GA plans.

DOOR 2D.01, 2D.02, 2D.03, 2D.05, 2D.08, 2D.09, 2D.10, 2D.20, 2D.45
APPROX 900 X 2800 & 1200 X 2800
SINGLE WITH GLAZED SIDE PANEL
RAL 9005
LOCK, CARD READER ACCESS CONTROL TO 2D.08, 2D.20, 2D.21, 2D.22, 2D.45
NO FIRE RATING

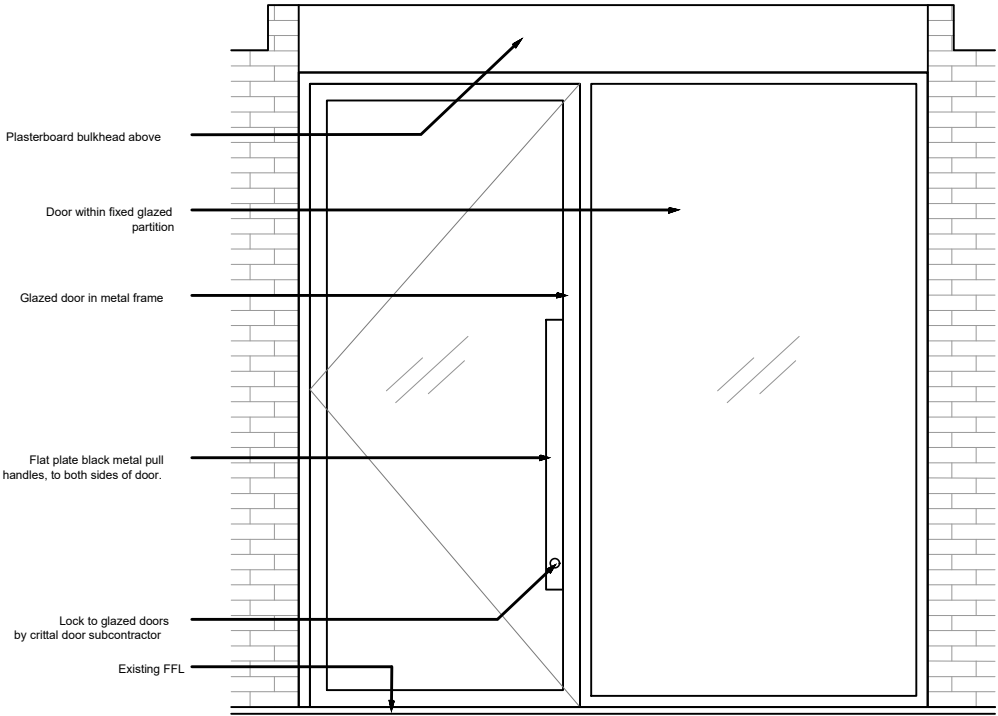

1 Type E9 : Front Elevation
1:25 @ A3

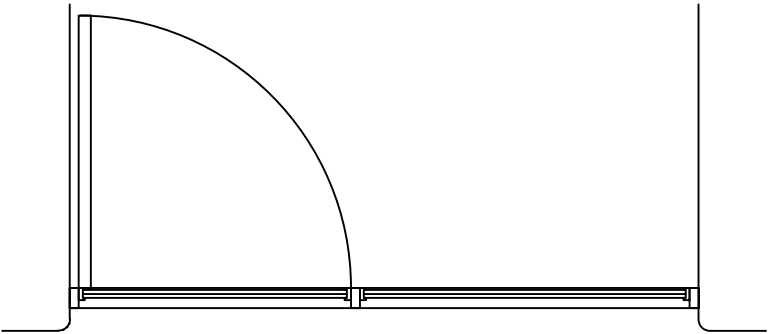

3 Type E9 : Plan
1:25 @ A3

Door Type E8 : Internal Glazed Doors within Glazed Partition

Metal glazed doors, PPC coating, RAL 9005

All ironmongery to be by specialist subcontractor

Note:

Drawing shows design intent only. Final Proposals/Layout for Crittall-Style Glazed Doors and Partitions are to be developed with the specialist subcontractor and approved by the Architect before manufacture

Notes:

Do not scale from this drawing. All dimensions to be checked on-site by contractor to ensure accuracy prior to any installation. All design work produced by Amspec Ltd is for indicative purposes only. It is the client and contractors responsibility to ensure that building control and fire officer approval have been met prior to commencement of site work

REV:	DESCRIPTION:	BY:	DATE:
STATUS: AS BUILT			
amspec DESIGN & BUILD SOLUTIONS 1 : 01942 621342 f : 01942 226552 www.amspec.co.uk			
CLIENT:	OBI 80 MOSLEY STREET MANCHESTER M2 3FX		
ARCHITECT:			
SITE:	18 LOWER BYROM STREET MANCHESTER		
TITLE:	MEETING ROOM/ WORK SUITE DOORS		
SCALE AT A3: 1:25	DATE: 02.12.19	DRAWN: CR	CHECKED: MS
PROJECT NO: 1683	DRAWING NO: 02(32)406	REVISION:	