
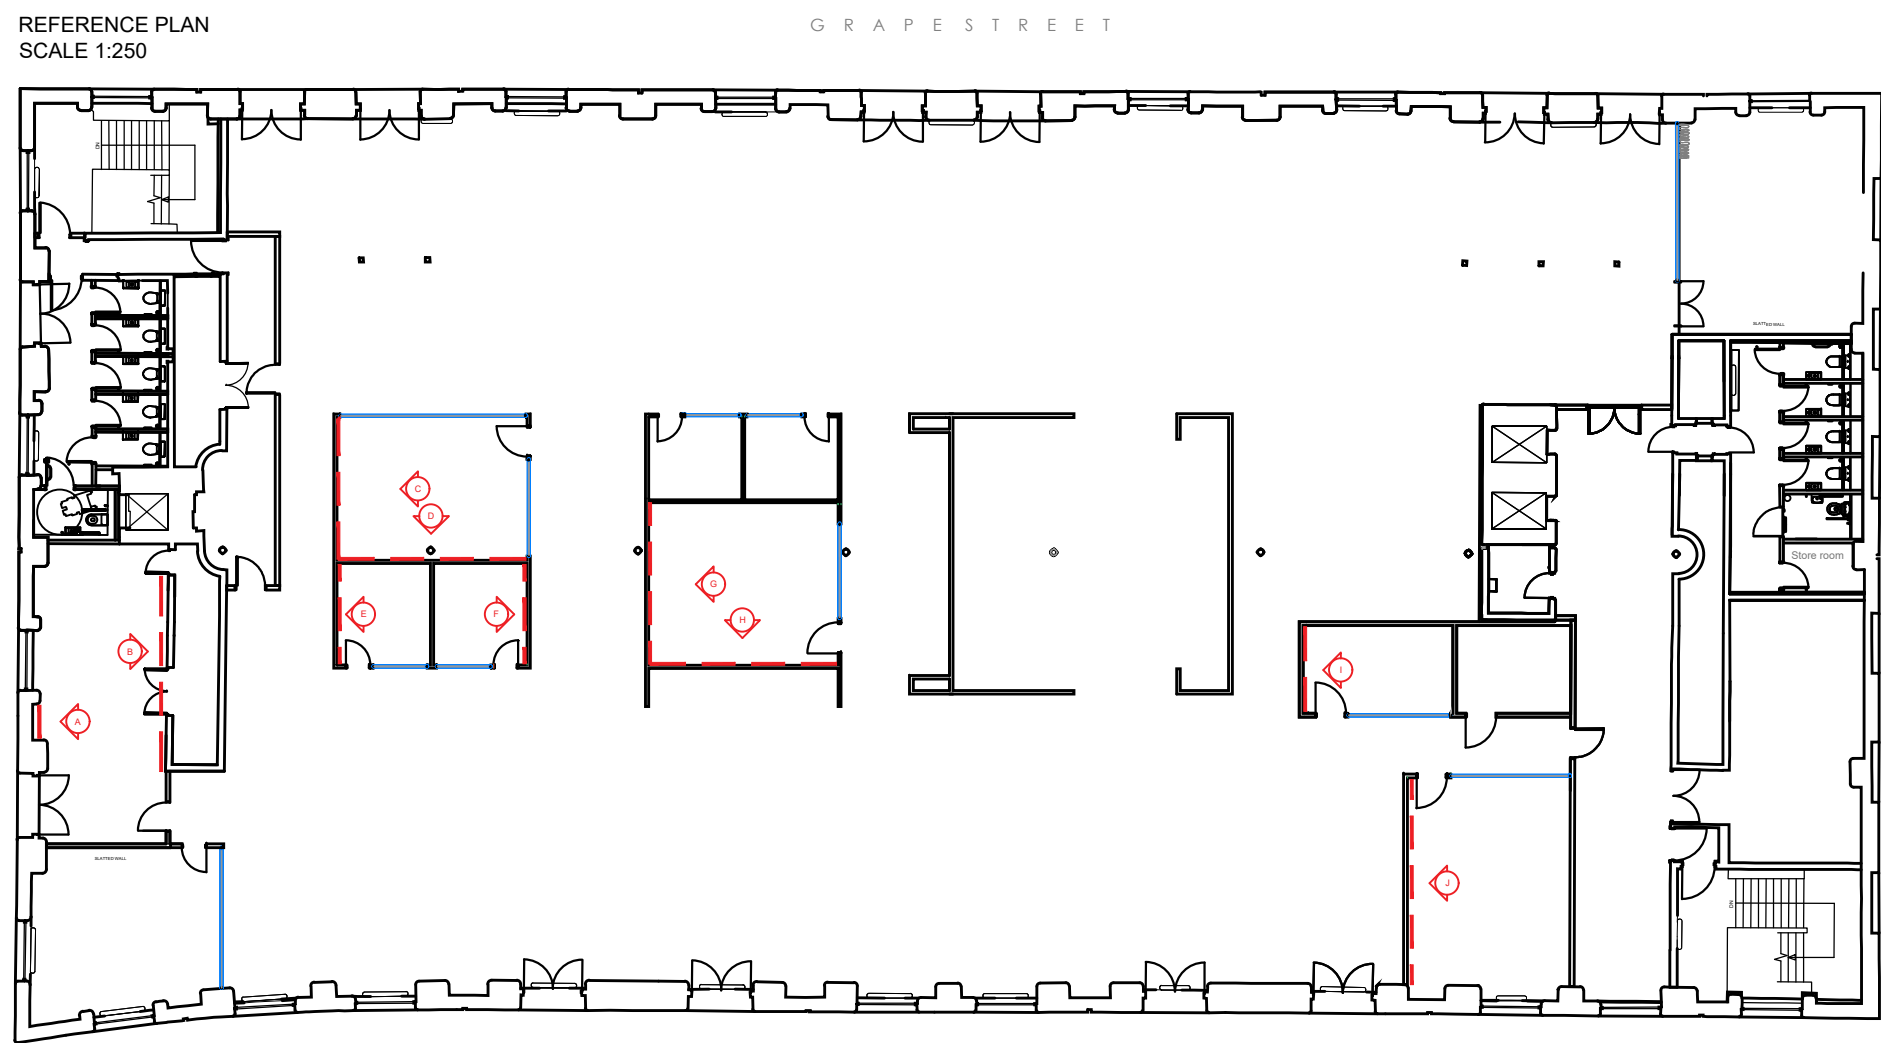
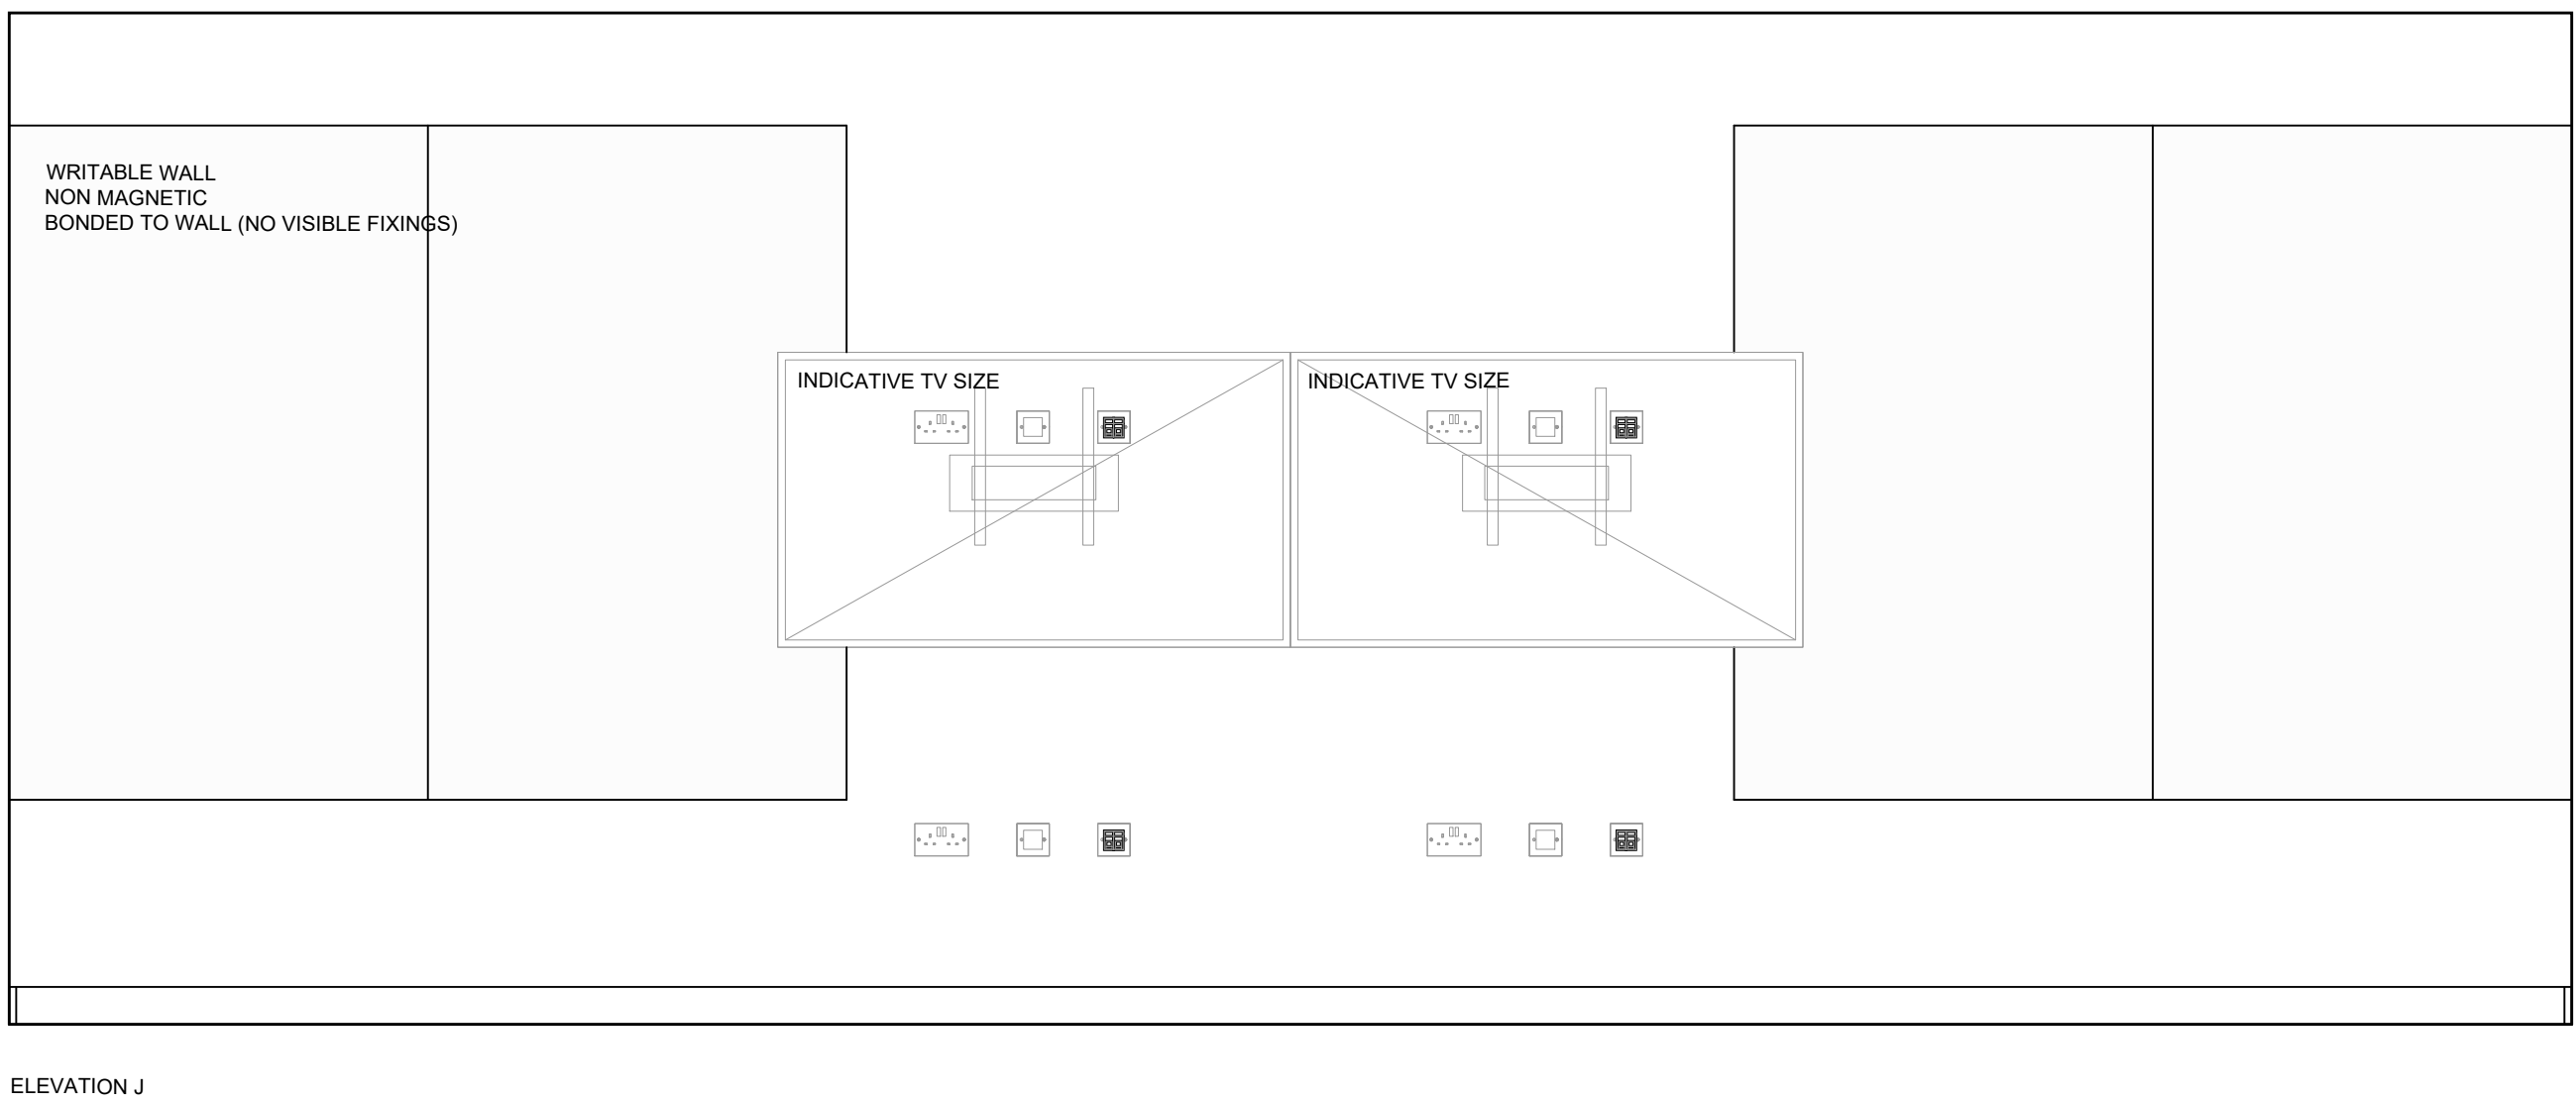
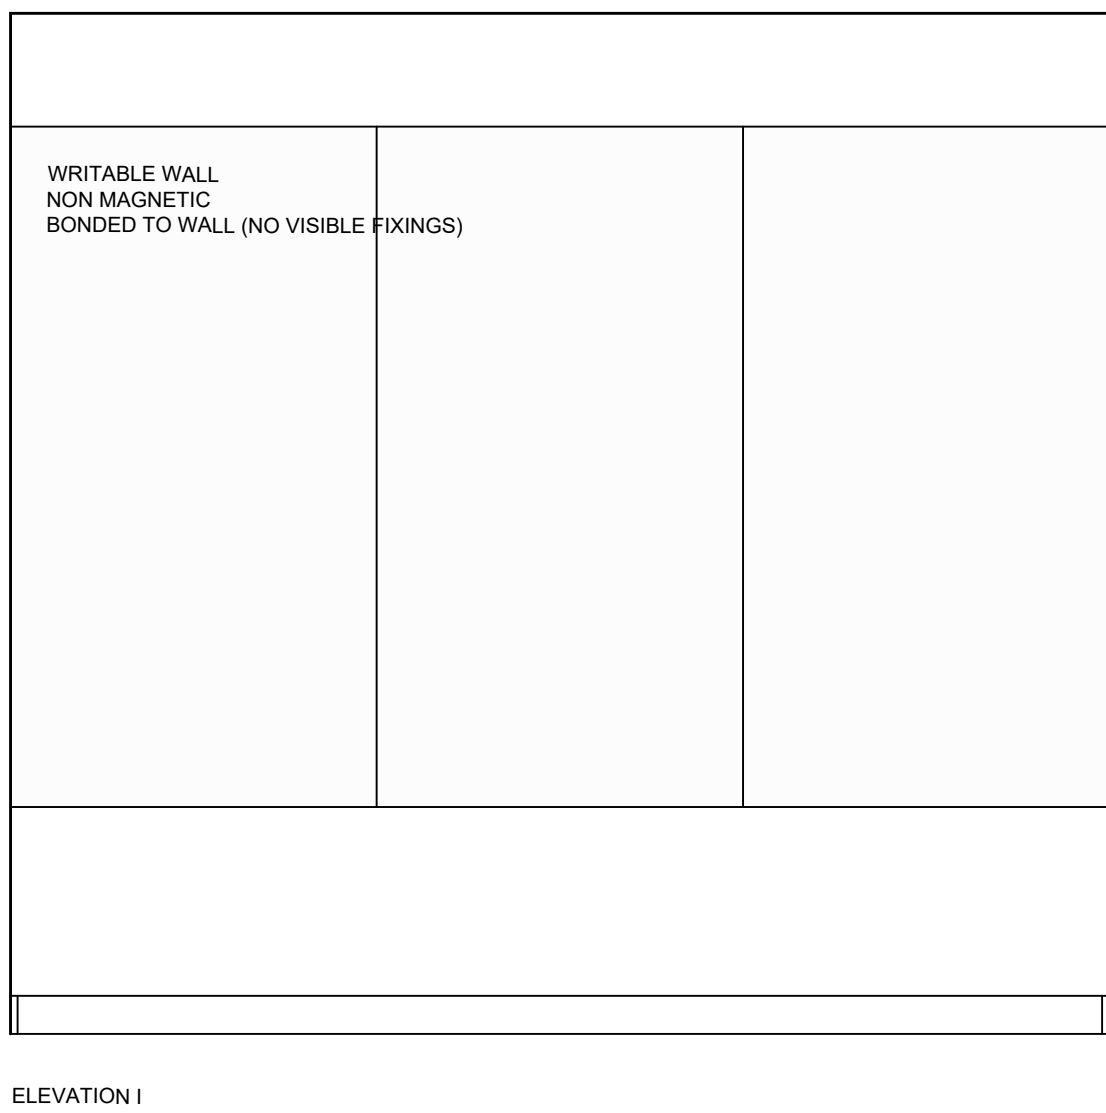
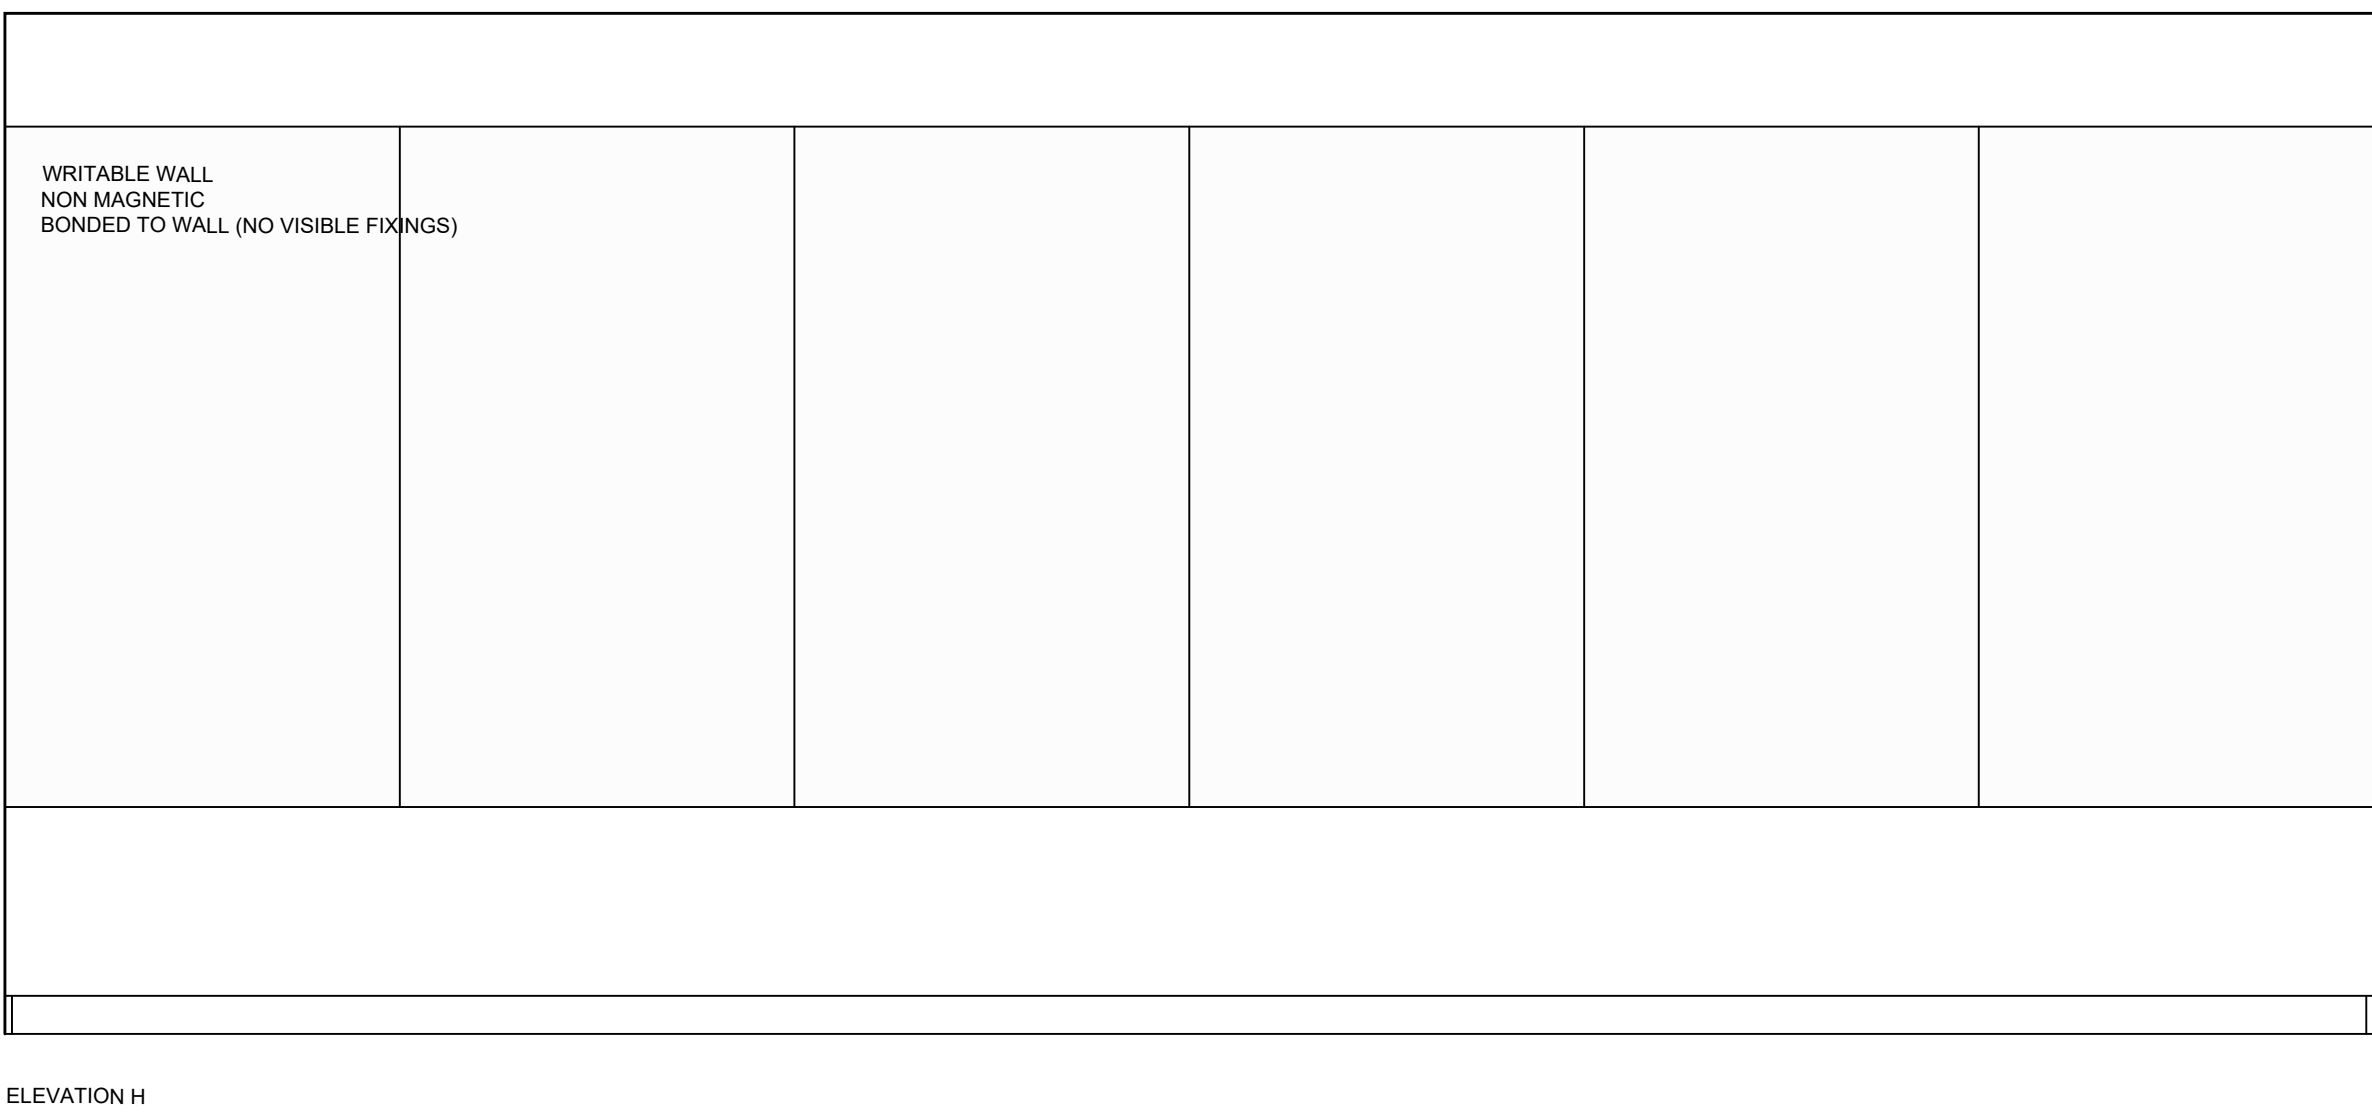
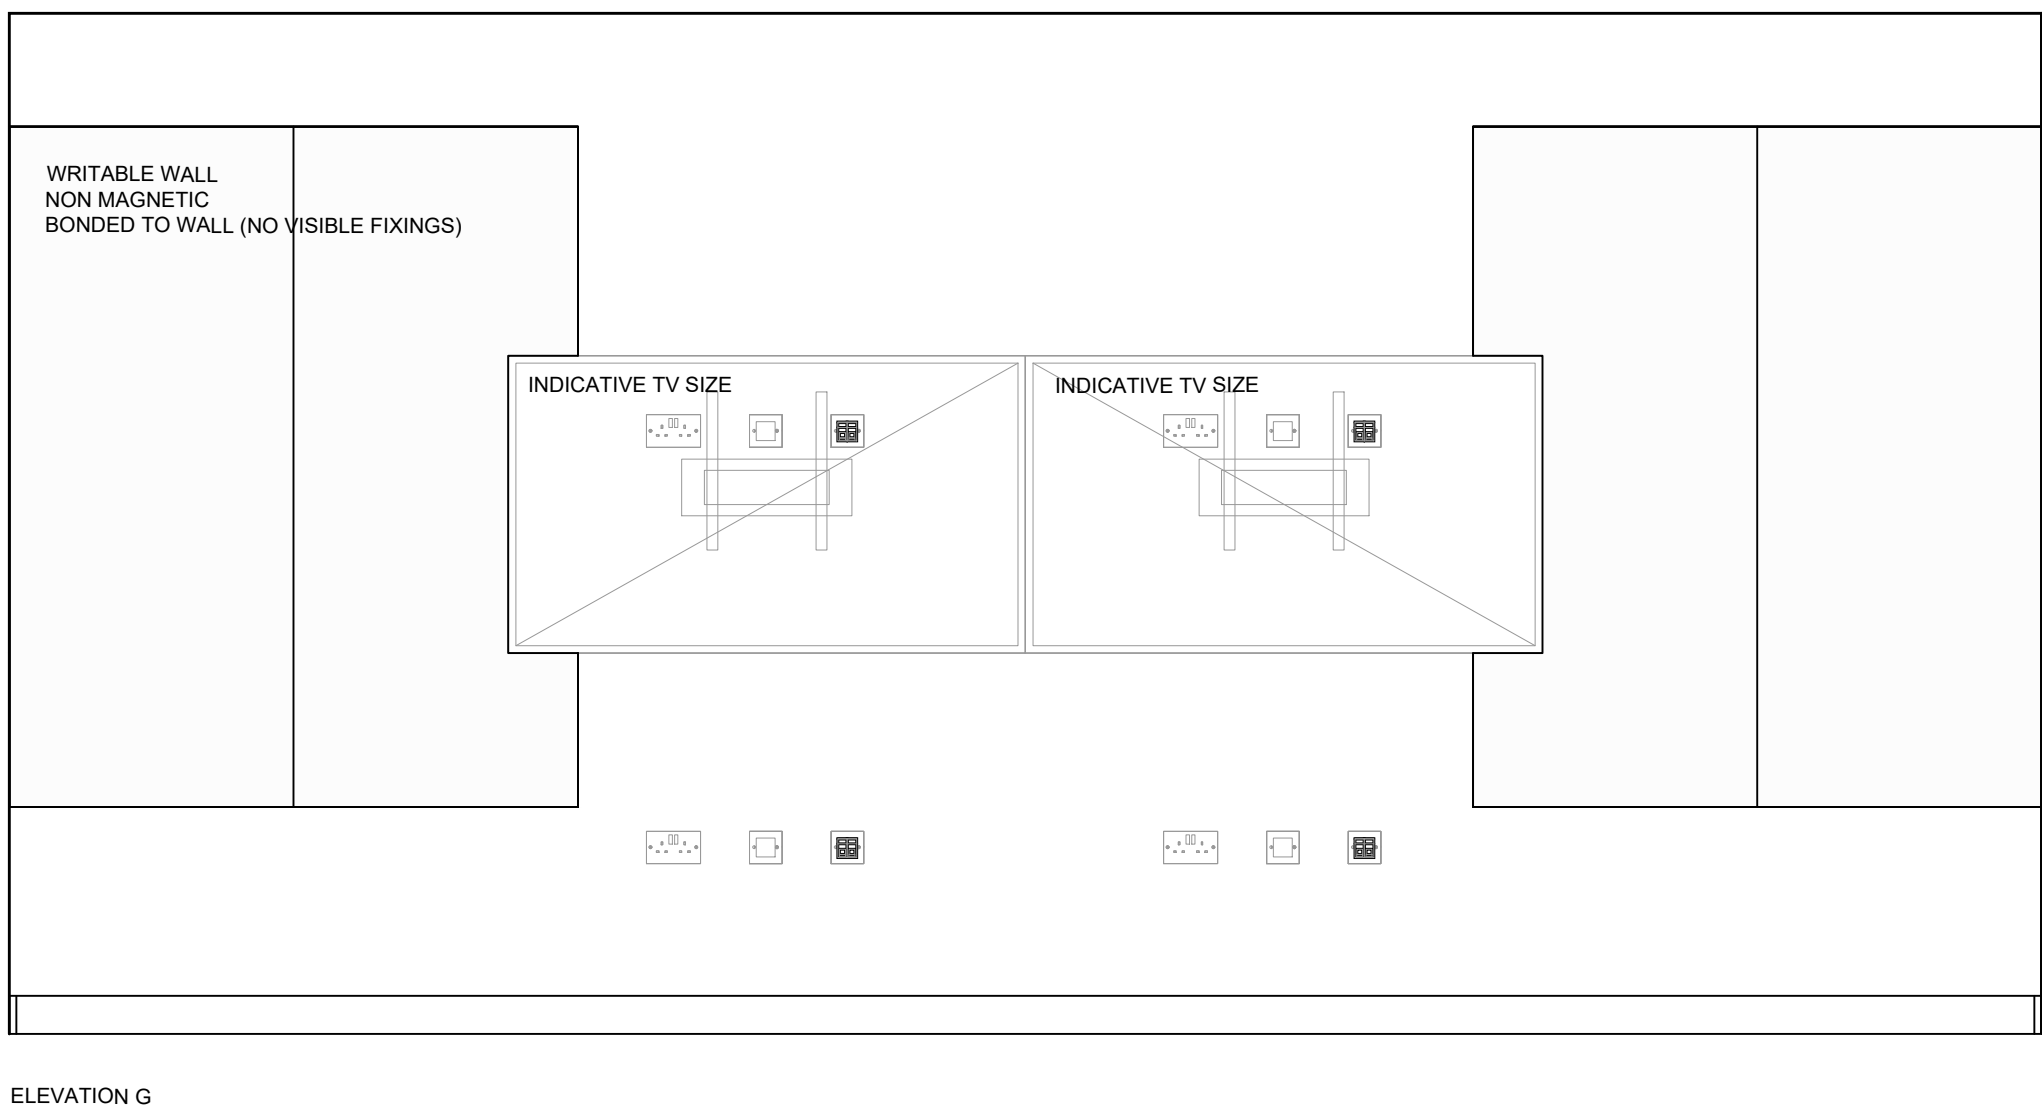
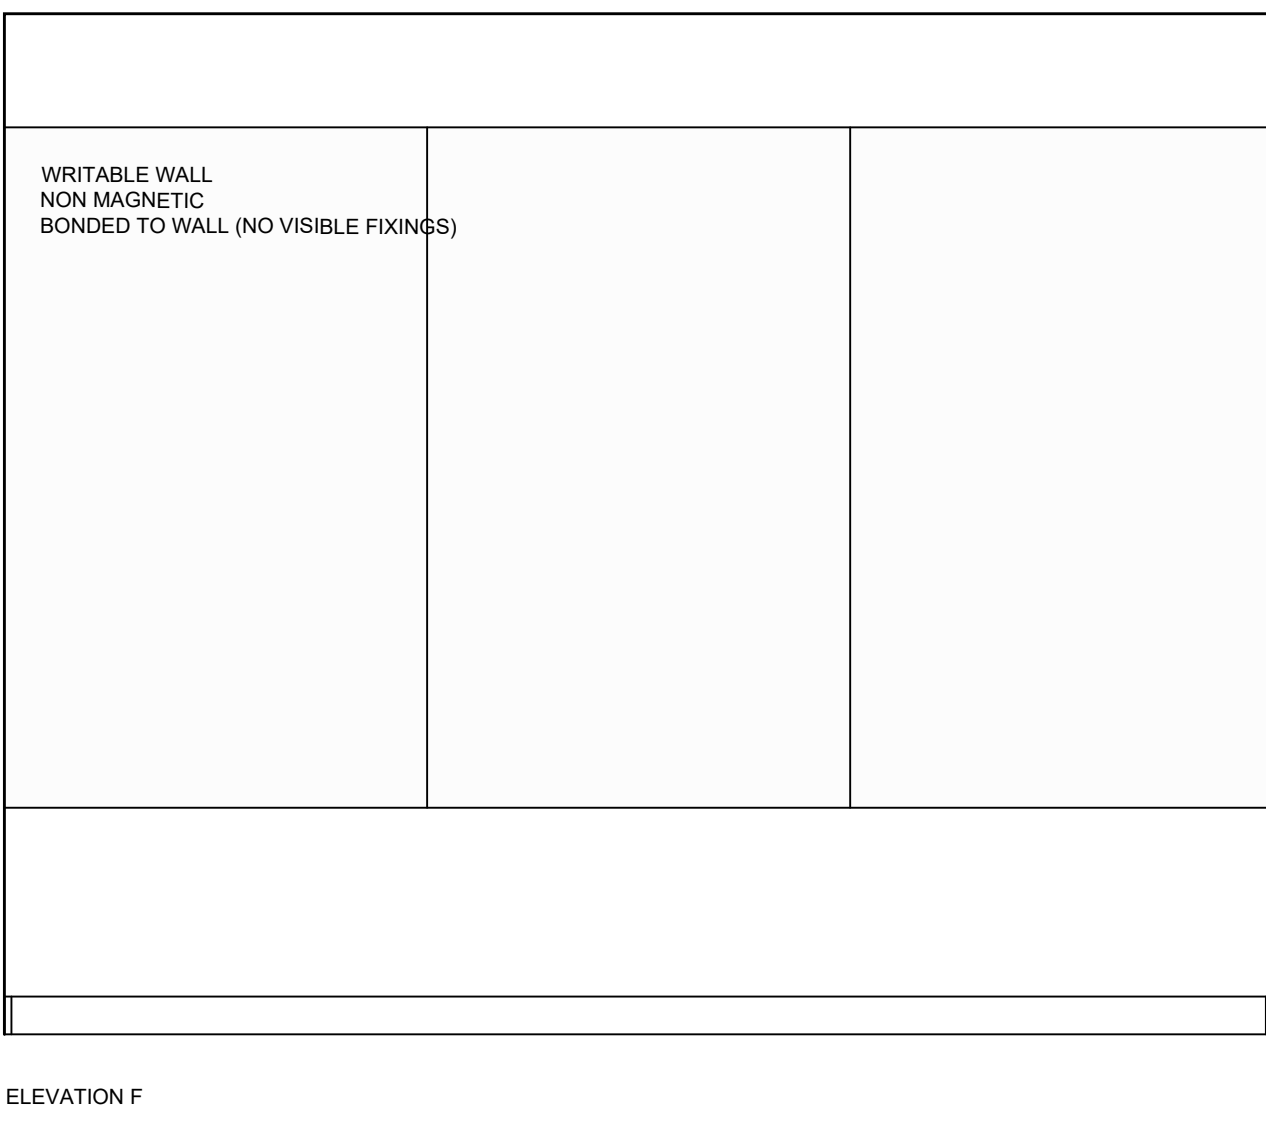
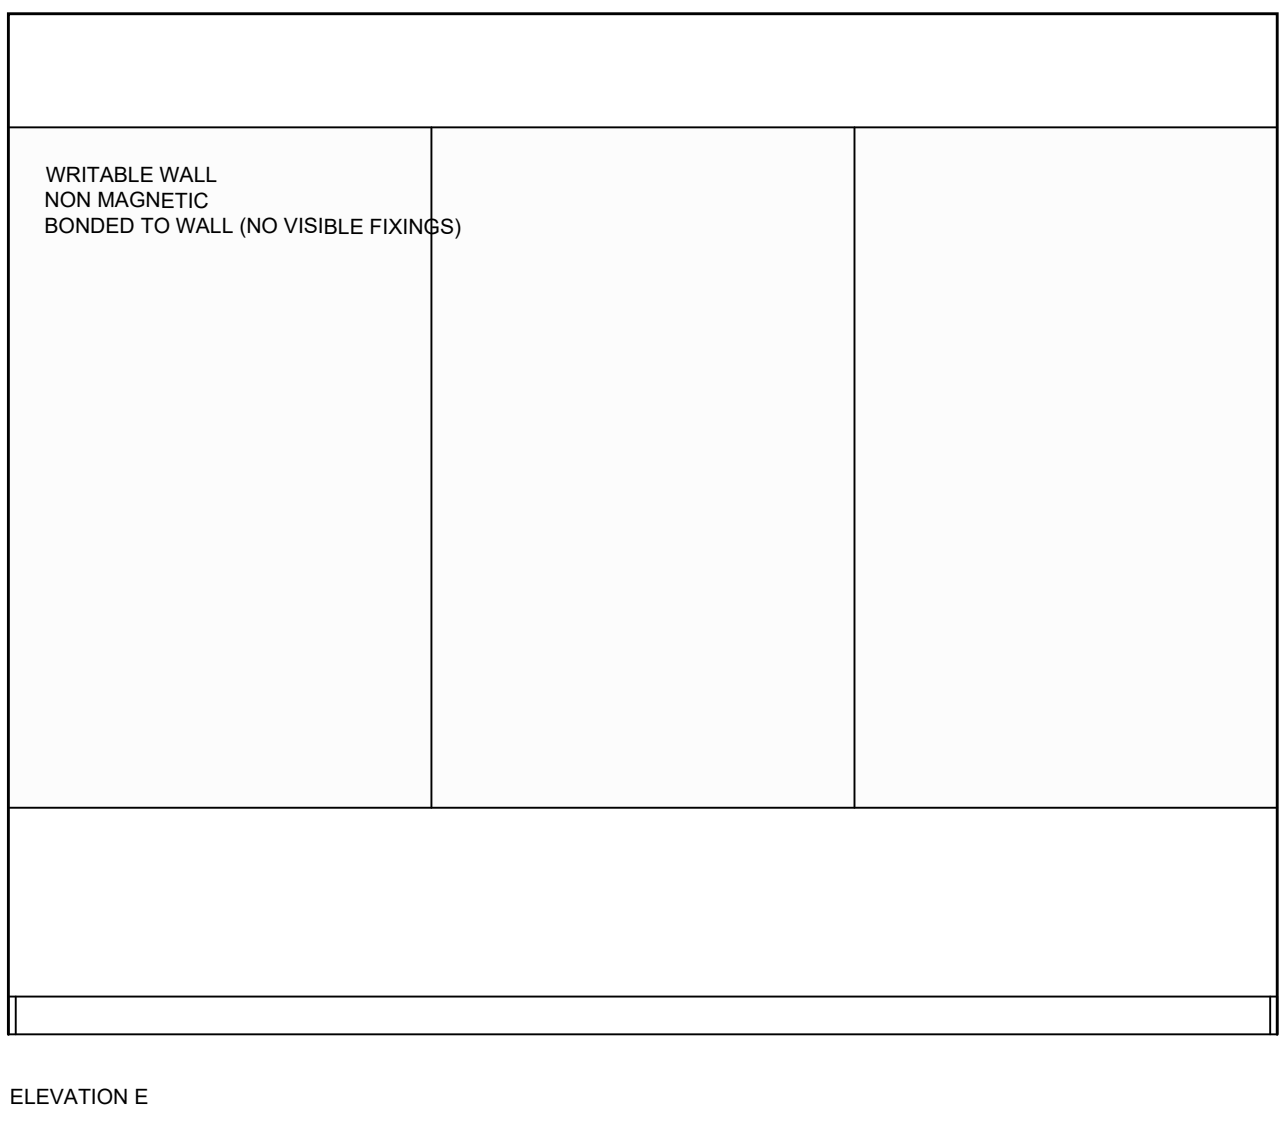
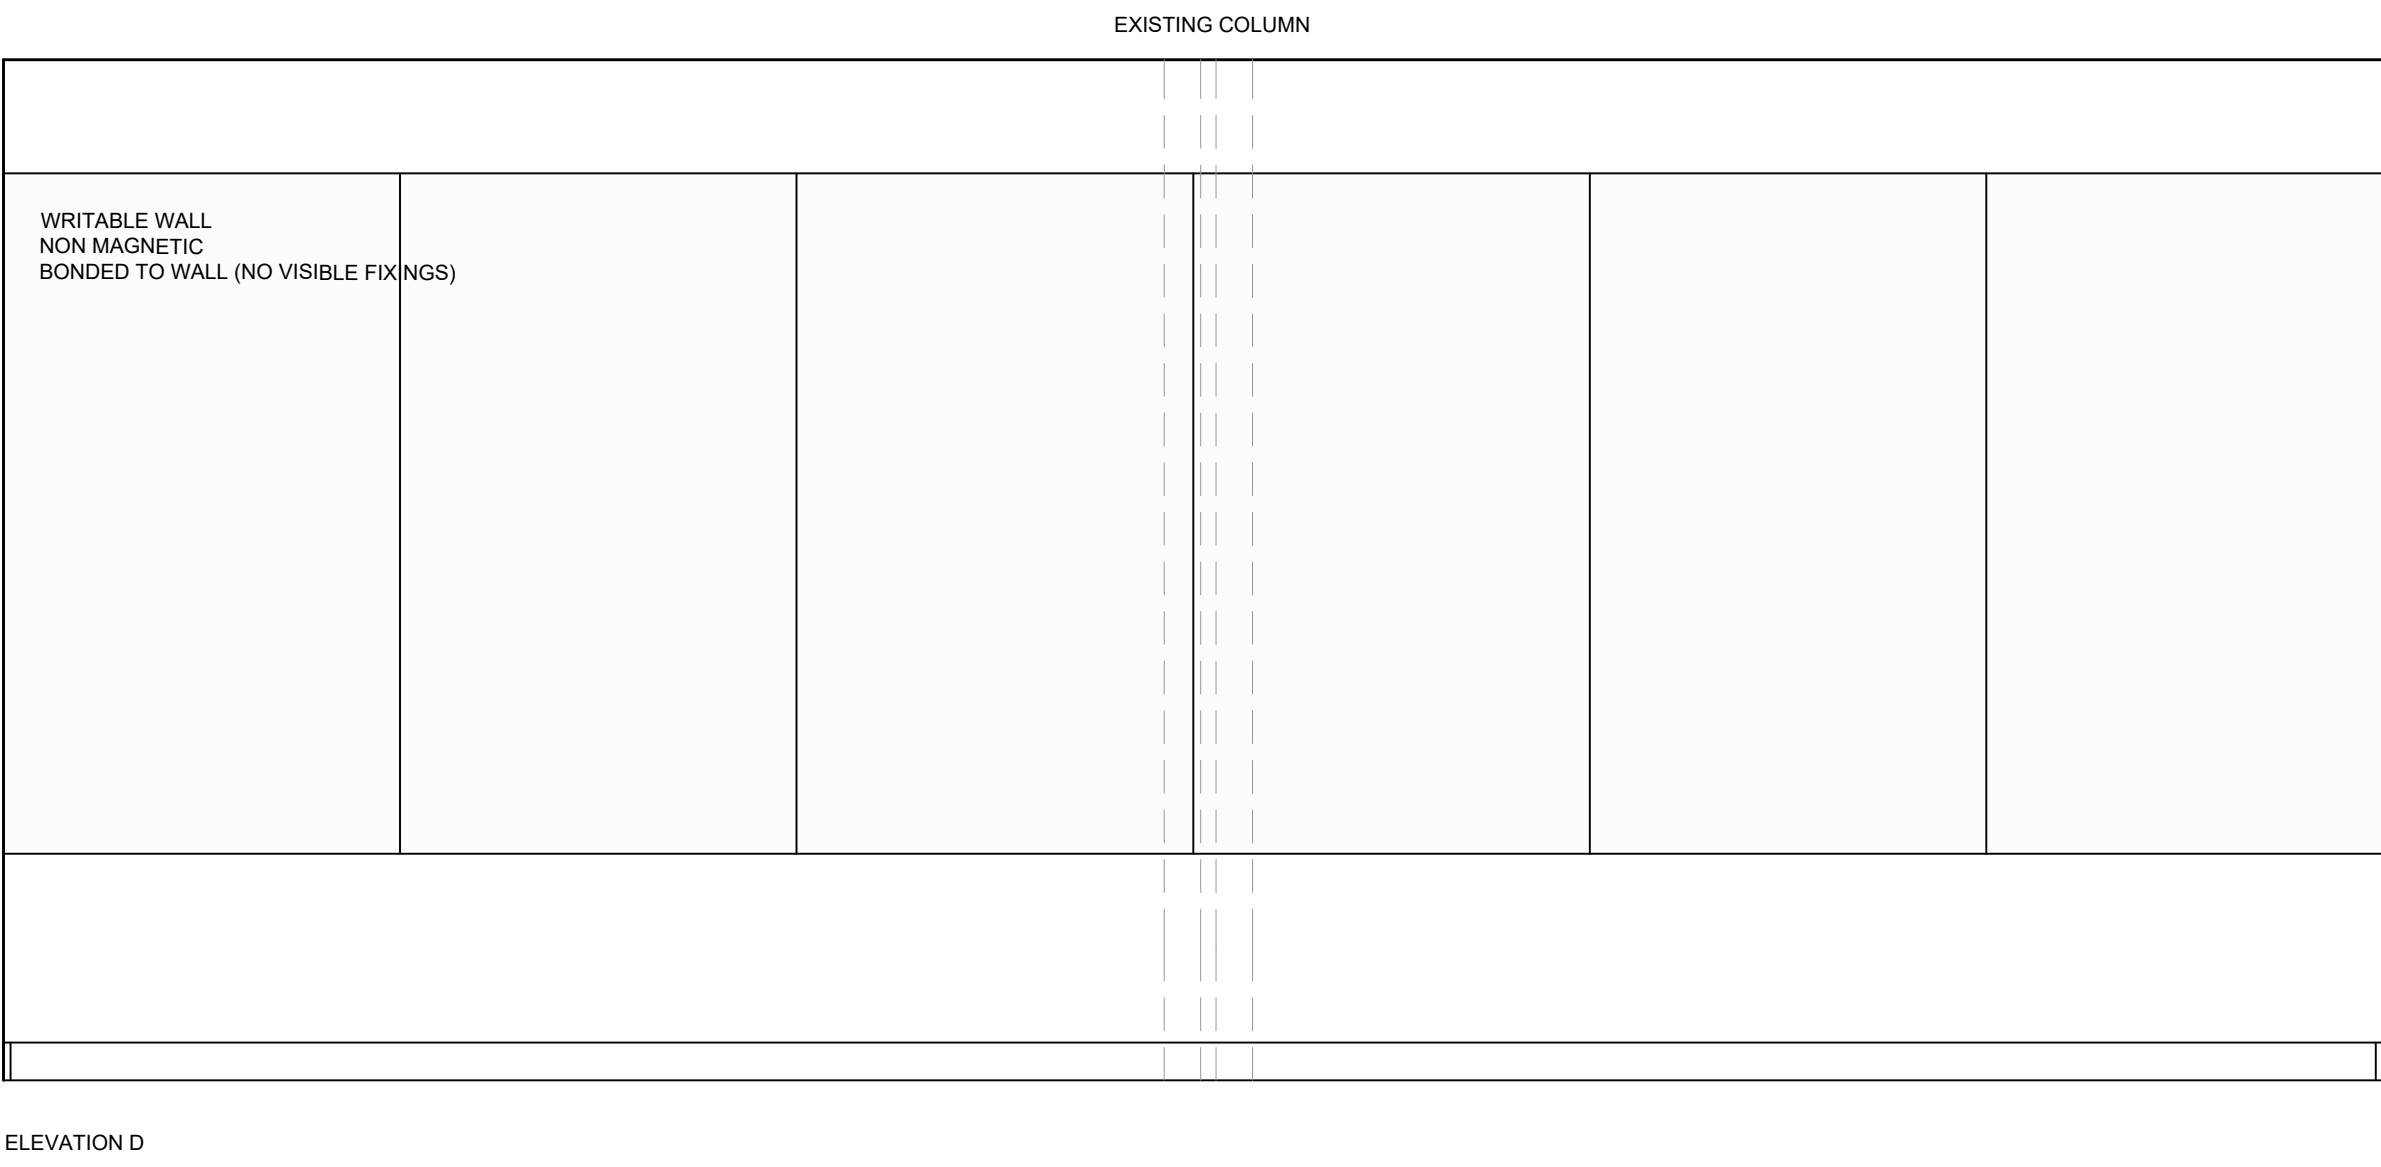
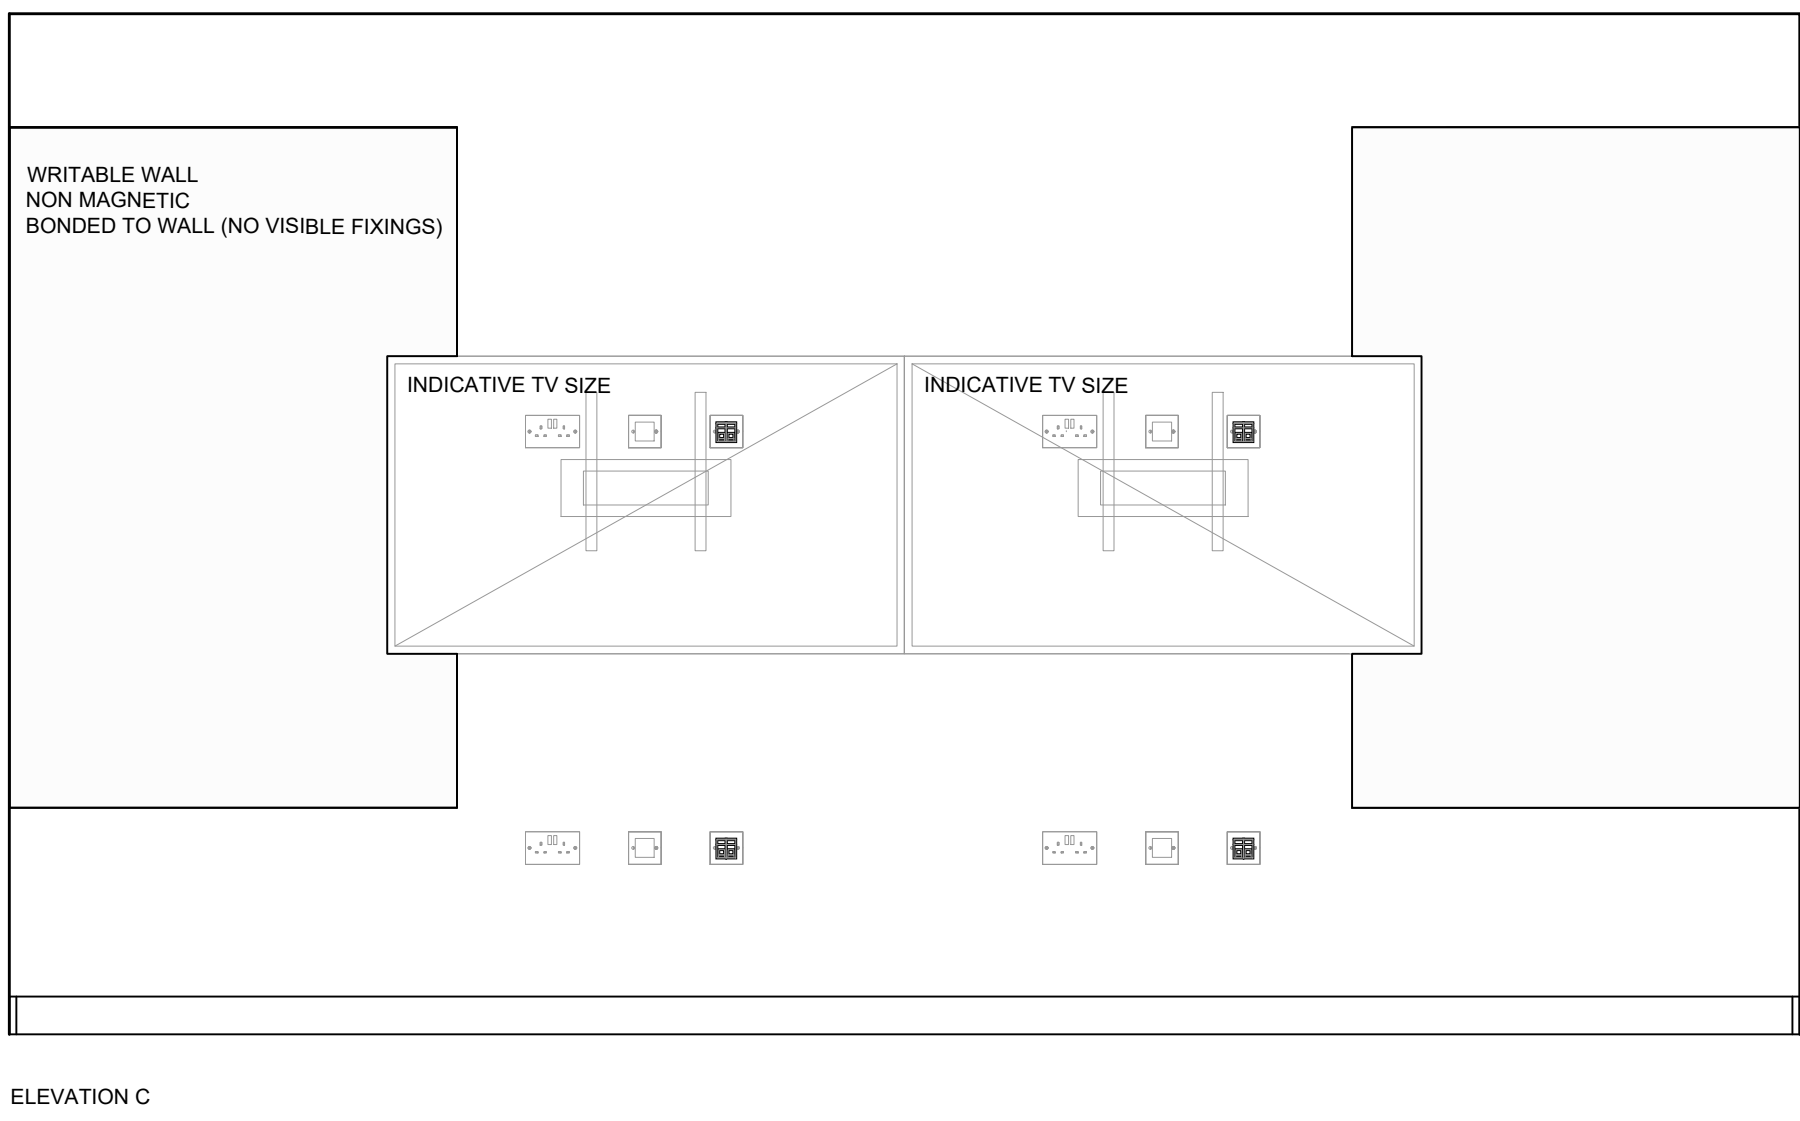


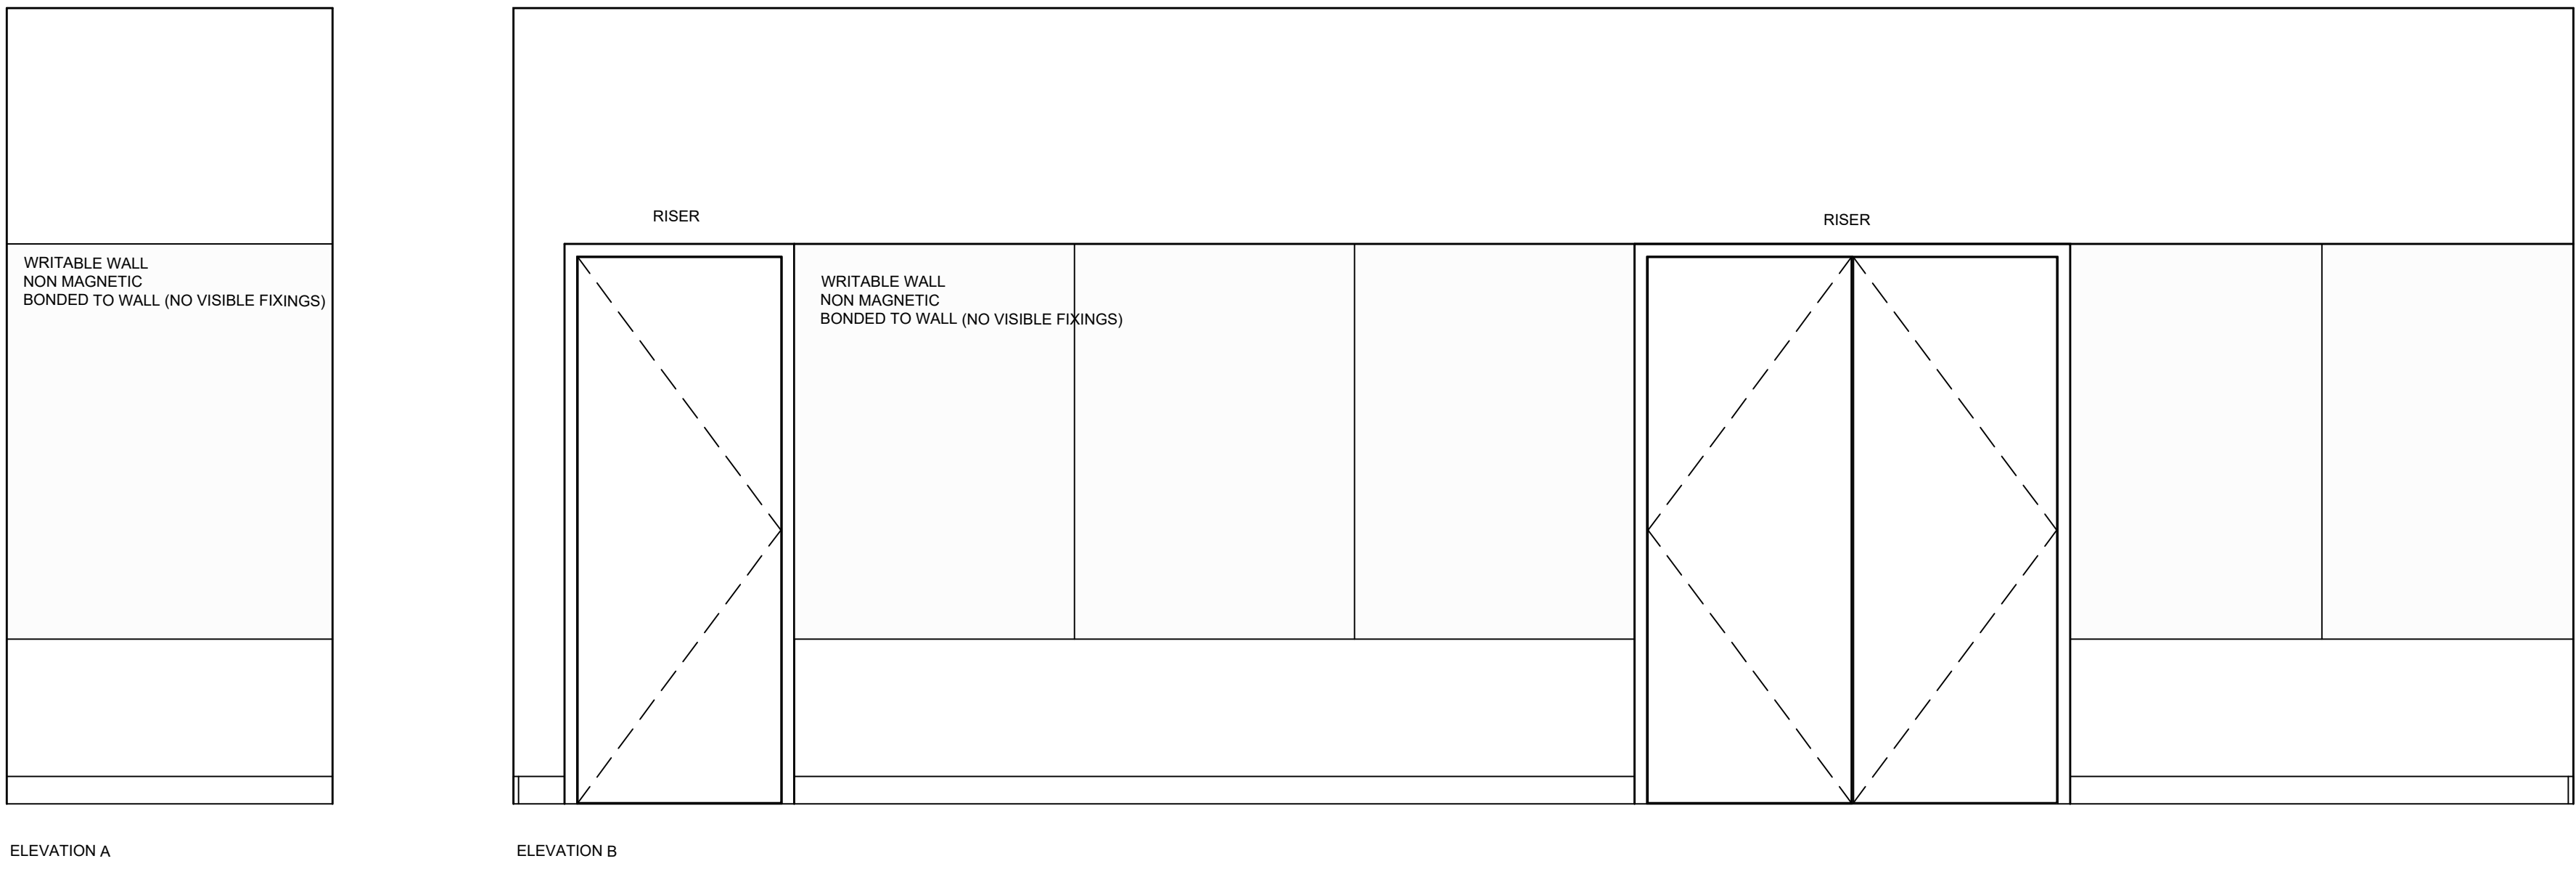

Notes:

Do not scale from this drawing. All dimensions to be checked on-site by contractor to ensure accuracy prior to any installation. All design work produced by amspec Ltd is for indicative purposes only. It is the client and contractor responsibility to ensure that building control and the officer approval have been met prior to commencement of site work.

ALL DIMENSIONS TO BE CONFIRMED ON-SITE PRIOR TO MANUFACTURE OF PANELS

REV:	DESCRIPTION:	BY:	DATE:
STATUS: AS BUILT			
 amspec DESIGN & BUILD SOLUTIONS T: 0161 42 421342 F: 0161 42 324552 www.amspec.co.uk			
CLIENT:	OBI 80 MOSLEY STREET MANCHESTER M2 3PX		
ARCHITECT:			
SITE:	18 LOWER BYROM STREET MANCHESTER		
TITLE:	LEVEL 6 WRITABLE WALL ELEVATIONS		
SCALE: AT A0:	DATE:	DRAWN:	CHECKED:
1:25	15.01.20	CR	MS
PROJECT NO:	DRAWING NO:	REVISION:	
1683	06(22)400		