


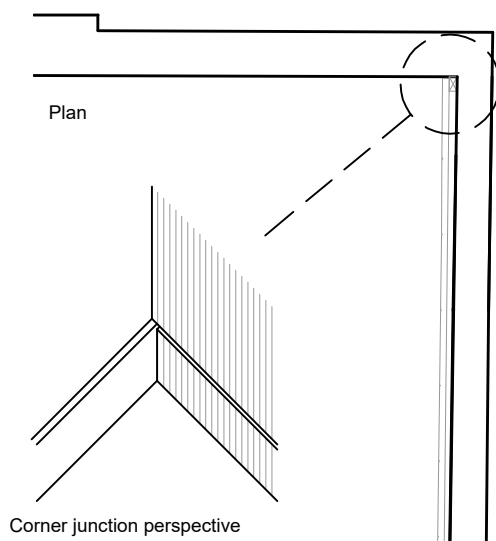
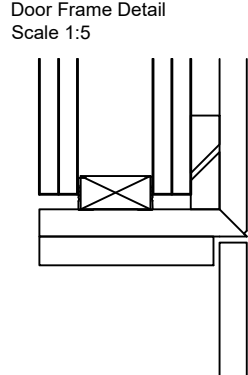
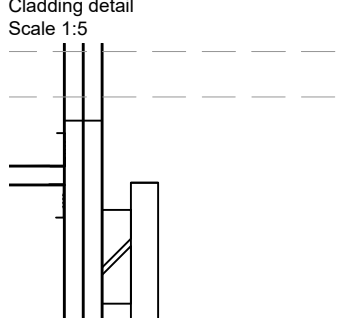
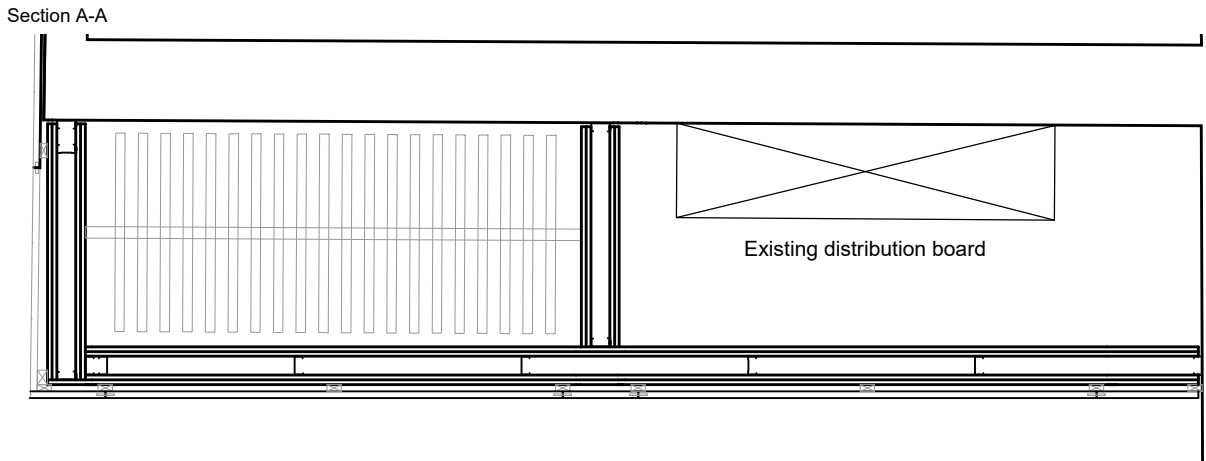
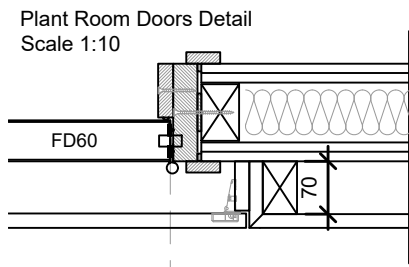
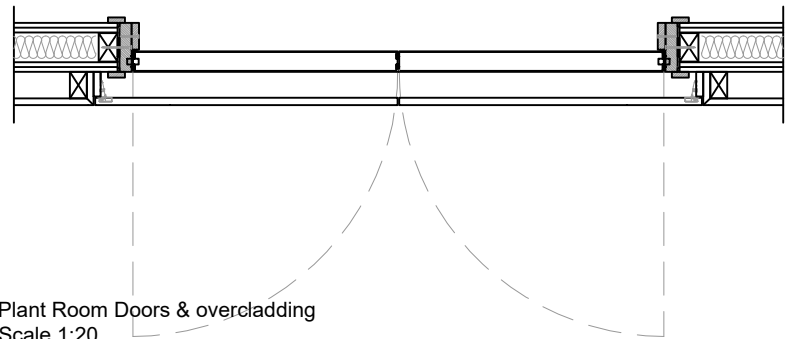
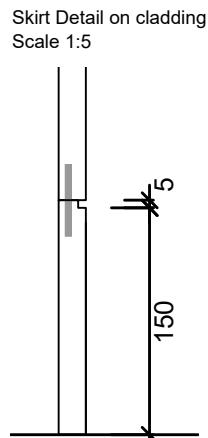
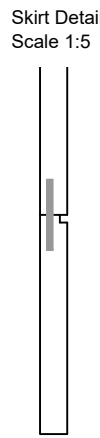


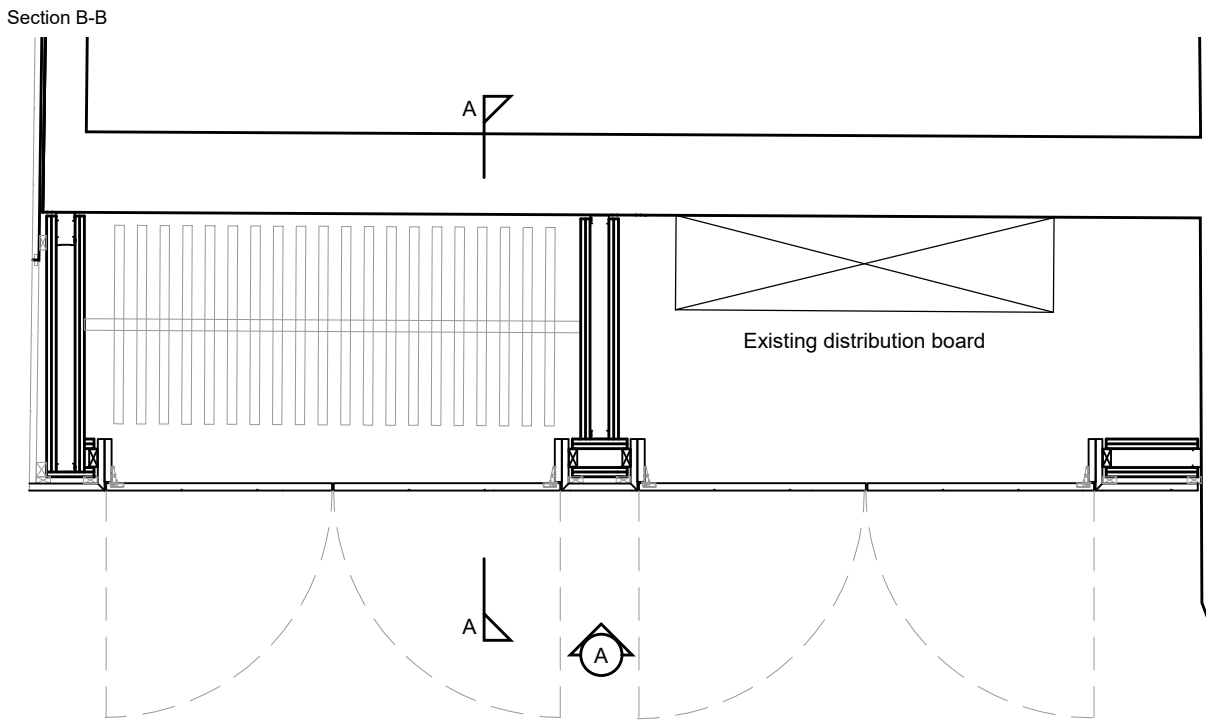


Plant Room Elevation B
Scale 1:50

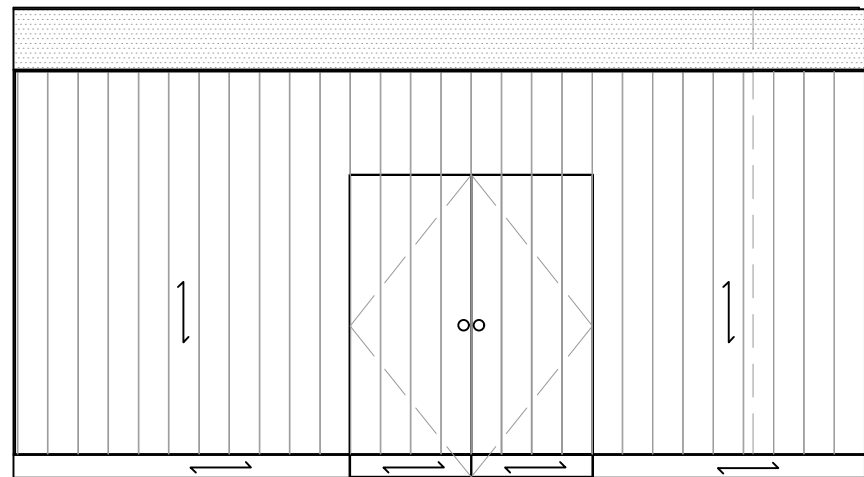


Elevation A

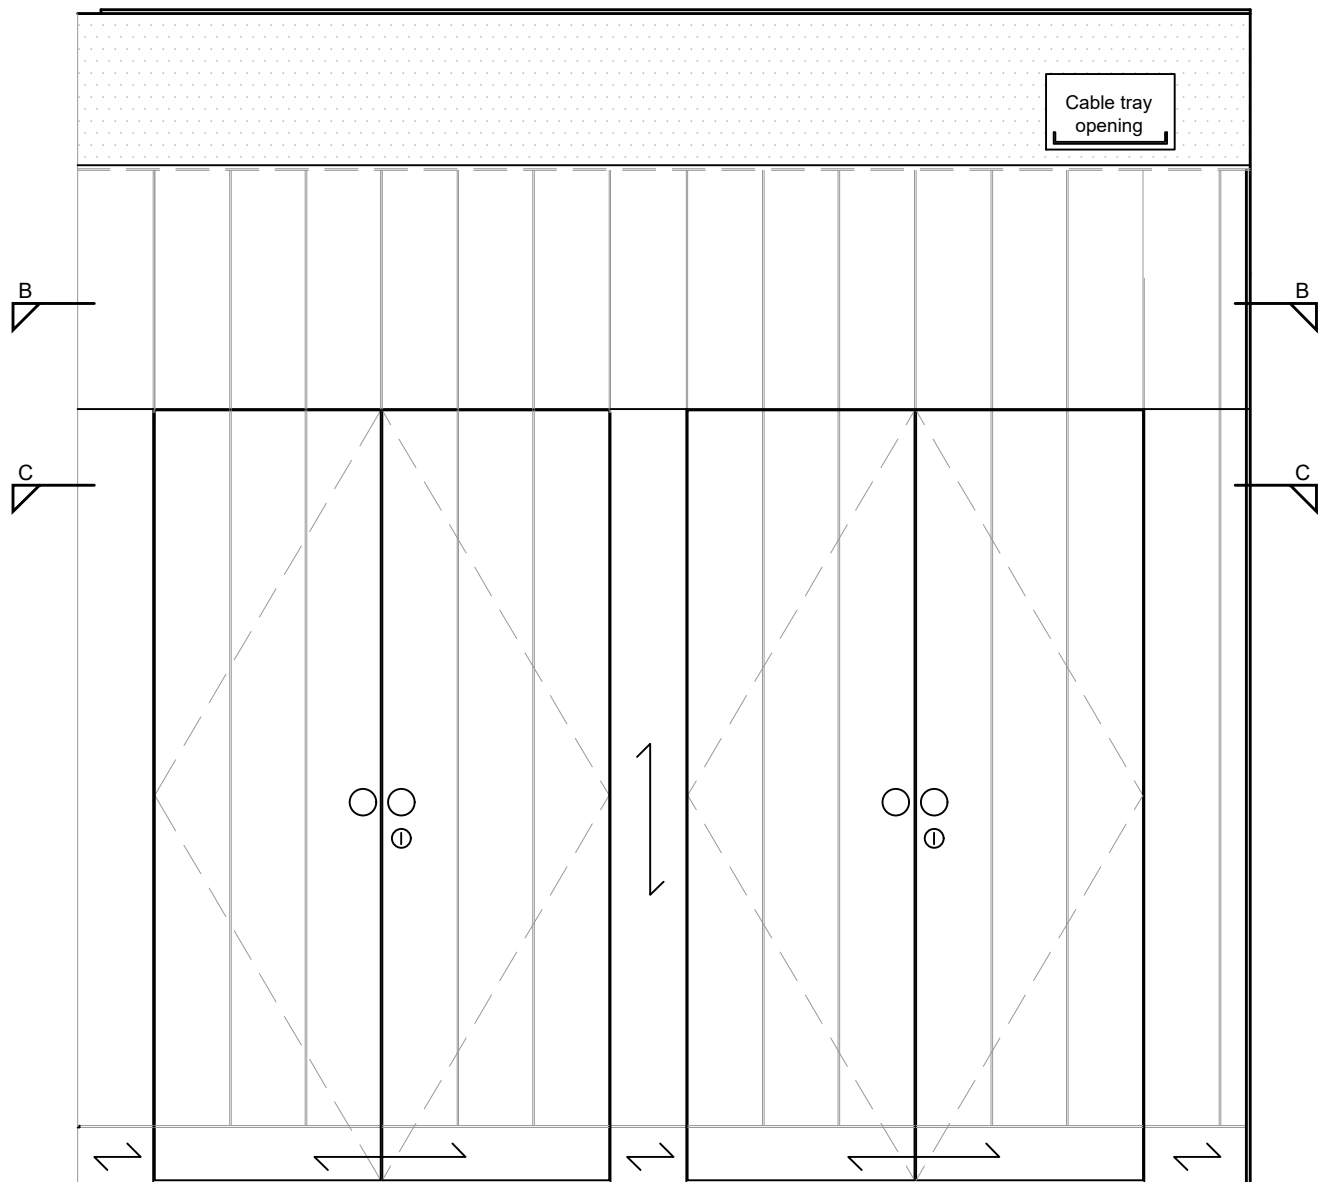

Section A-A

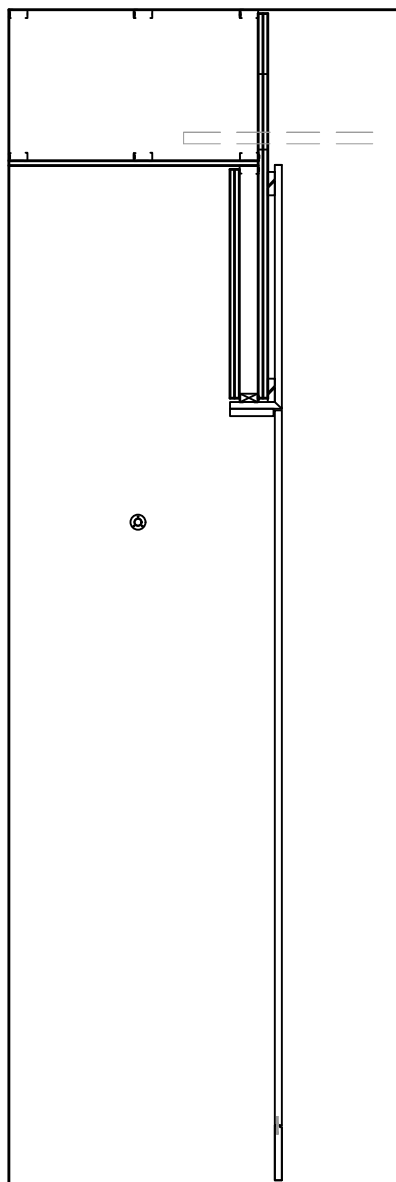

Cladding detail
Scale 1:5

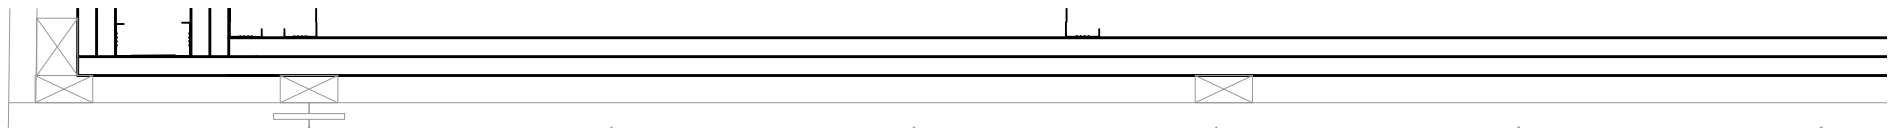


Notes:

Do not scale from this drawing. All dimensions to be checked on-site by contractor to ensure accuracy prior to any installation. All design work produced by Amspec Ltd is for indicative purposes only. It is the client and contractors responsibility to ensure that building control and fire officer approval have been met prior to commencement of site work

Materials	Description
Cladding:	19mm MDF oak veneer with v-cut grooves black stained oak. Sample required for approval
Door finish:	19mm MDF oak veneer with v-cut grooves black stained oak.
Door handles:	Matte black flush pull round handle 50mm open design. Mucheln Architectural Door Hardware
Door locks:	Espagnolette rod with lock and black face escutcheon plate, Hettich
Hinges:	Concealed Blum full overlay soft close hinges black finish
Coat rail:	19mm black round steel tube with tube end sockets in black

Contracts manager to check and confirm all measures on-site. Any discrepancies to be reported to the designer

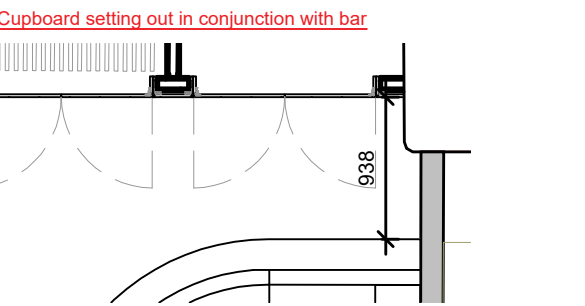

REV: DESCRIPTION: BY: DATE:

STATUS: AS BUILT



CLIENT: OBI
80 MOSLEY STREET
MANCHESTER
M2 3FX

ARCHITECT:

SITE: 18 LOWER BYROM STREET
MANCHESTER

TITLE: LEVEL 2
CUPBOARD & PANELLING

SCALE: AT A2: 1:20 DATE: 08.11.19 DRAWN: CR CHECKED: MS

PROJECT NO: 1683 DRAWING NO: 02(71)511 REVISION: