


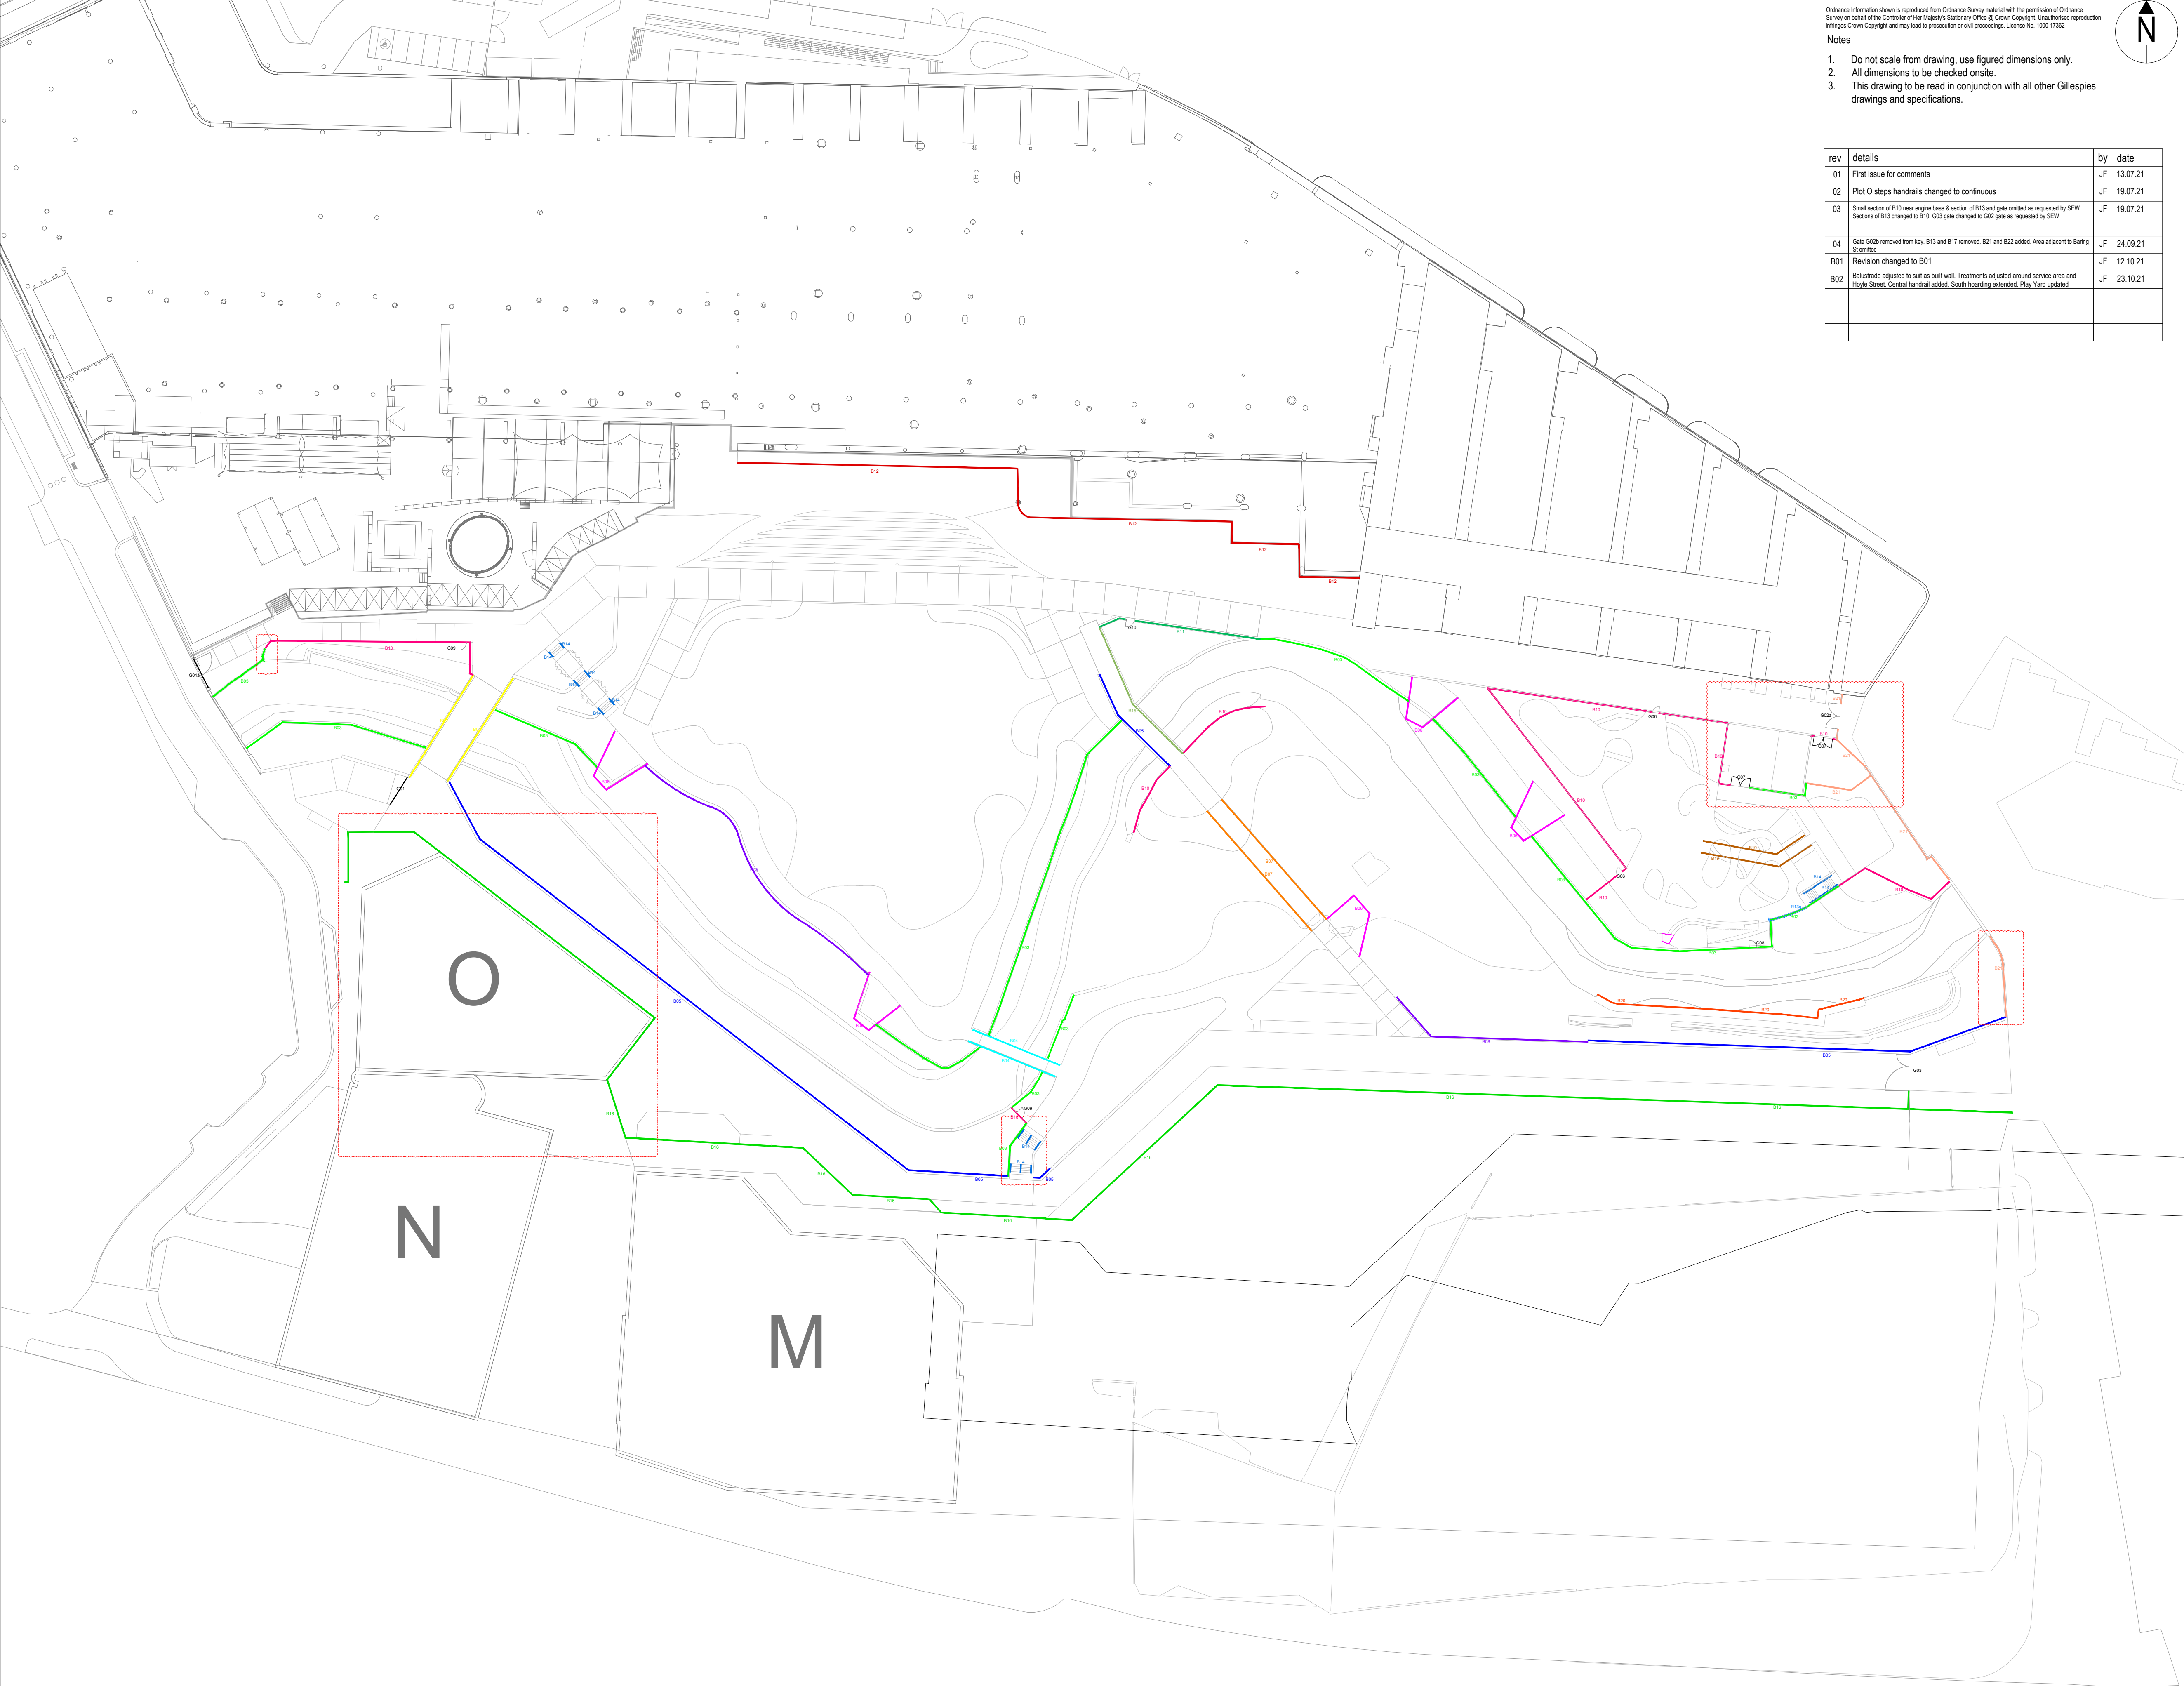

Ordnance Information shown is reproduced from Ordnance Survey material with the permission of Ordnance Survey on behalf of the Controller of Her Majesty's Stationary Office © Crown Copyright. Unauthorised reproduction infringes Crown Copyright and may lead to prosecution or civil proceedings. License No. 1000 17502

Notes

1. Do not scale from drawing, use figured dimensions only.
2. All dimensions to be checked onsite.
3. This drawing to be read in conjunction with all other Gillespies drawings and specifications.

rev	details	by	date
01	First issue for comments	JF	13.07.21
02	Plot O steps handrails changed to continuous	JF	19.07.21
03	Small section of B10 near engine base & section of B13 and gate omitted as requested by SEW. Sections of B13 changed to B10. G03 gate changed to G02 gate as requested by SEW.	JF	19.07.21
04	Gate G03 removed from key. B13 and B17 removed. B21 and B22 added. Area adjacent to Barrng St omitted.	JF	24.09.21
B01	Revision changed to B01	JF	12.10.21
B02	Balustrade adjusted to suit as built wall. Treatments adjusted around service area and Hoyle Street. Central handrail added. South hoarding extended. Play Yard updated	JF	23.10.21

- Freight Island Boundary. Description: to be redesigned by Freight island architect as part of the reconfiguration of the freight island seating booths to face the park. Finish TBC
- B01 - Balustrade Type 01. Description: Balustrade fixed on top of concrete plinth.
- B02 - Balustrade Type 02. Description: Balustrades fixed to outside of bridge with concrete plinth on the inside.
- B03 - Balustrade Type 03. Description: Balustrade fixed on top of existing refurbished wall with new concrete coping.
- B04 - Balustrade Type 04. Description: Proposed steel bridge with new mesh cladding.
- B05 - Balustrade Type 05. Description: Metalwork balustrade 100mm bars fixed to face and underside of concrete bridge deck.
- B06 - Balustrade Type 06. Description: Metal balustrade fixed to front of I-beam jetty structure.
- B07 - Balustrade Type 07. Description: Metal balustrade fixed to front of I-beam boardwalk structure.
- B08 - Balustrade Type 08. Description: 450mm knee rail
- B10 - Balustrade Type 10. Description: Balustrade in soft
- B11 - Balustrade Type 11. Description: Balustrade fixed to top of concrete wall and concrete coping to sheet piling
- B12 - Balustrade Type 12. Description: Boundary secure fence
- B14 - Step Handrails.
- B15 - Concrete Upstand/Plinth.
- B16 - Southern hoarding line. Description: Timber Plywood Hoarding 1200x2400x18mm thick timber plywood sheets (EN1635-3), 100mm x 150mm x 3400mm Posts (Grade C24), 3 off 75mm x 100mm Horizontal Rails (Grade C24) @ 1200max/m vertical centres. Plywood sheets fixed to posts & rails with 4mm screws (50mm lg) @ 300 max centres. Posts sunk 1000mm into 400mm square holes & filled with lean mix concrete. Top & Bottom Coping. Painted graphic to be developed as part of the site wide branding/wayfinding strategy
- B18 - Armco Barrier to edge of maintenance yard.
- B19 - Balustrade fixed to play tower access bridge and abutment
- B20 - Wall R08 Cladding
- B21 - Steel Expanded Mesh. Refer to drawing MAY101-WSL-EXT-GIL-DR-0209
- G01 - Gate Type 01
Description: Sliding Gate
- G02A - Gate Type 02A
Description: Vehicular and Pedestrian gate
- G03 - Gate Type 03
Description: Vehicular and Pedestrian gate
- G04A - Gate Type 04A
Description: Pedestrian Gate
- G05 - Gate Type 05
Description: Vehicular Gate/Access into park maintenance yard
- G06 - Gate Type 06
Description: Single Leaf playground gate
- G07 - Gate Type 07
Description: Double Leaf playground gate
- G08 - Gate Type 08
Description: Single Leaf Maintenance Gate on existing Wall
- G09 - Gate Type 09
Description: Single Leaf Maintenance Gate in soft landscaping
- G10 - Gate Type 10
Description: Single Leaf Maintenance Gate on proposed Wall

Project title
Mayfield Park

Drawing title
Landscape
Boundaries and Edge Protection GA

Drawing status
B

Scale
1:500 @ A1

Drwn
JF

Chk'd
WC

Date
13.07.21

Rev

Drawing number
MAY101-WSL-EXT-GIL-DR-7060-0107 02

P11511-01-001-GIL-0101 © copyright GILLESPIES LLP, all rights reserved

Client
P. P. O'CONNOR
Committed To Excellence

61 Mosley Rd
Trafford Park
Stretford
Manchester
M17 1NB

GILLESPIES

Westgate House, 44 Hale Road, WA14 2EX
P: 0161 928 7715 E: design.manchester@gillespies.co.uk