


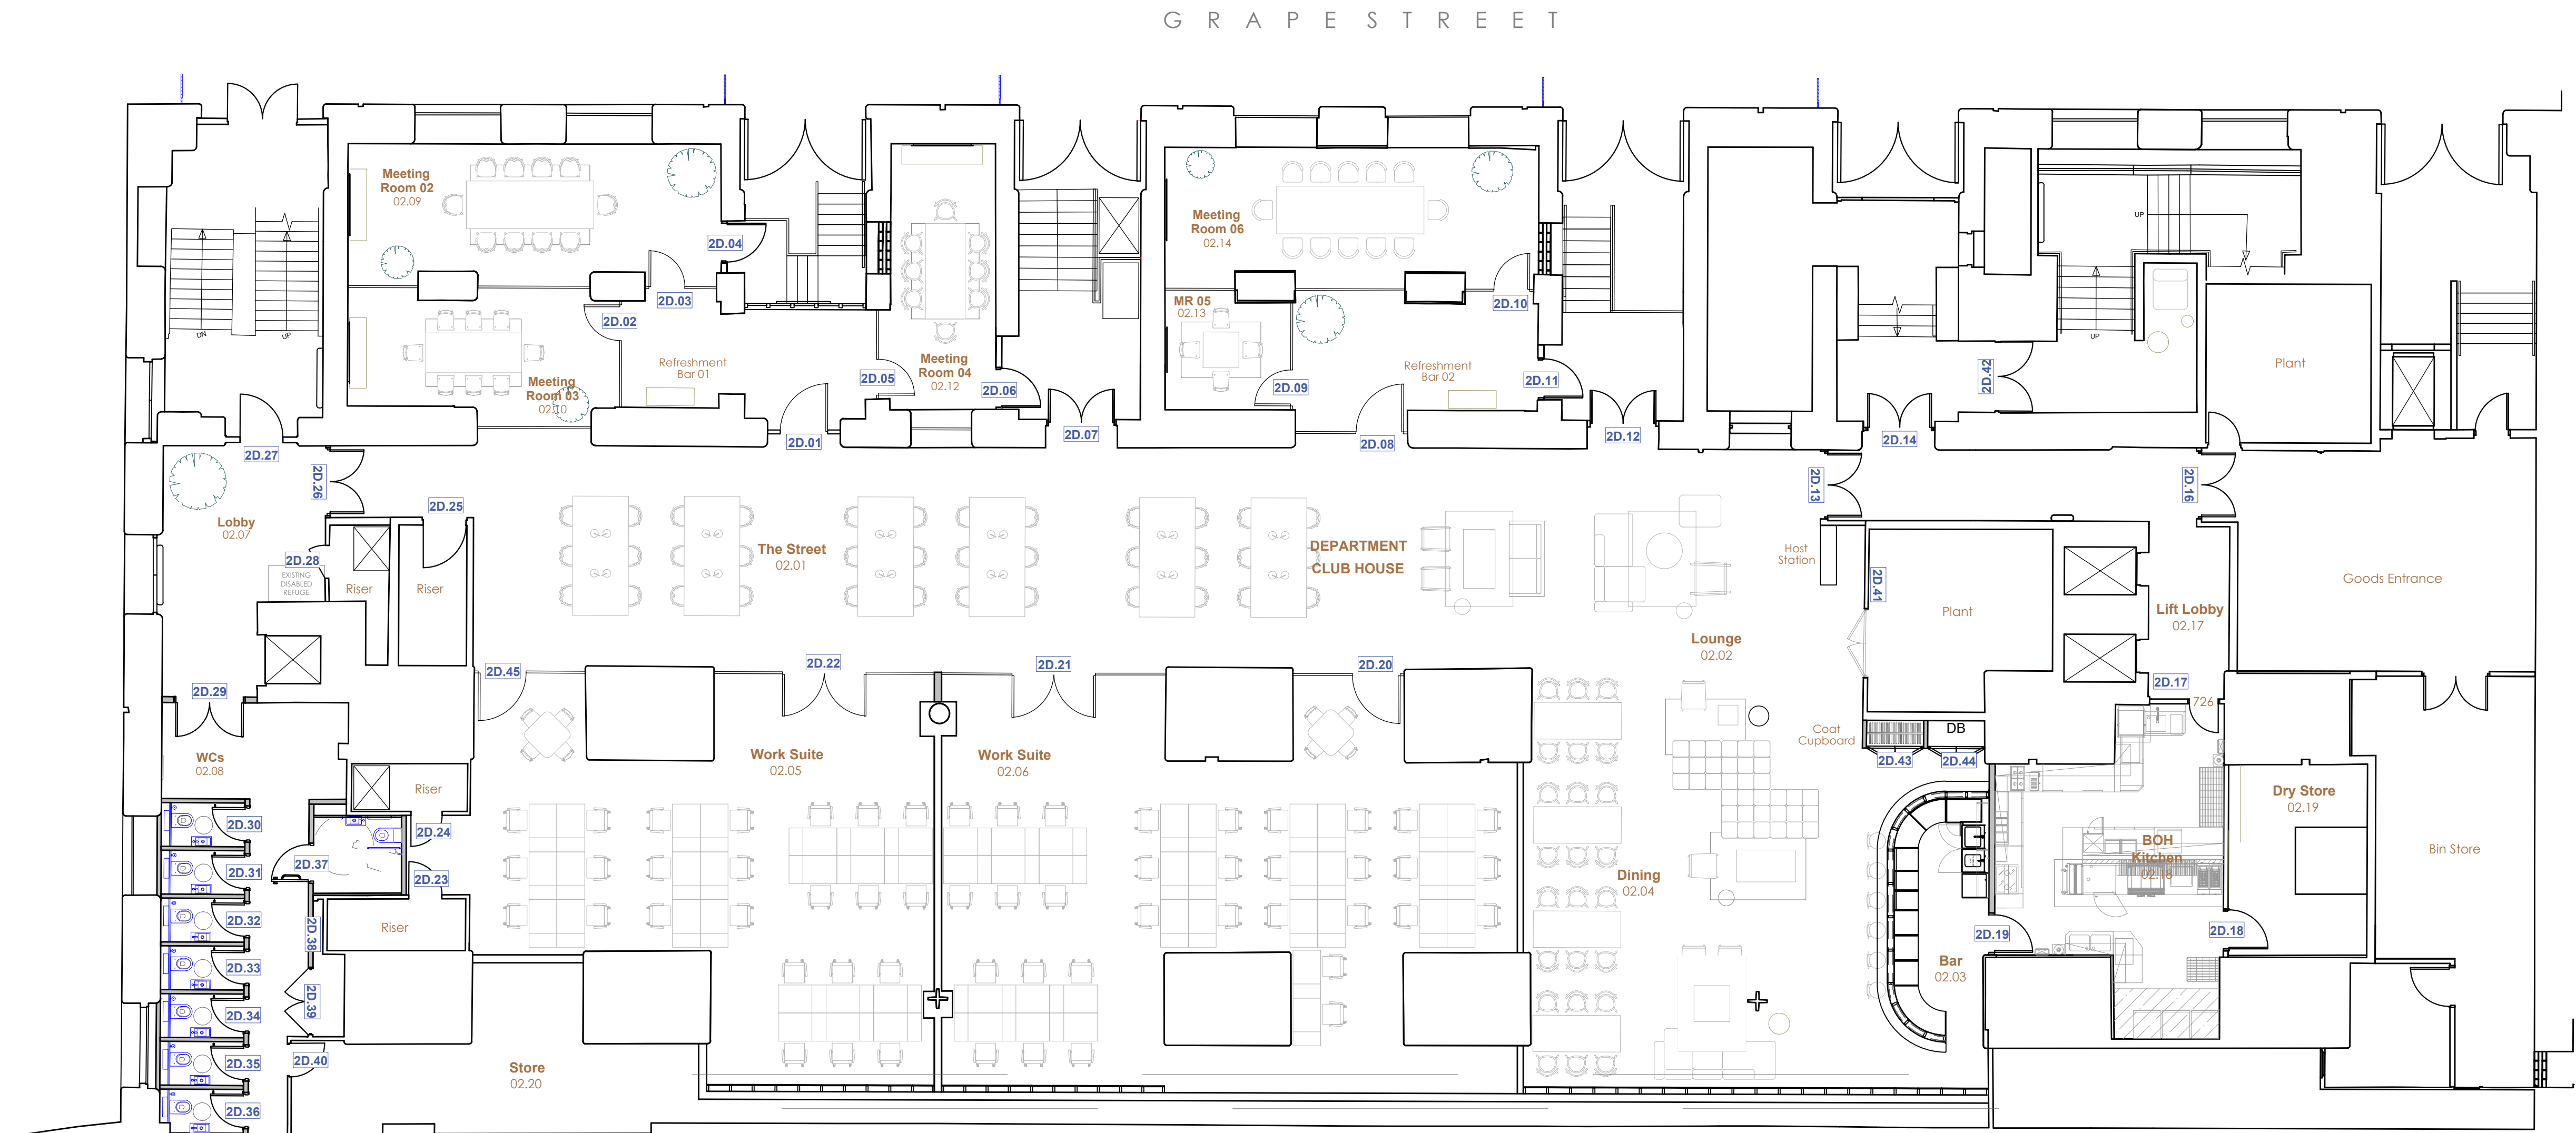

Notes:

Do not scale from this drawing. All dimensions to be checked on-site by contractor to ensure accuracy prior to any installation. All design work produced by Amspec Ltd is for indicative purposes only. It is the client and contractors responsibility to ensure that building control and fire officer approval have been met prior to commencement of site work.

REV:	DESCRIPTION:	BY:	DATE:
STATUS: AS BUILT			
amspec DESIGN & BUILD SOLUTIONS f : 01942 621342 f : 01942 226552 www.amspec.co.uk			
CLIENT:	OBI 80 MOSELEY STREET MANCHESTER M2 3FX		
ARCHITECT:			
SITE:	18 LOWER BYROM STREET MANCHESTER		
TITLE:	LEVEL 2 GENERAL ARRANGEMENT		
SCALE: AT A1: 1:100	DATE: 24.10.19	DRAWN: CR	CHECKED: MS
PROJECT NO: 1683	DRAWING NO: 02(20)100	REVISION:	