


Door Type A1 : WC Cubicle Door


GENERAL NOTE

To be read in conjunction with Schedule of Works, Door Schedule and GA plans.


DOOR 2D.30, 2D.31, 2D.34, 2D.35, 2D.36
800 X 2100
44MM THICK
RAL TBC
THUMBTURN LOCK ACCESS CONTROL
NO FIRE RATING
RISING HINGE
SIGNAGE

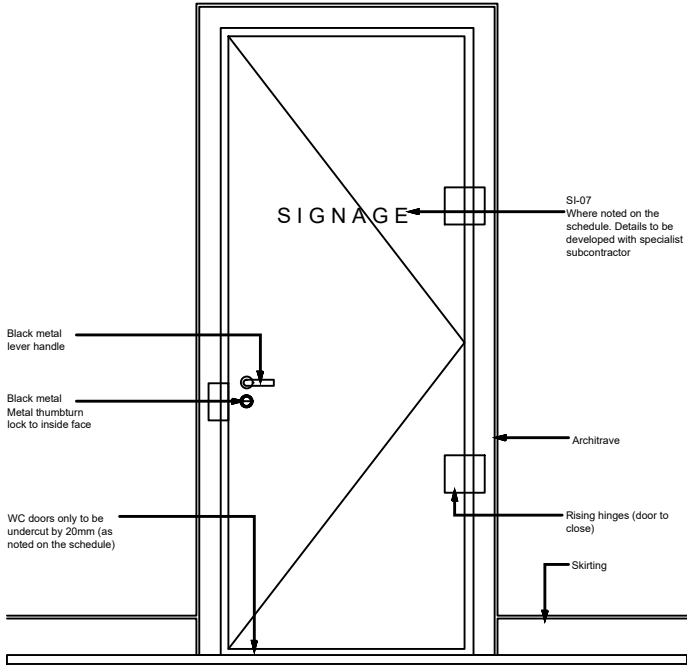

1 Type A1 : Front Elevation
1:25 @ A3

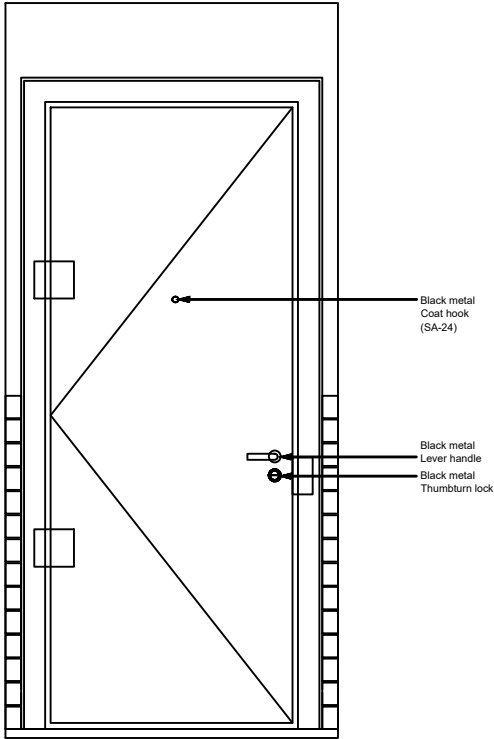

2 Type A1 : Rear Elevation
1:25 @ A3

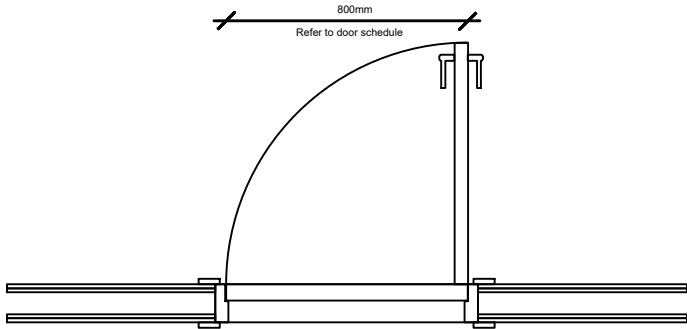

3 Type A1 : Plan
1:25 @ A3

Door Type A1 : WC Cubicle Door
Lacquered Faced Timber Door
NOTES:
44mm thick solid core door.
Fire rating: N/A
Black metal ironmongery
Signage Design TBC

Notes:

Do not scale from this drawing. All dimensions to be checked on-site by contractor to ensure accuracy prior to any installation. All design work produced by Amspec Ltd is for indicative purposes only. It is the client and contractors responsibility to ensure that building control and fire officer approval have been met prior to commencement of site work

REV:	DESCRIPTION:	BY:	DATE:
STATUS: AS BUILT			
amspec DESIGN & BUILD SOLUTIONS f : 01942 621342 f : 01942 226552 www.amspec.co.uk			
CLIENT:	OBI 80 MOSLEY STREET MANCHESTER M2 3FX		
ARCHITECT:			
SITE:	18 LOWER BYROM STREET MANCHESTER		
TITLE:	WC CUBICLE DOOR		
SCALE AT A3:	DATE:	DRAWN:	CHECKED:
1:25	02.12.19	CR	MS
PROJECT NO:	DRAWING NO:	REVISION:	
1683	02(32)402		