
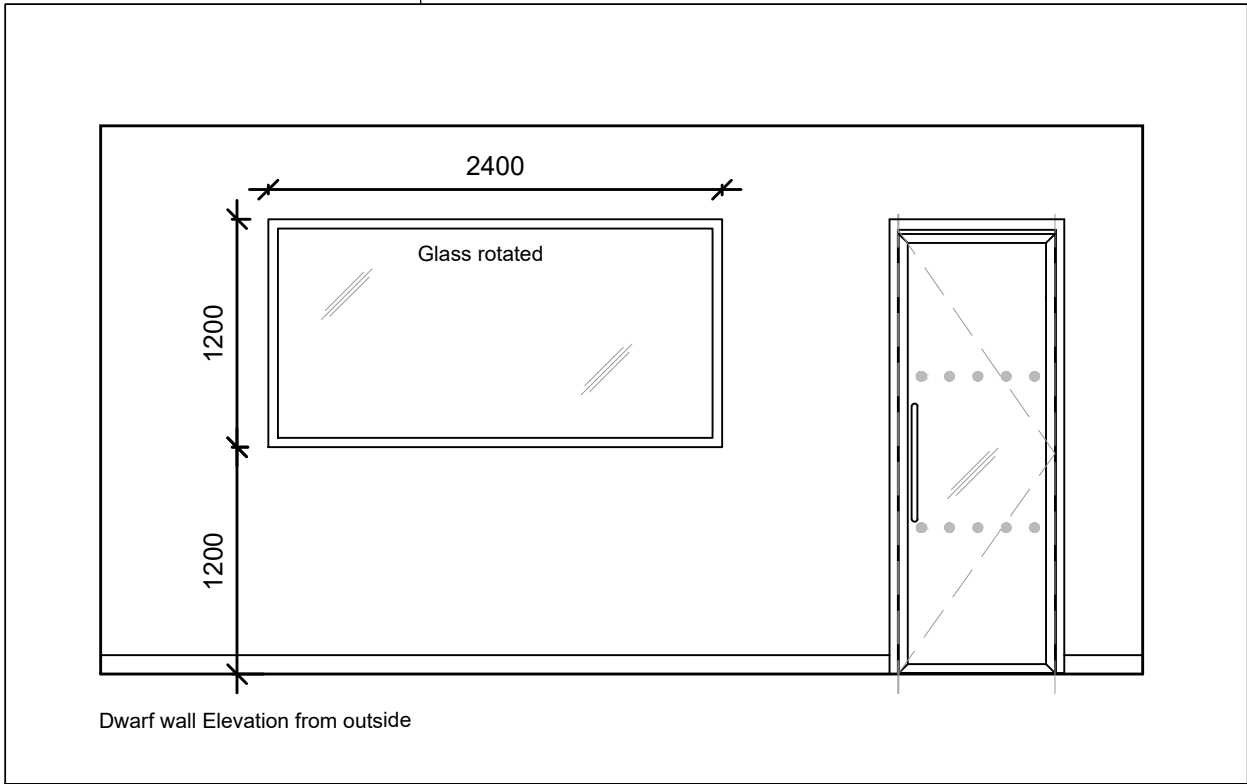


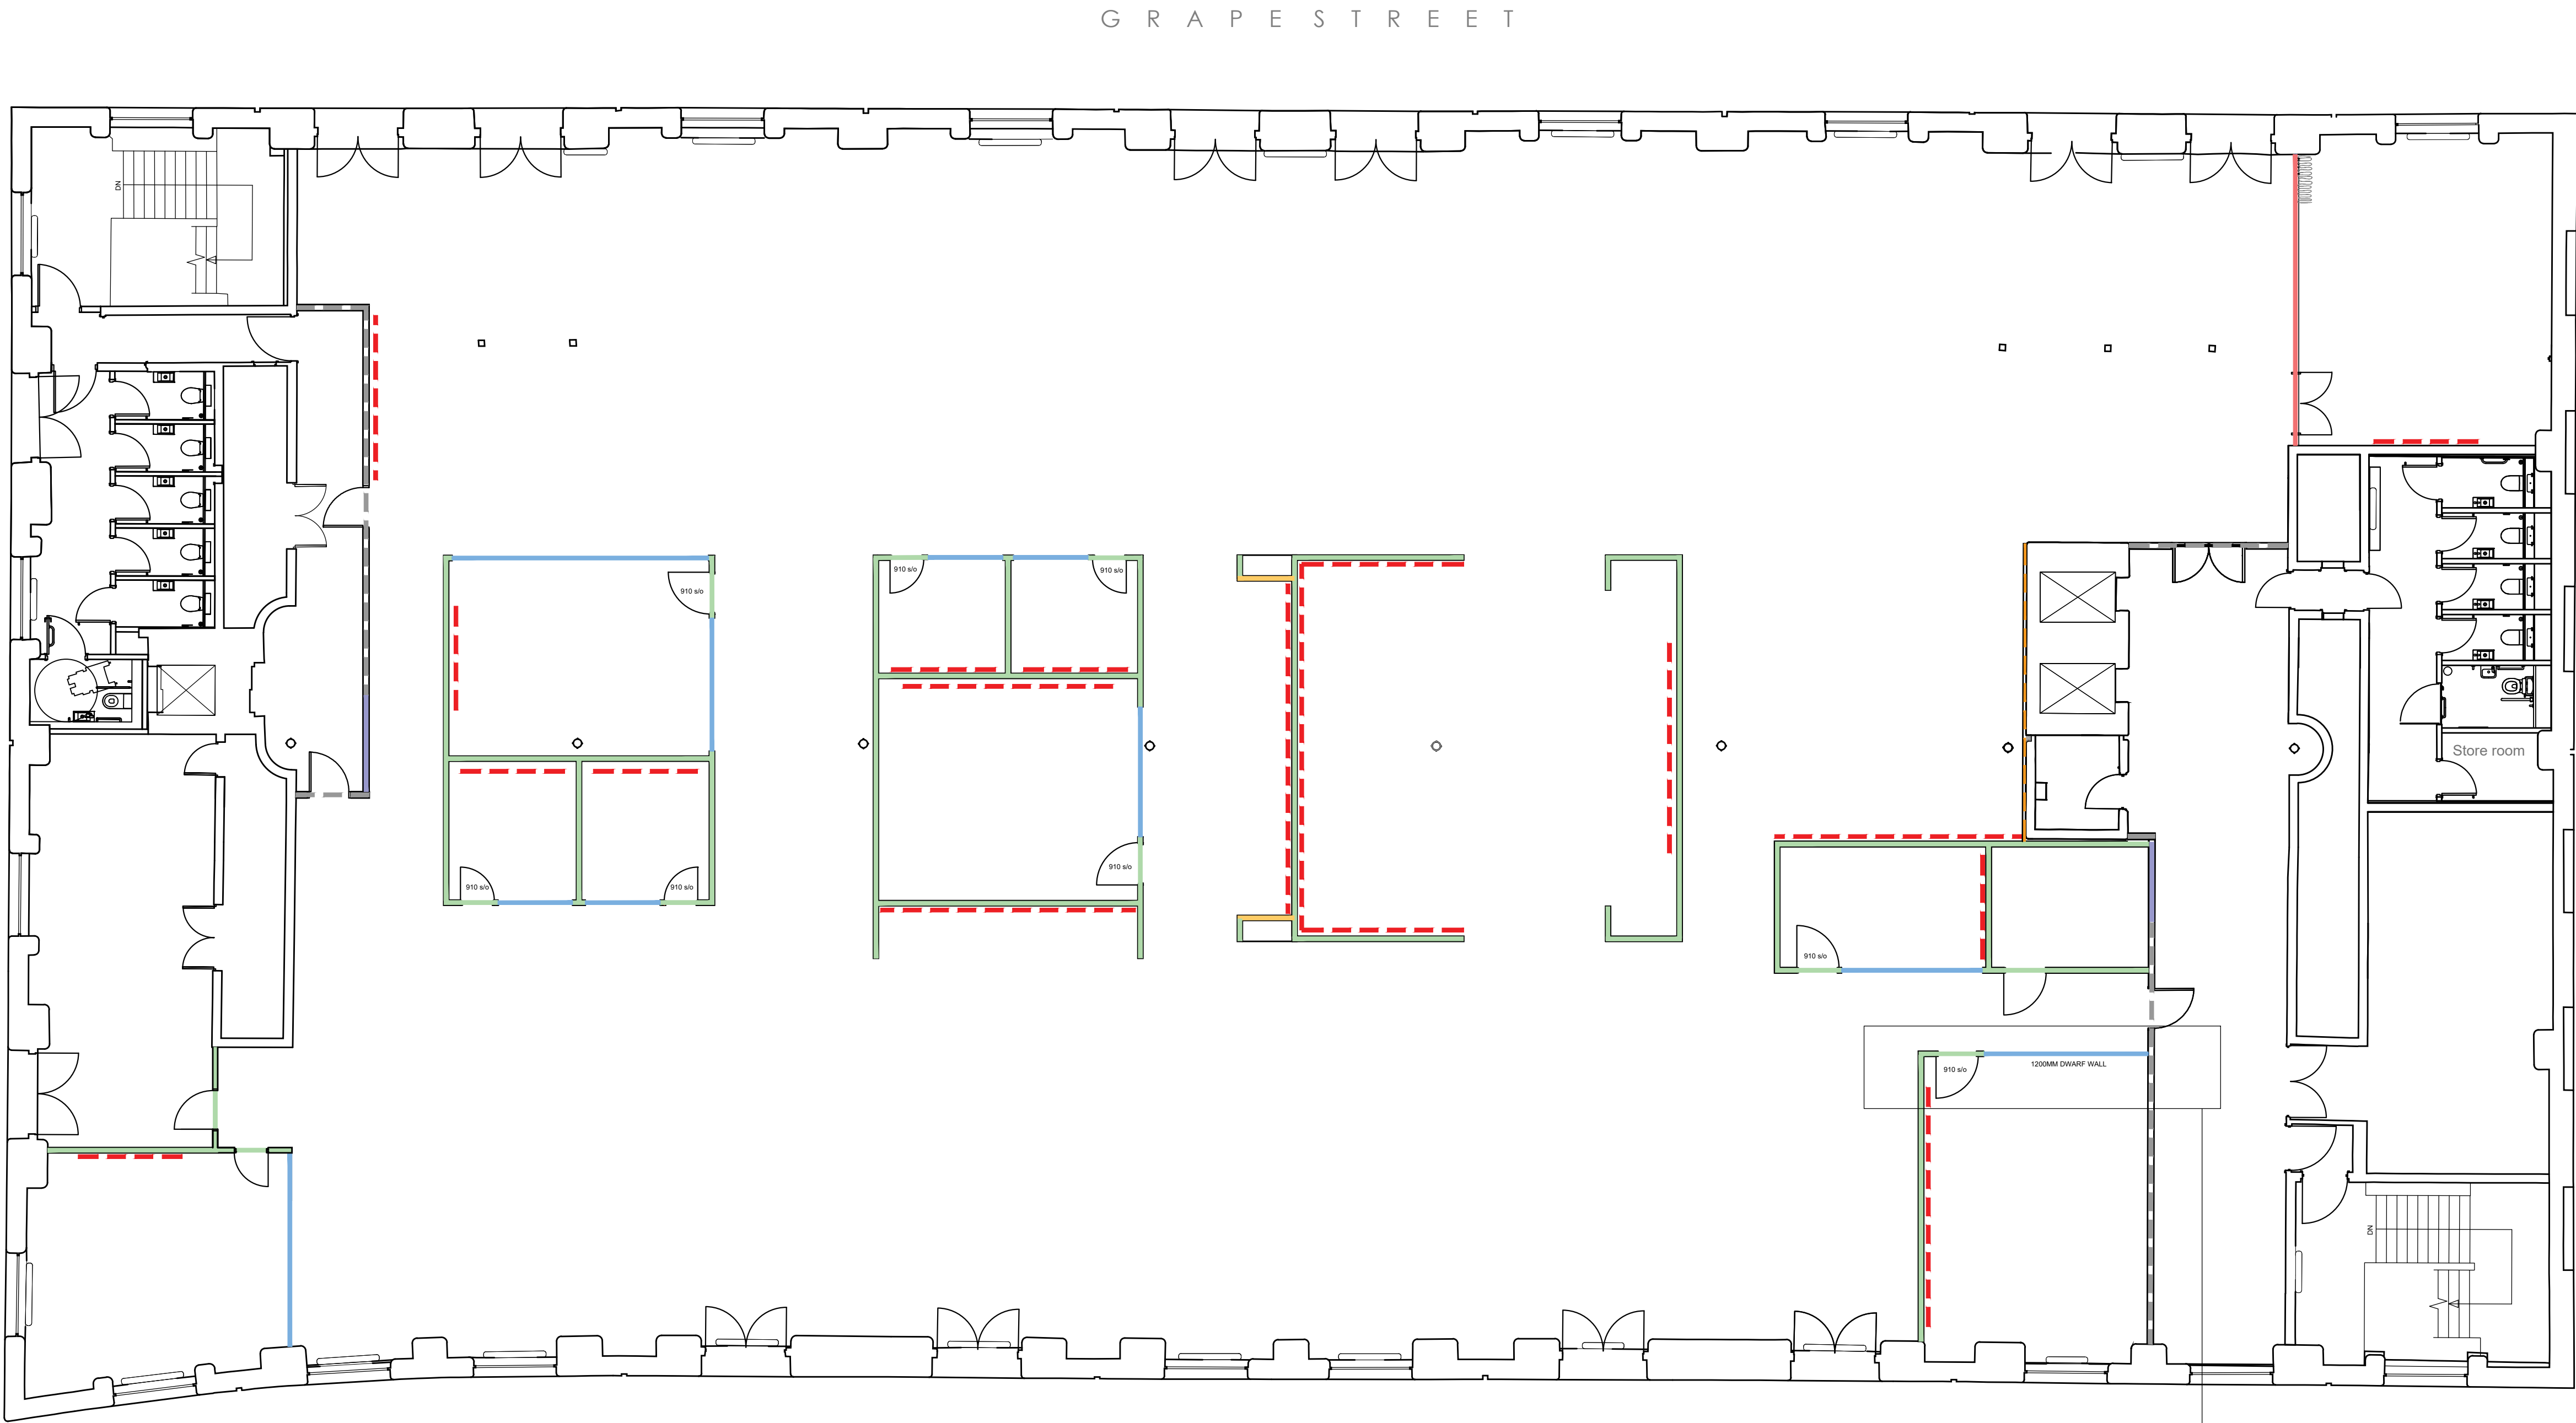

Notes:

Do not scale from this drawing. All dimensions to be checked on-site by contractor to ensure accuracy prior to any installation. All design work produced by Amspec Ltd is for indicative purposes only. It is the client and contractors responsibility to ensure that building control and fire officer approval have been met prior to commencement of site work.

Partition Types

148mm C stud, 600 centers 2 x gyproc 12.5 wall board, 25mm Isover insulation 60 min fire rating

70mm C stud, 600 centers 2 x gyproc 12.5 wall board, 25mm Isover insulation

48mm C stud, 600 centers 1 x gyproc 12.5 wall board

Single glazing with bulkhead

Double glazing with bulkhead

Pattrassing

Existing walls

18mm plywood lined partition

REV:	DESCRIPTION:	BY:	DATE:
STATUS:		AS BUILT	

amspec

DESIGN & BUILD SOLUTIONS

t : 01942 621342 f : 01942 226552

www.amspec.co.uk

CLIENT:

OBI
80 MOSLEY STREET
MANCHESTER
M2 3FX

ARCHITECT:

SITE:

18 LOWER BYROM STREET
MANCHESTER

TITLE:

LEVEL 6
PARTITION TYPES

SCALE AT A1:	DATE:	DRAWN:	CHECKED:
1:100	29.10.19	CR	IC
PROJECT NO:	DRAWING NO:	REVISION:	
1683	06(22)100		