


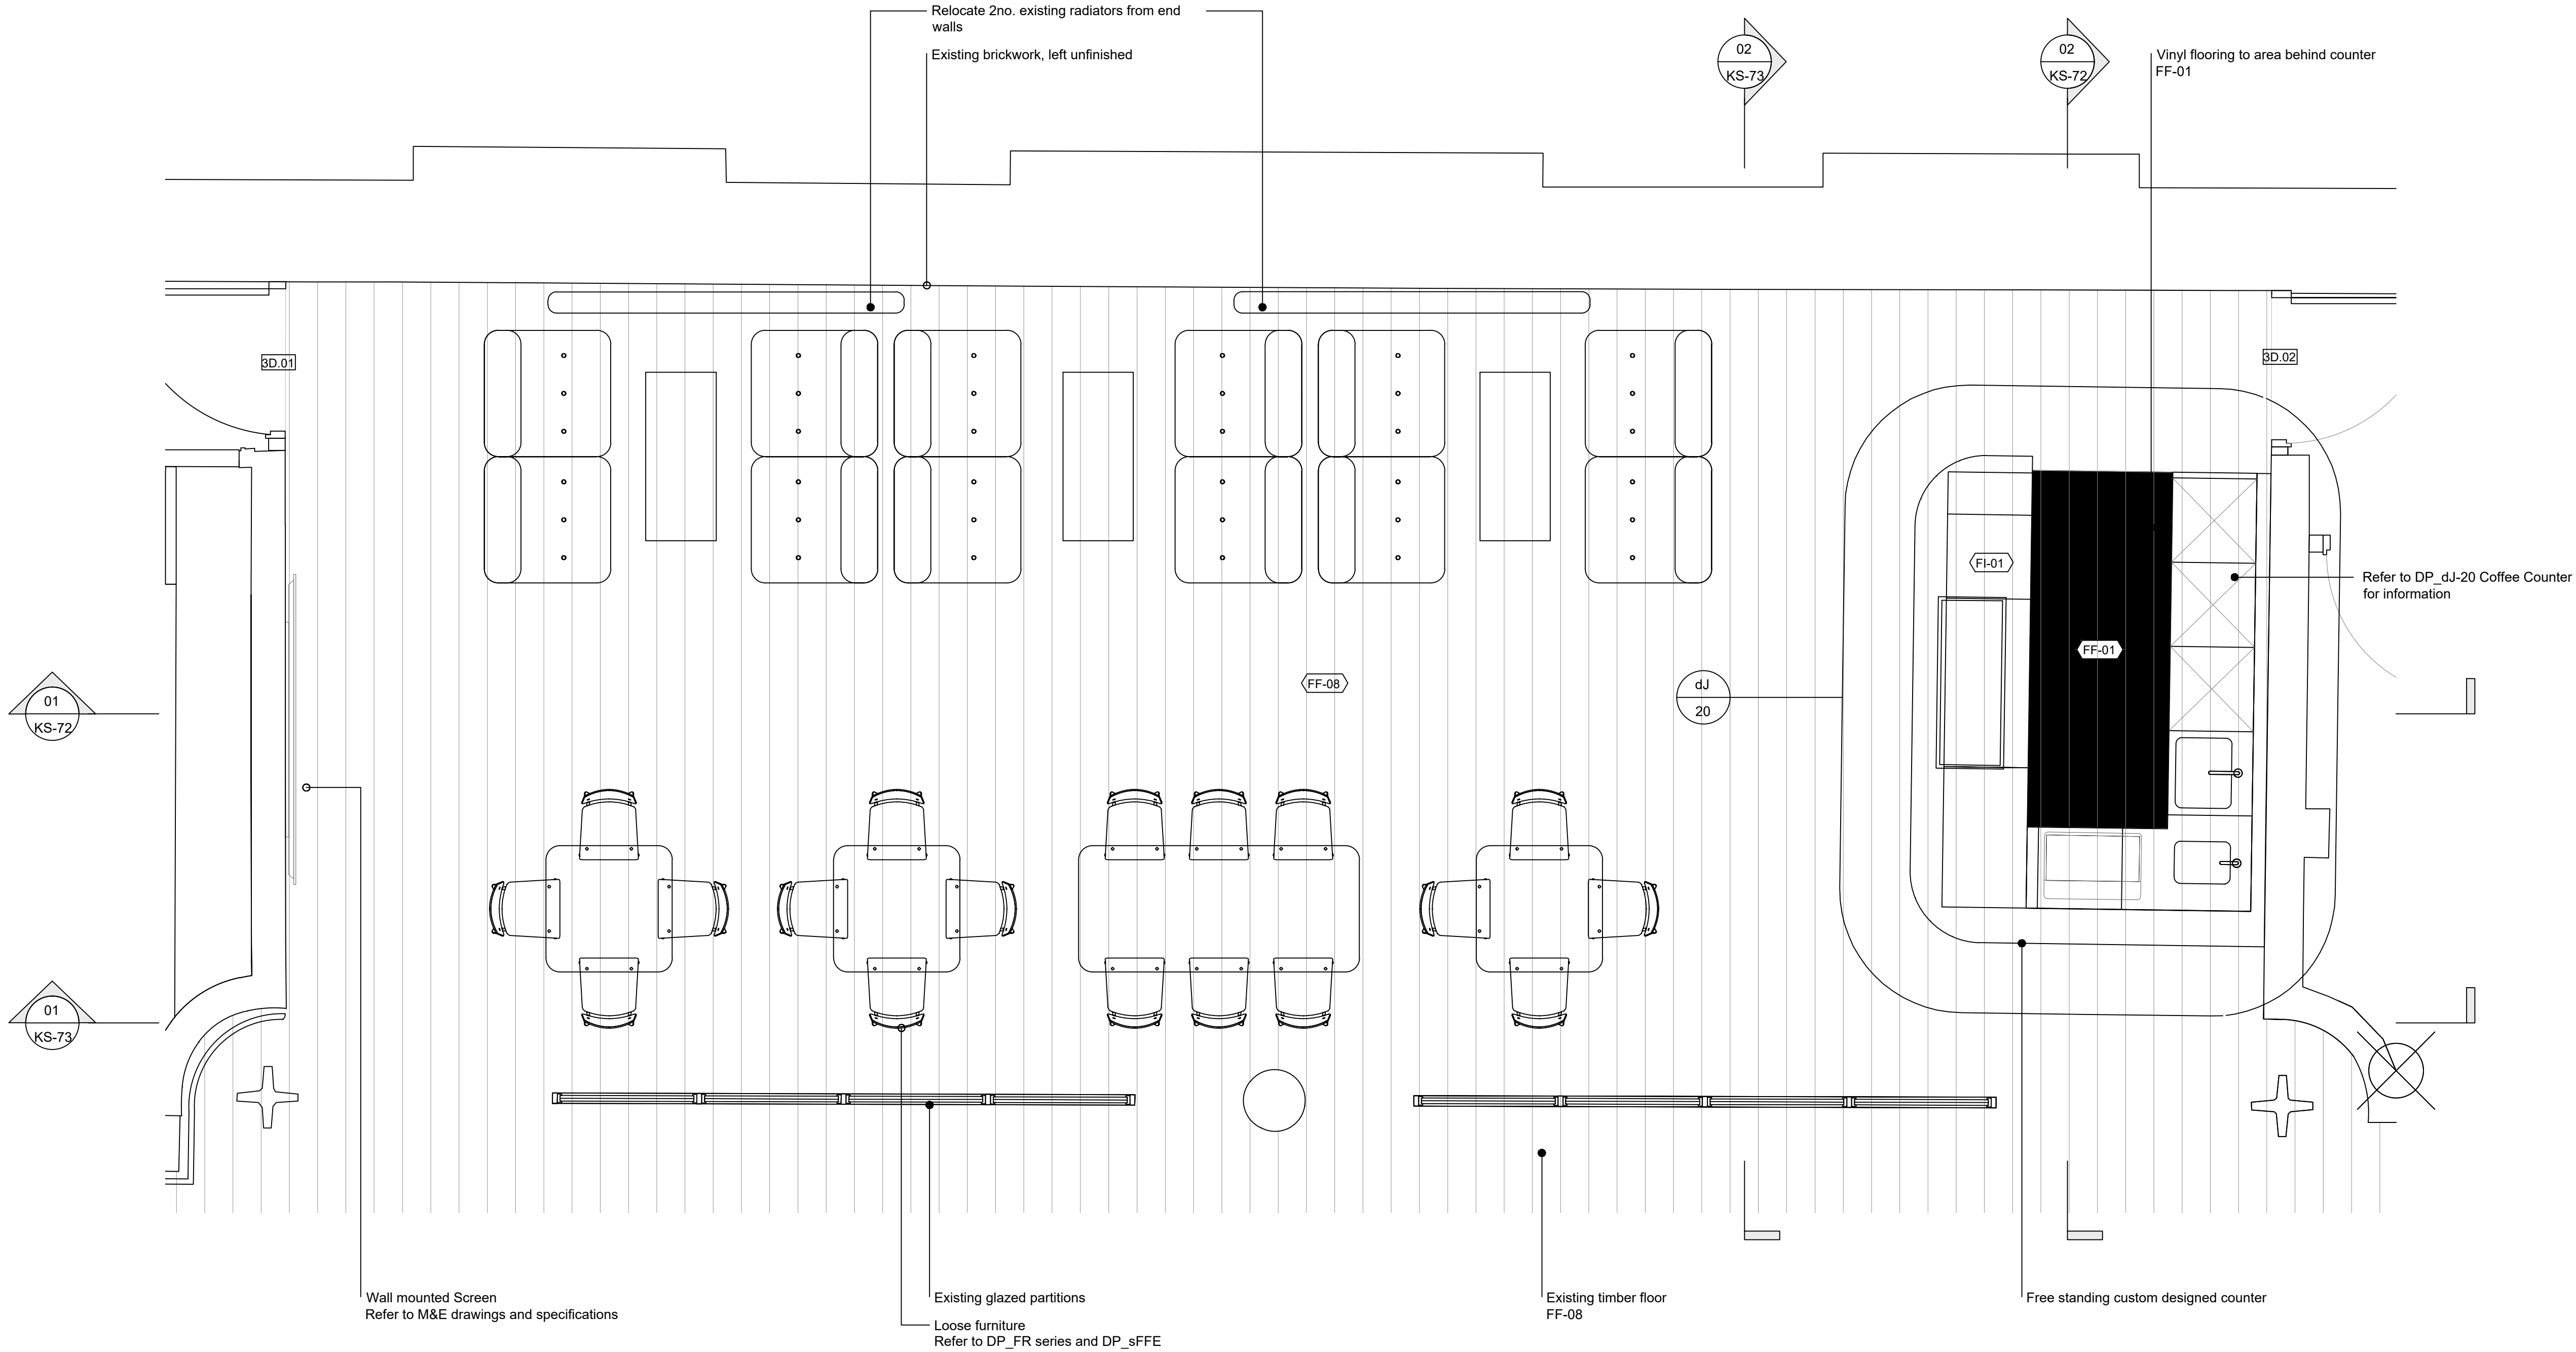

Notes:

Do not scale from this drawing. All dimensions to be checked on-site by contractor to ensure accuracy prior to any installation. All design work produced by Amspec Ltd is for indicative purposes only. It is the client and contractors responsibility to ensure that building control and fire officer approval have been met prior to commencement of site work.

Drawing Key

Refer to Lighting Schedule DP_IL

LIGHT FITTINGS

- LI-01 Mini Perleto Black Pendant
- LI-02 GU11 Tube spot Black Directional Spotlight
- LI-03 Existing linear lights

FIXTURES / FITTINGS

- FI-01 Free standing bespoke counter
- FI-02 Menu signage

CEILING TYPES

- CL-03 Existing exposed brick soffit and steel beams

FLOOR FINISHES

- FF-01 Altro Suprema Loam SU2047 safety flooring
- FF-08 Existing timber floor

REV:	DESCRIPTION:	BY:	DATE:
------	--------------	-----	-------

STATUS: AS BUILT



CLIENT: OBI
80 MOSELY STREET
MANCHESTER
M2 3FX

ARCHITECT:

SITE: 18 LOWER BYROM STREET
MANCHESTER

TITLE: RECEPTION COFFEE PLAN

SCALE AT A1: 1:25	DATE: 27.06.19	DRAWN: CR	CHECKED: IC
PROJECT NO: 1683	DRAWING NO: DP_KS-70	REVISION:	