



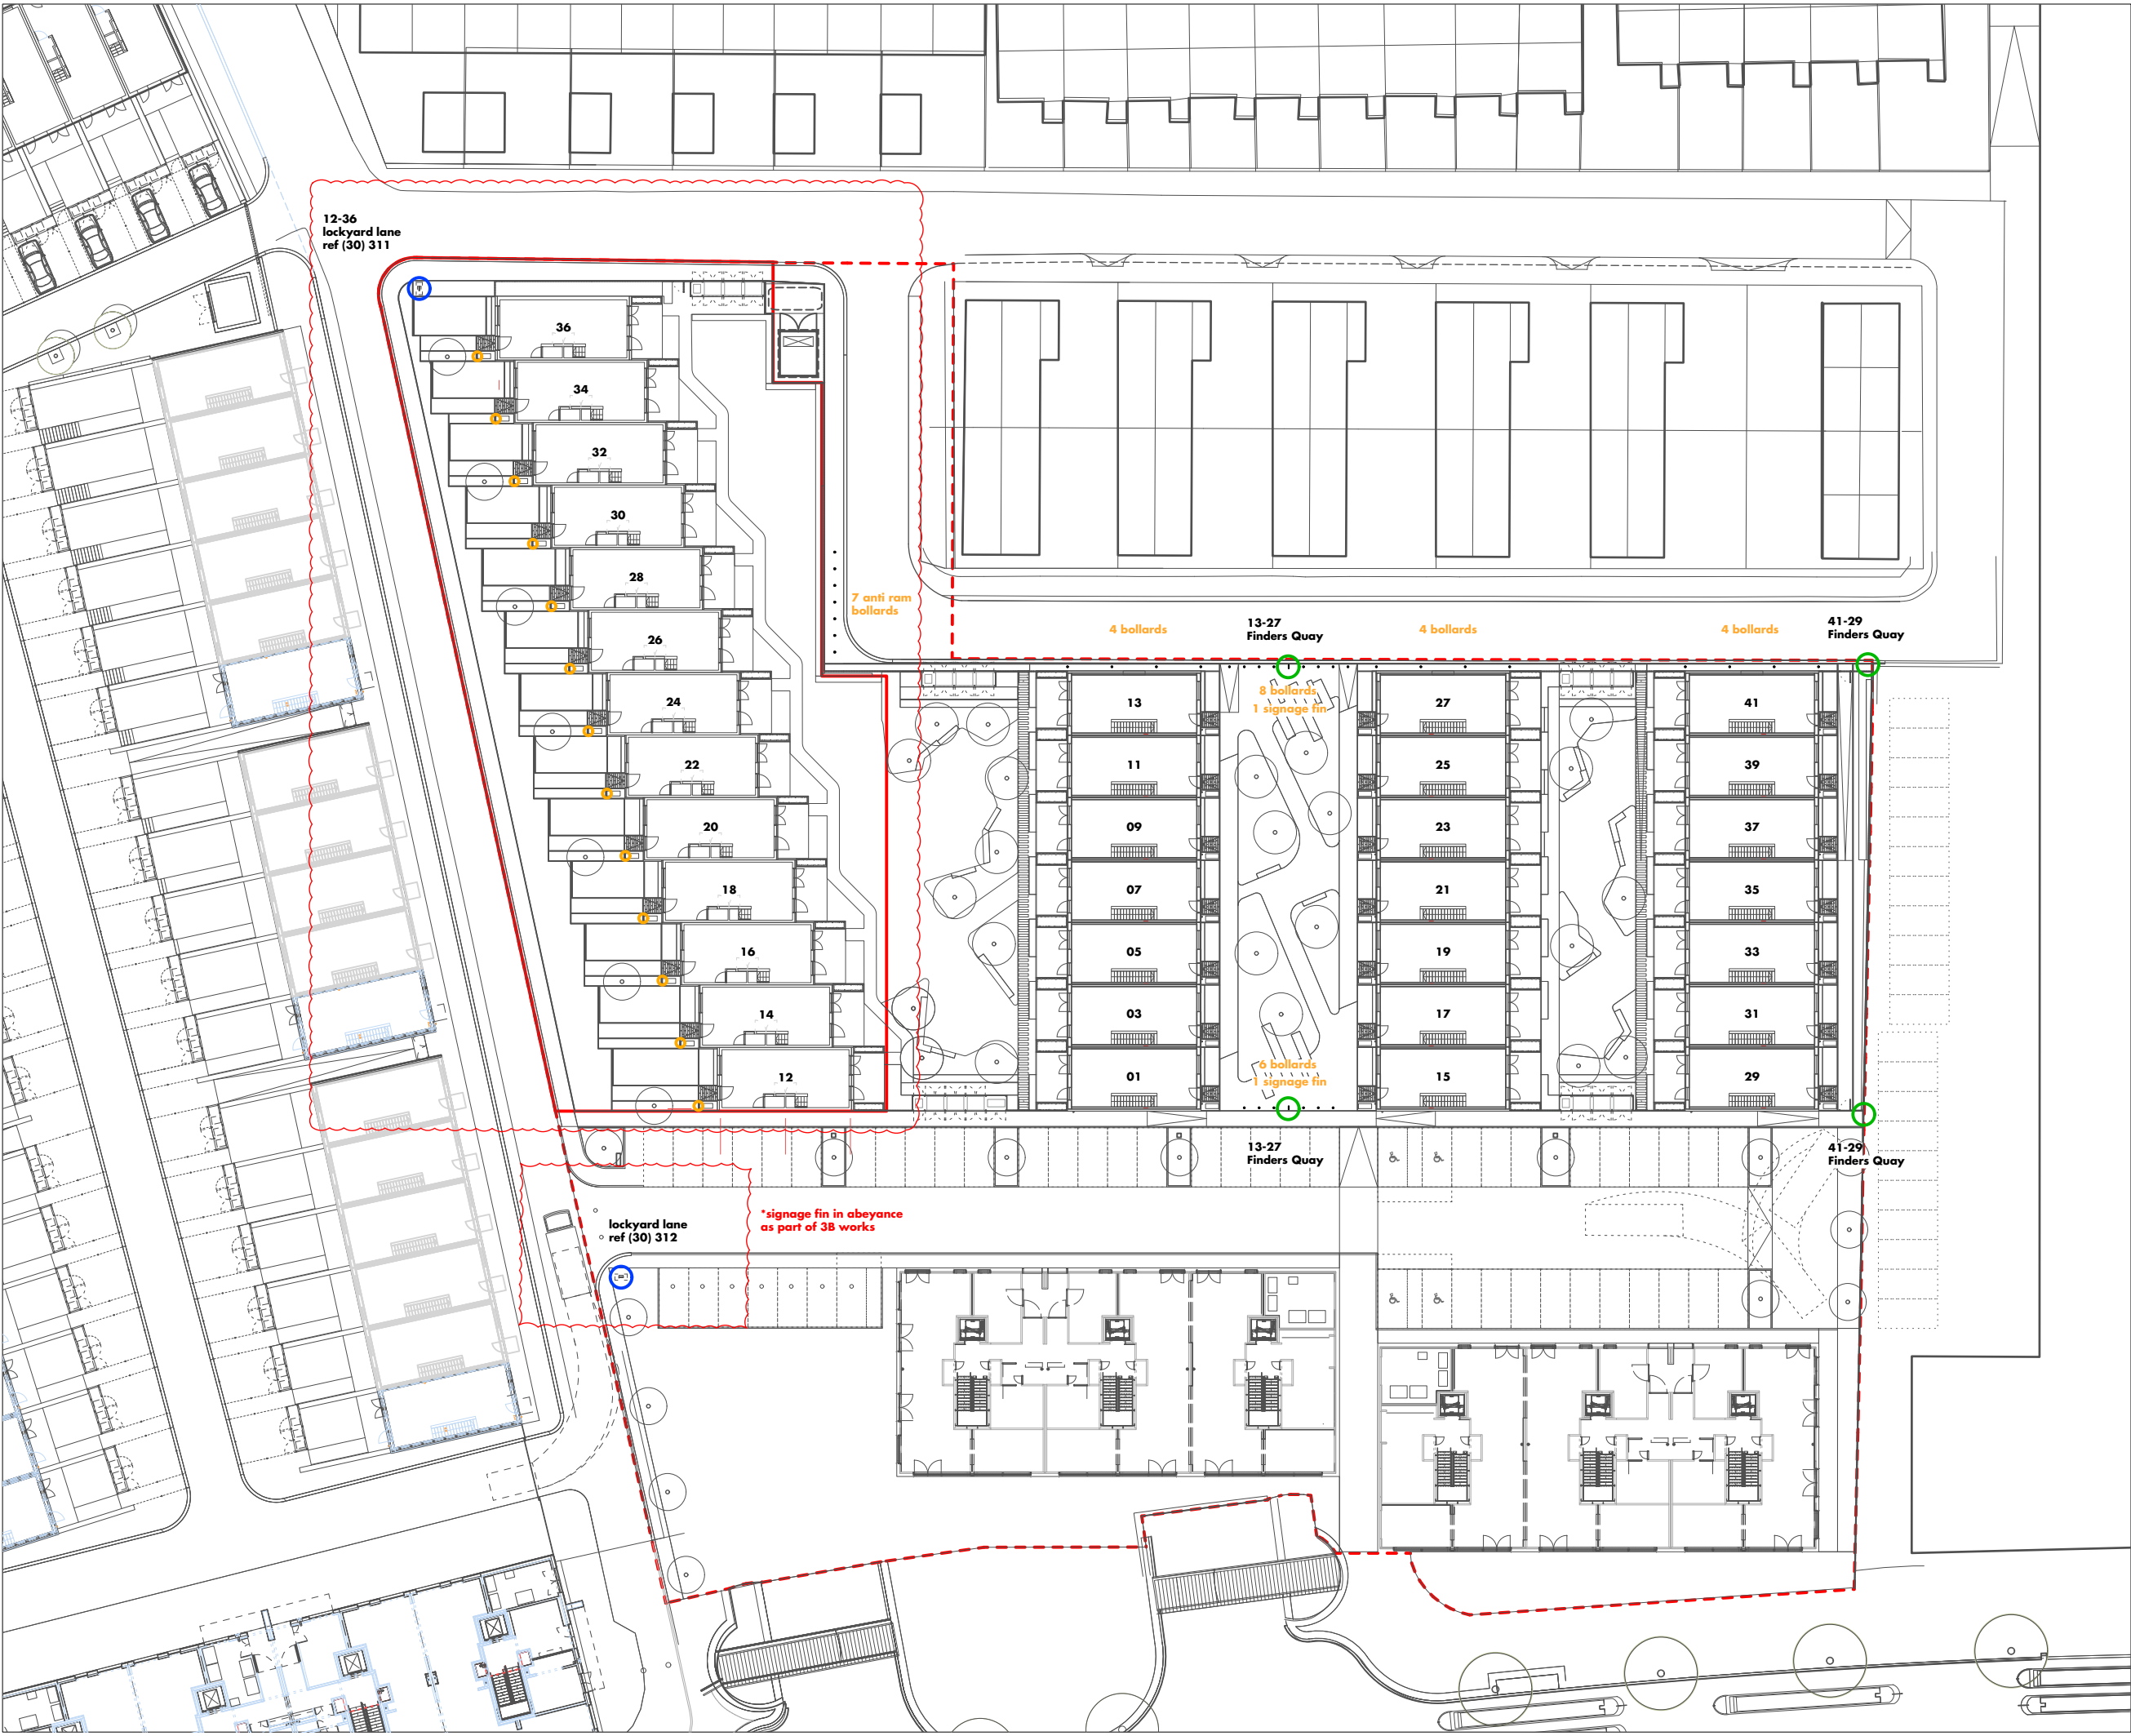

- street signage position
 - phase A street signage
 - plot signage/number
 - NI3C first phase site works
 - NI3 complete site red line
- notes**
- for street signage elevation refer (30) 311 + 312
 - for house signage refer (30) 301
 - for site GAs refer to NI3 [00] series drawings
 - for terrace GAs refer to NI3 [10] series drawings
 - for plot GAs refer to NI3 [20] series drawings
 - for meter cabinets refer to NI3 [30] 000 series drawings
 - * street signage to be coordinated alongside landscape design

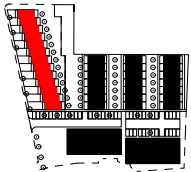

b • construction update - lockyard lane	21 04 21 • hw • rt
a • construction issue	16 04 21 • hw • rt
• first issue	12 03 21 • hw • rt
rev • description	issued • drawn • checked
+44 (0)151 709 8211	
+44 (0)207 253 8881	
project	NI3 C
client	urban splash
drawing number	NI3 C [30] 310 b
scale	1:500 @ a3
status	construction
street signage - site plan	
do not scale from this drawing • all dimensions are to be set out and checked on site prior to starting construction • any discrepancy found between information given on this drawing and that given elsewhere or recorded on site shall be brought to the attention of the project architect immediately	