




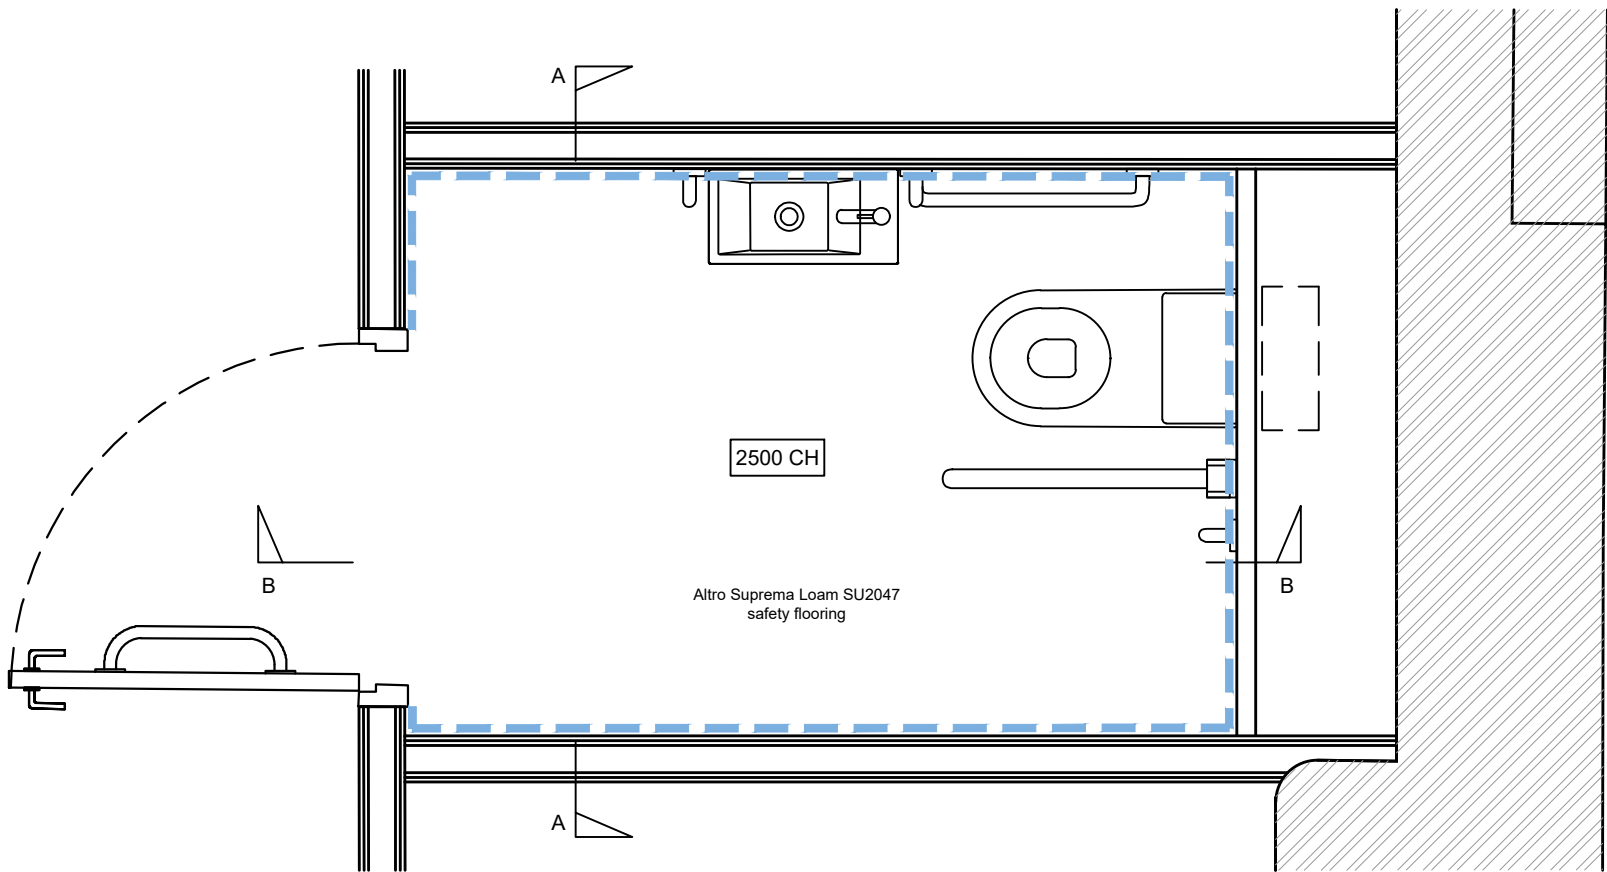

Plan
Scale 1:20

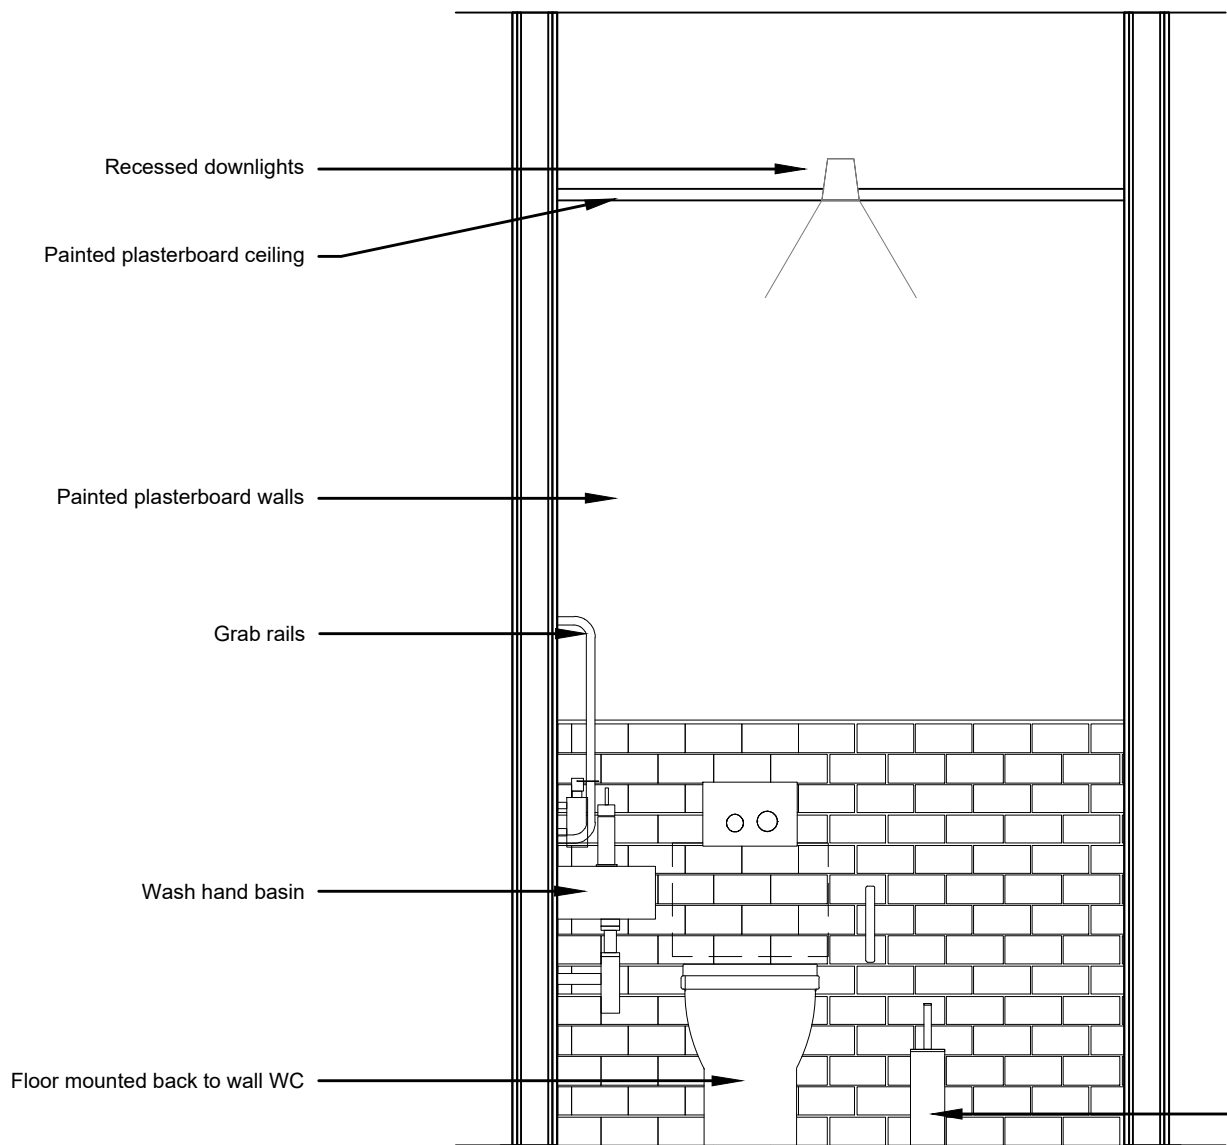

Section A-A
Scale 1:20

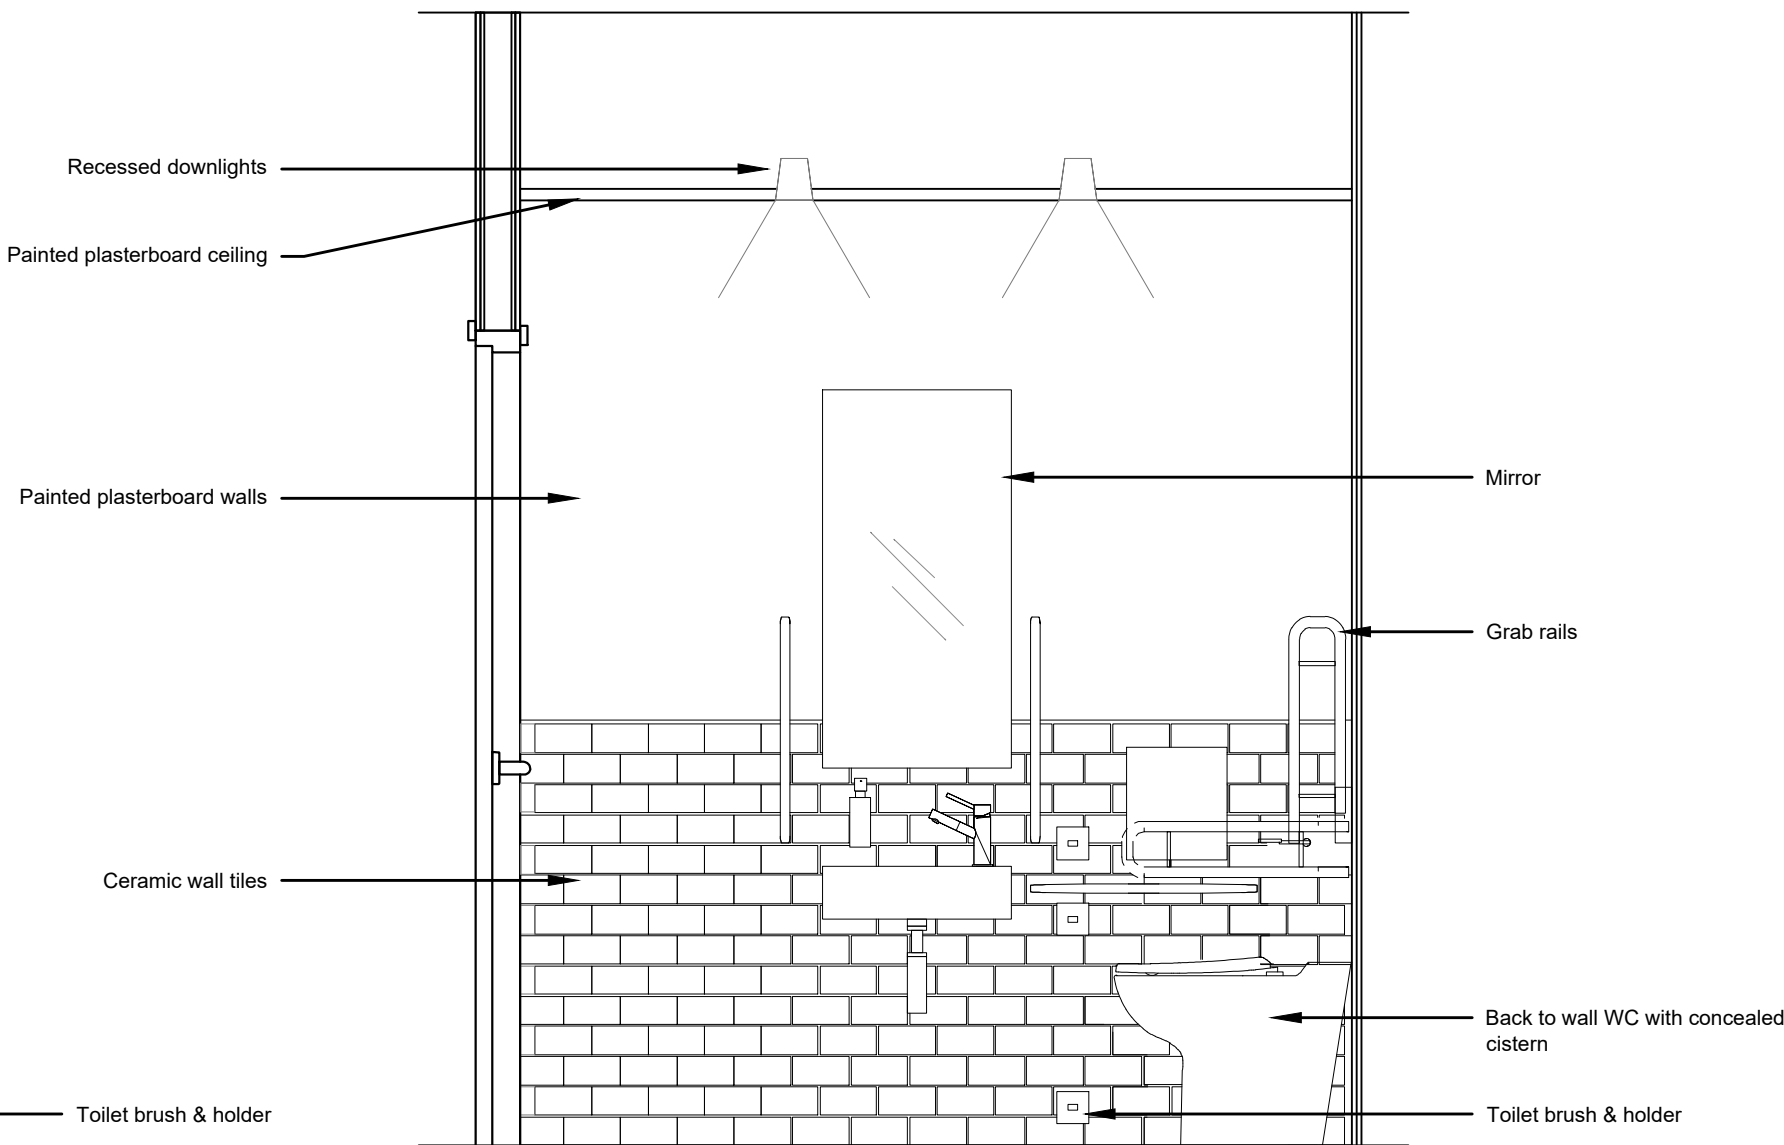


Section B-B
Scale 1:20

Notes:

Do not scale from this drawing. All dimensions to be checked on-site by contractor to ensure accuracy prior to any installation. All design work produced by Amspec Ltd is for indicative purposes only. It is the client and contractors responsibility to ensure that building control and fire officer approval have been met prior to commencement of site work.

Materials	Description
Ceiling finish:	Ceiling finished to RAL 9010 pure white
Tile finish:	Solus ceramics diffusion 150x75mm glazed tiles Hesket gloss tile 5VEL107 (green) Dawen gloss 5VEL101 (cream)
Wall finish:	Walls finished to RAL 9010 pure white
Floor finish:	Altro Suprema Loam SU2047 safety flooring
Ceiling lights:	Flush recessed LED spotlights white flush frame
WC:	Duravit Stark 3 floor standing DDA compliant WC with concealed cistern and frame. White ceramic
Push plate:	Geberit Sigma 50 dual flush push plate Jet black RAL 9005
WHB:	Catalano Verso 50 wash hand basin wall mounted white ceramic with Hansgrohe s/s bottle trap waste
Tap:	Ideal standard Ceramix blue single lever basin mixer Satin stainless steel
Paper towel dispenser:	Dolphin DP3104 satin stainless steel wall mounted DDA compliant paper towel dispenser
Grab rails:	Allgood D line FSB ergosystem grab rail doc m pack black
Soap dispenser:	Dolphin DP1104 satin stainless steel wall mounted DDA compliant soap dispenser
Toilet roll holder:	Dolphin BC271-1 stainless steel toilet roll holder
Toilet brush:	Dolphin BC9387 stainless steel toilet brush and holder

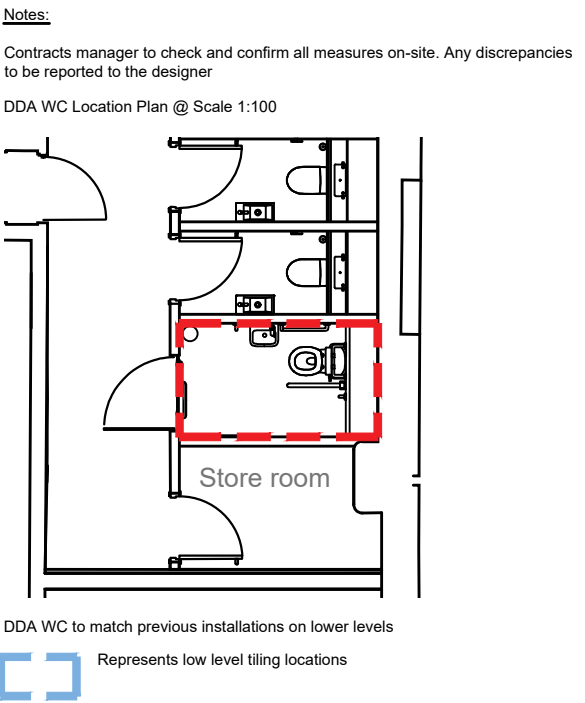

REV:	DESCRIPTION:	BY:	DATE:
STATUS:	AS BUILT		
CLIENT:	OBI 80 MOSLEY STREET MANCHESTER M2 3FX		
ARCHITECT:			
SITE:	18 LOWER BYROM STREET MANCHESTER		
TITLE:	LEVEL 6 DDA WC		
SCALE AT A2:	DATE:	DRAWN:	CHECKED:
1:20	11.11.19	CR	MS
PROJECT NO:	DRAWING NO:		REVISION:
1683	06(74)400		