


Door Type E7 : Internal glazed pivot doors to Meeting Rooms on Level 02


GENERAL NOTE

To be read in conjunction with Schedule of Works, Door Schedule and GA plans.

DOOR 2D.01
TO SUIT EXISTING OPENING 870 X 2300MM APPROX
METAL GLAZED FINISH
RAL TBC
LOCK, CARD READER ACCESS CONTROL
NO FIRE RATING

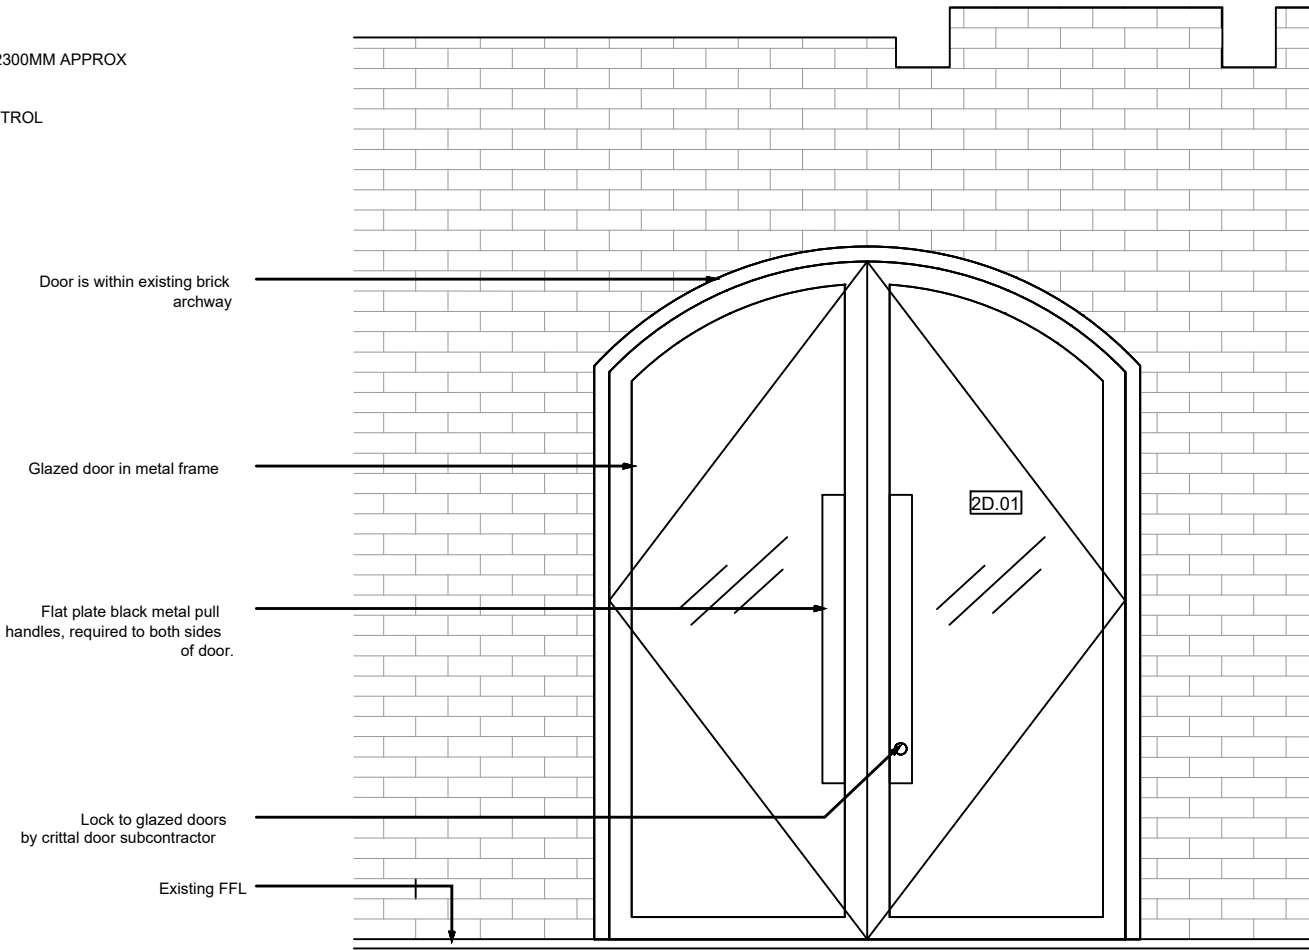

1 Type E7 : Front Elevation
1:25 @ A3

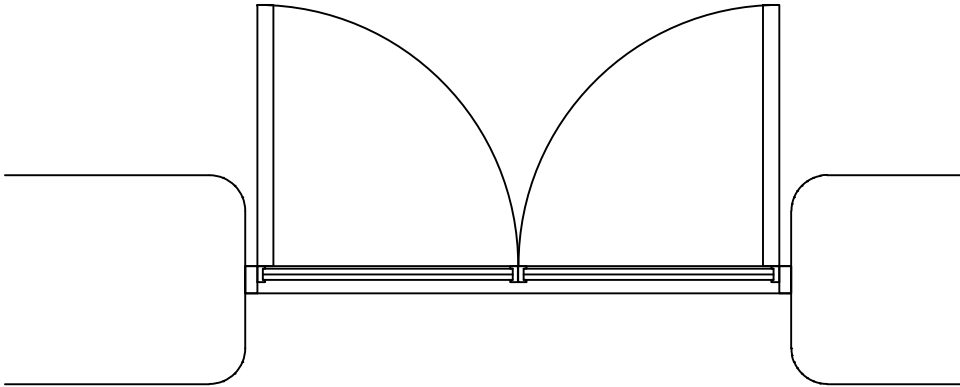

3 Type E7 : Plan
1:25 @ A3

Door Type E7 : Internal Glazed Doors to existing brick archway

Metal glazed doors. PPC coating, RAL 9005

All ironmongery to be by specialist subcontractor

Note:

Drawing shows design intent only. Final Proposals/Layout for Crittall-Style Glazed Doors and Partitions are to be developed with the specialist subcontractor and approved by the Architect before manufacture

Notes:

Do not scale from this drawing. All dimensions to be checked on-site by contractor to ensure accuracy prior to any installation. All design work produced by Amspec Ltd is for indicative purposes only. It is the client and contractors responsibility to ensure that building control and fire officer approval have been met prior to commencement of site work

REV:	DESCRIPTION:	BY:	DATE:
STATUS: AS BUILT			
amspec DESIGN & BUILD SOLUTIONS f : 01942 621342 f : 01942 226552 www.amspec.co.uk			
CLIENT:	OBI 80 MOSLEY STREET MANCHESTER M2 3FX		
ARCHITECT:			
SITE:	18 LOWER BYROM STREET MANCHESTER		
TITLE:	LOBBY DOOR		
SCALE AT A3:	DATE:	DRAWN:	CHECKED:
1:25	02.12.19	CR	MS
PROJECT NO:	DRAWING NO:	REVISION:	
1683	02(32)405		