


Elevation A
Scale 1:10

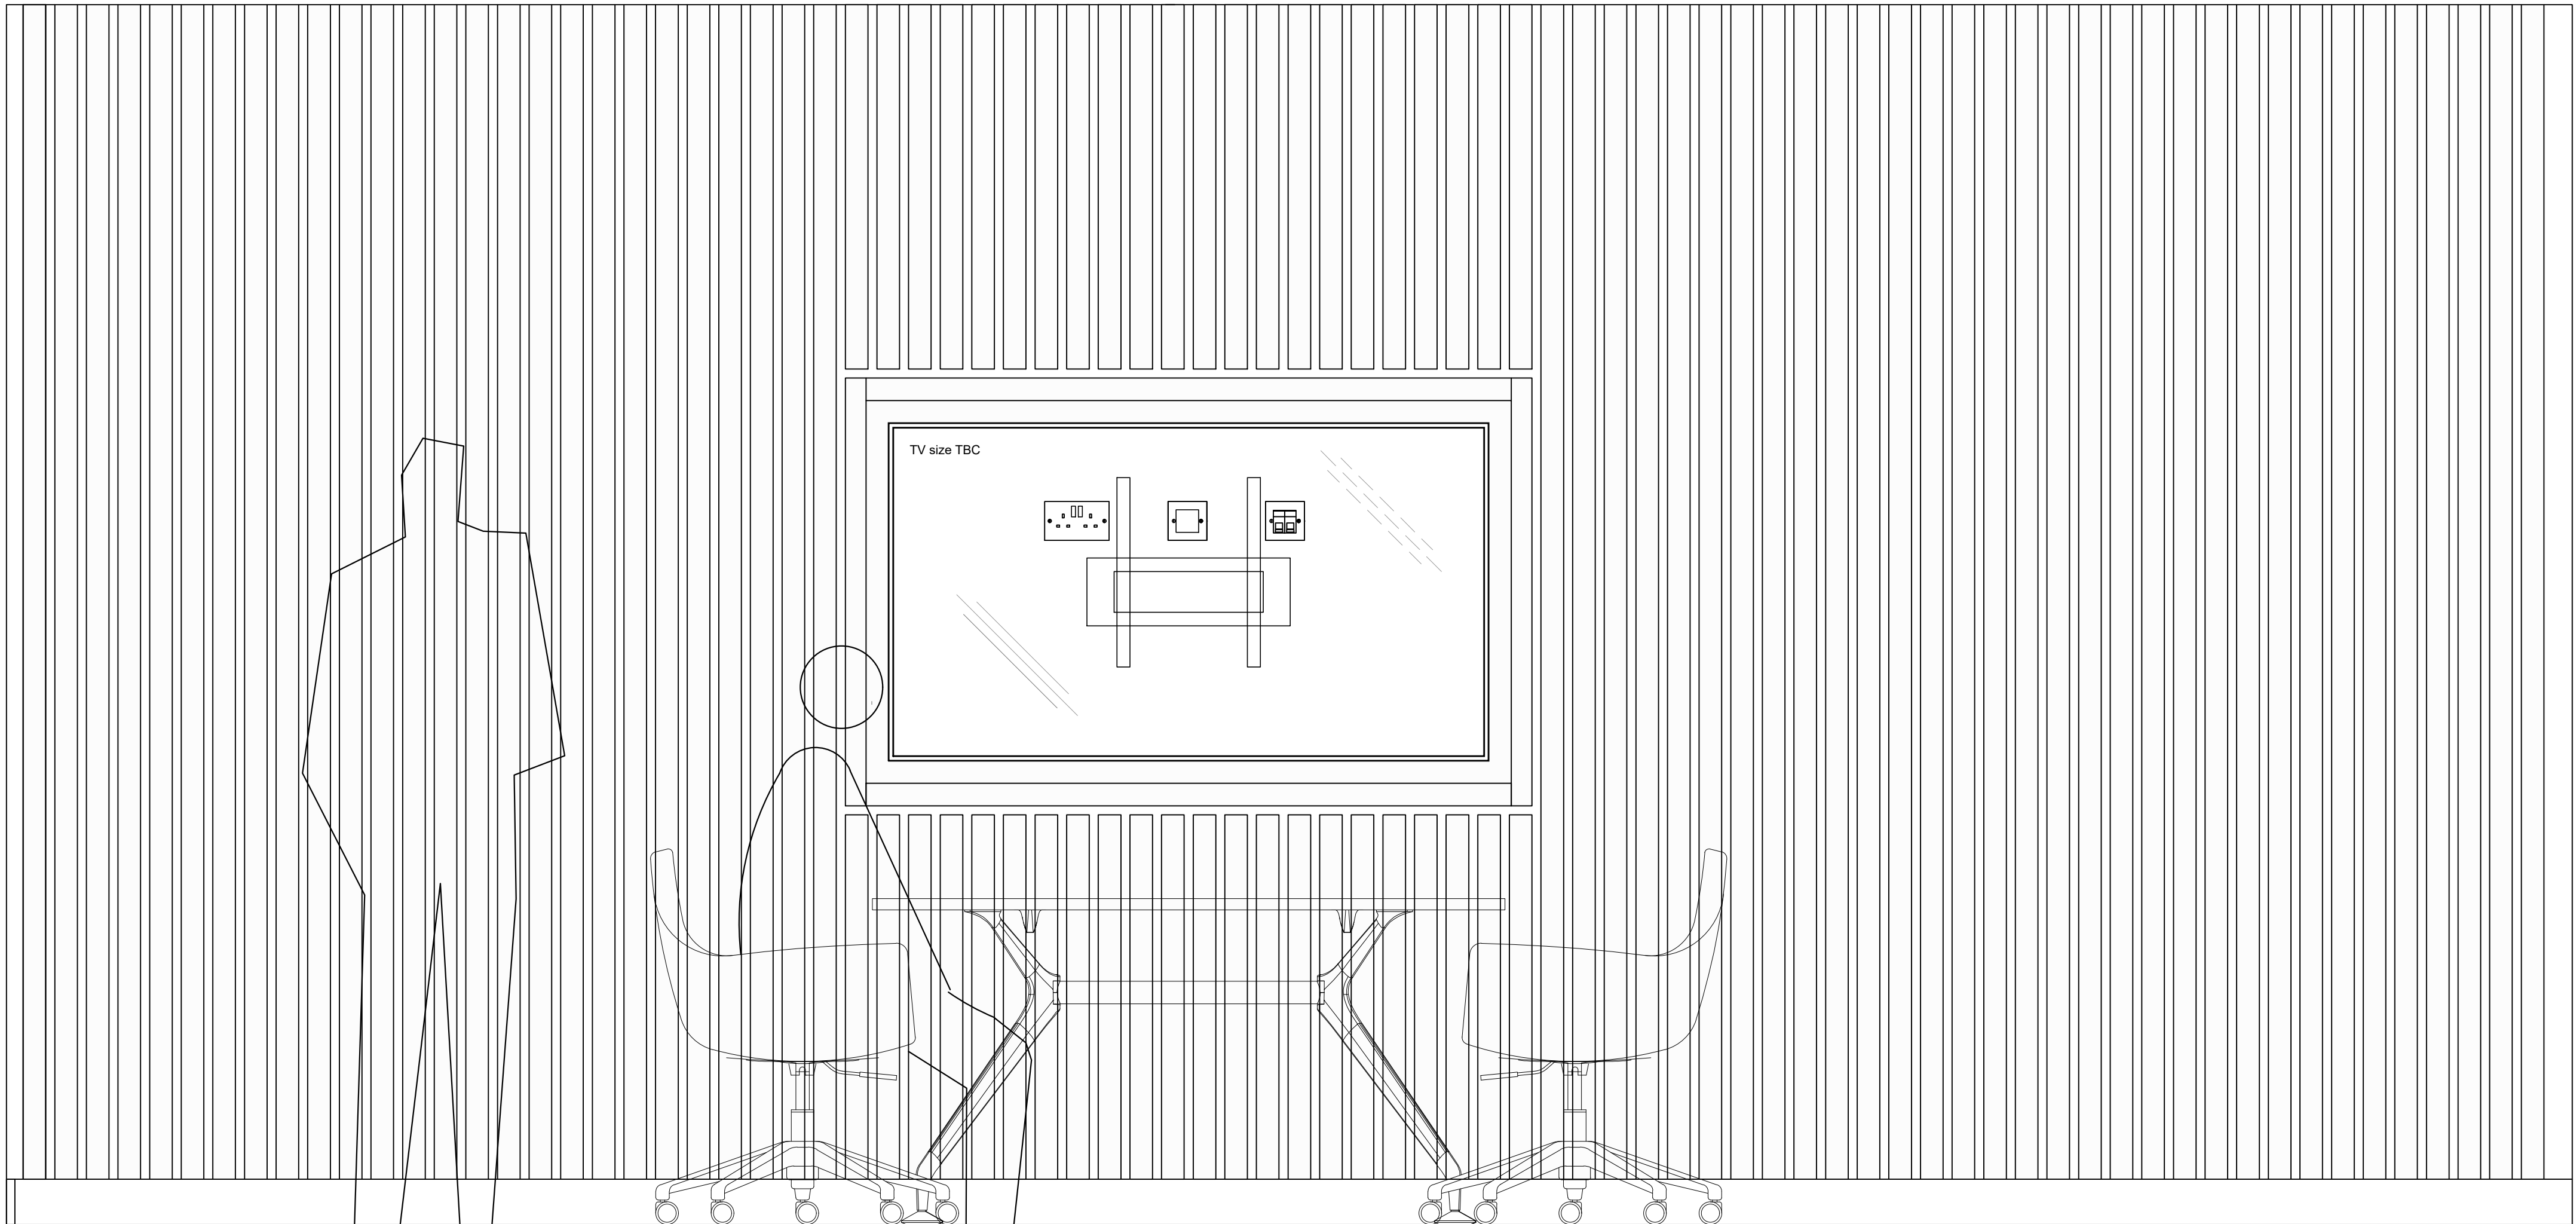

Notes:

Do not scale from this drawing. All dimensions to be checked on-site by contractor to ensure accuracy prior to any installation. All design work produced by Amspec Ltd is for indicative purposes only. It is the client and contractors responsibility to ensure that building control and fire officer approval have been met prior to commencement of site work

Materials	Description
Timber slats:	50mm MRMDF Oak veneer with edging to match at profiles of 100x50mm
Backing board:	18mm MRMDF sprayed to RAL 9011 Graphite Grey

Notes:

Contracts manager to check and confirm all measures on-site. Any discrepancies to be reported to the designer

Anthropometric Data

Average sitting height
Male = 1340mm
Female = 1280

Average standing height
Male = 1740mm
Female = 1650mm

18mm plywood pattress

REV:	DESCRIPTION:	BY:	DATE:
STATUS:	AS BUILT		
 DESIGN & BUILD SOLUTIONS t : 01942 621342 f : 01942 226552 www.amspec.co.uk			
CLIENT:	OBI 80 MOSLEY STREET MANCHESTER M2 3FX		
ARCHITECT:			
SITE:	18 LOWER BYROM STREET MANCHESTER		
TITLE:	LEVEL 6 BOARDROOM TV WALL		
SCALE AT A1:	DATE:	DRAWN:	CHECKED:
1:10	16.01.20	CR	MS
PROJECT NO:	DRAWING NO:	REVISION:	
1683	06(22)401		