




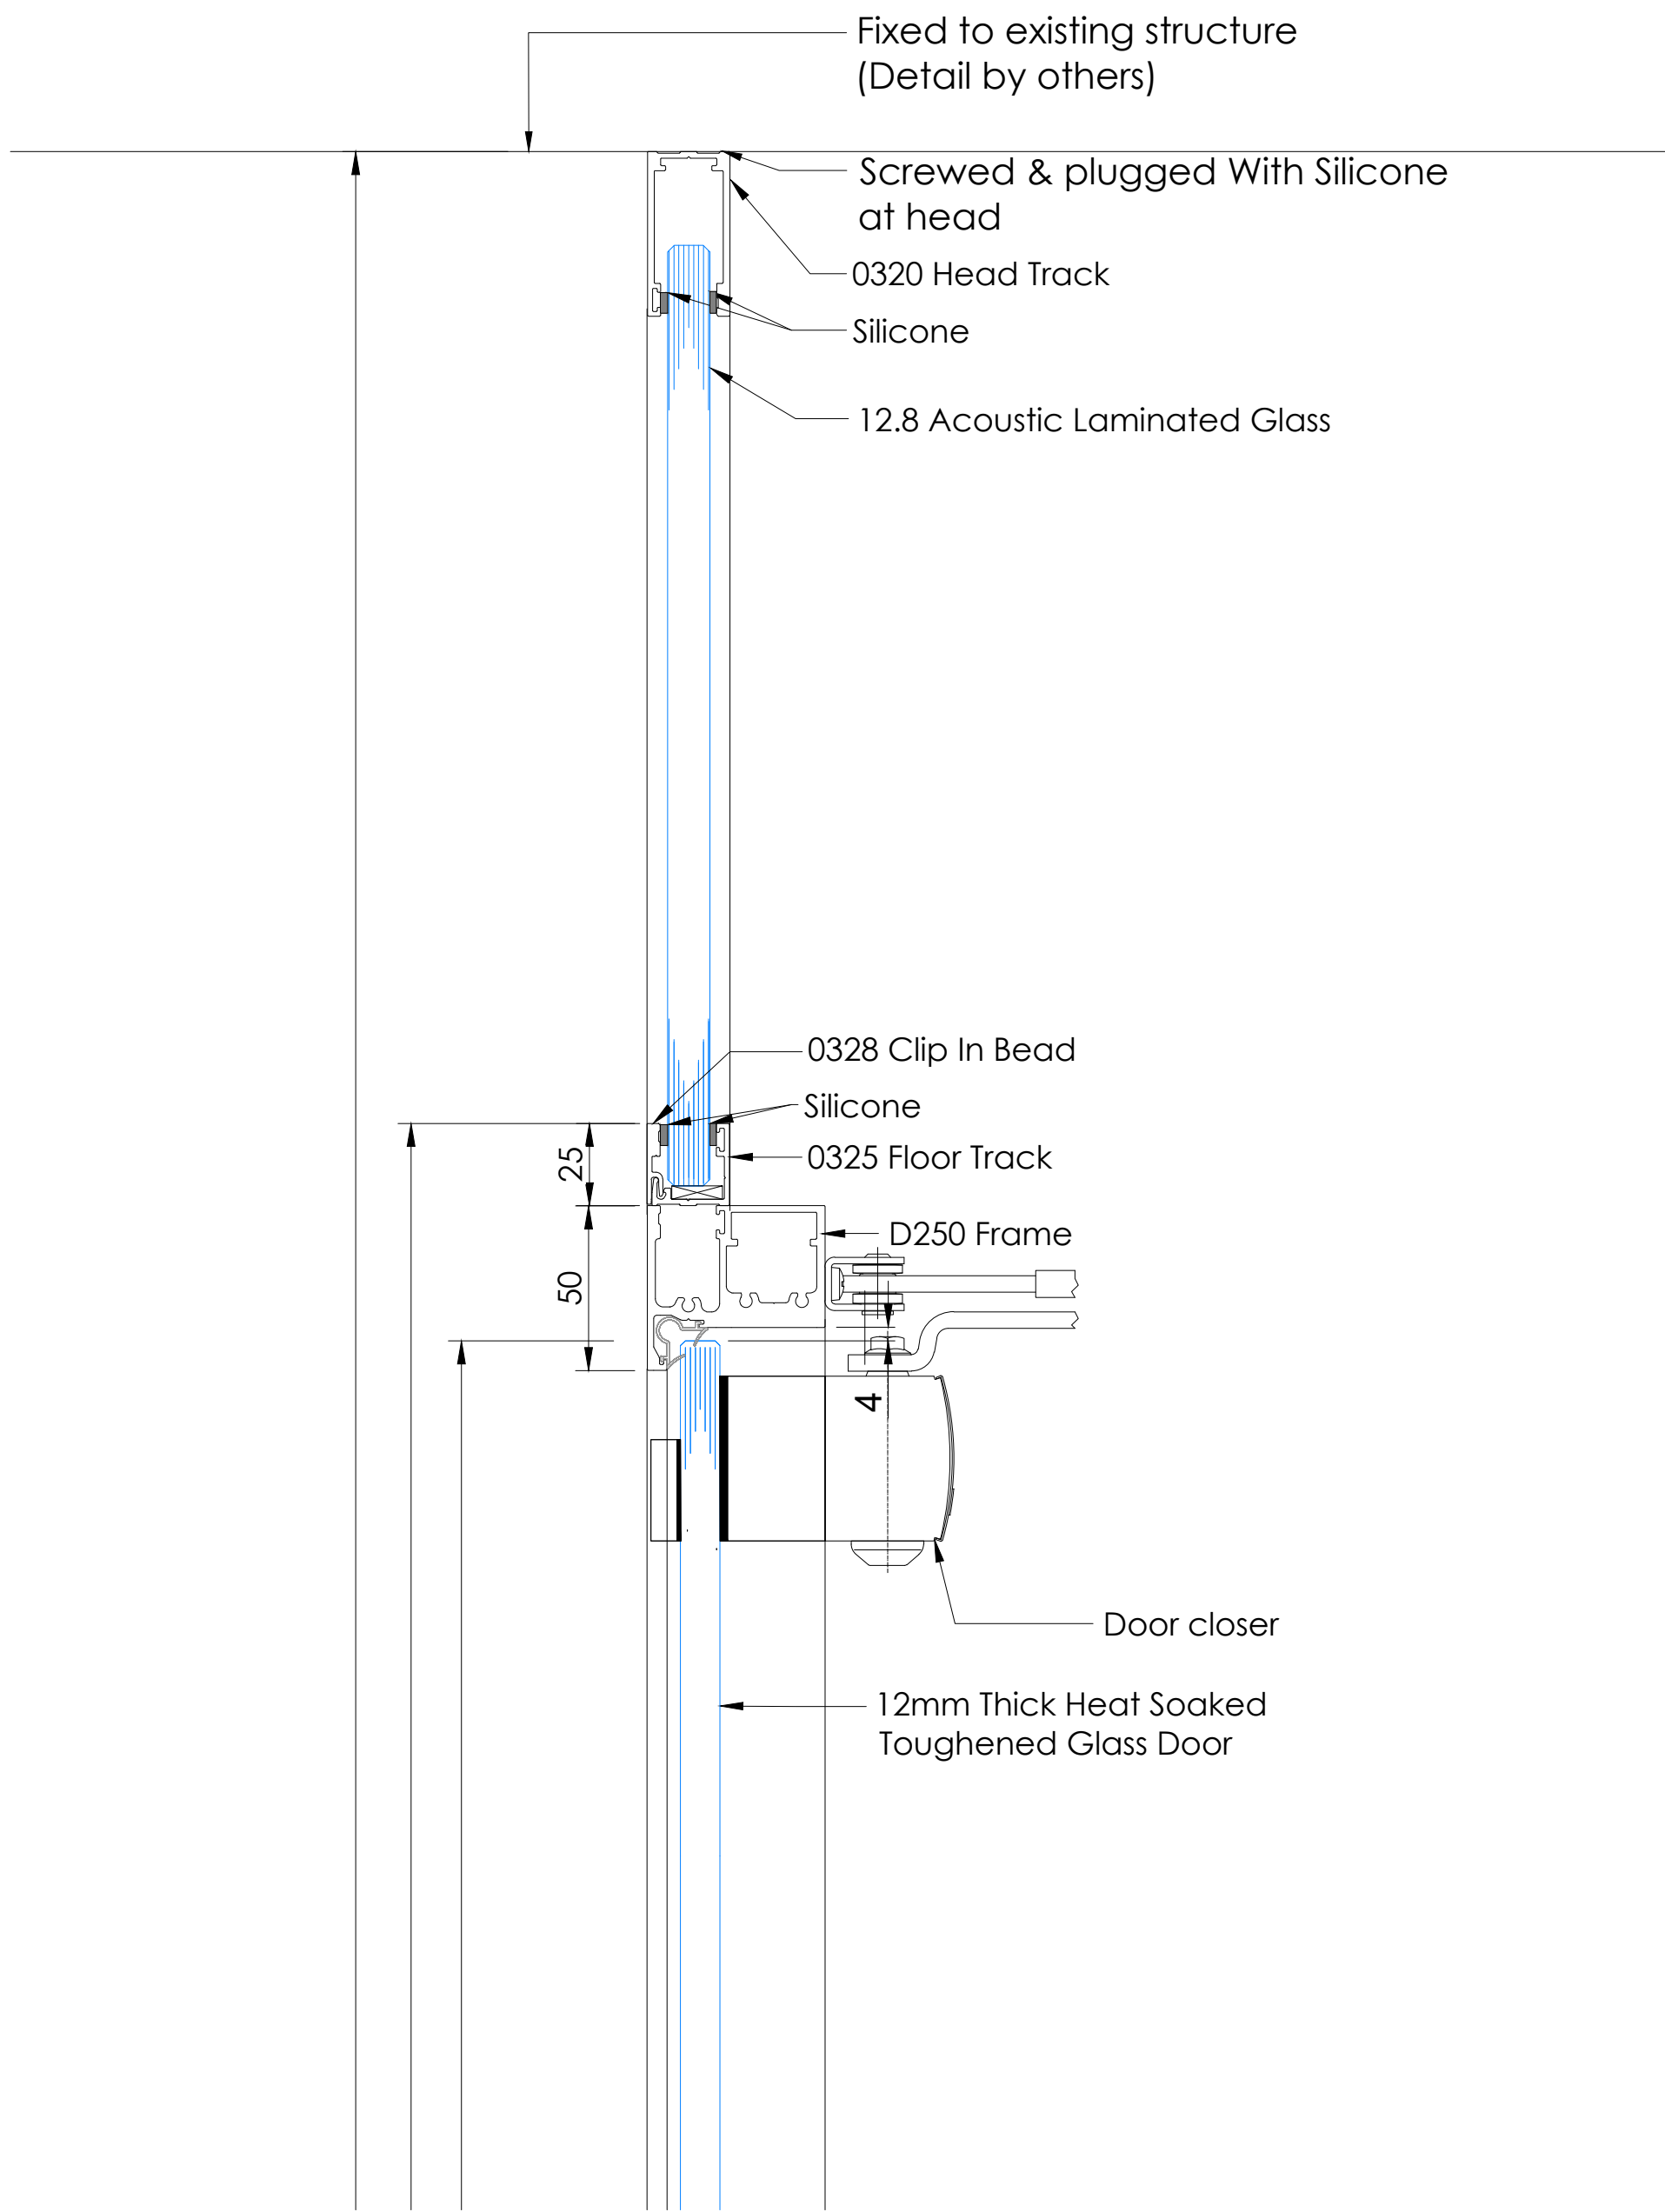


1 SECTION: Door Axile Clarity Scale 1:2

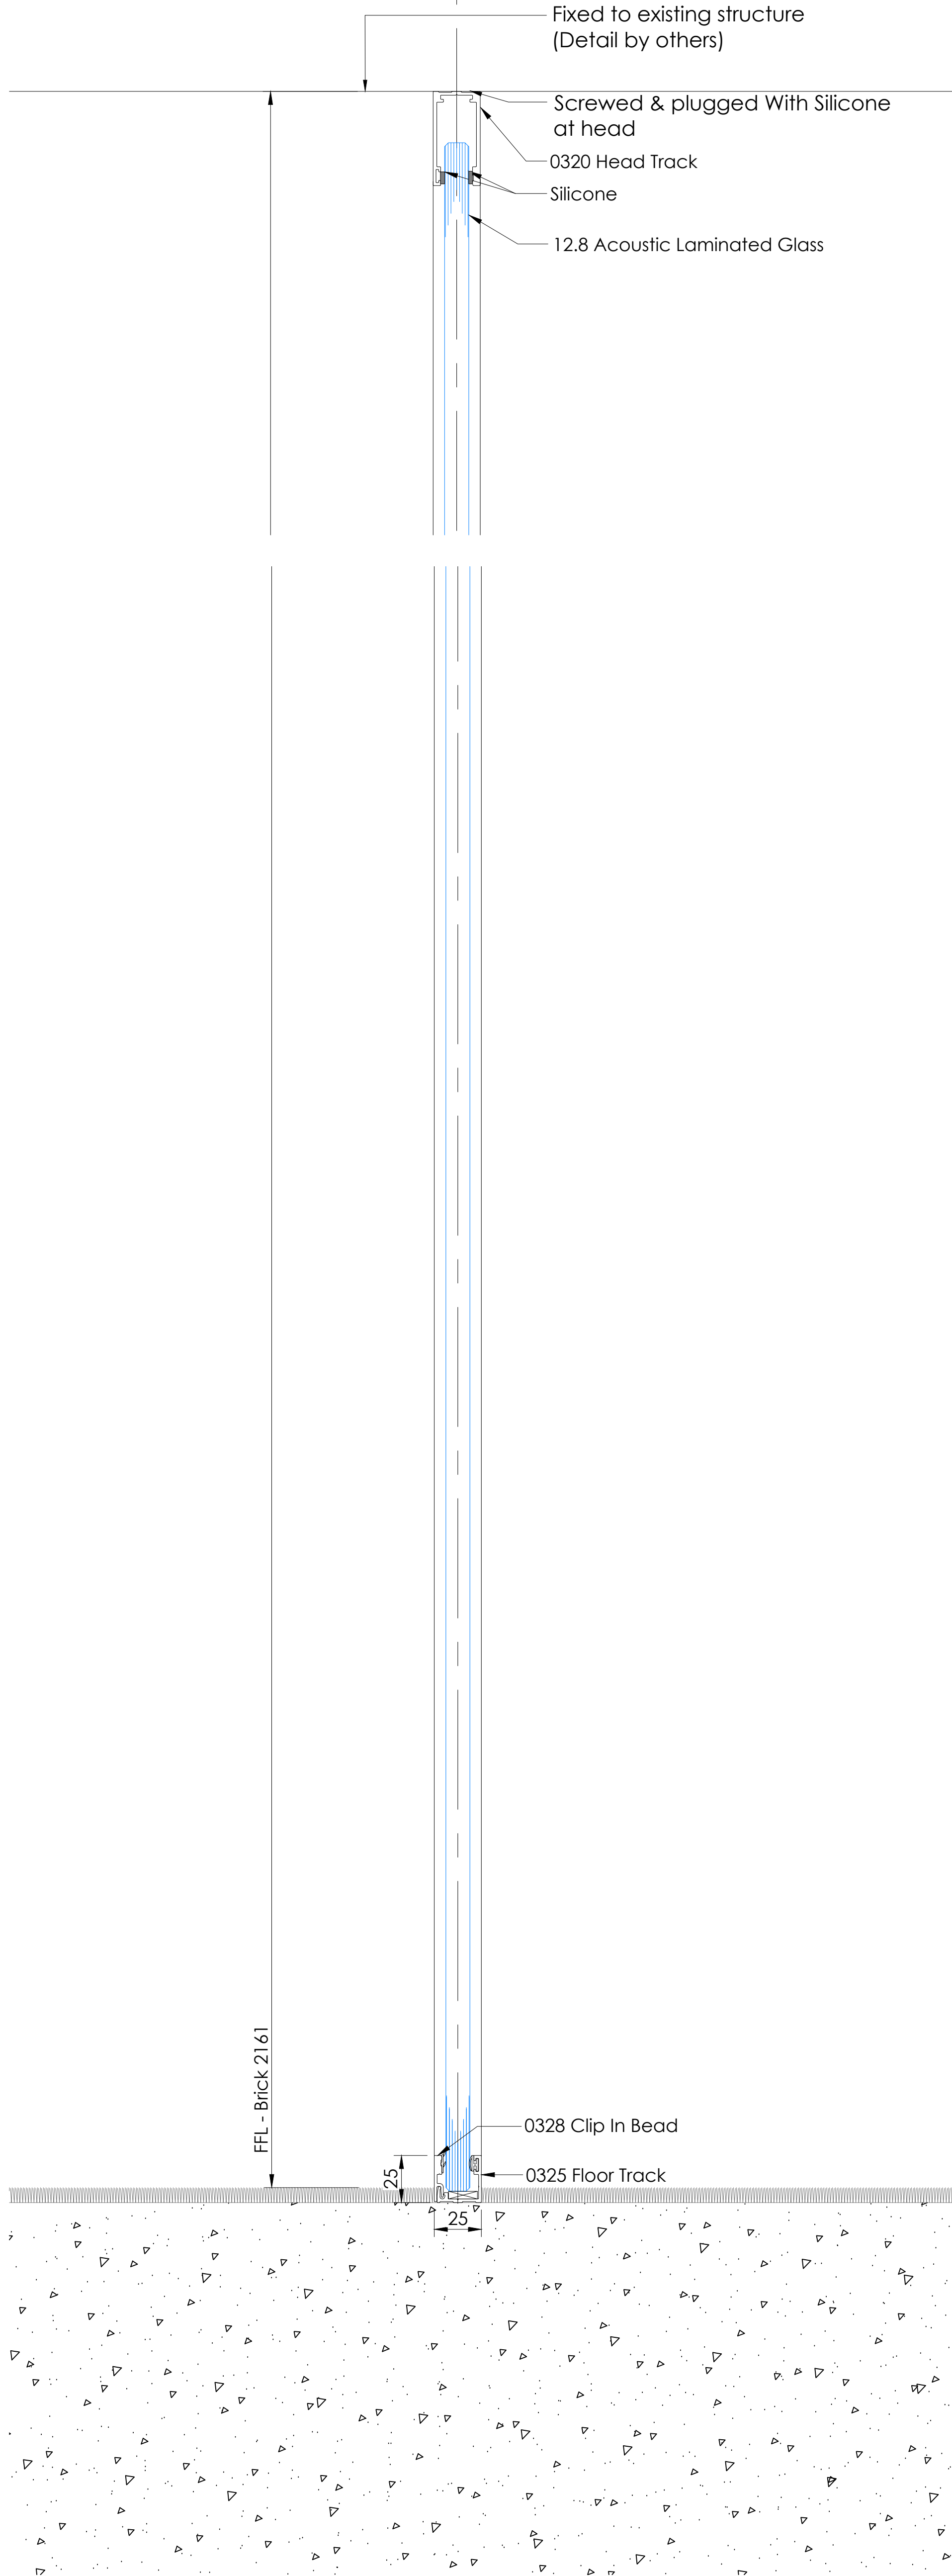


2 SECTION: Screen 6 117+ Scale 1:2

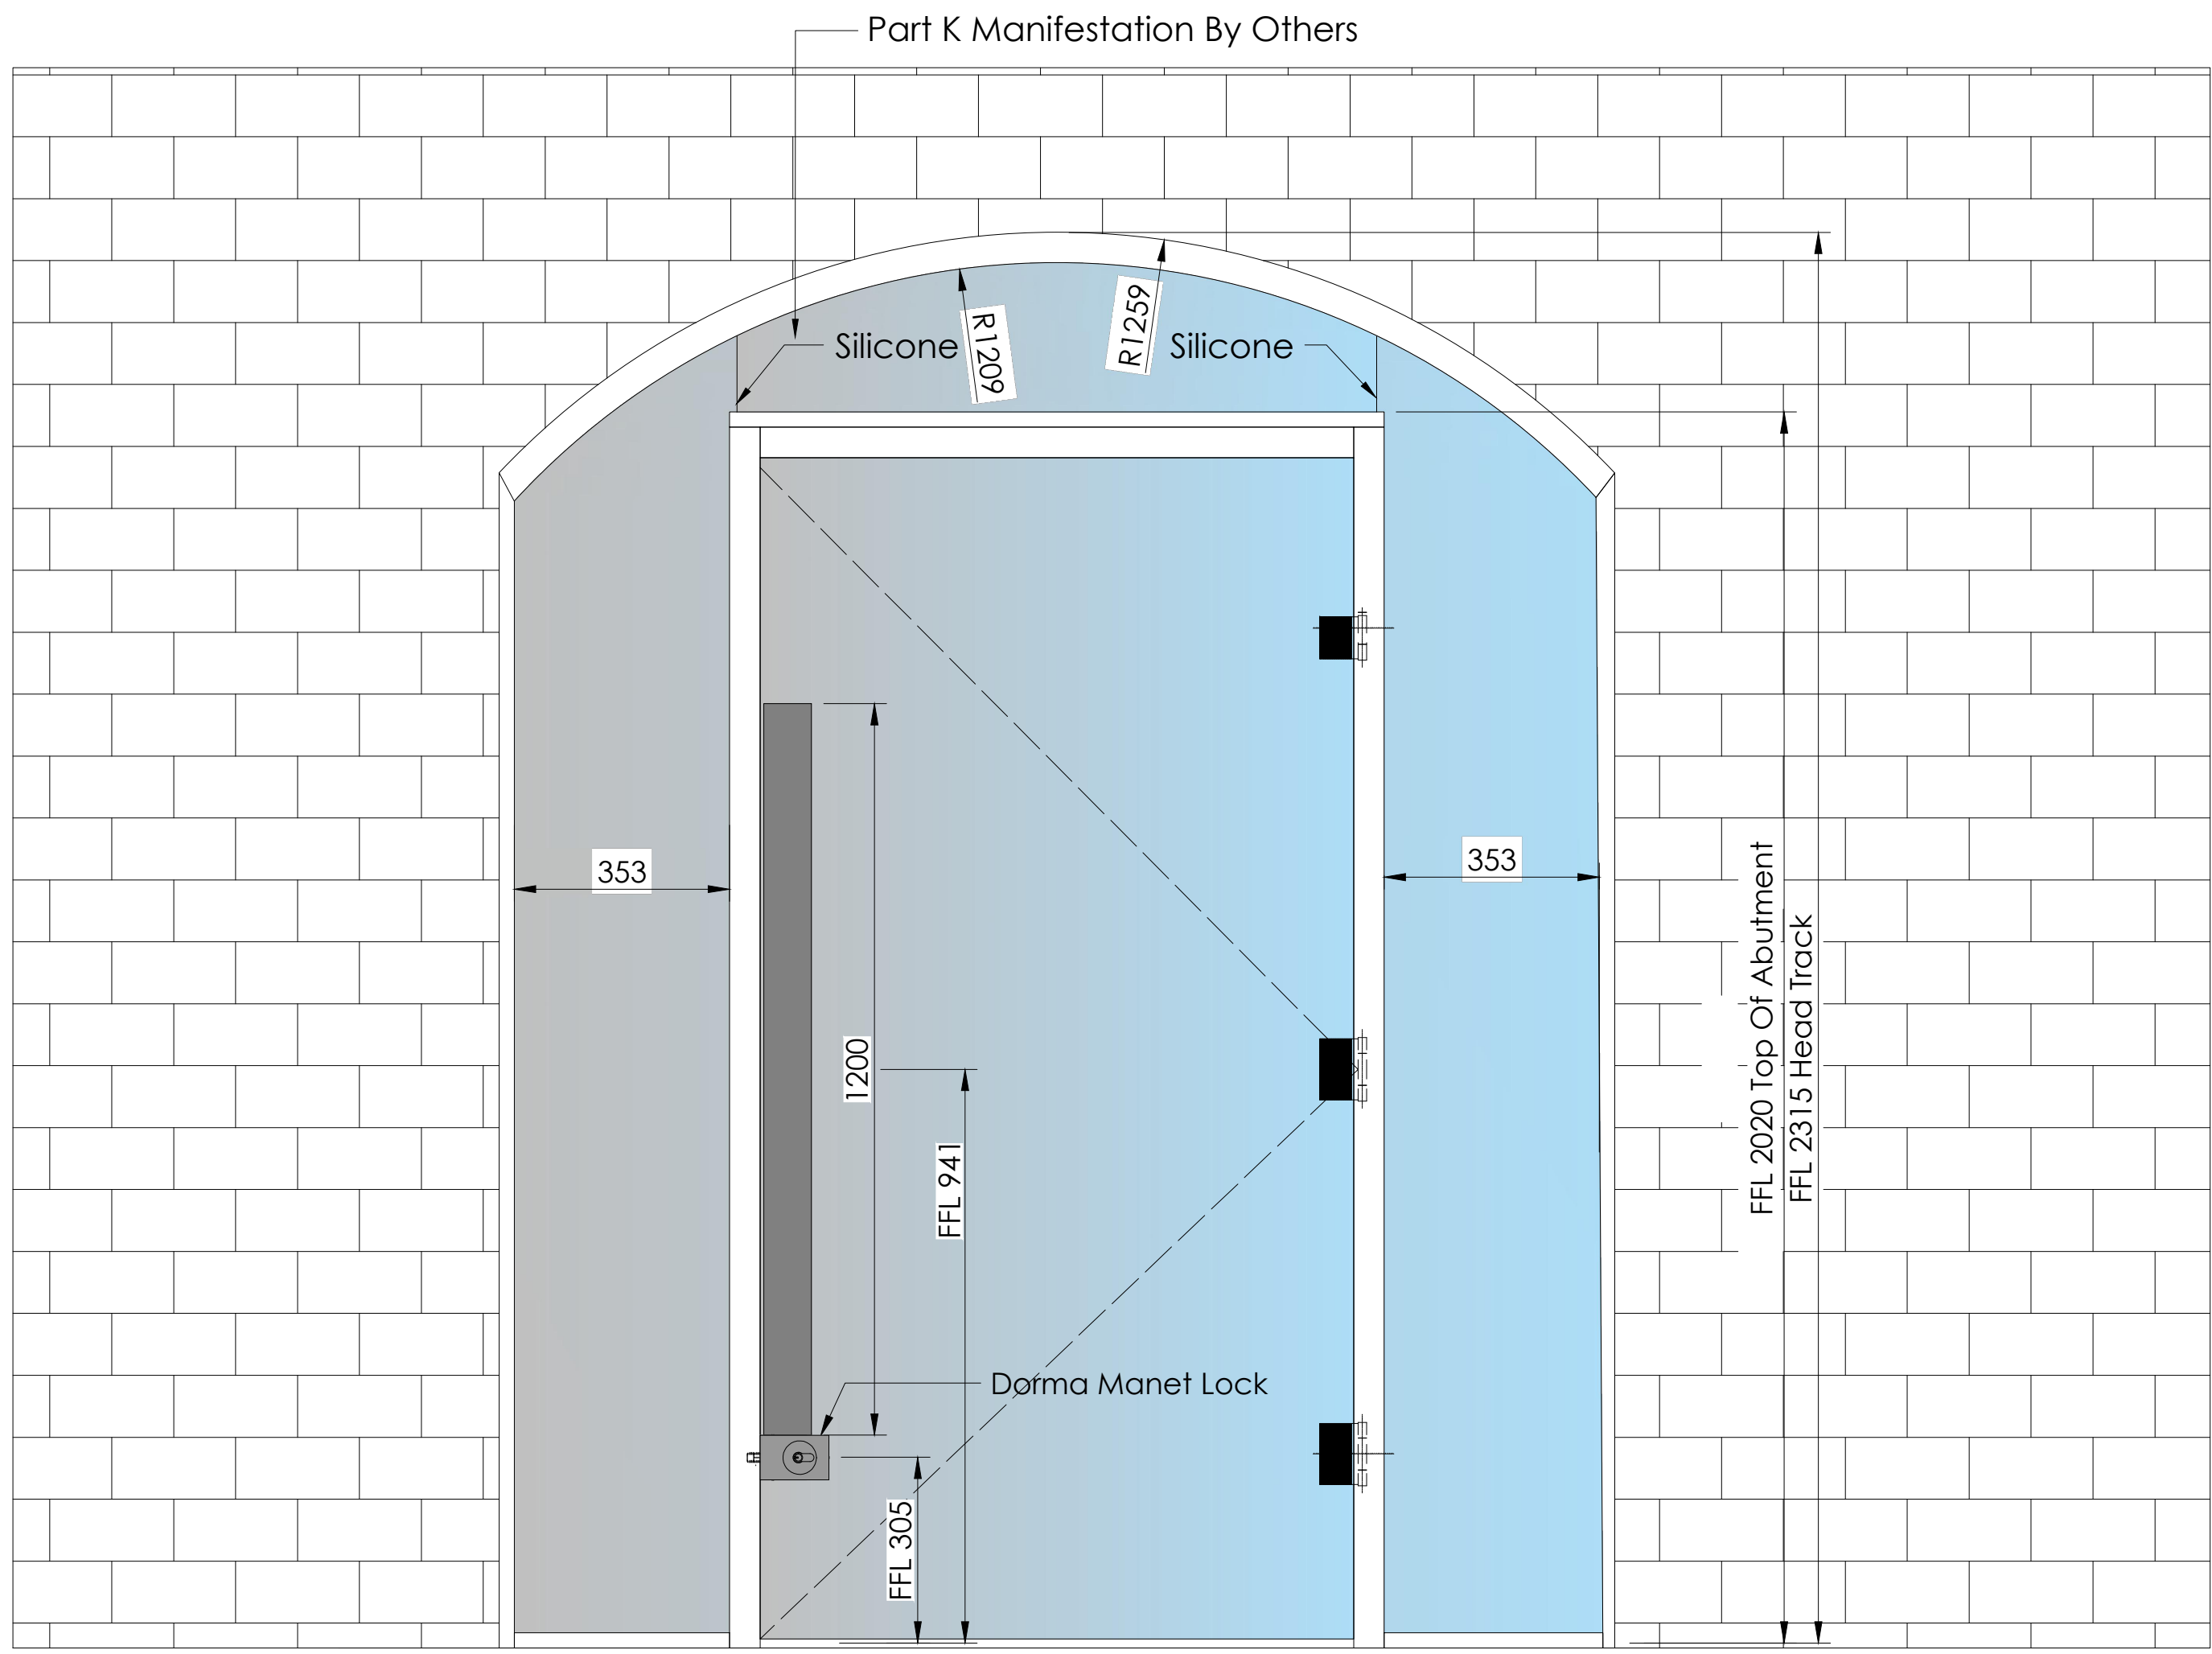

3 Elevation: Screen 6 117+ - Axile Clarity Door Scale 1:10

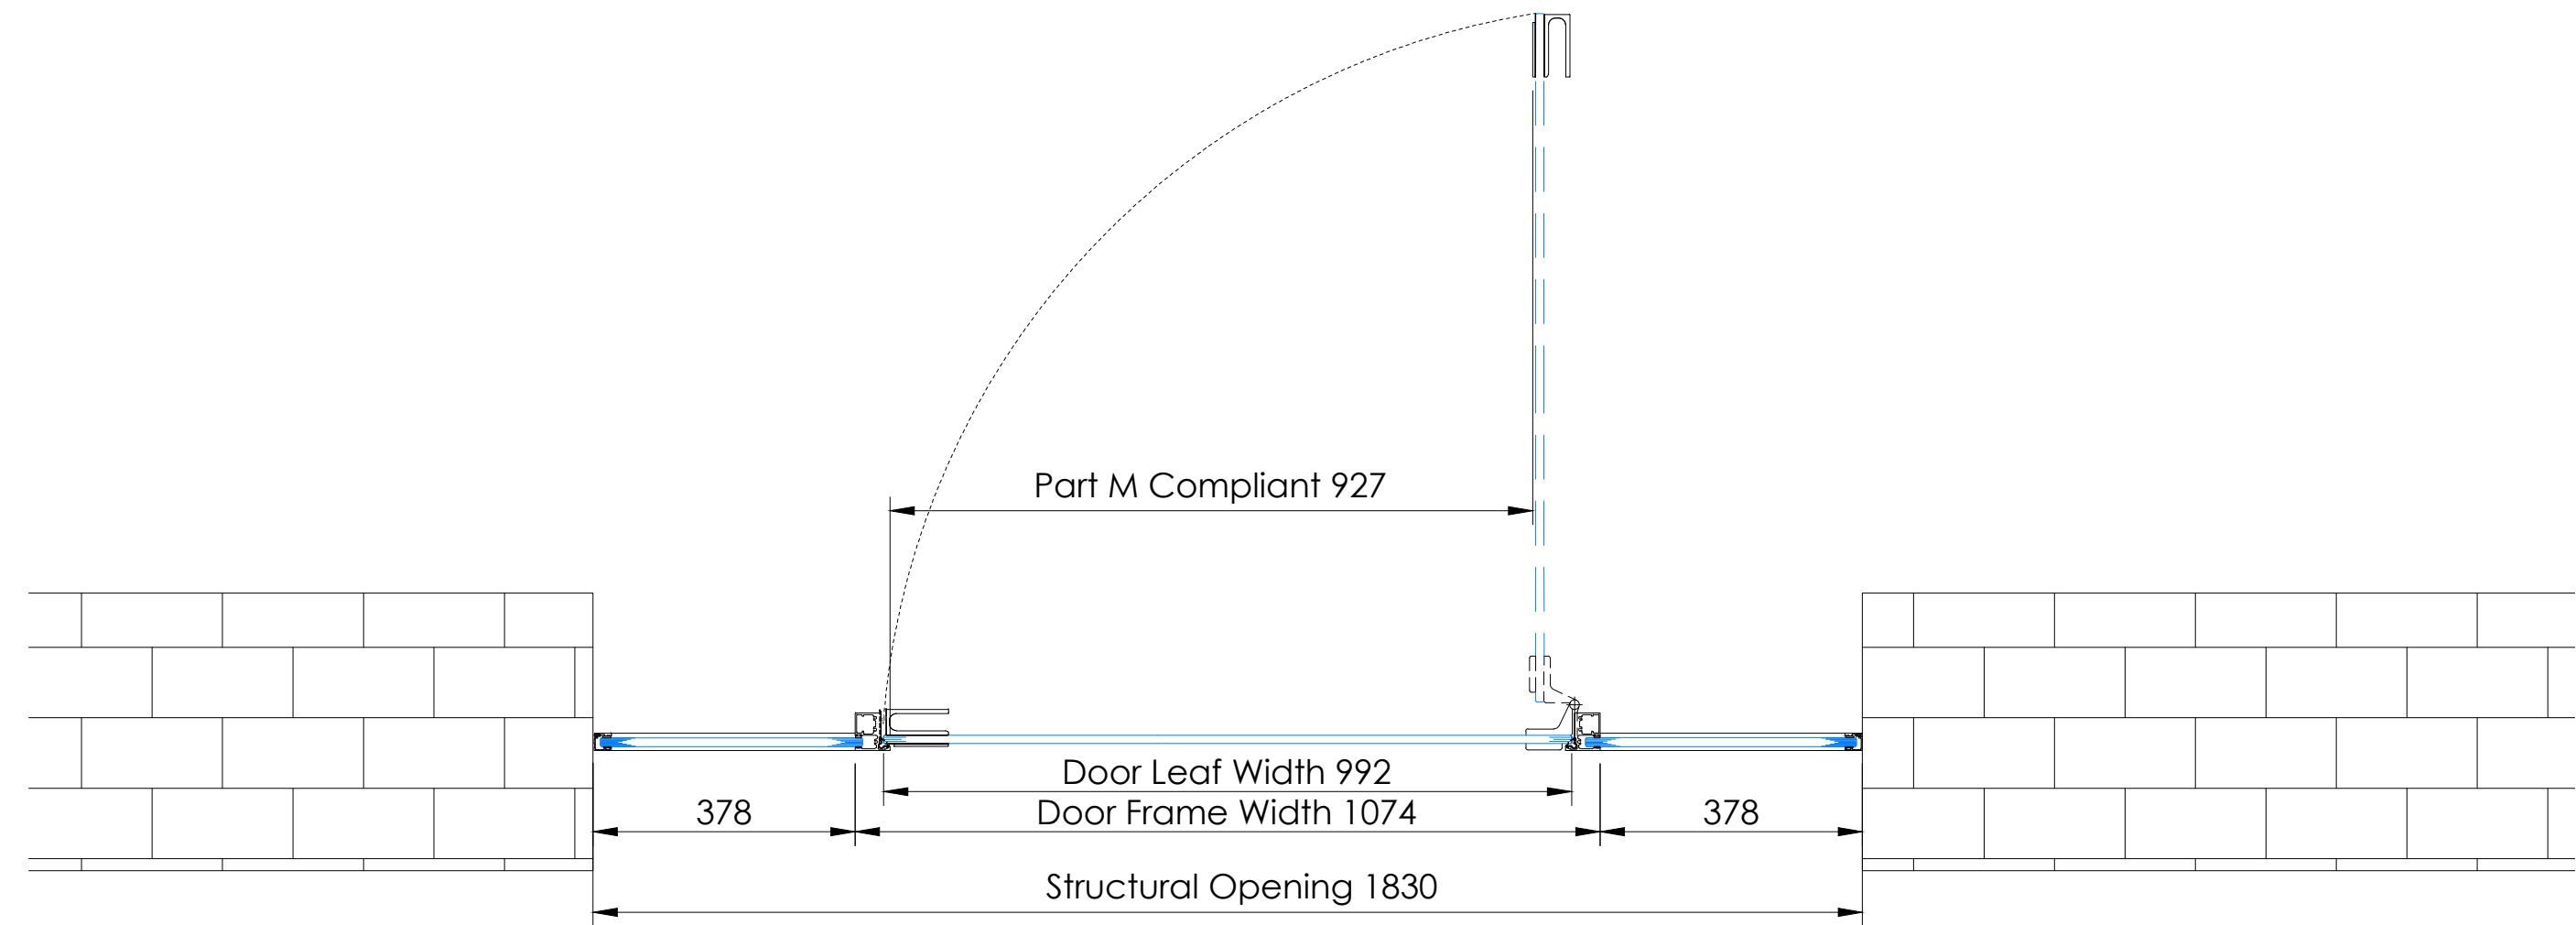

4 PLAN: Screen 6 117+ - Axile Clarity Door Scale 1:10

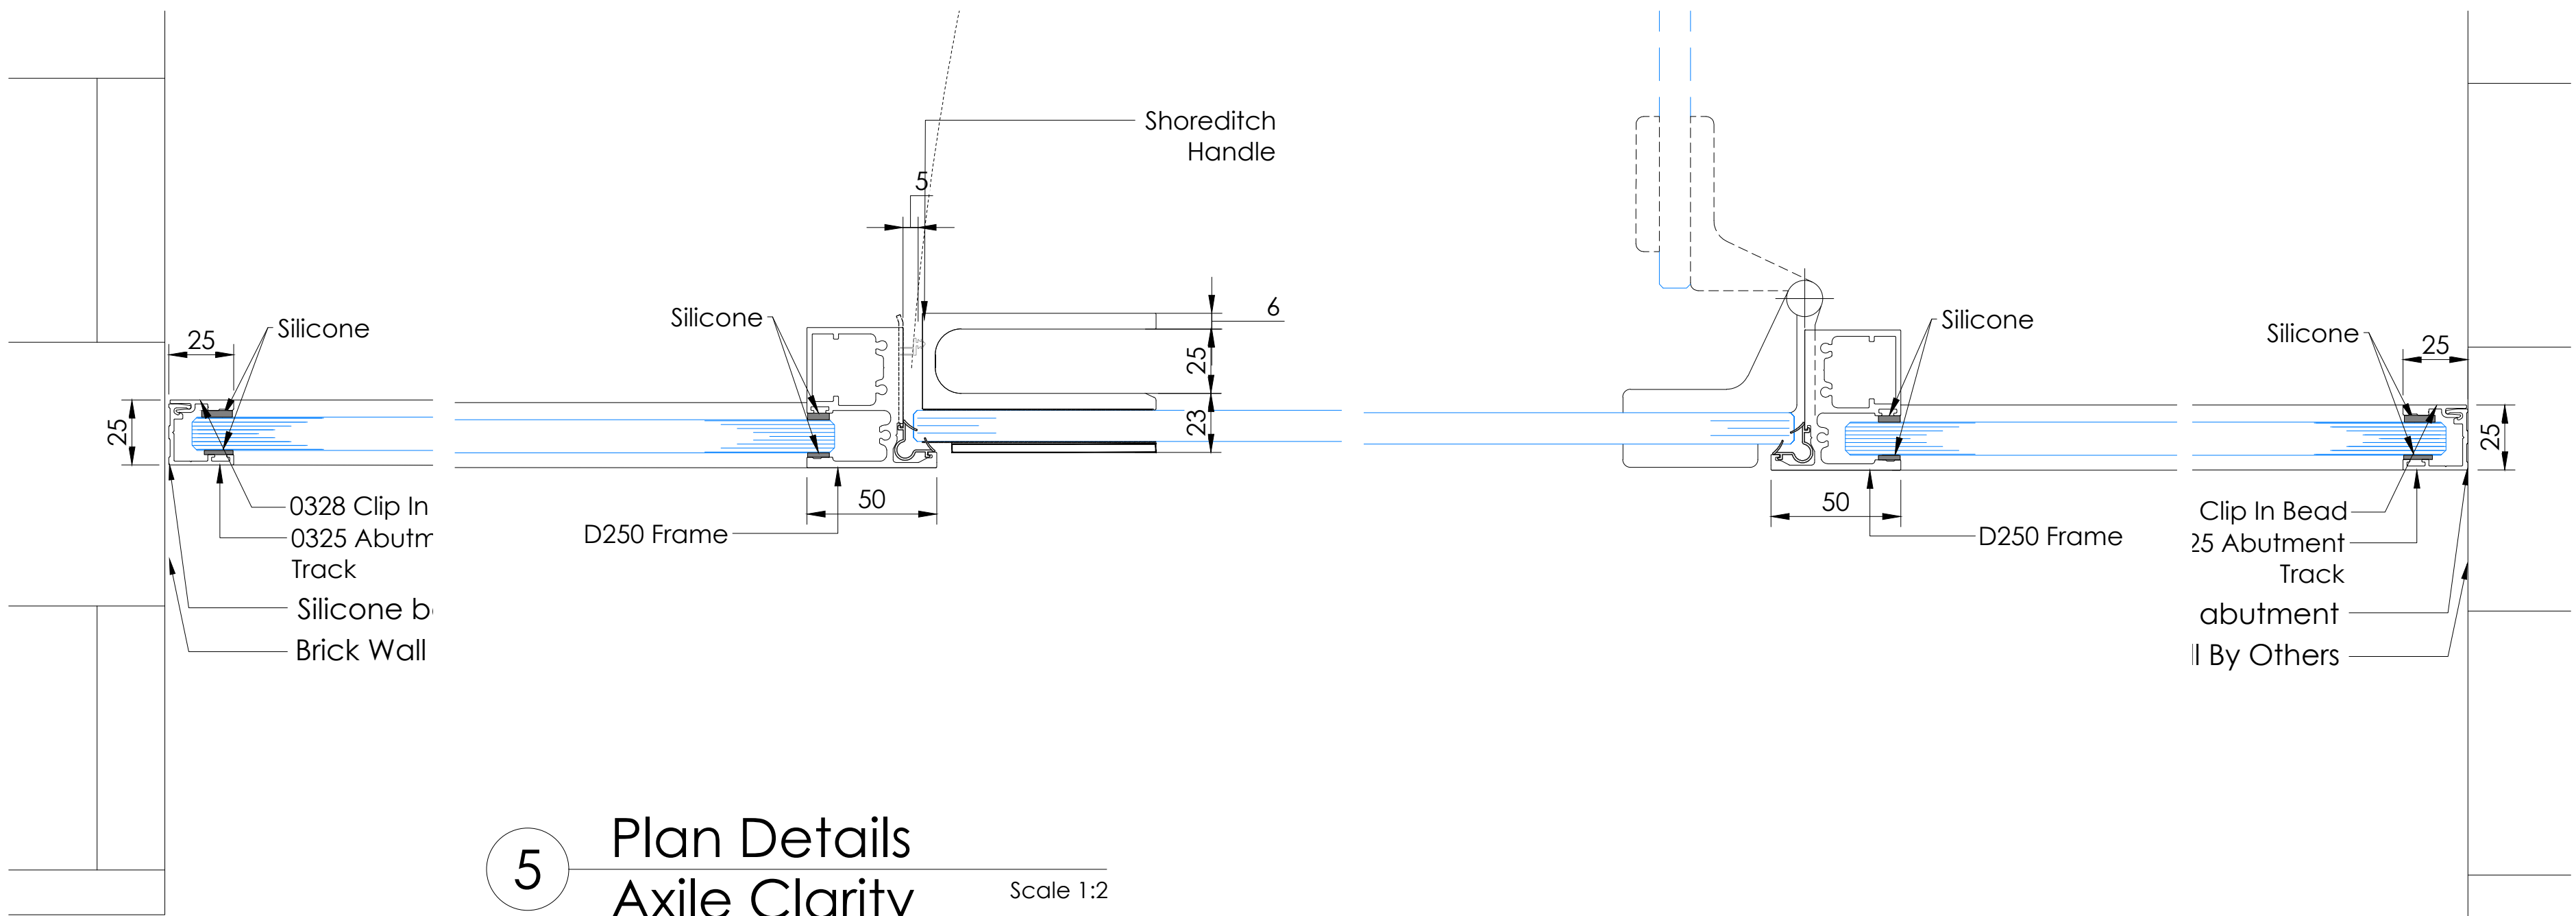


5 Plan Details Axile Clarity Scale 1:2

Safety Health & Environmental Box	
Construction Risks	This project uses any materials that have been used in the region before. From a Designer viewpoint, Optima do not envisage any specific Construction Issues to communicate.
Maintenance / Cleaning Risks	Optima in the main, provide office partitioning, the components specifically the glass are tested to the relevant standard or international standards of the door, to such CLEANING and MAINTENANCE of the relevant material no specific data. However, Optima would point out that all persons involved with maintenance and cleaning should themselves be subject to their own employer specific risk assessment process. Specific care should be taken of handling height. In such cases the regulations of the day apply. Optima do not recommend any loadings against its products.
Demolition / Adaptation Risks	From the viewpoint of a Designer, Optima have identified no significant risks for demolition and adaptation. However, the usual risk assessments are presumed to be implemented by the company proposing demolition and/or adaptation.
Environmental / Recycling	Much of the Optima range of project is recyclable, cable. See original terms and conditions for clarification. Environmental issues are subject to the law of the day.
In addition to the hazards / risks normally associated with the types of work detailed on this drawing take note of the above. It is assumed that all work on this drawing will be carried out by competent contractors meeting where applicable, to an approved method statement.	

General Information Table 1014	
Door/Partition	
Door/Partition Type	117+ - Screen 6/ Axile Clarity Door
Floors	2
Acoustic Rating	Screen: Rw38dB
Ironmongery Set	Shoreditch Pull Handles/ Door Closer/ Dorma Manet Lock/ patch fittings RAL 9005
Door Finish	N/A
Frame Finish	RAL 9005
Deflection	N/A
Glass	12mm thick heat soaked toughened/ x2 12.8 Acoustic Laminated Glass

Structural Openings To Be Checked On Site

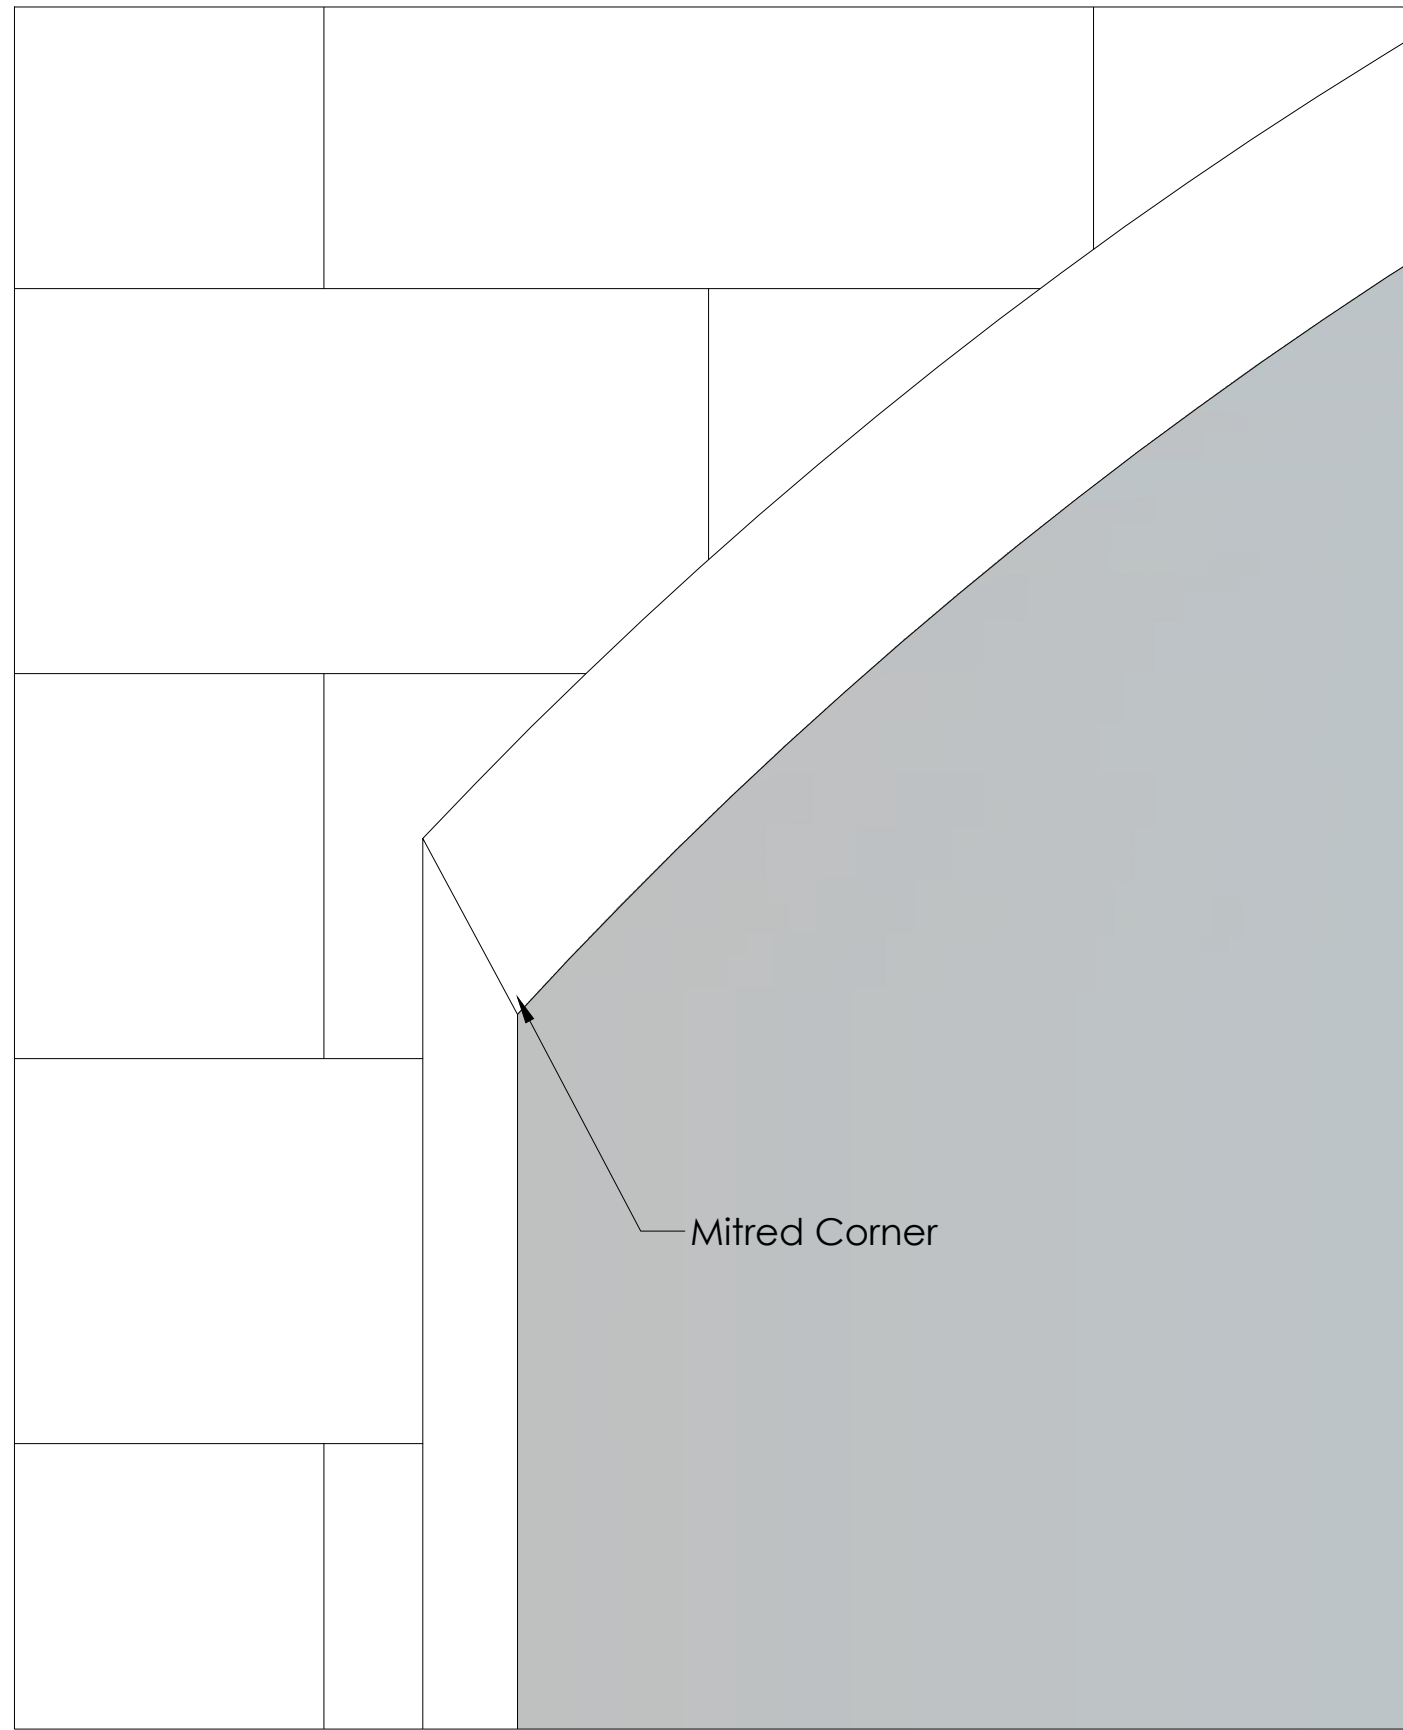

31/03/20 Rev: Rev00
AS BUILT

As	31.03.20	As Built	CC	CT	GM
Rev	Date	Description	Dr	App	Ck
Status:					
As Built					
Optima					
© Optima Products Ltd.					
OPTIMA CONTRACTING LIMITED COURTYARD HOUSE WEST END ROAD HIGH WYCOMBE BUCKINGHAMSHIRE HP11 2QB			Tel: +44 (0) 1494 492600 Web: www.optimasytems.com		
PART OF THE OPTIMA GROUP					
Project:					
50195 Bonded Warehouse L2					
Title:					
117+					
Screen 6 With Axile Clarity Door					
Scale @ A0:		Drawing No.:		Revision:	
VARIES		OPT-DRG-1014		AB	