


Notes:


Do not scale from this drawing. All dimensions to be checked on-site by contractor to ensure accuracy prior to any installation. All design work produced by Amspec Ltd is for indicative purposes only. It is the client and contractors responsibility to ensure that building control and fire officer approval have been met prior to commencement of site work

Drawing Key

- FLOOR FINISHES
- FF-05 Existing timber floor
 - FF-06 Bolon Elements Birch Woven Vinyl
- WALL FINISHES
- WF-06 Black MDF peg board cladding
 - WF-10 Diamond matt RAL 9010 pure white Emulsion
 - WF-16 Paint to existing metal columns
 - WF-19 Paint to new plasterboard partition
- BALUSTRADES / HANDRAILS
- BA-01 New black lacquered metal balustrade
- CEILING TYPES
- CL-01 New painted plasterboard MF ceiling
 - CL-03 Existing exposed brick soffit and steel beams
- CEILING FINISHES
- CF-01 Paint to plasterboard MF ceiling
 - CF-05 Paint to existing steel beams
- LIGHT FITTINGS
- LI-04 Existing linear lights - adjusted to be surface mounted

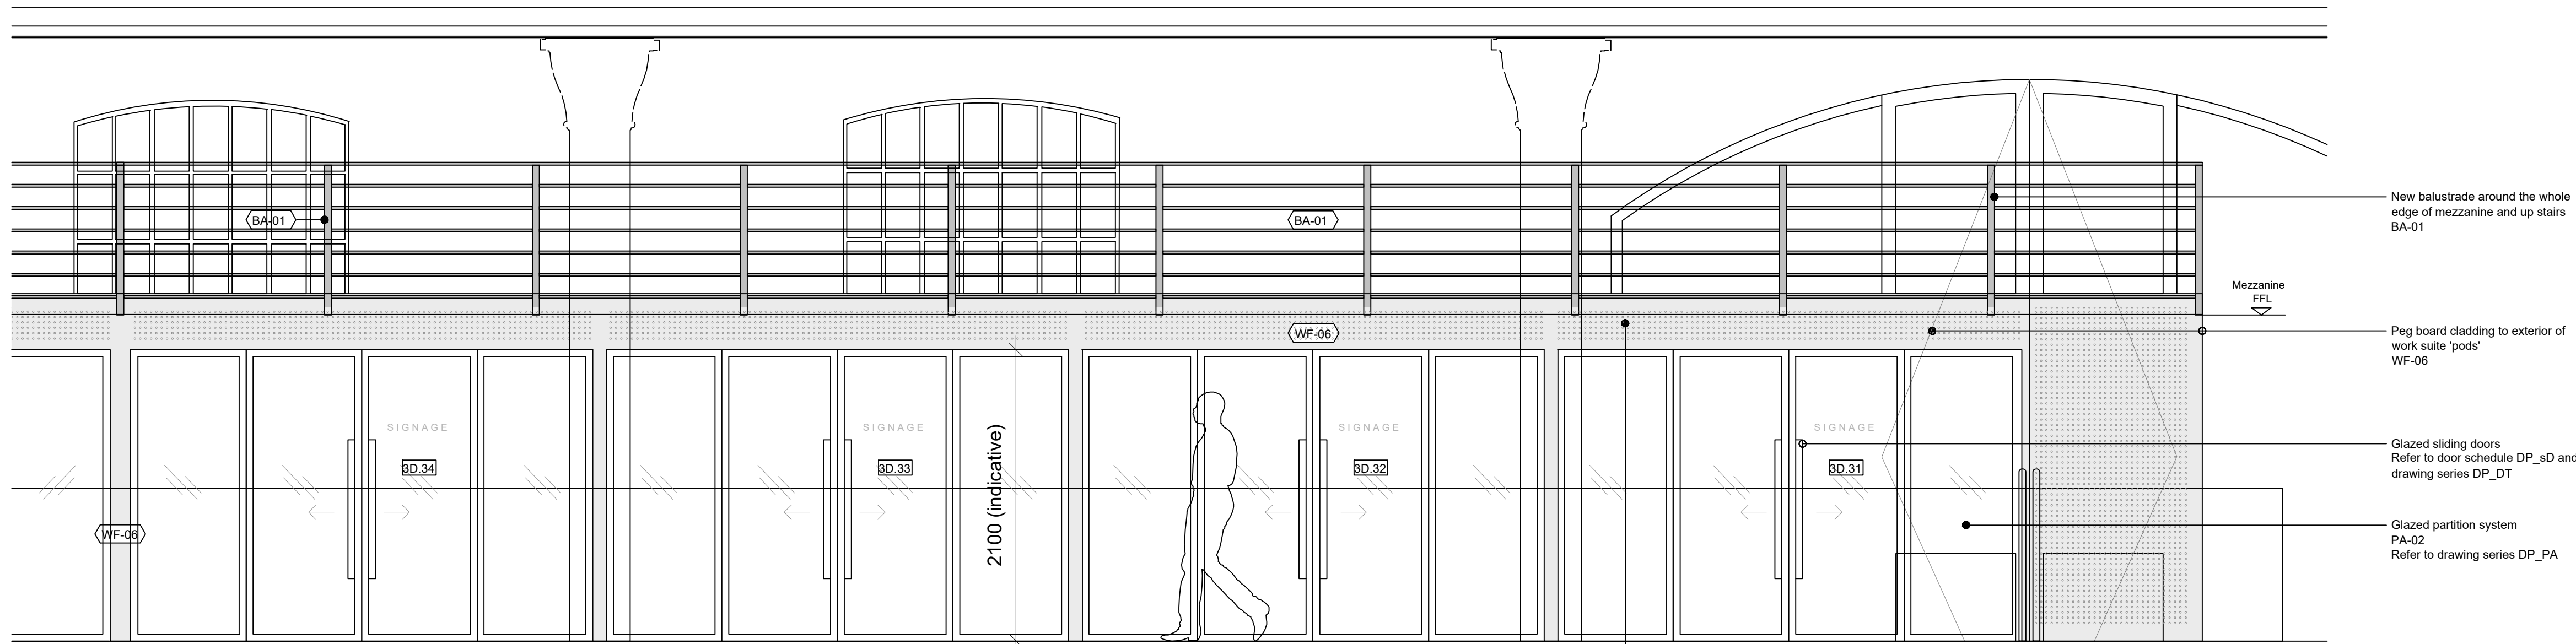


01 Proposed Elevation A
1:25 at A1

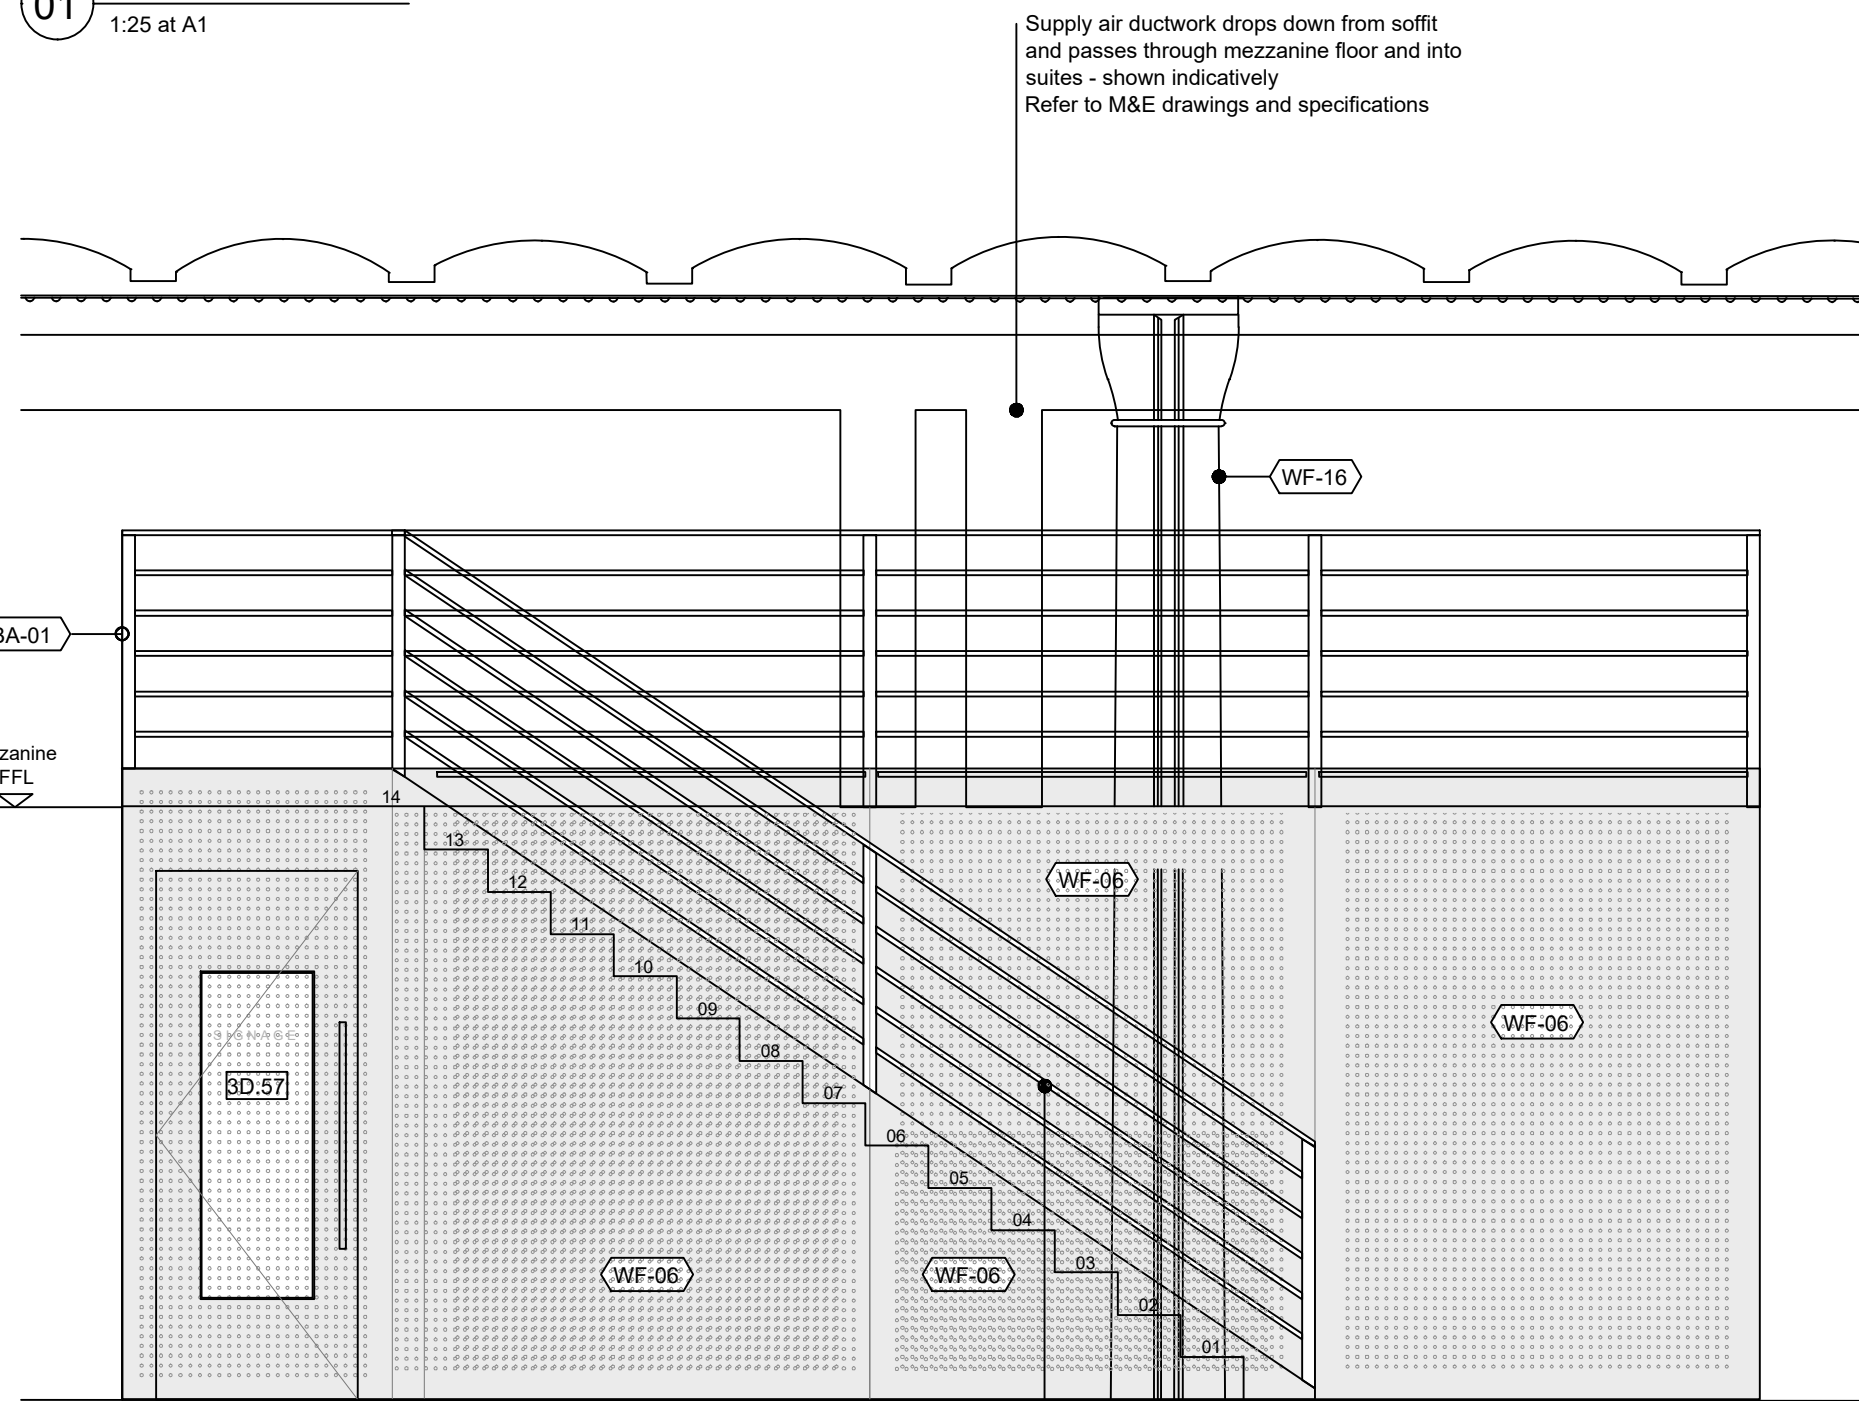

02 Proposed Elevation B
1:25 at A1

Balustrade to both sides of stairs

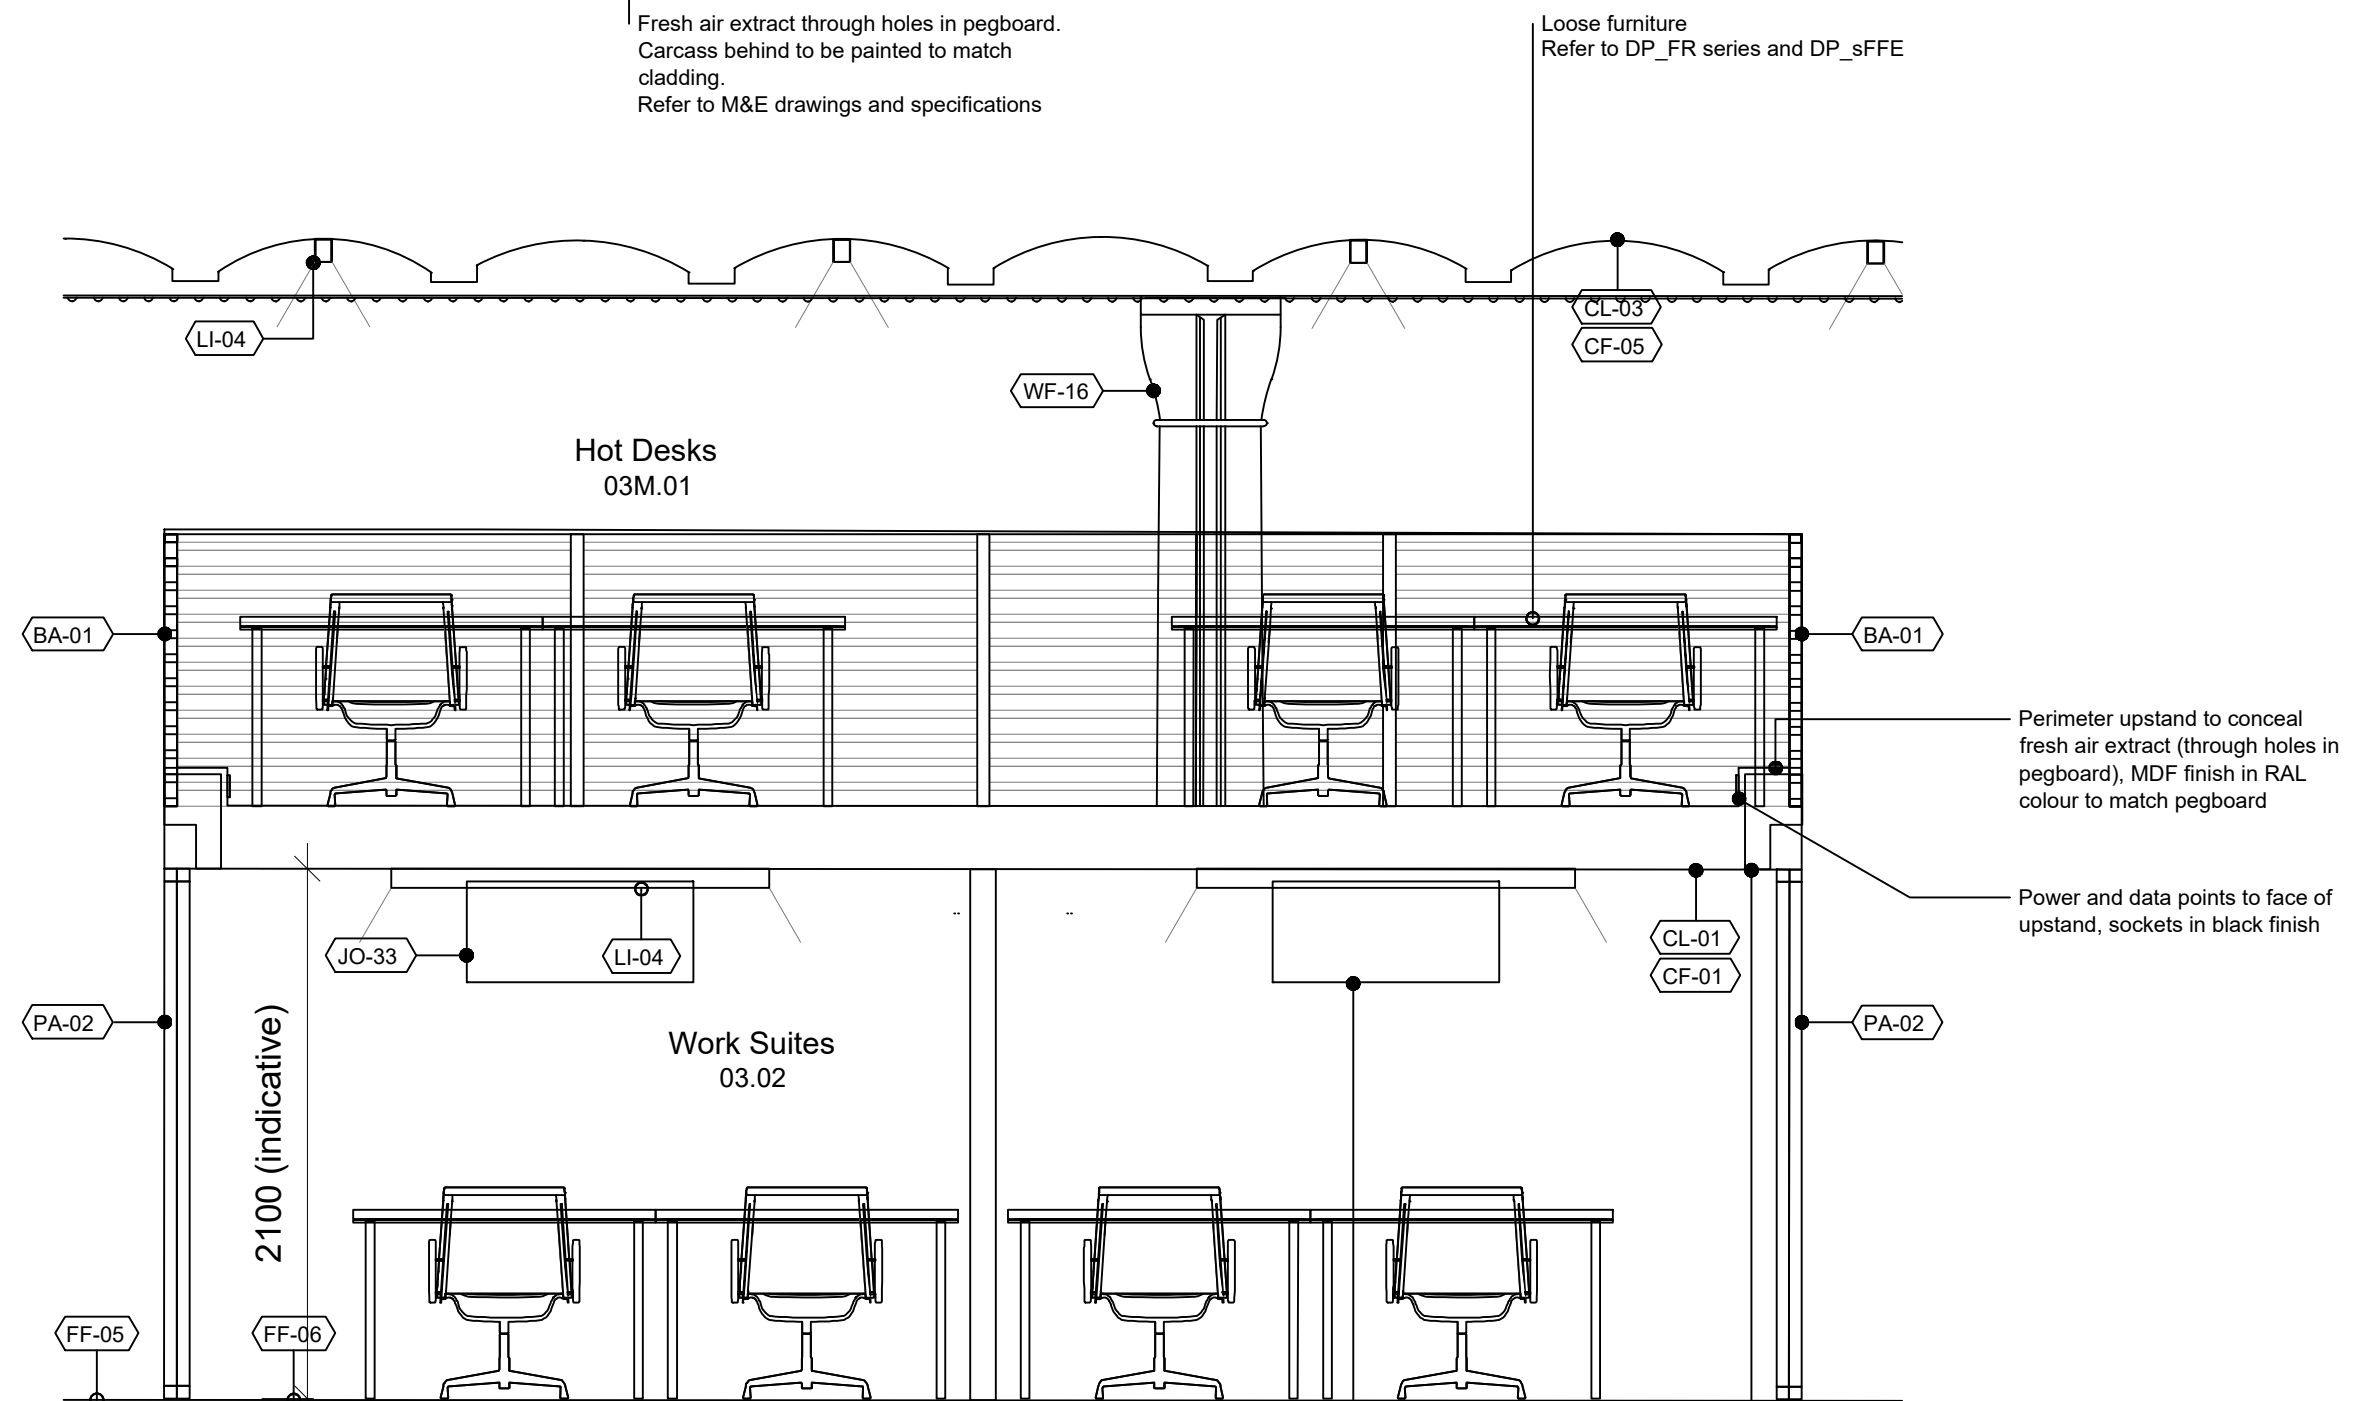

03 Proposed Section C
1:25 at A1

Wall mounted FCU with metal mesh cover
JO-33
Refer to M&E drawings and specifications

Linear slot extract grille in ceiling and transfer grille in elevation
Refer to M&E drawings and specifications

Perimeter upstand to conceal fresh air extract (through holes in pegboard), MDF finish in RAL colour to match pegboard

Power and data points to face of upstand, sockets in black finish

REV:	DESCRIPTION:	BY:	DATE:
STATUS:	AS BUILT		



CLIENT:	OBI 80 MOSELY STREET MANCHESTER M2 3FX
ARCHITECT:	

SITE:	18 LOWER BYROM STREET MANCHESTER
-------	-------------------------------------

TITLE:	LEVEL 3 DP WORK HUB WORK SUITE PODS ELEVATIONS
--------	---

SCALE: AT A1: 1:30	DATE: 27.06.19	DRAWN: CR	CHECKED: IC
PROJECT NO: 1683	DRAWING NO: DP_KS-54	REVISION:	