

AHU MAINTENANCE CLEARANCE SPACE

NEW STEPS TO ACCESS PLANT DECK

NEW 7500 FRESH AIR & 7000 EXTRACT AIR DUCTS FROM ROOF LEVEL DROP TO BELOW TO SERVE LEVEL 3

ATTENUATION TO BE PROVIDED ON SUPPLY & EXTRACT DUCTWORK

HATCHED AREAS TO BE FILLED IN WITH NEW PLANT DECK

HATCHED AREAS NOT SUITABLE FOR PLANT LOADING

NEW STEPS TO ACCESS PLANT DECK

SPACE ALLOCATION FOR FUTURE LEVEL 2 EXTERNAL CONDENSER

L3 AHU


AHU ACCESS SPACE

L1 PH EXTRACT FAN

L3 Condenser PURIST EP-40007N061A

L1 Condenser PURIST EP-15007N061A

L4 Condenser PURIST EP-15007N061A

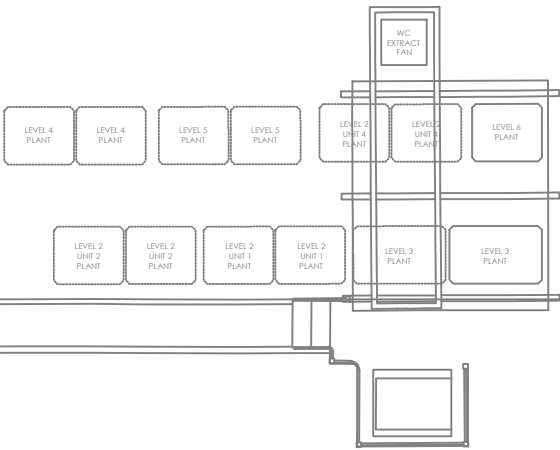

MECHANICAL LEGEND:

- FRESH AIR DUCT
- EXTRACT AIR DUCT
- FIRE DAMPER
- DUCTWORK RISES OR DROPS
- ATTENUATORS

AS BUILT

These lines measure 100mm in length when plotted correctly.

All scaled dimensions taken from this drawing shall be verified on site.

This drawing is the property of Thermotech Mechanical Services and no information contained hereon shall be copied, in whole or in part, or passed to any other party without written consent. Copyright 2015.

Notes

- This drawing shall be read in conjunction with the relevant Thermotech Mechanical Services specification(s) and all relevant Architect's and other Engineer's drawing(s).
- Details are for design purposes only and shall be verified on site by the Engineering Contractor where accuracy is critical. The exact location of all plant items/equipment and the route of all services shall be determined on site.
- All plant, equipment, distribution system components and ancillaries shall be installed in strict accordance with the manufacturer's guidelines.
- The installation personnel shall allow for changes in distribution system(s) invert levels (including any sets up and down etc.) as necessary to coordinate fully with the building structure and other M&E Services.

Notes

- This drawing shall be read in conjunction with the relevant Thermotech Mechanical Services specification(s) and all relevant Architect's and other Engineer's drawing(s).
- Details are for tender purposes only and shall be verified on site by the Engineering Contractor where accuracy is critical. The exact location of all plant items/equipment and the route of all services shall be determined on site.
- All plant, equipment, distribution system components and ancillaries shall be installed in strict accordance with the manufacturer's guidelines.
- The installation personnel shall allow for changes in distribution system(s) invert levels (including any sets up and down etc.) as necessary to coordinate fully with the building structure and other M&E Services.
- The installation of all internal and external units, refrigerant pipework, interconnecting wiring, commissioning and testing shall be carried out by a specialist refrigerant systems installer. The installer shall be certified and approved by the AC equipment manufacturer to carry out installation and commissioning of their equipment. This certification and approval status shall be current and valid upto at least the end of the defects liability period.
- All interconnecting AC pipework shall be designed by AC equipment manufacturer, including the selection of all pipe sizes, refrigerant flow control devices (e.g. Refnet branch piping kits, branch selector units etc.) and other ancillary components.
- The MEC shall carry out all interconnecting refrigerant pipework associated with the AC systems, including all refrigerant flow control components (Refnet branch piping kits, branch selector units etc.). All pipework shall be carried out in refrigerant quality soft/medium drawn copper tubing to BS2873 Part 2: 1972, complete with the appropriate headers and joints. Pipework shall be carried out by an Approved Refrigerant Engineer and accordance to BS EN 378: 2000 Specification and the AC equipment manufacturer's design and installation instructions. All pipework shall be suitable for the refrigerant used.
- The MEC shall carry out all associated condensate discharge pipework. The condensate lines from the AC indoor units shall discharge into the above ground drainage system via a Hepworth HepVO dry trap, or shall discharge safely over the nearest floor gully. The exact method and discharge position shall be agreed with the Consulting Engineer prior to installation. All condensate pipework shall be either half-hard copper to EN1057-R250, Table X with matching compression fittings or plastic with matching solvent-weld joints. The pipework shall be laid to sufficient falls to ensure standing water does not occur. Access tees shall be fitted at each change of direction.
- The MEC shall carry out all interconnecting controls wiring associated with the AC systems. Any control or communication wiring shall not be run next to power wiring. A minimum space of 100mm between both control and power cables shall apply.
- Unless stated otherwise, all AC controllers shall be wall-mounted at 1,200mm AFFL.
- Unless stated otherwise, all AC remote temperature sensors shall be wall-mounted at 1,500mm AFFL.

|       |                                                               |          |     |     |
|-------|---------------------------------------------------------------|----------|-----|-----|
| AB    | EXTERNAL CONDENSERS ADDED DETAILS                             | 20.02.20 | RB  | TH  |
| C2    | CONSTRUCTION ISSUE - EXTERNAL CONDENSERS ADDED TO ROOF LAYOUT | 17.01.20 | TT  | AH  |
| C1    | CONSTRUCTION ISSUE - STATUS B                                 | 04.10.19 | TT  | AH  |
| A1    | PRELIMINARY ISSUE                                             | 30.09.19 | TT  | AH  |
| ISSUE | DESCRIPTION                                                   | DATE     | DRN | CHD |

**Thermotech**  
Mechanical Services

Thermotech  
Hercules Office Park  
Bird Hall Lane  
Cheadle Hulme  
Stockport  
SK3 0UX

Tel: 0161 476 5551 | www.thermotechsolutions.co.uk

STATUS

AS BUILT

CLIENT

-

CONTRACT

BONDED WAREHOUSE

TITLE

PROPOSED ROOF LEVEL - VENTILATION SERVICES LAYOUT

|               |          |         |                |
|---------------|----------|---------|----------------|
| DATE          | 10.07.19 | SCALE   | 1:100          |
| DRAWN         | TT       | JOB No. | REV            |
| CHECKED       | AH       | 4004537 | 4004537-M-5701 |
| APPROVED      | -        | 4004537 | AB             |
| EXTERNAL REF. | -        |         |                |

THIS DRAWING IS CONFIDENTIAL & IS THE PROPERTY OF THERMOTECH MECHANICAL SERVICES. IT MUST NOT BE DISCLOSED TO A THIRD PARTY, COPIED OR LENT WITHOUT THEIR WRITTEN CONSENT.

C1