
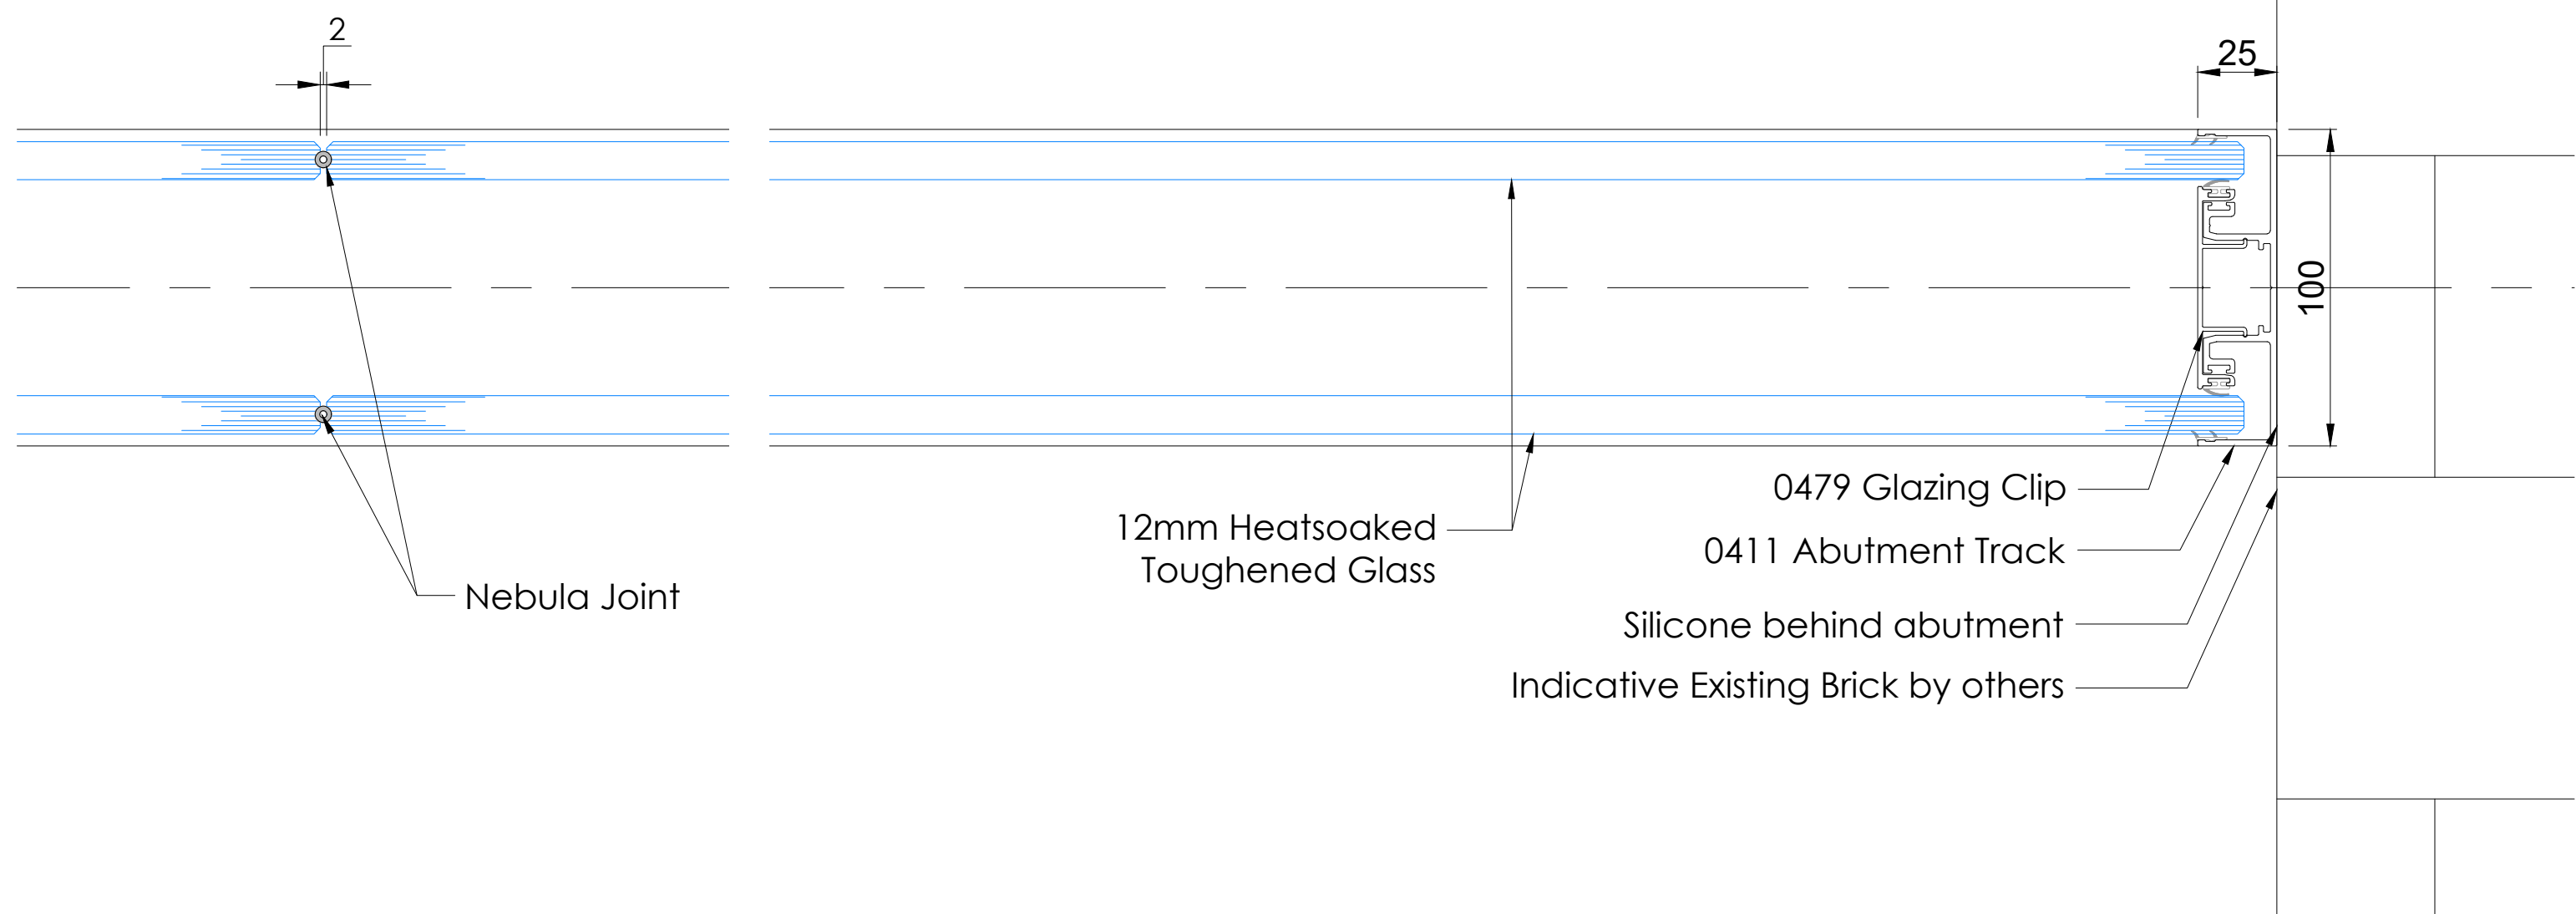
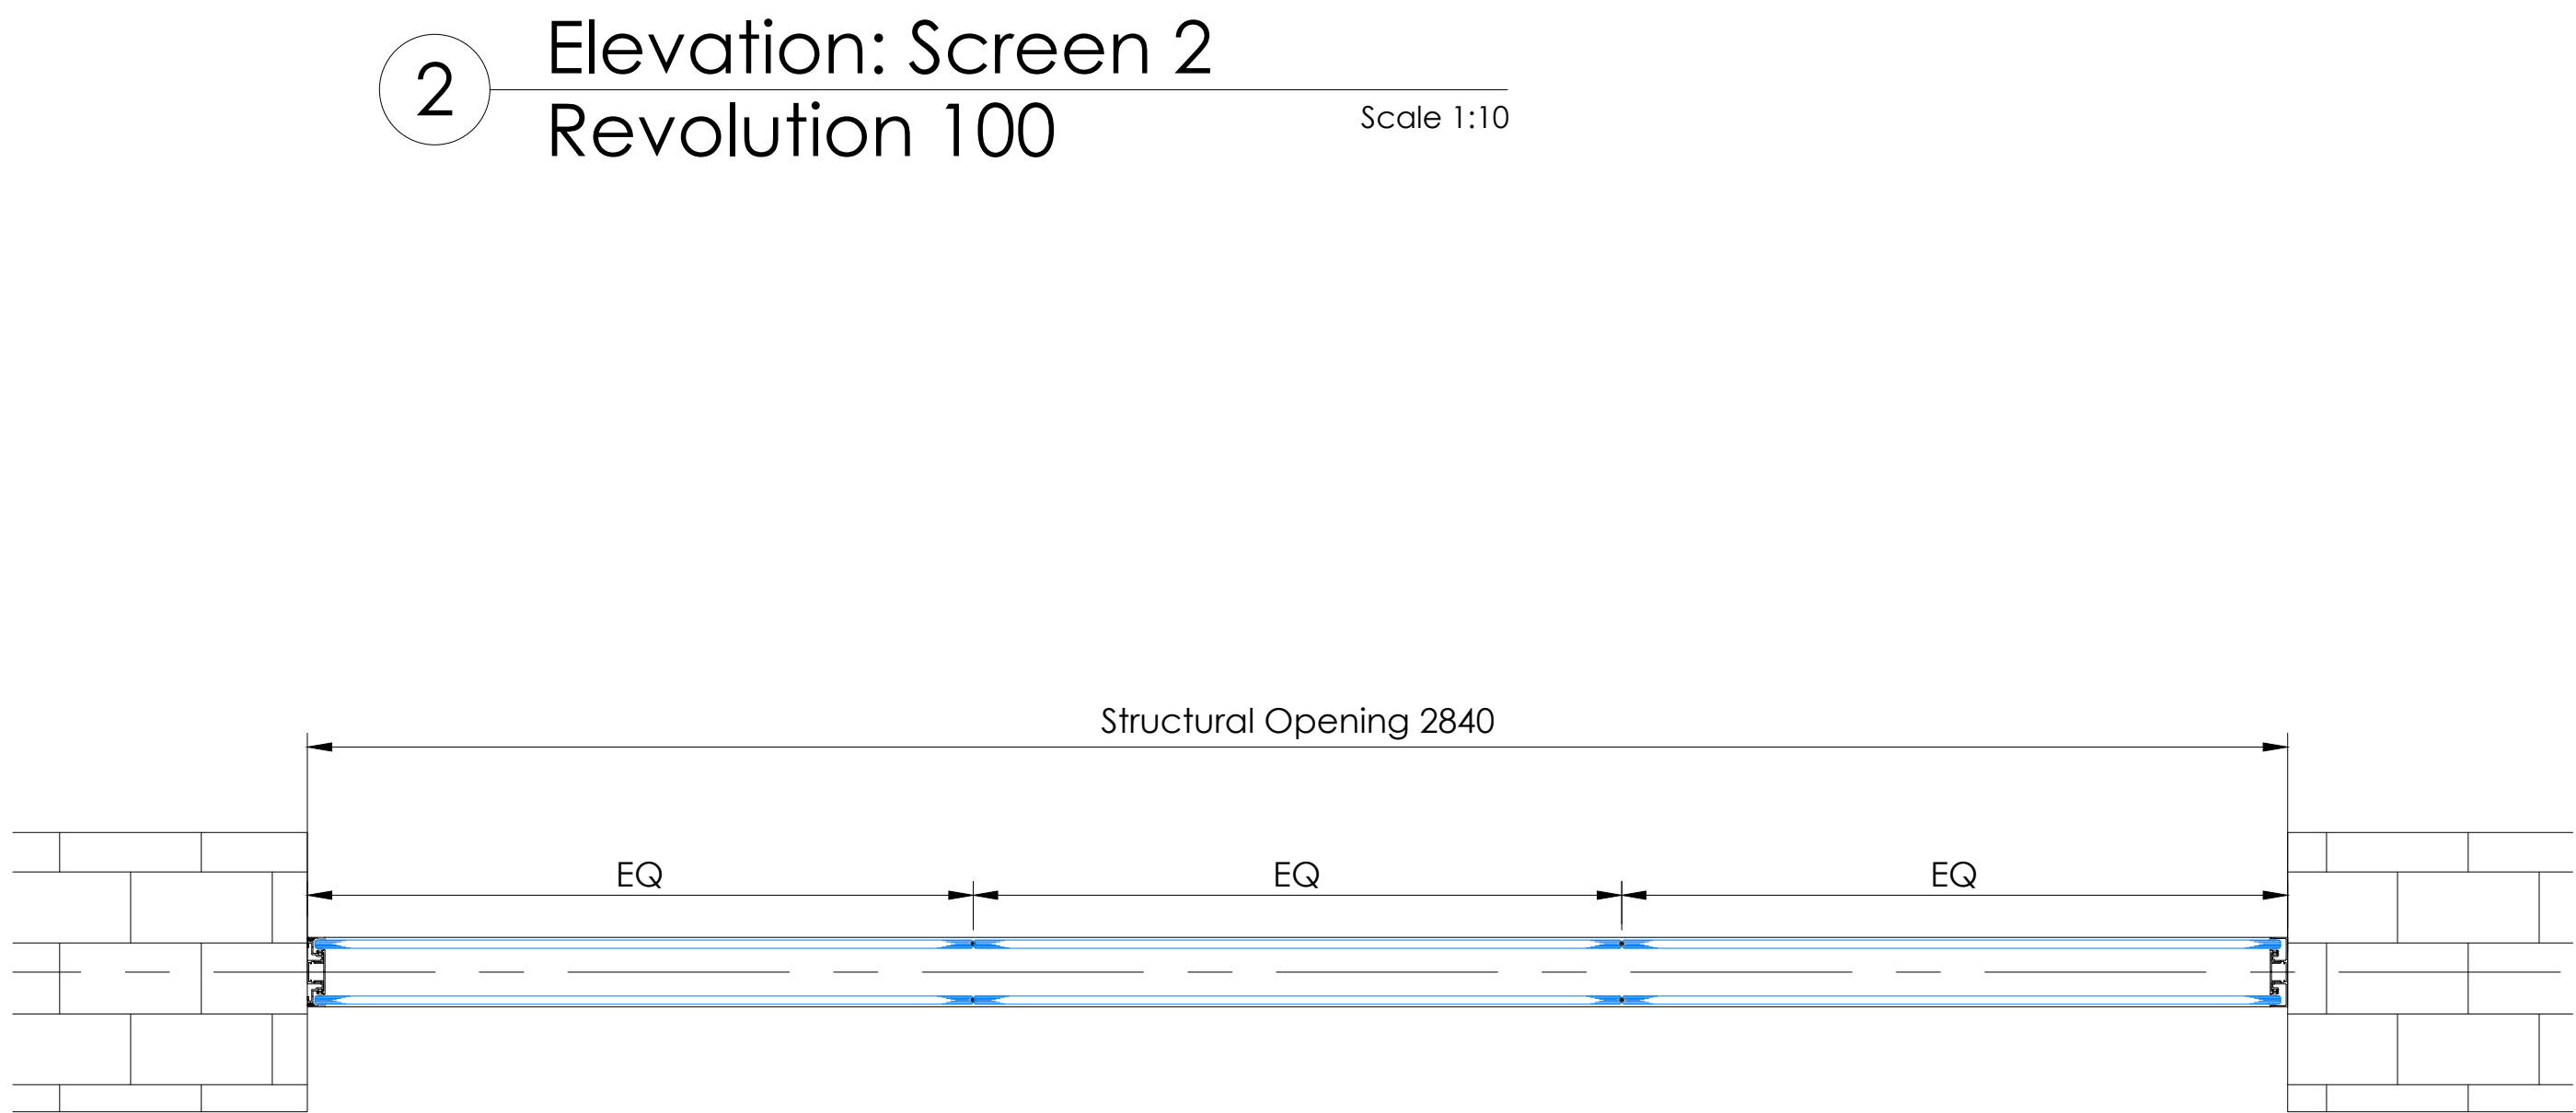
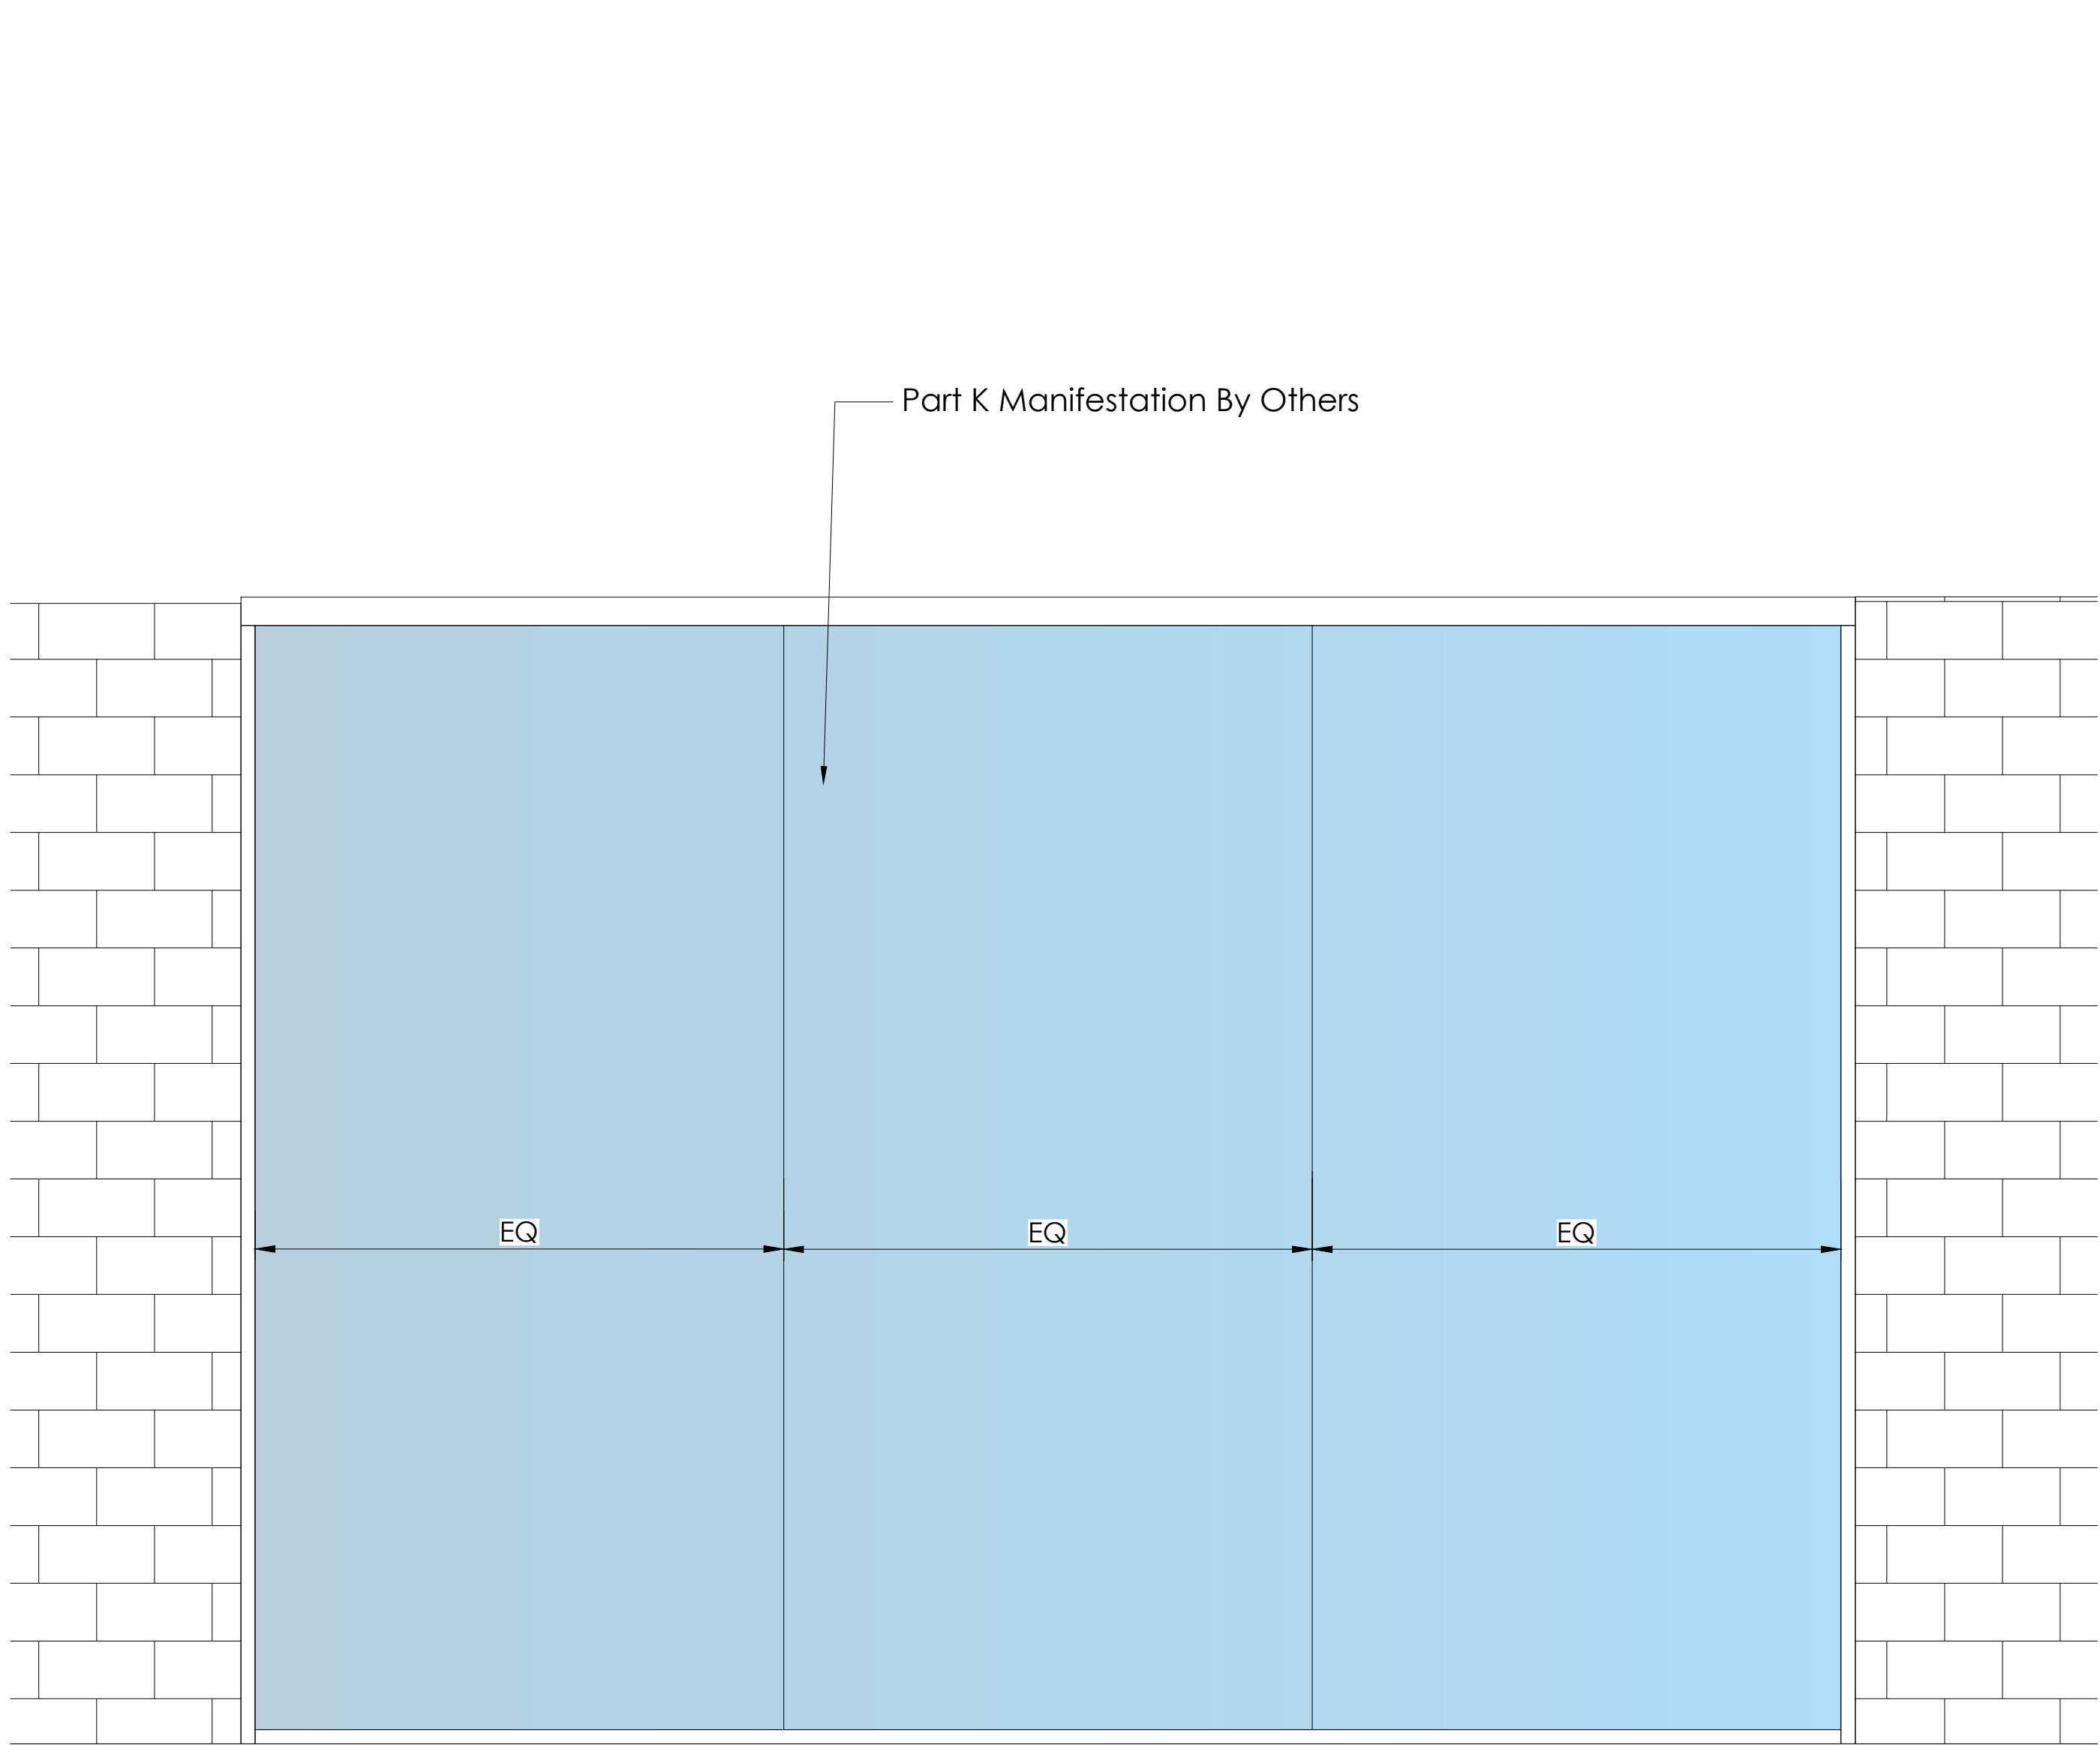
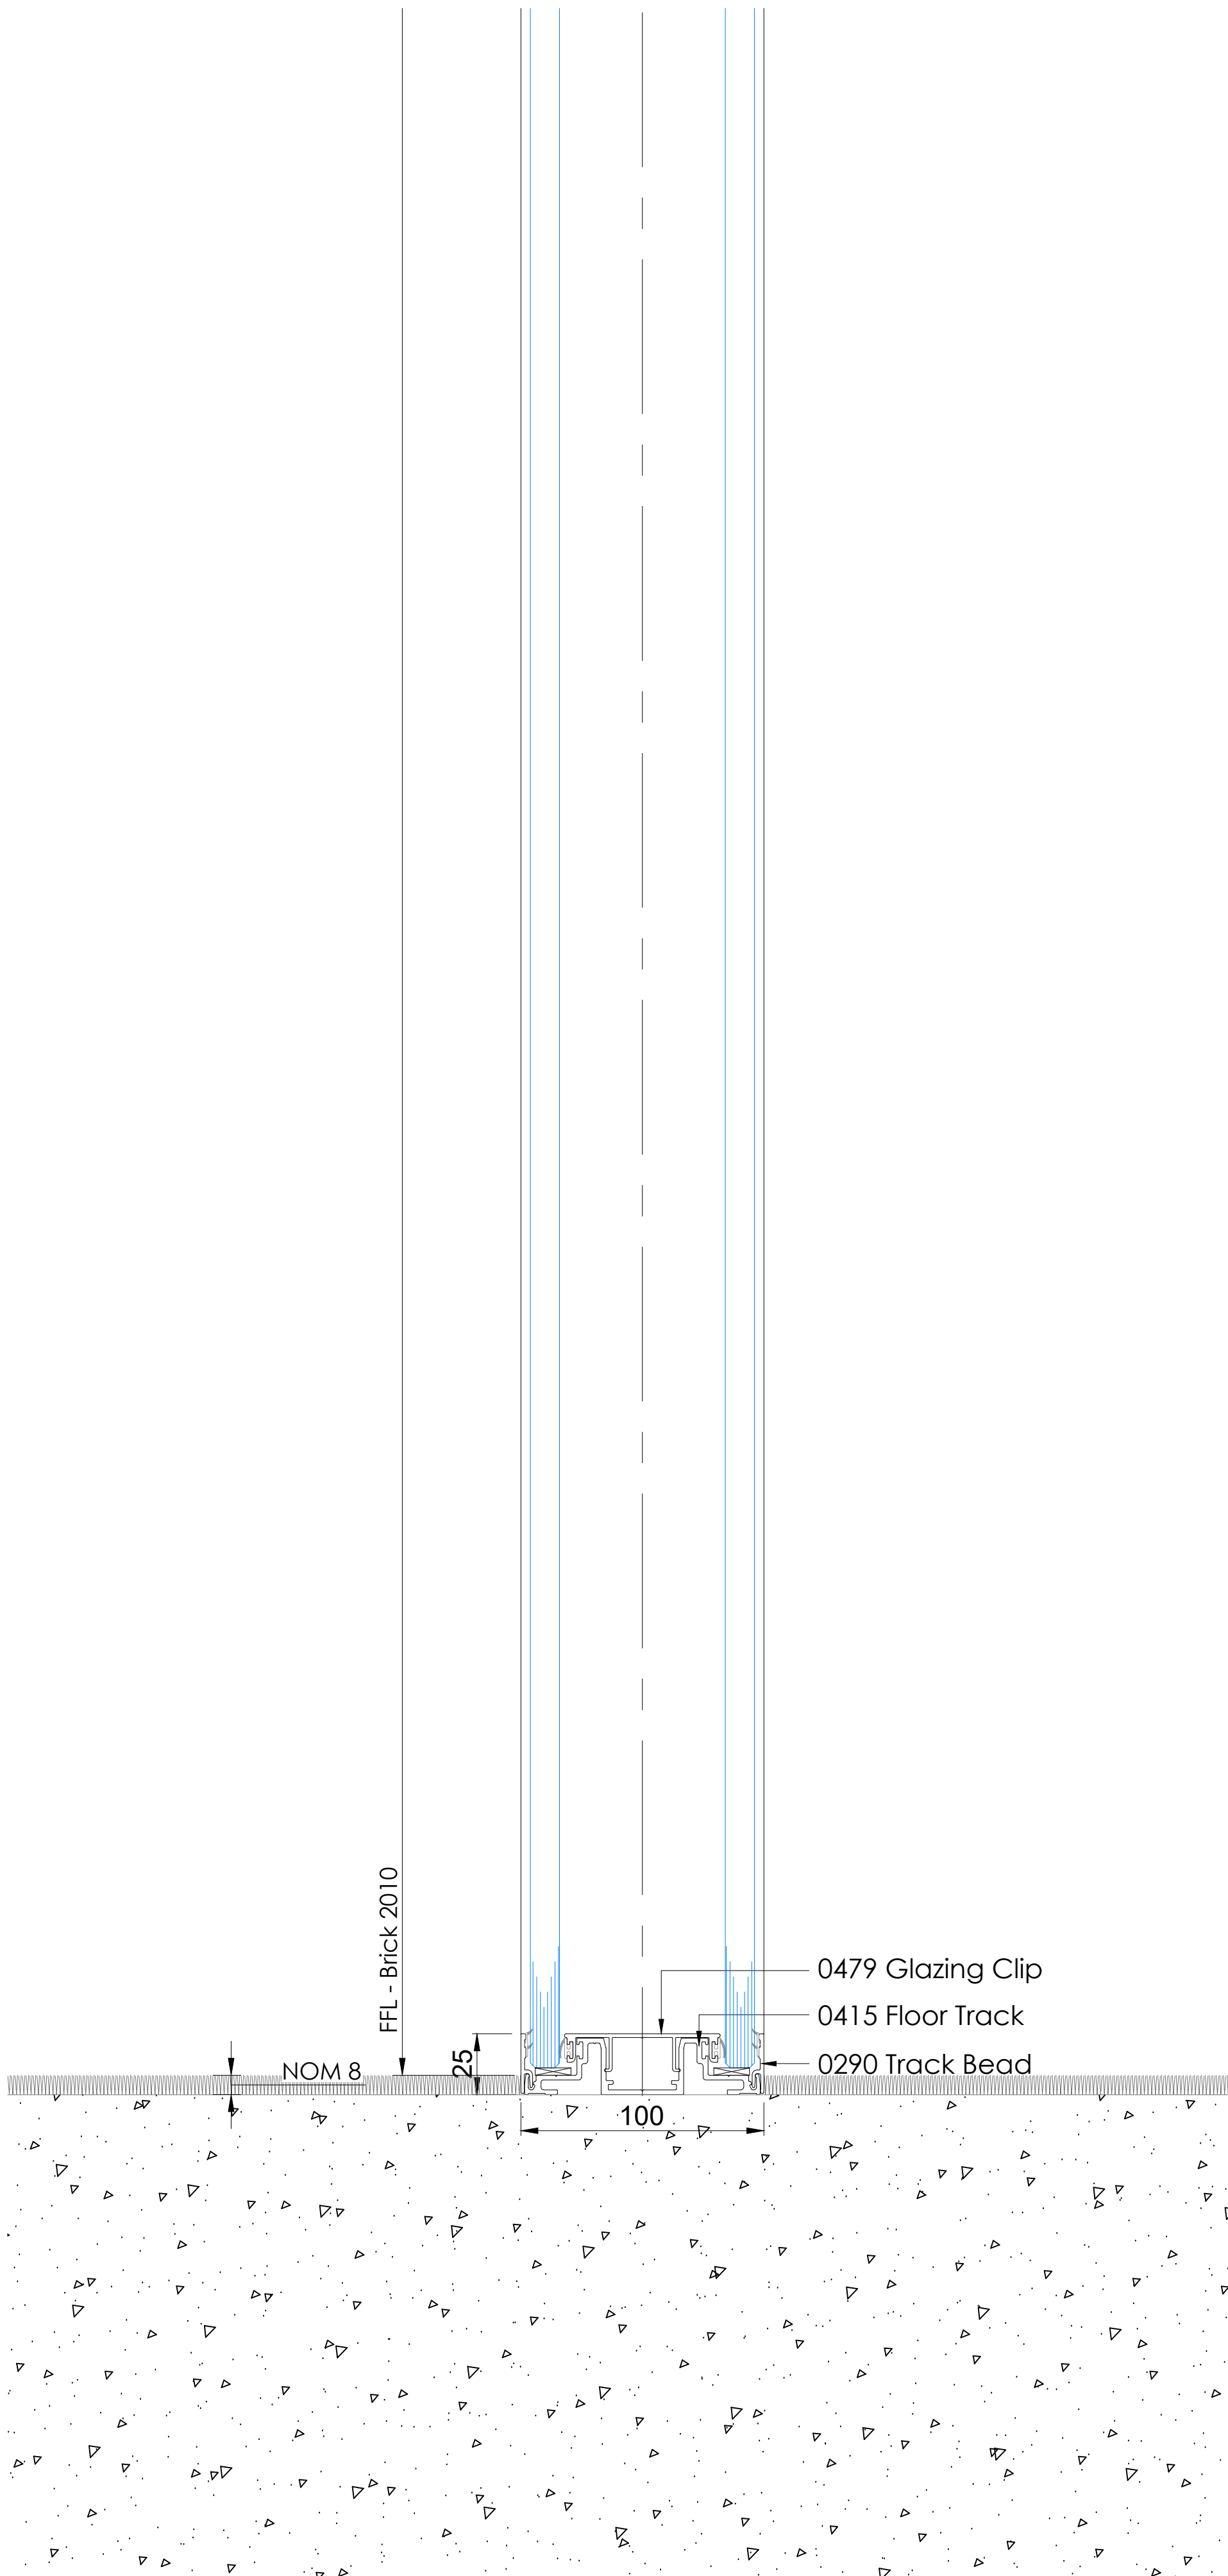


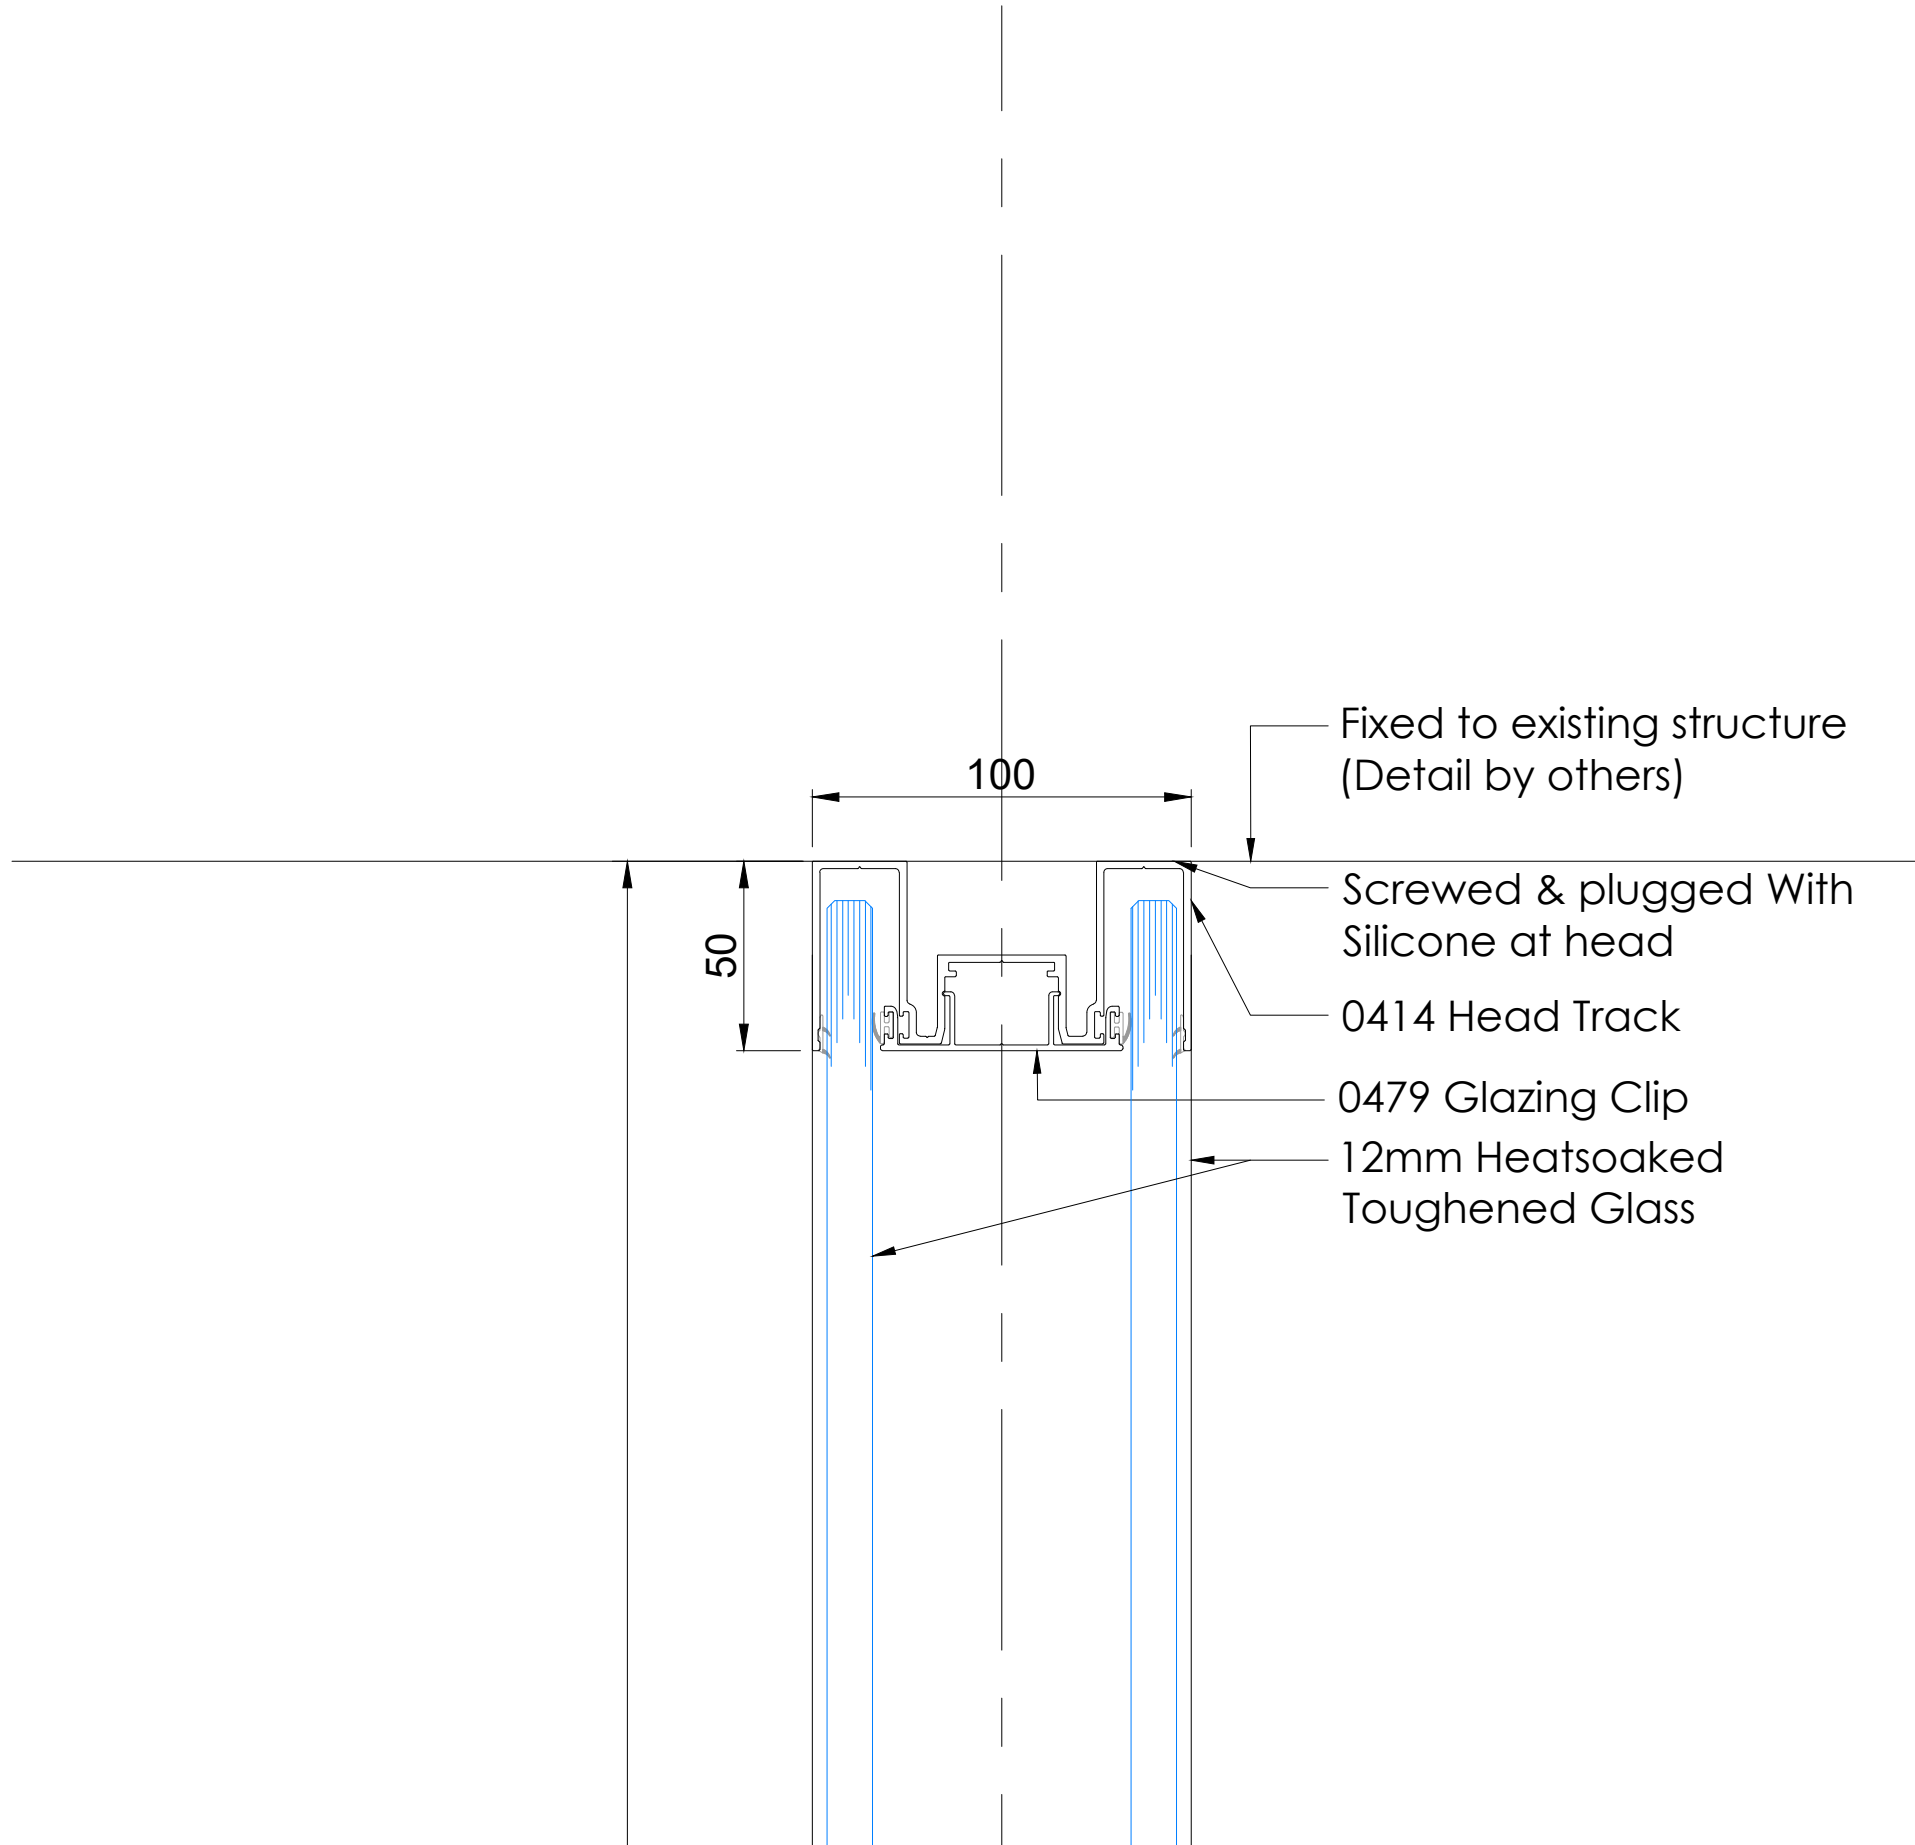

| Safety Health & Environmental Information Box                                                                                                                                                                                                                                                                                                                                                                                                                                                                                                                                                                                        |
|--------------------------------------------------------------------------------------------------------------------------------------------------------------------------------------------------------------------------------------------------------------------------------------------------------------------------------------------------------------------------------------------------------------------------------------------------------------------------------------------------------------------------------------------------------------------------------------------------------------------------------------|
| <b>Construction Risks</b><br>This project uses only materials that have been used in the region before. From a Designer viewpoint, Optima do not envisage any specific Construction Issues to communicate.                                                                                                                                                                                                                                                                                                                                                                                                                           |
| <b>Maintenance / Cleaning Risks</b><br>Optima, in the main, provide office partitioning, the components specifically the glass are tested to the relevant standard or international standard of the glass. As such CLEANING and MAINTENANCE of this project should be no specific risk. However, Optima would point out that all persons involved with maintenance and cleaning should themselves be subject to their own employer's specific risk assessment process. Special care should be taken if working at height. In such cases the regulations of the day apply. Optima do not recommend any loadings against its products. |
| <b>Demolition / Adaptation Risks</b><br>From the viewpoint of a Designer, Optima have identified no significant risks for demolition and adaptation. However, the usual risk assessments are presumed to be implemented by the company proposing demolition and/or adaptation.                                                                                                                                                                                                                                                                                                                                                       |
| <b>Environmental / Recycling</b><br>Much of the Optima range of project is relocatable, stable. See original terms and conditions for clarification. Environmental issues are subject to the law of the day.                                                                                                                                                                                                                                                                                                                                                                                                                         |
| In addition to the hazards / risks normally associated with the types of work detailed on this drawing take note of the above. It is assumed that all work on this drawing will be carried out by competent contractors meeting relevant standards. For an approved method statement.                                                                                                                                                                                                                                                                                                                                                |

| General Information Table 1001 |                                  |
|--------------------------------|----------------------------------|
| Door/Partition                 |                                  |
| Door/Partition Type            | Revolution 100 - Screen 2        |
| Floors                         | 2                                |
| Acoustic Rating                | Screen: Rw45dB                   |
| Ironmongery Set                | N/A                              |
| Door Finish                    | N/A                              |
| Frame Finish                   | RAL 9005                         |
| Deflection                     | N/A                              |
| Glass                          | 12mm thick heat soaked toughened |

Structural Openings To Be Checked On Site

31/03/20

Rev: Rev00

AS BUILT

|     |          |             |    |     |    |
|-----|----------|-------------|----|-----|----|
| AB  | 31.03.20 | As Built    | CC | CT  | GM |
| Rev | Date     | Description | Dr | App | Ck |

Status:

As Built

Optima

© Optima Products Ltd.

OPTIMA CONTRACTING LIMITED  
COURTYARD HOUSE  
WEST END ROAD  
HIGH WYCOMBE  
BUCKINGHAMSHIRE  
HP11 2QB

Tel: +44 (0) 1494 492600  
Web: www.optimaisystems.com

PART OF THE OPTIMA GROUP  
Project:  
50195 Bonded Warehouse L2

Title:  
Revolution 100  
Screen 2

|             |              |           |
|-------------|--------------|-----------|
| Scale @ A0: | Drawing No.: | Revision: |
| VARIES      | OPT-DRG-1001 | AB        |