


Door Type E5 : Internal glazed door to Reception

GENERAL NOTE


To be read in conjunction with Schedule of Works, Door Schedule and GA plans.

3D.03

3D.04

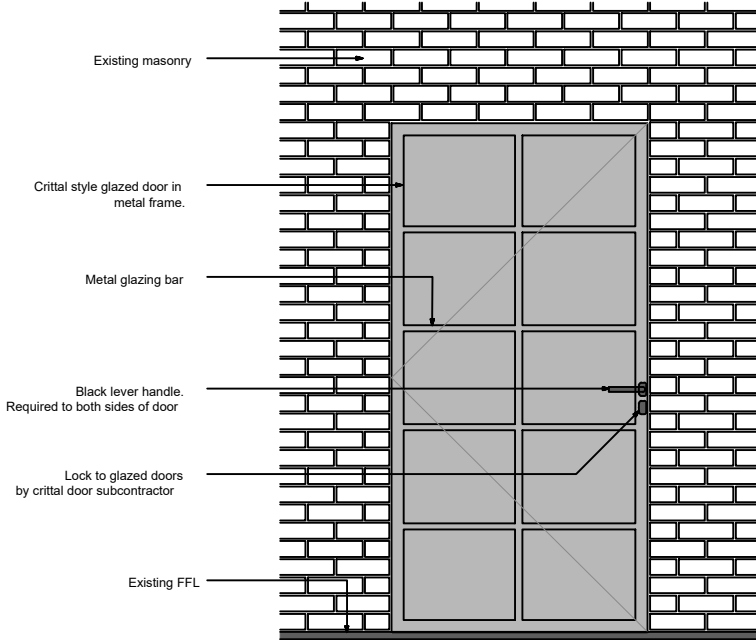

Type E5 : Front Elevation

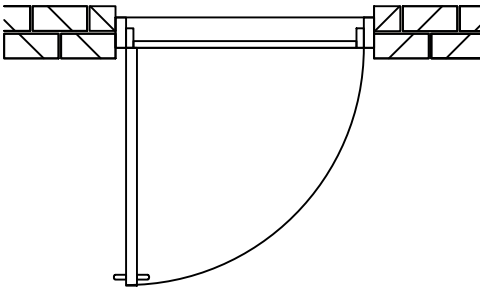

Type E5 : Plan

Door Type E : Internal Glazed Doors

Crittall style metal glazed doors. PPC coating, RAL 9005

All ironmongery to be by specialist subcontractor

For fire rating of doors refer to Door Schedule DP_sD

Note:

Drawing shows design intent only. Final Proposals/Layout for Crittall-Style Glazed Doors and Partitions are to be developed with the specialist subcontractor and approved by the Architect before manufacture

Notes:

Do not scale from this drawing. All dimensions to be checked on-site by contractor to ensure accuracy prior to any installation. All design work produced by Amspec Ltd is for indicative purposes only. It is the client and contractors responsibility to ensure that building control and fire officer approval have been met prior to commencement of site work

REV:	DESCRIPTION:	BY:	DATE:
STATUS: AS BUILT			
amspec DESIGN & BUILD SOLUTIONS f : 01942 621342 f : 01942 226552 www.amspec.co.uk			
CLIENT:		OBI 80 MOSELY STREET MANCHESTER M2 3FX	
ARCHITECT:			
SITE:		18 LOWER BYROM STREET MANCHESTER	
TITLE:		LEVEL 3 DOOR TYPE E5	
SCALE AT A3: 1:25	DATE: 28.06.19	DRAWN: CR	CHECKED: IC
PROJECT NO: 1683	DRAWING NO: DP_DT-19		REVISION: