


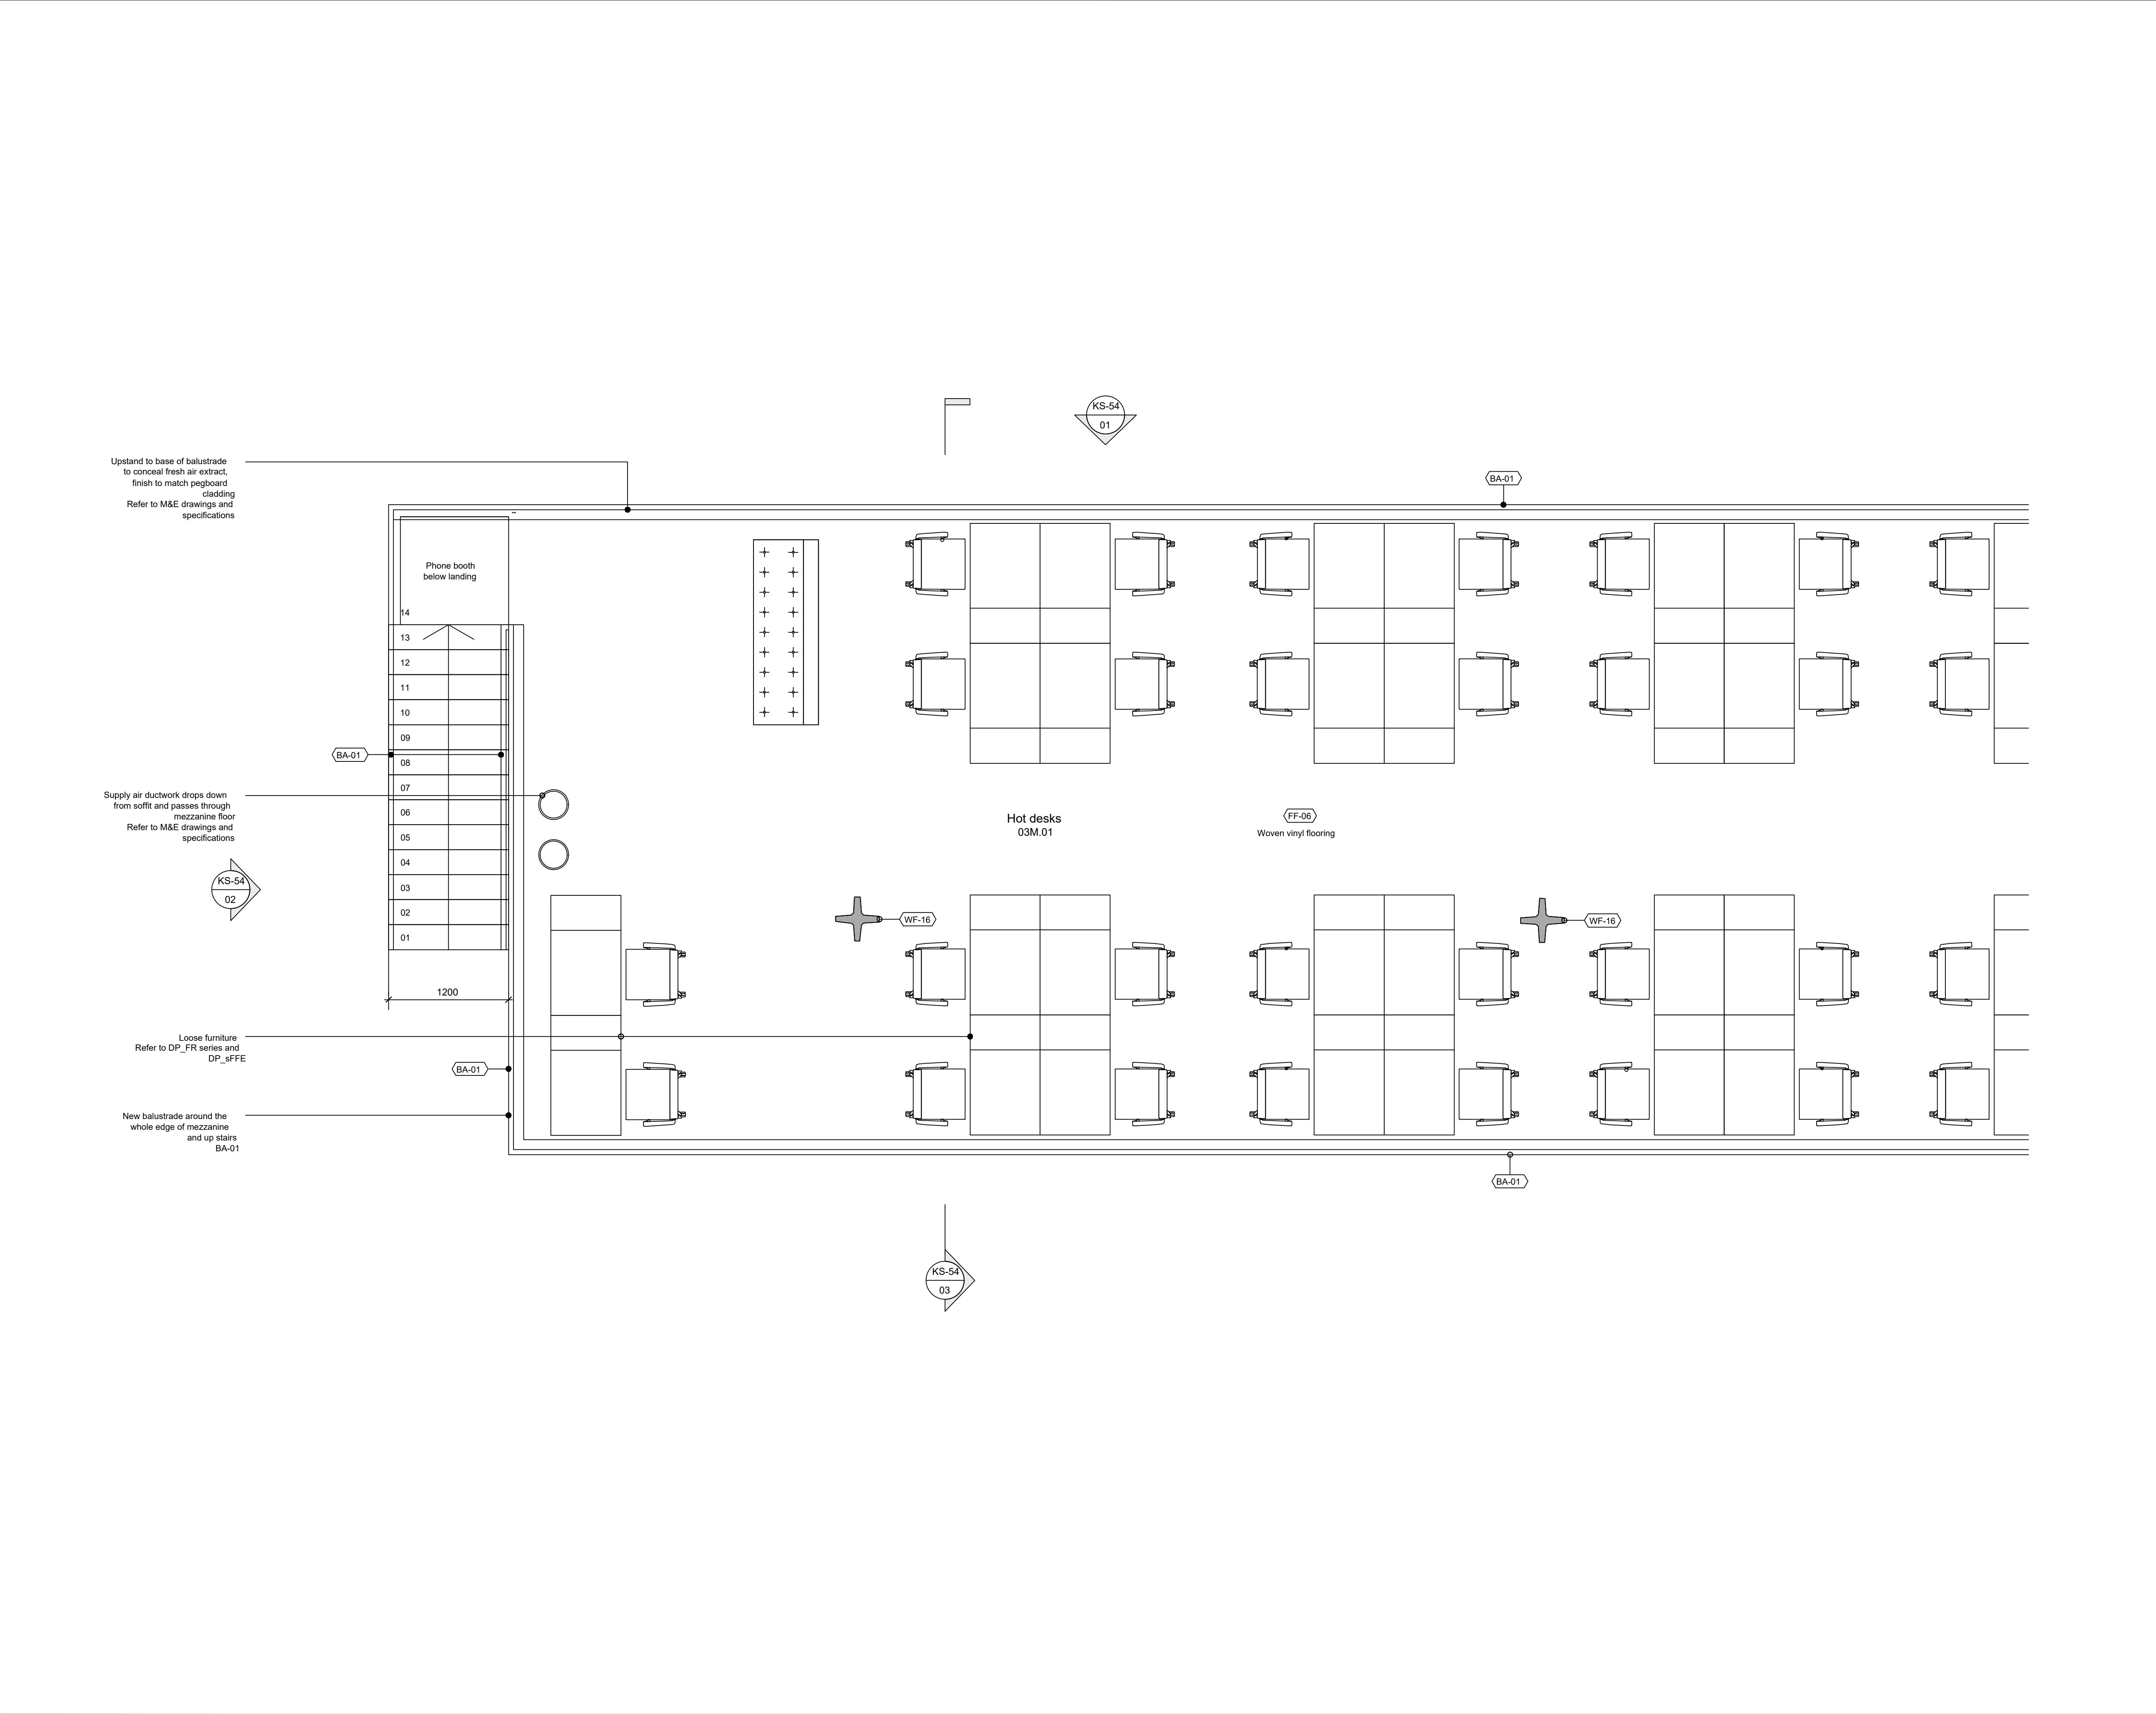

Notes:

Do not scale from this drawing. All dimensions to be checked on-site by contractor to ensure accuracy prior to any installation. All design work produced by Amspec Ltd is for indicative purposes only. It is the client and contractors responsibility to ensure that building control and fire officer approval have been met prior to commencement of site work.

Drawing Key

FLOOR FINISHES

FF-05Existing timber floor

FF-06Bolon Elements Birch Woven Vinyl

WALL FINISHES

WF-06Black MDF peg board cladding

WF-10Diamond matt RAL 9010 pure white Emulsion

WF-16Paint to existing metal columns

WF-19Paint to new plasterboard partition

BALUSTRADES / HANDRAILS

BA-01New black lacquered metal balustrade

CEILING TYPES

CL-01New painted plasterboard MF ceiling

CL-03Existing exposed brick soffit and steel beams

CEILING FINISHES

CF-01Paint to plasterboard MF ceiling

CF-05Paint to existing steel beams

LIGHT FITTINGS

LI-04Existing linear lights - adjusted to be surface mounted

REV:	DESCRIPTION:	BY:	DATE:
STATUS: AS BUILT			
amspec DESIGN & BUILD SOLUTIONS t : 01942 621342 f : 01942 226552 www.amspec.co.uk			
CLIENT:	OBI 80 MOSELY STREET MANCHESTER M2 3FX		
ARCHITECT:			
SITE:	18 LOWER BYROM STREET MANCHESTER		
TITLE:	LEVEL 3 DP WORKS HUB TYPICAL POD MEZZ PLAN		
SCALE AT A1:	DATE:	DRAWN:	CHECKED:
1:30	27.06.19	CR	IC
PROJECT NO:	DRAWING NO:	REVISION:	
1683	DP_KS-52		