


Door Type J: Internal Door to Phone Booth

GENERAL NOTE

To be read in conjunction with Schedule of Works, Door Schedule and GA plans.

3D.47

3D.48

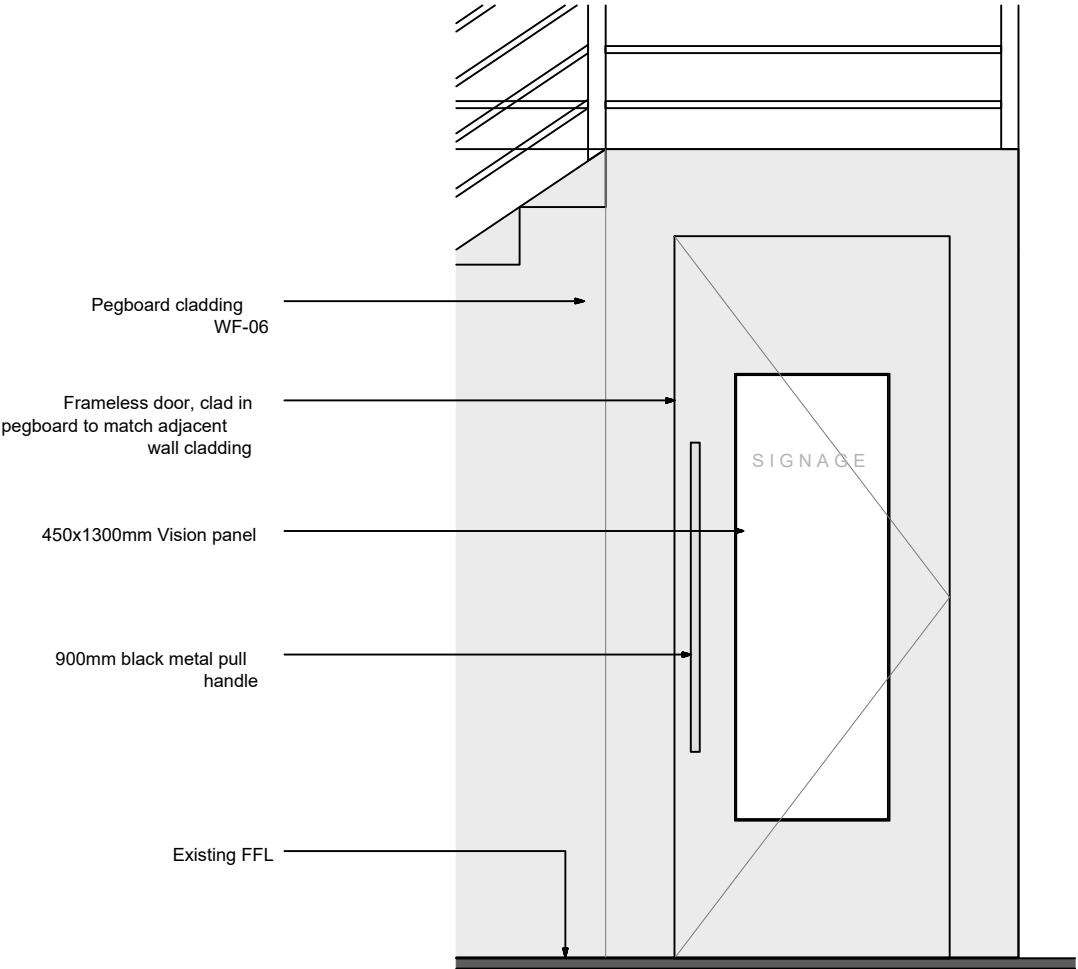

Type J : Front Elevation

Door Type J : Single frameless door with peg board cladding

Solids door with vision panel.

Concealed hinges and concealed door closer.

Note:

Drawing shows design intent only. Final Proposals/Layout for Doors and Partitions are to be developed with the specialist subcontractor and approved by the Architect before manufacture

Notes:

Do not scale from this drawing. All dimensions to be checked on-site by contractor to ensure accuracy prior to any installation. All design work produced by Amspec Ltd is for indicative purposes only. It is the client and contractors responsibility to ensure that building control and fire officer approval have been met prior to commencement of site work

REV:	DESCRIPTION:	BY:	DATE:
STATUS: AS BUILT			
amspec DESIGN & BUILD SOLUTIONS f : 01942 621342 f : 01942 226552 www.amspec.co.uk			
CLIENT:	OBI 80 MOSELY STREET MANCHESTER M2 3FX		
ARCHITECT:			
SITE:	18 LOWER BYROM STREET MANCHESTER		
TITLE:	LEVEL 3 DOOR TYPE J		
SCALE AT A3: 1:25	DATE: 28.06.19	DRAWN: CR	CHECKED: IC
PROJECT NO: 1683	DRAWING NO: DP_DT-22	REVISION:	