
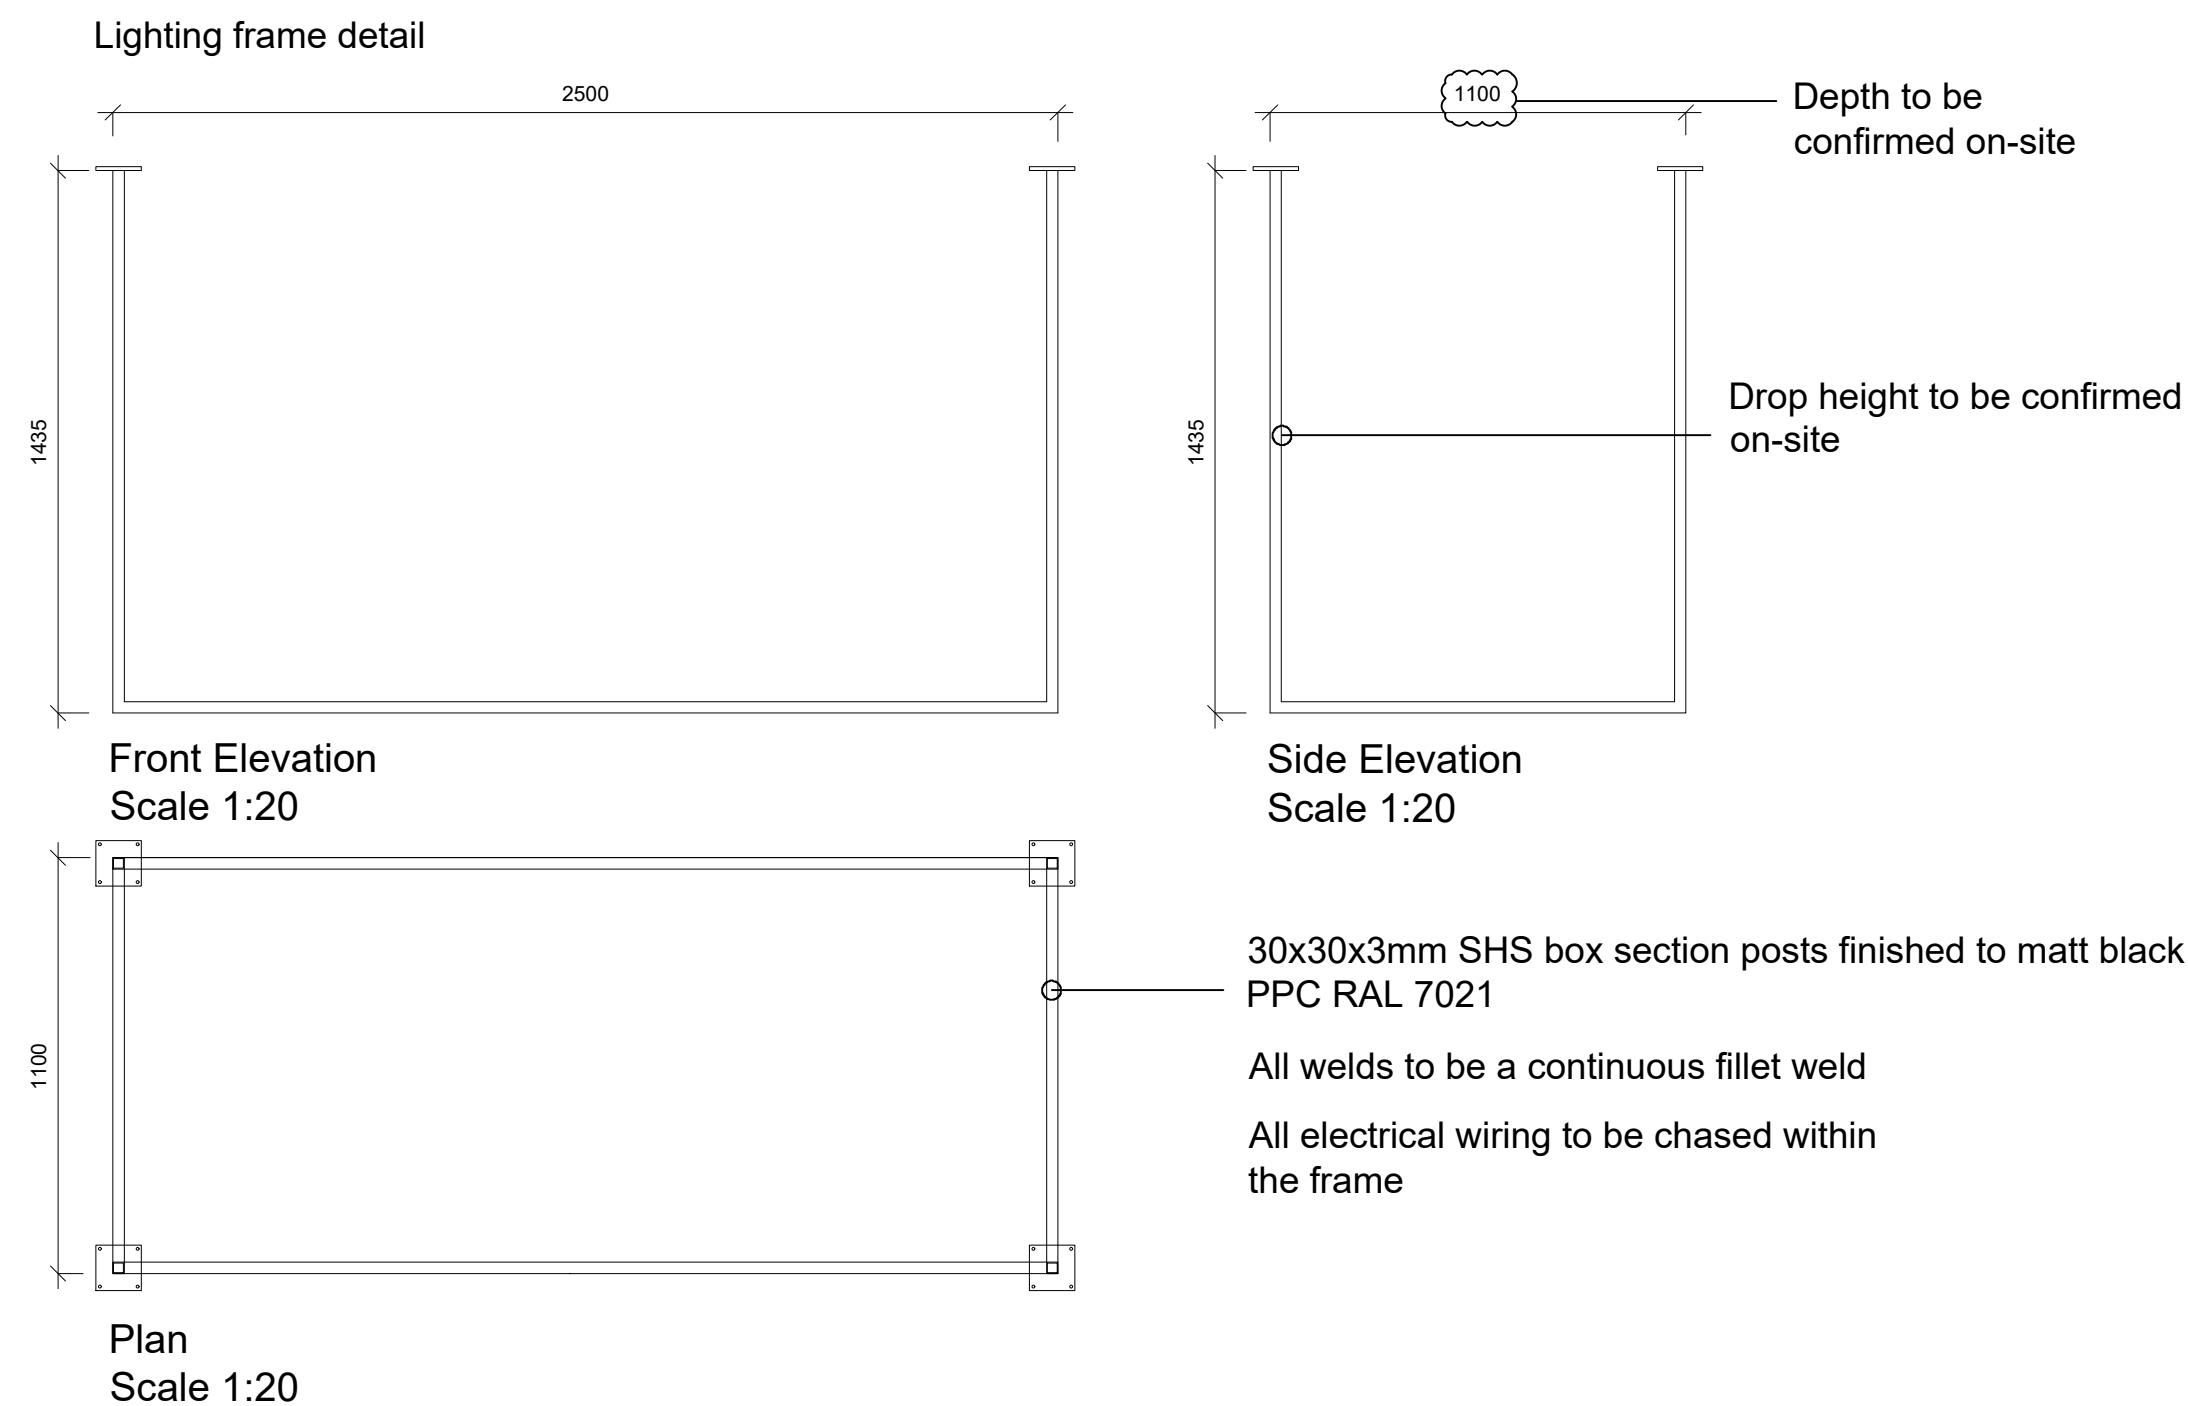
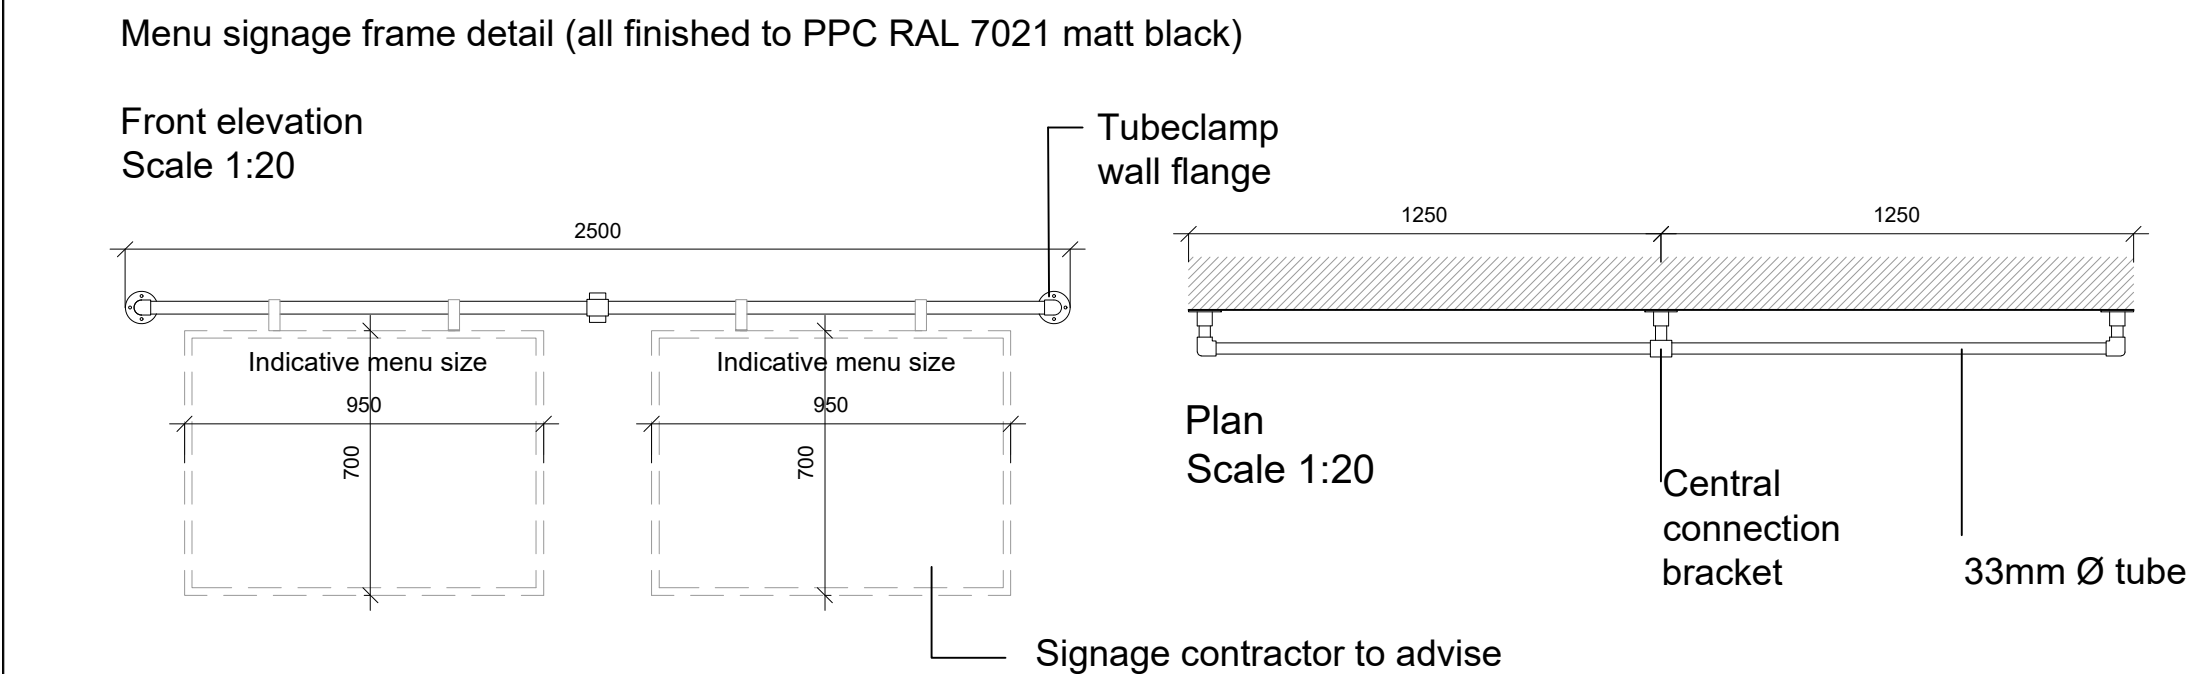
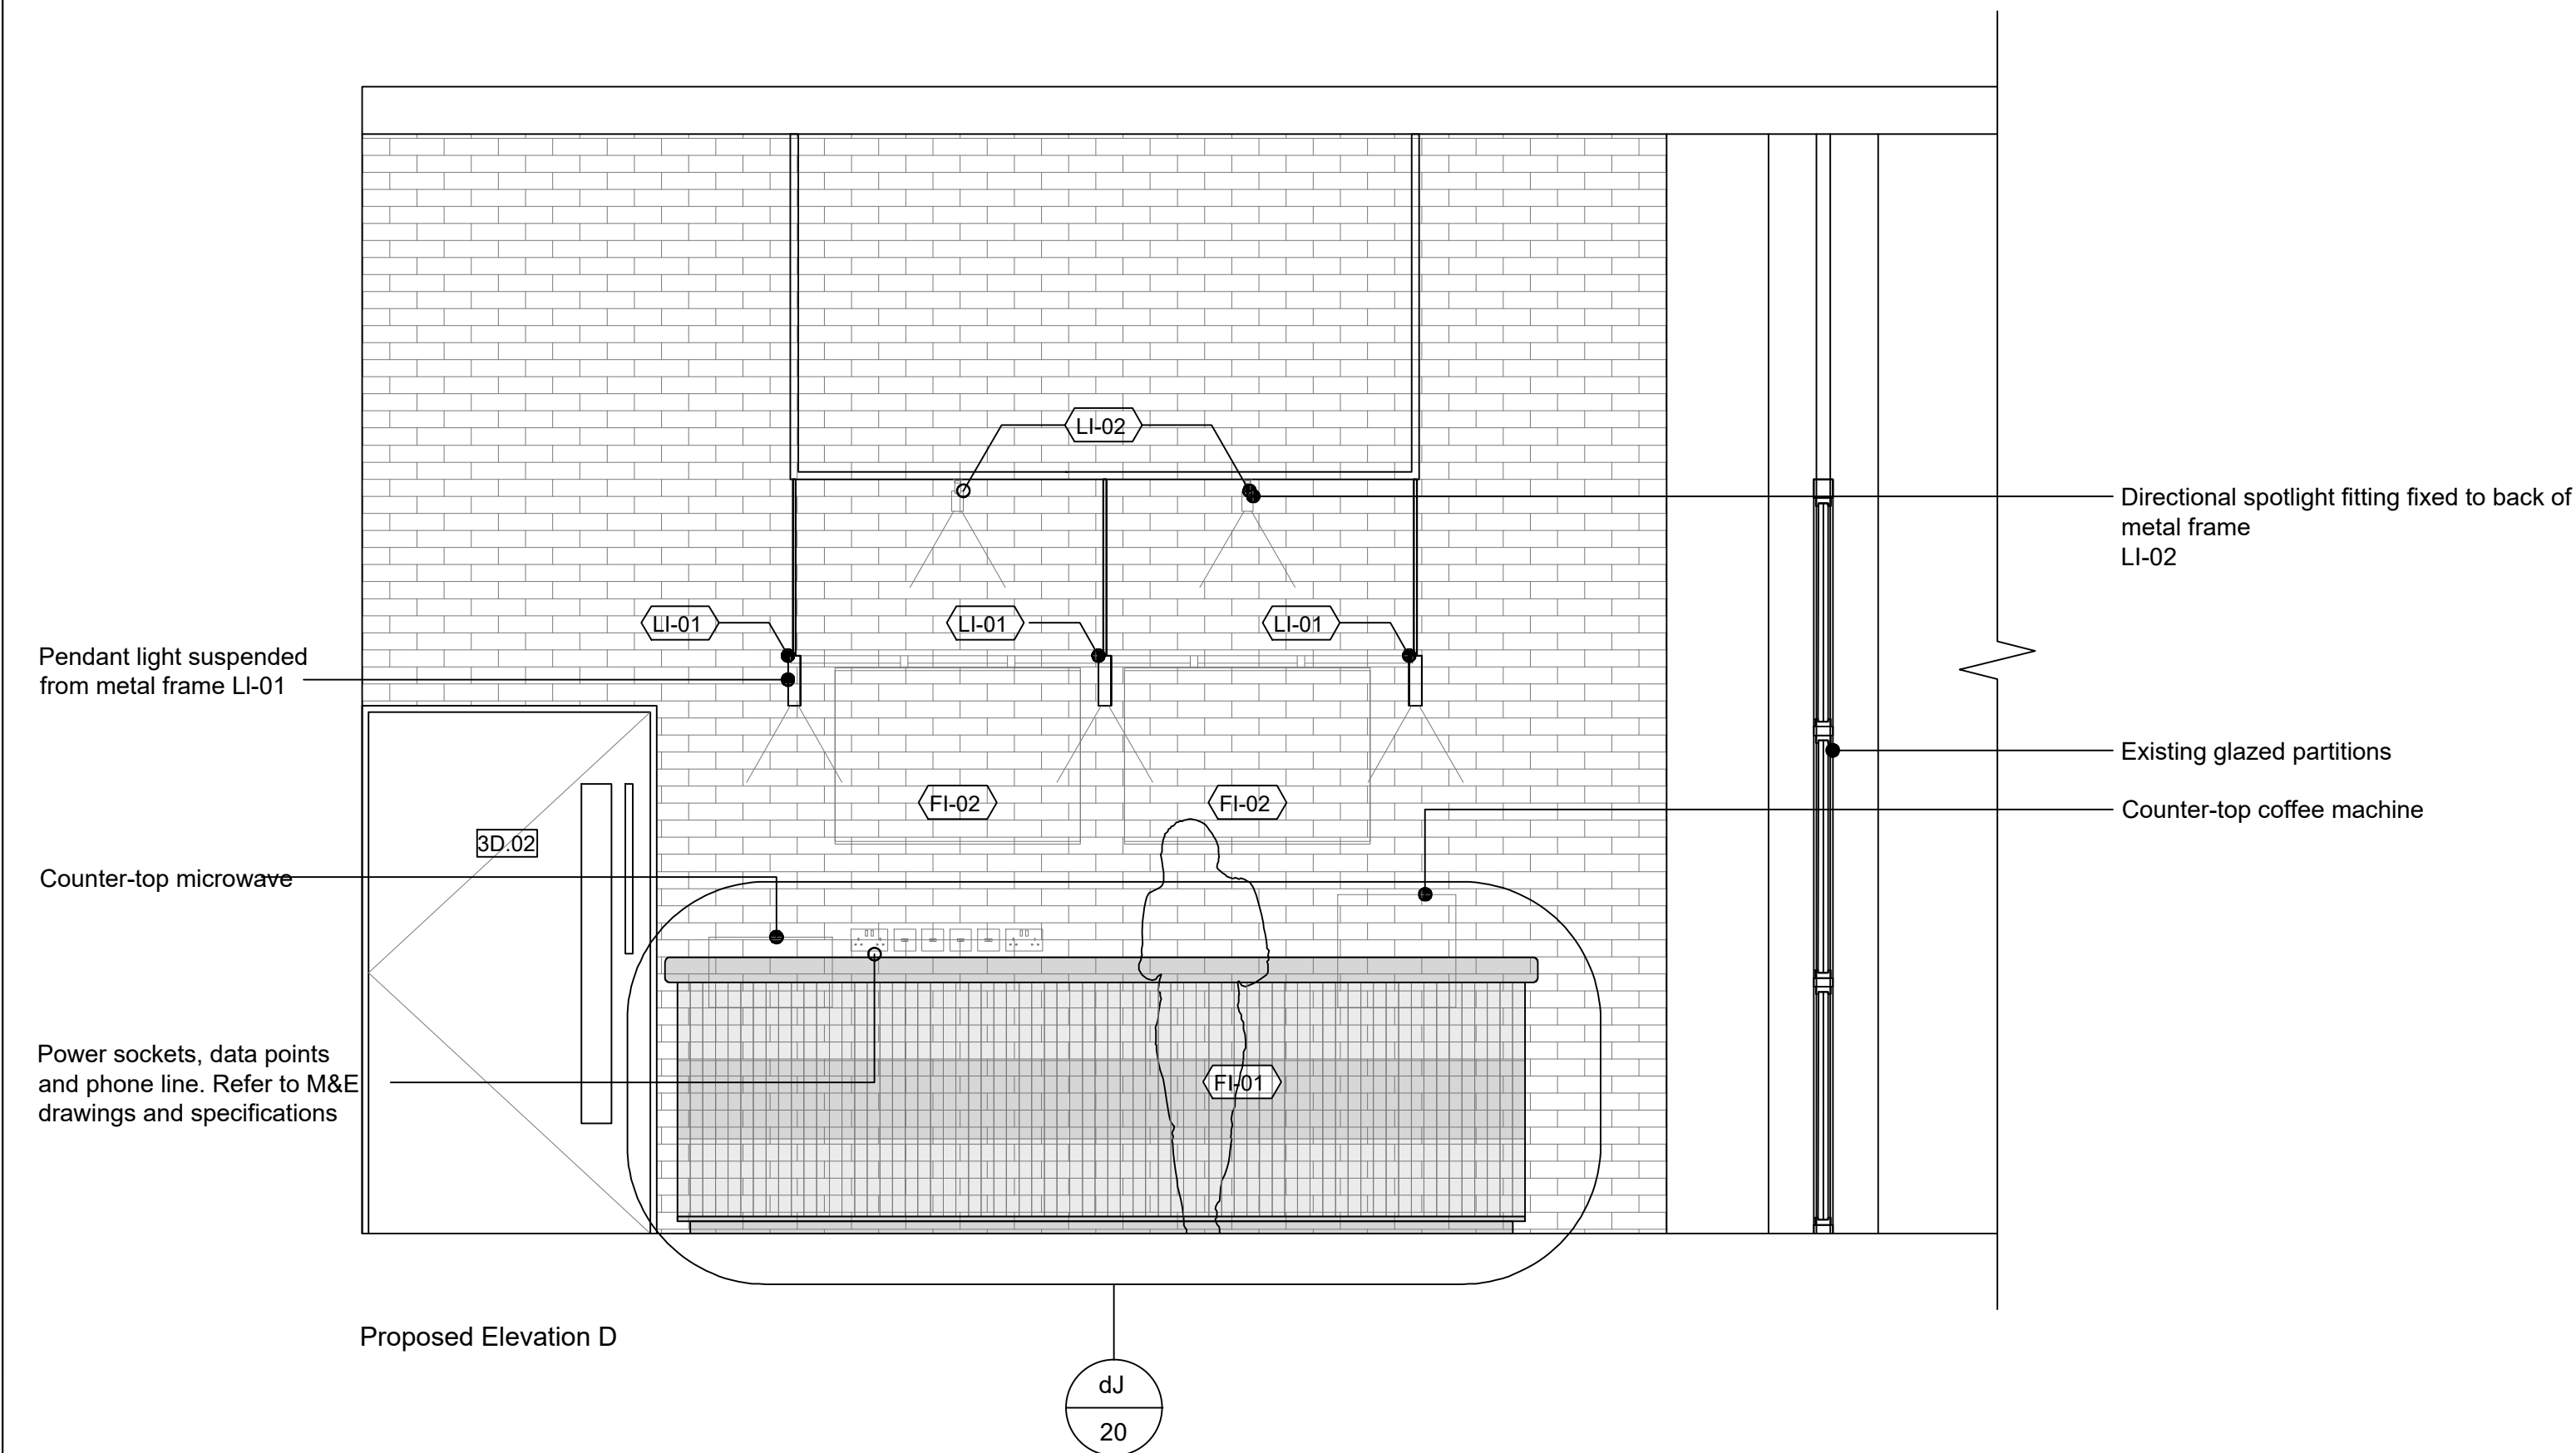


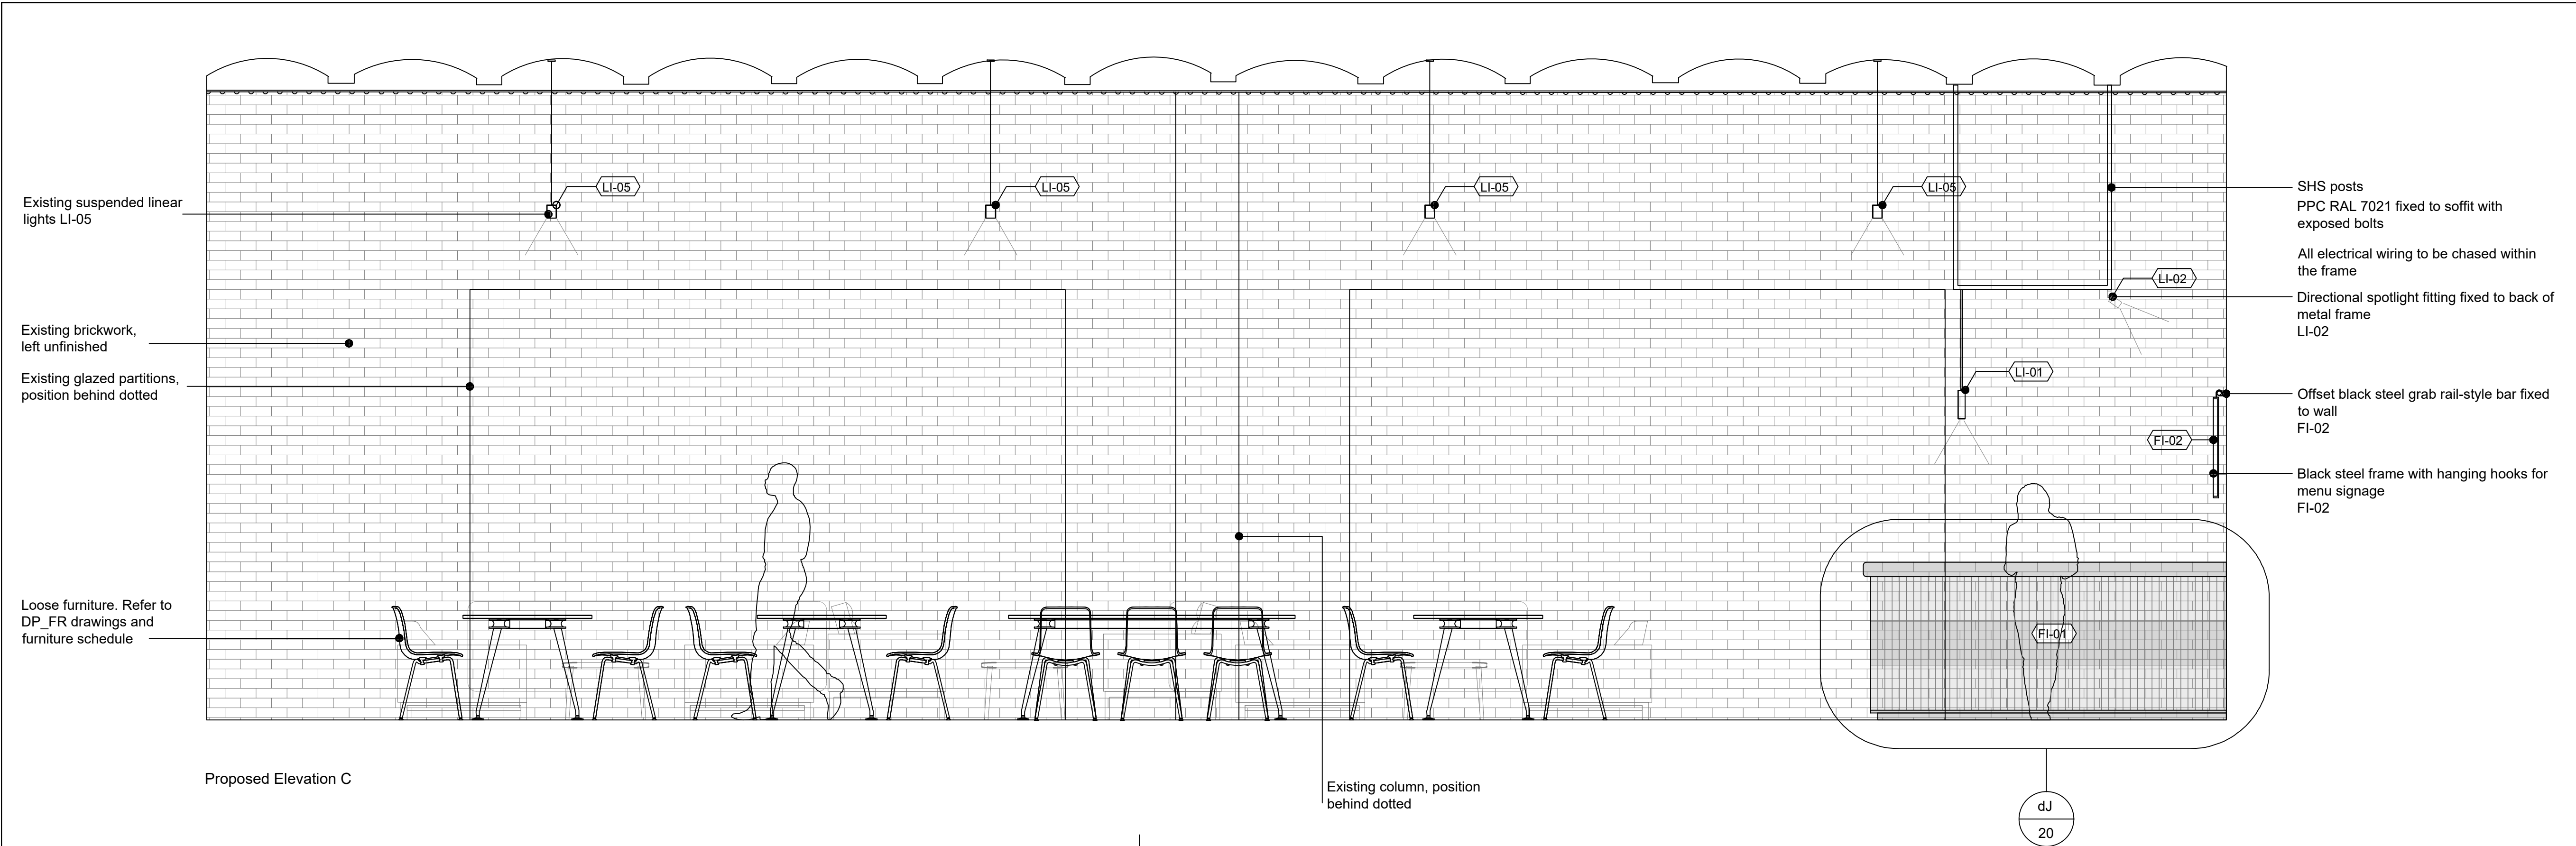

Notes:

Do not scale from this drawing. All dimensions to be checked on-site by contractor to ensure accuracy prior to any installation. All design work produced by Amspec Ltd is for indicative purposes only. It is the client and contractors responsibility to ensure that building control and fire officer approval have been met prior to commencement of site work

Drawing Key

Refer to Lighting Schedule DP\_at

LIGHT FITTINGS

LI-01

Mini Peretto Black Pendant

LI-02

GU11 Tube spot Black Directional Spotlight

LI-05

Existing linear lights

FIXTURES / FITTINGS

FI-01

Free standing bespoke counter

FI-02

Menu signage

CEILING TYPES


CL-03

Existing exposed brick soffit and steel beams

FLOOR FINISHES

FF-08

Existing timber floor

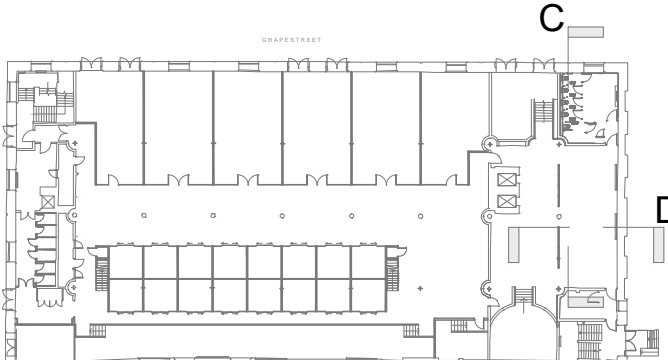

REV:

DESCRIPTION:

BY:

DATE:

STATUS:

AS BUILT



DESIGN & BUILD SOLUTIONS

t : 01942 621342 f : 01942 226552

www.amspec.co.uk

CUJENT:

OBI

80 MOSLEY STREET

MANCHESTER

M2 3FX

ARCHITECT:

SITE:

18 LOWER BYROM STREET

MANCHESTER

TITLE:

RECEPTION

COFFEE ELEVATIONS C & D

SCALE AT A1:

DATE:

DRAWN:

CHECKED:

1:25

28.06.19

CR

IC

PROJECT NO:

DRAWING NO:

REVISION:

1683

DP\_KS-73