
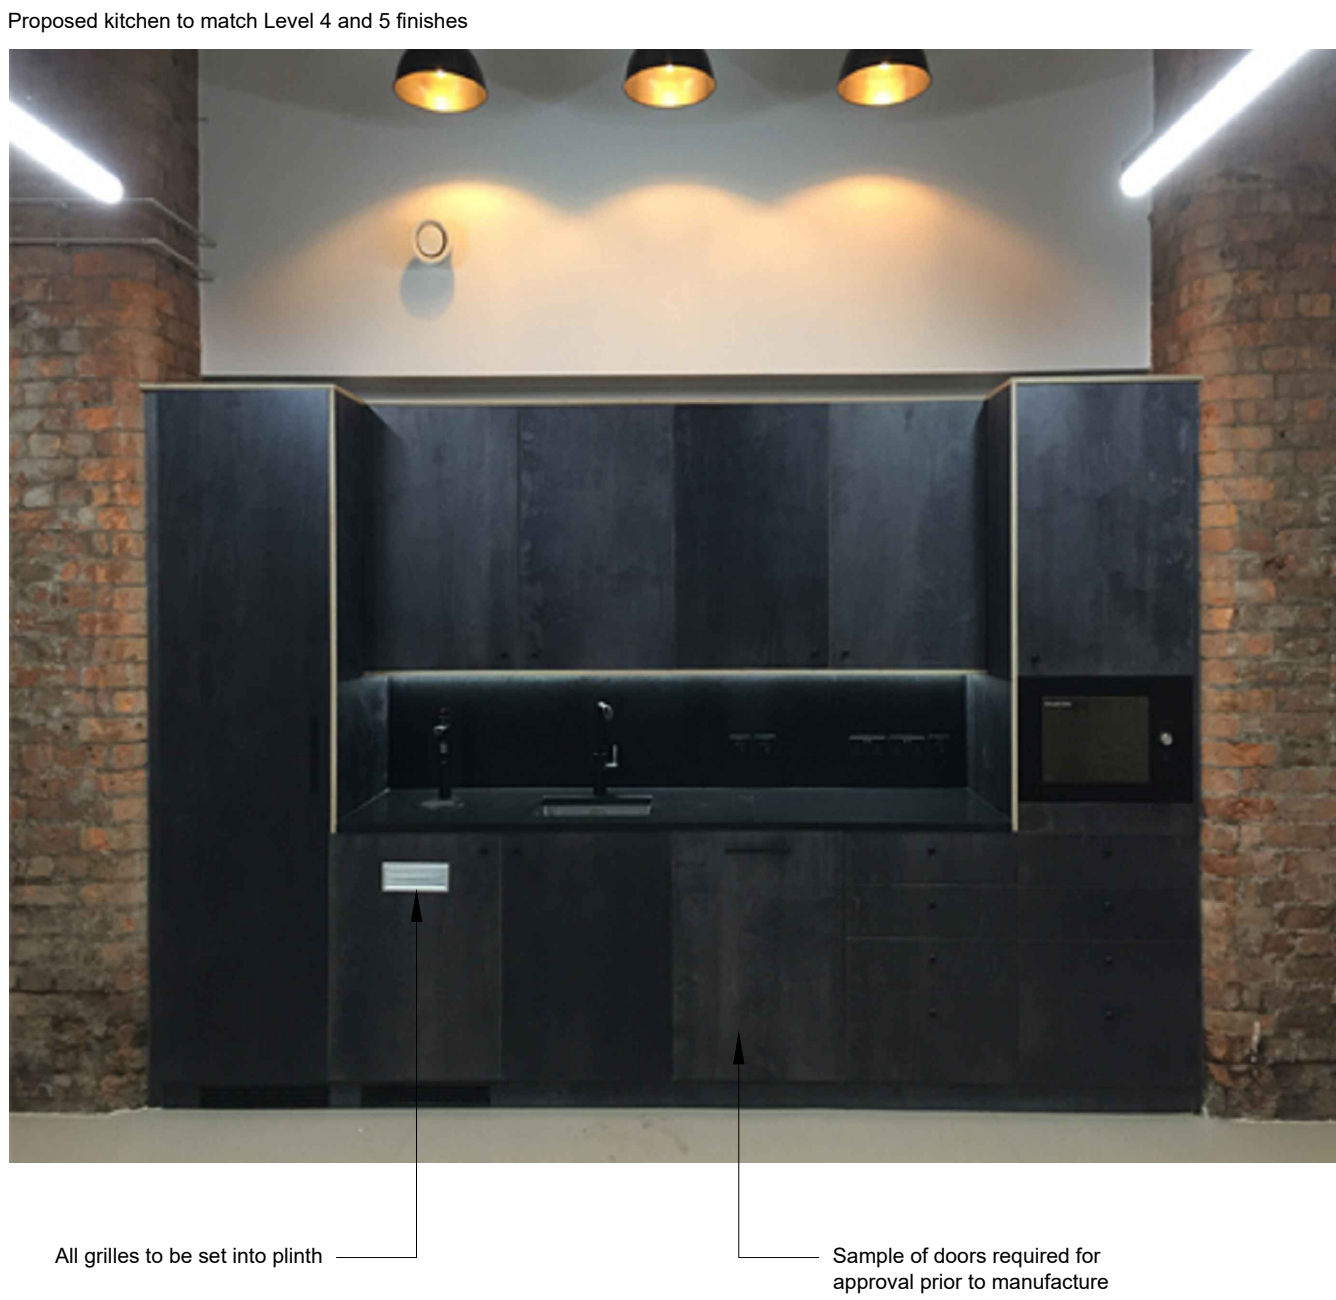
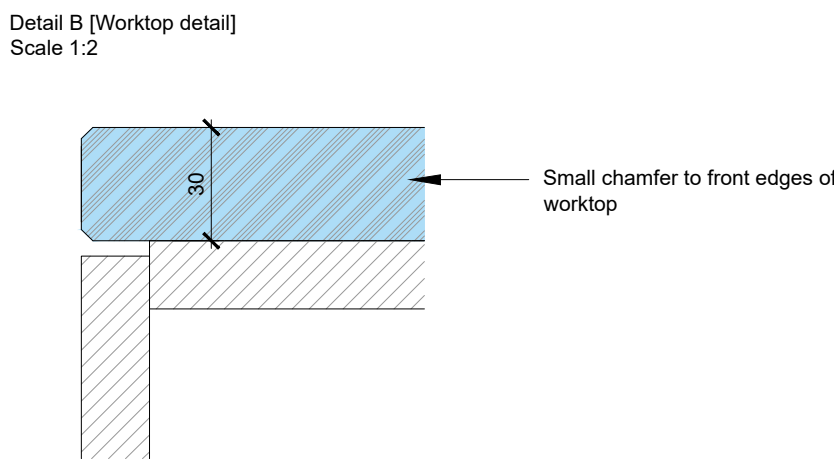
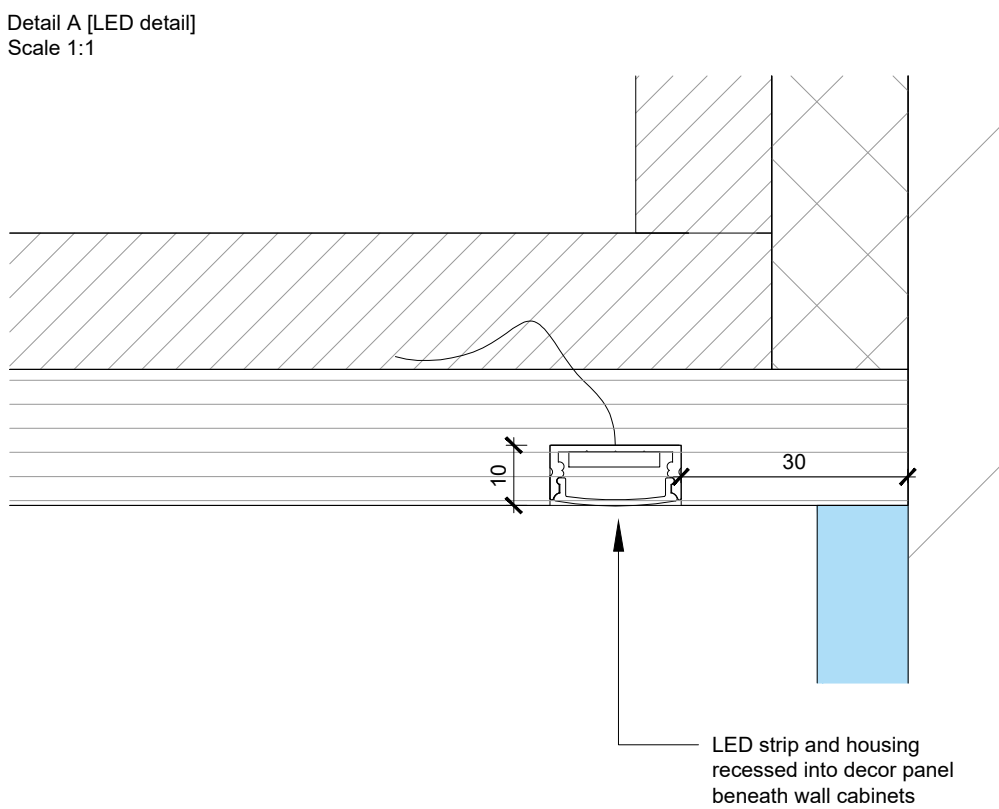


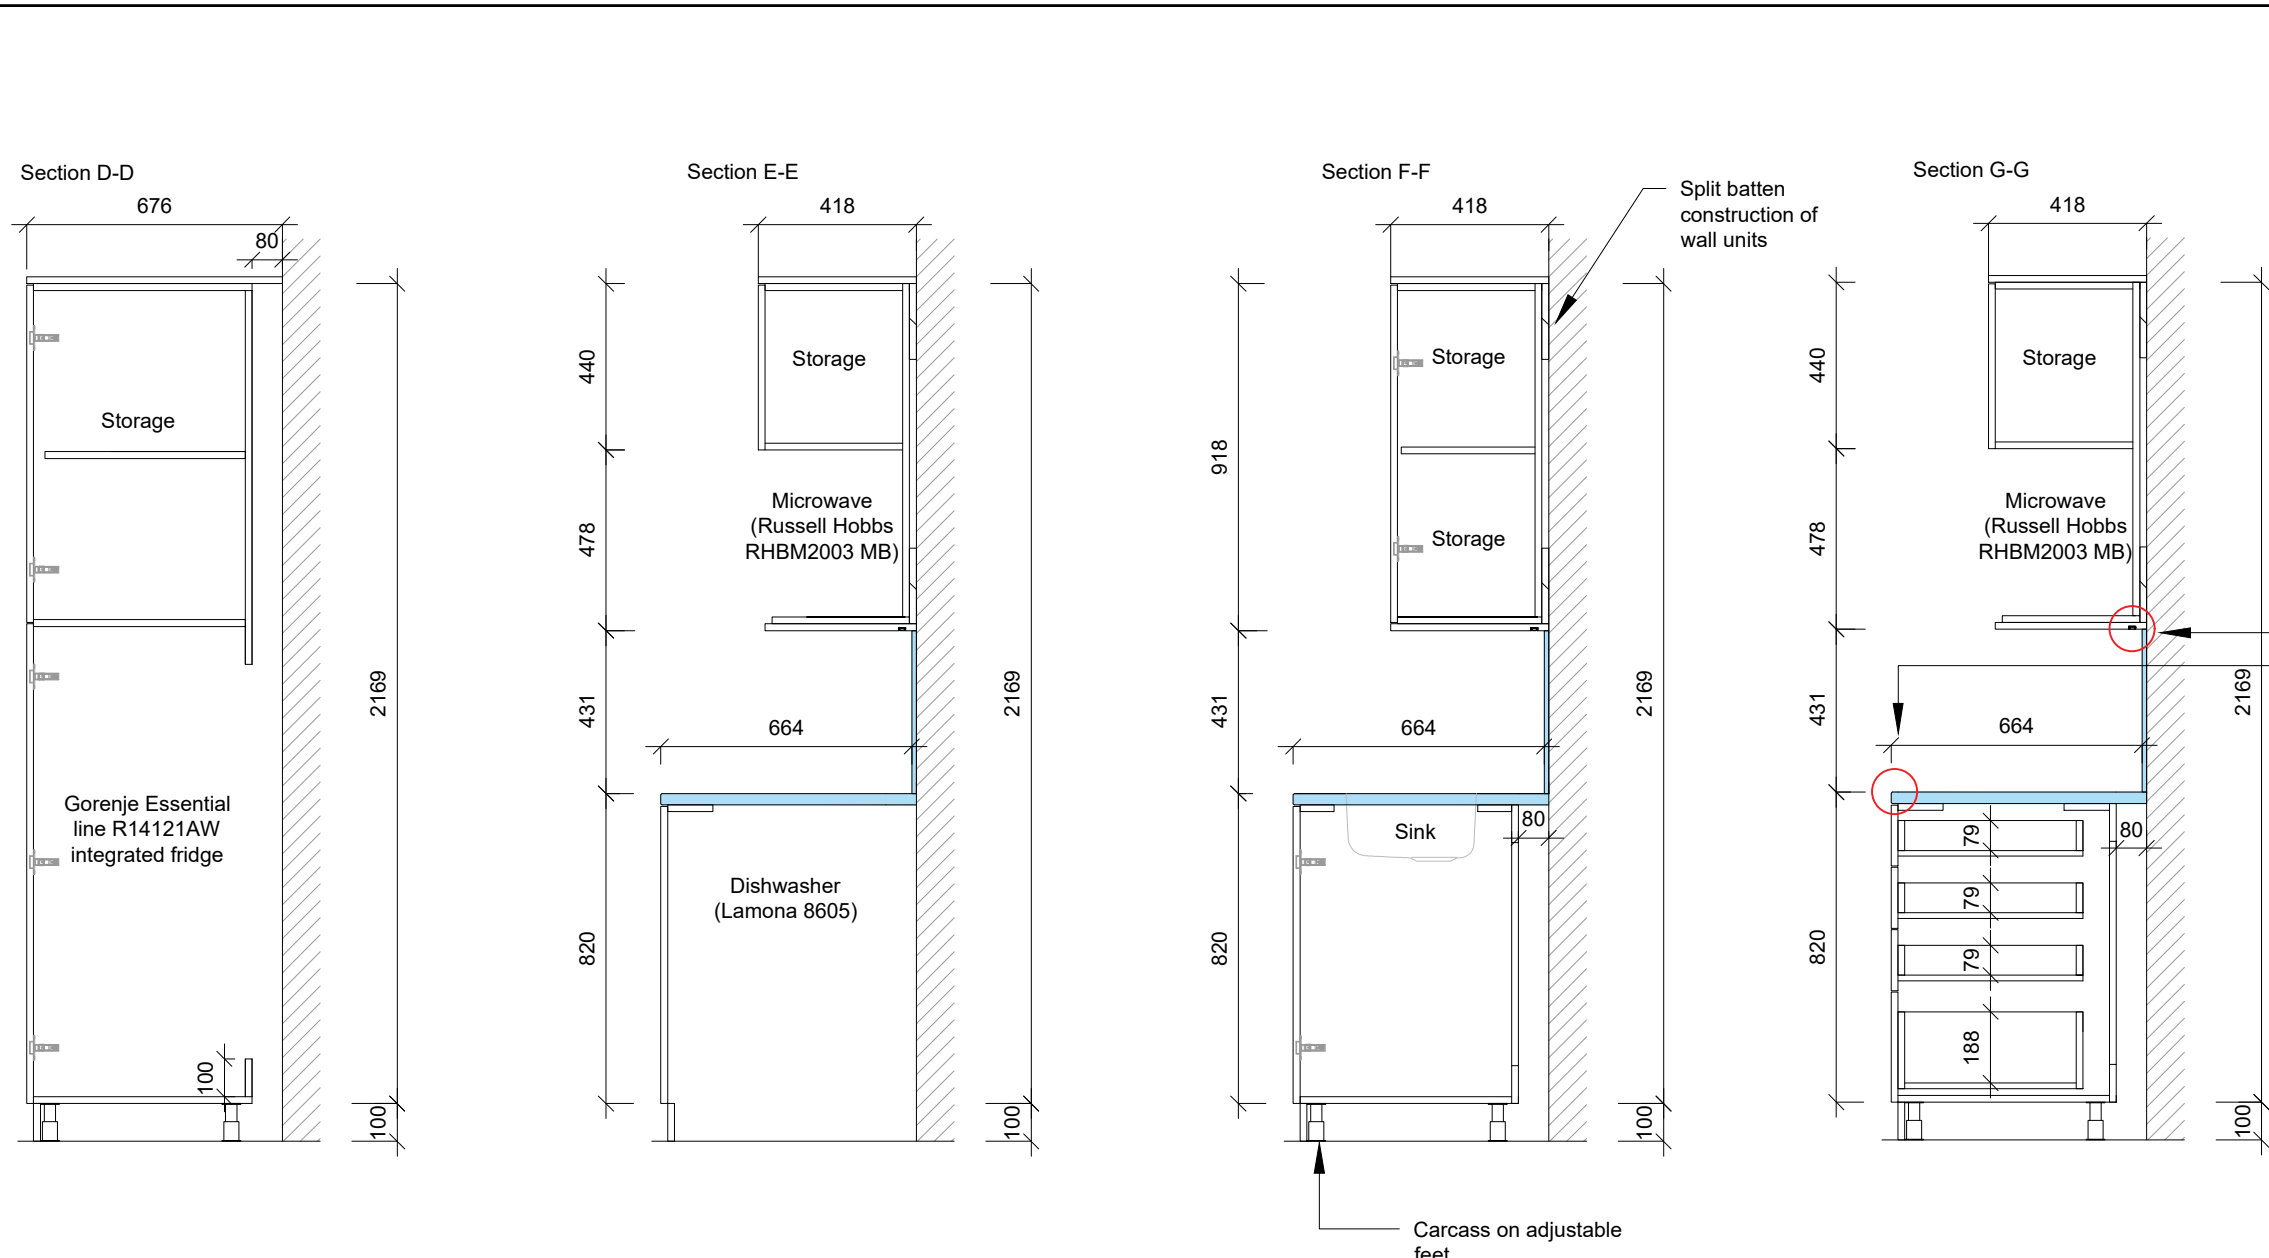

Notes:

Do not scale from this drawing. All dimensions to be checked on-site by contractor to ensure accuracy prior to any installation. All design work produced by Amspec Ltd is for indicative purposes only. It is the client and contractors responsibility to ensure that building control and fire officer approval have been met prior to commencement of site work

Materials	Description
Worktop:	30mm Stone Taurus black polished with small chamfer to front edge and corners
Doors & panels:	18mm plywood stained black with clear 5% lacquer (edges not to be stained) TBC
Internal carcass:	18mm MFMFD in Kronospan Black 0190 with 2mm matching ABS edging
Plinth:	18mm MDF sprayed to RAL 9011 graphite black with clear 5% lacquer
Grille:	500x100mm black plinth grille aluminum finished to RAL 9011 matt finish
Split battens:	18mm plain MDF
Drawers:	15mm MFMFD in Kronospan Black 0190 with 2mm matching ABS edging
Splashback:	20mm Stone Taurus black polished
Door pull:	A&H brass Scope cupboard knob 18mm matt black
Door handle:	A&H brass kuller cabinet handle 12x288mm matt black
Sink tap:	Kohler purist monobloc tap matt black
Sink:	Kubus KBX 110-45 480x430x180mm stainless steel
Zip tap:	Zip hydro tap classic matt black
Integrated bins:	Pull out waste bin Vauth-Sagel VS Envi Space 515mm ref: 503.17.304 (2 x 35ltr, 1 x 21ltr)

Power locations shown as indicative. Refer to appliance data sheets for further information.

Dimensions as confirmed with clients DWG. Dimensions to be confirmed on-site

Contracts manager to check and confirm all measures on-site. Any discrepancies to be reported to the designer

Panel finishes (doors & plywood) to be provided for client approval

Kitchenette 02 Location Plan

Scale @ 1:100

Represents stone locations

REV:	DESCRIPTION:	BY:	DATE:
STATUS: AS BUILT			

amspec

DESIGN & BUILD SOLUTIONS

t : 01942 621342 f : 01942 226552
www.amspec.co.uk

CLIENT:

OBI
 80 MOSLEY STREET
 MANCHESTER
 M2 3FX

ARCHITECT:

N/A

SITE:

18 LOWER BYROM STREET
MANCHESTER

TITLE:

KITCHENETTE 02
PLAN, ELEVATIONS & DETAILS

SCALE AT A1:	DATE:	DRAWN:	CHECKED:
1:20	17.06.79	CR	IC
PROJECT NO:	DRAWING NO:	REVISION:	
1683	DP_KI-02		