


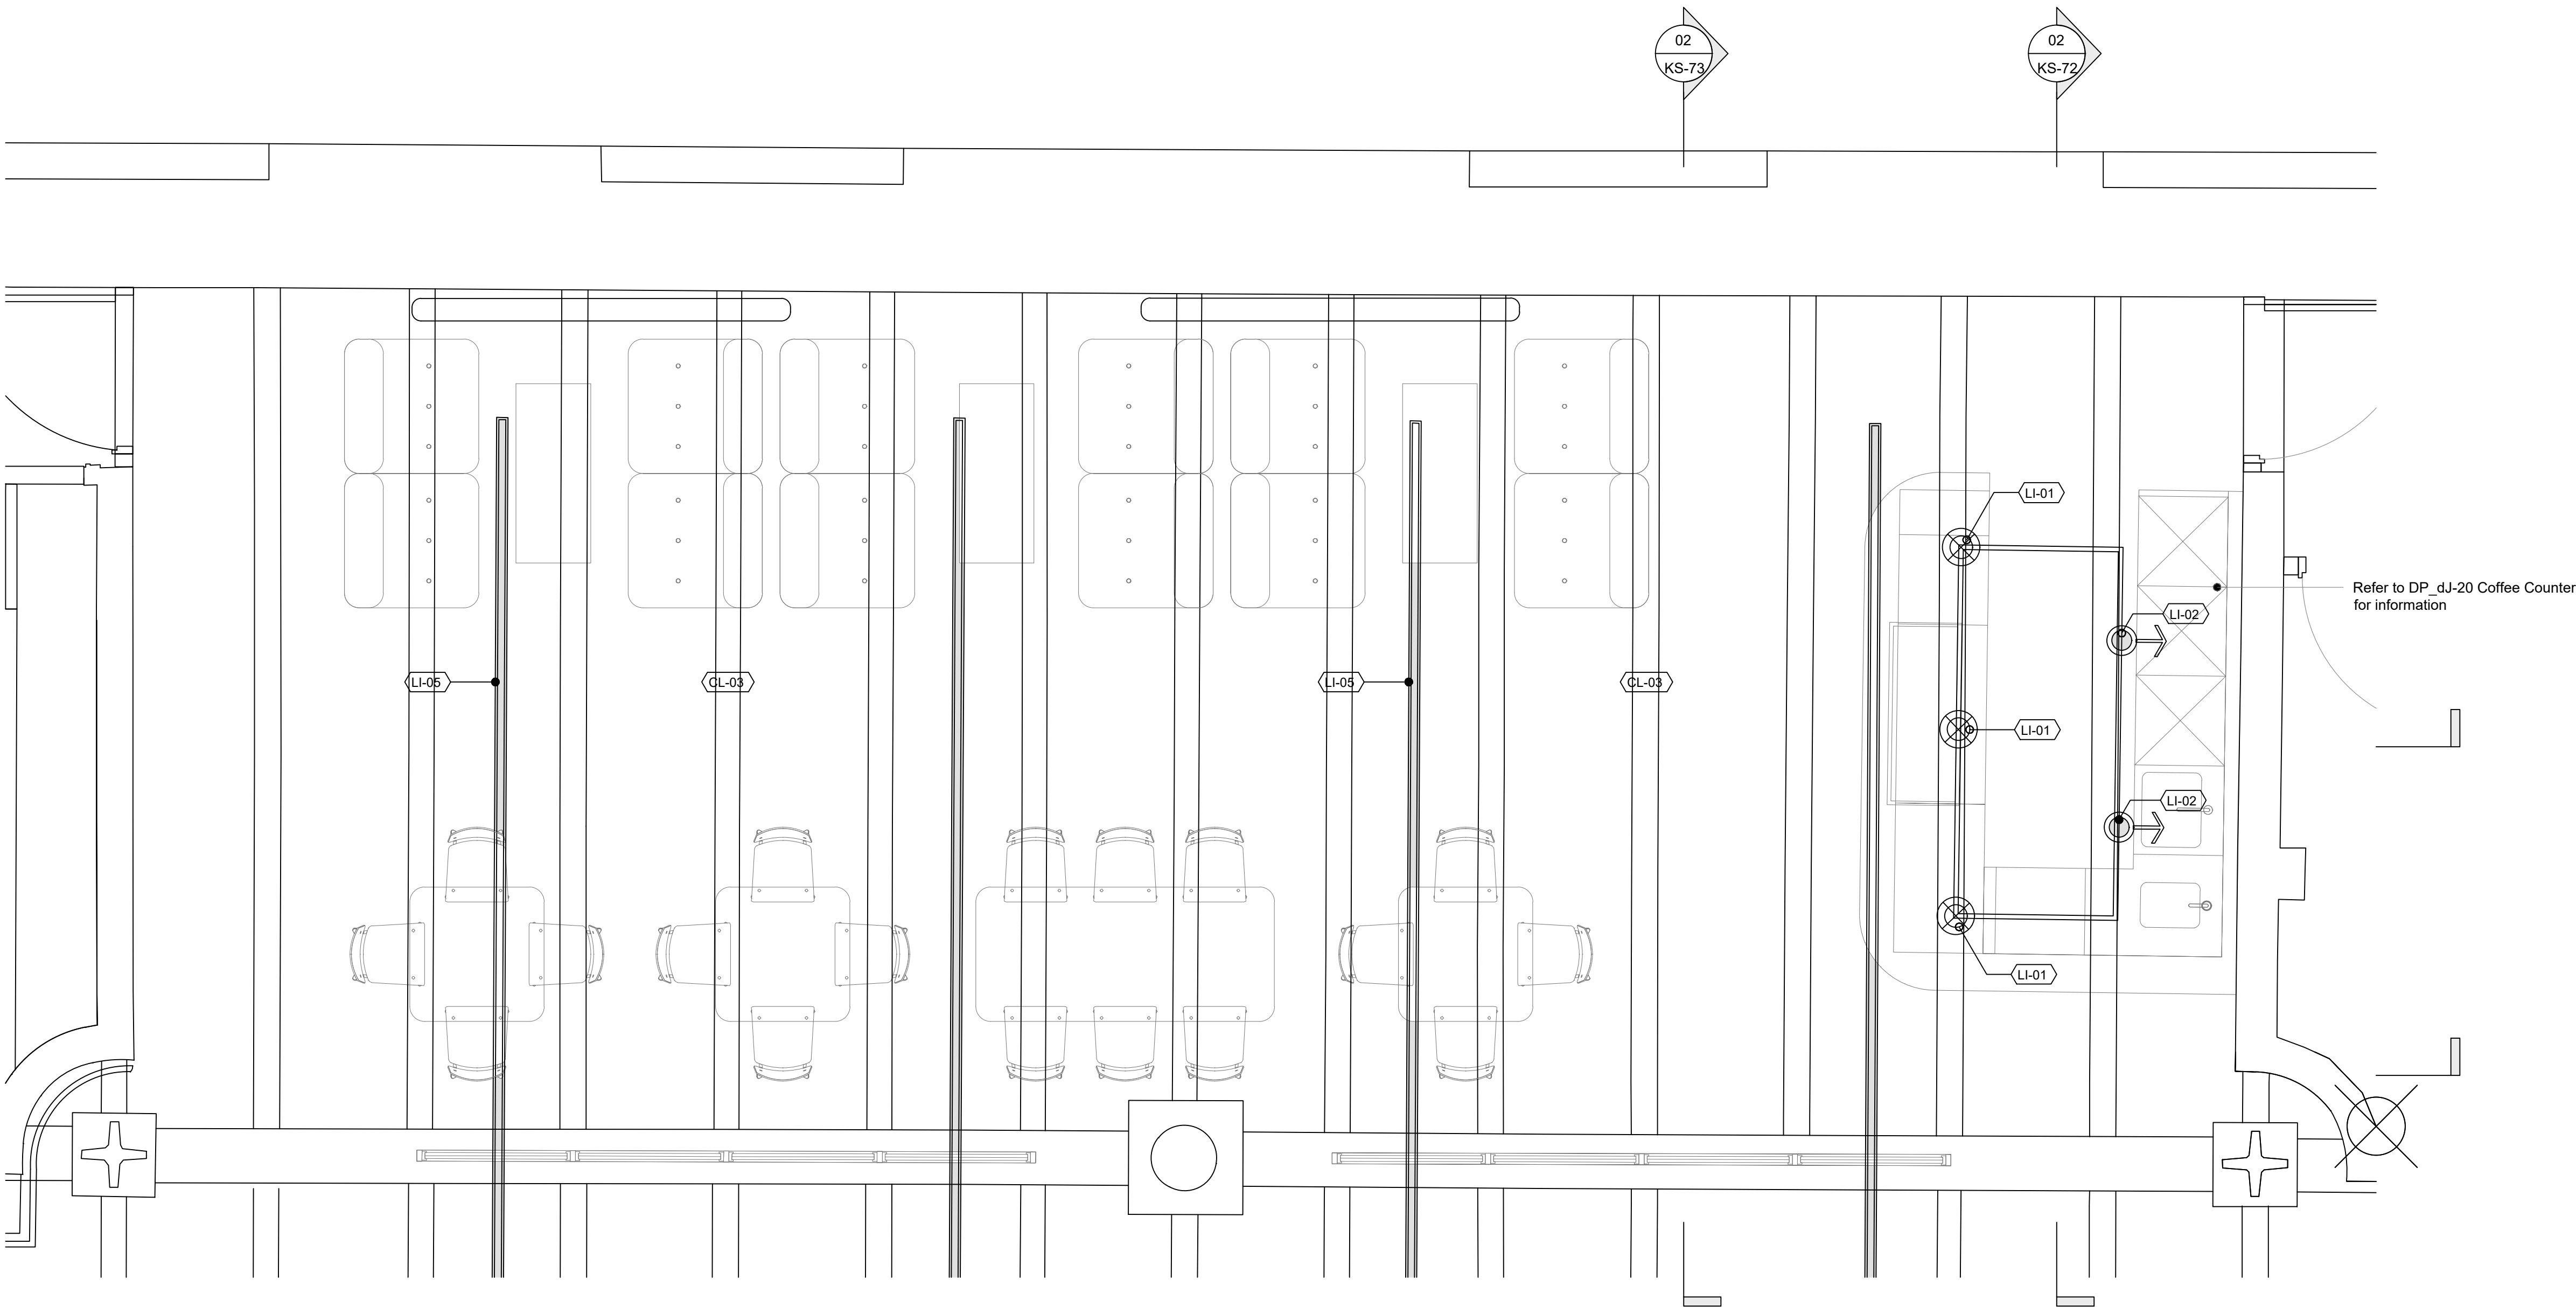

Notes:

Do not scale from this drawing. All dimensions to be checked on-site by contractor to ensure accuracy prior to any installation. All design work produced by Amspec Ltd is for indicative purposes only. It is the client and contractors responsibility to ensure that building control and fire officer approval have been met prior to commencement of site work

Drawing Key

Refer to Lighting Schedule DP_xL

LIGHT FITTINGS

- LI-01 Mini Peretto Black Pendant
- LI-02 GU11 Tube spot Black Directional Spotlight
- LI-05 Existing linear lights

FIXTURES / FITTINGS

- FL-01 Free standing bespoke counter
- FL-02 Menu signage

CEILING TYPES

- CL-03 Existing exposed brick soffit and steel beams

FLOOR FINISHES

- FF-08 Existing timber floor

REV:	DESCRIPTION:	BY:	DATE:
STATUS: AS BUILT			



CLIENT:	OBI 80 MOSELY STREET MANCHESTER M2 3FX
ARCHITECT:	

SITE:	18 LOWER BYROM STREET MANCHESTER
-------	-------------------------------------

TITLE:	RECEPTION COFFEE RCP
--------	----------------------

SCALE: AT A1:	DATE:	DRAWN:	CHECKED:
1:25	27.06.19	CR	IC
PROJECT NO:	DRAWING NO:	REVISION:	
1683	DP_KS-71		