


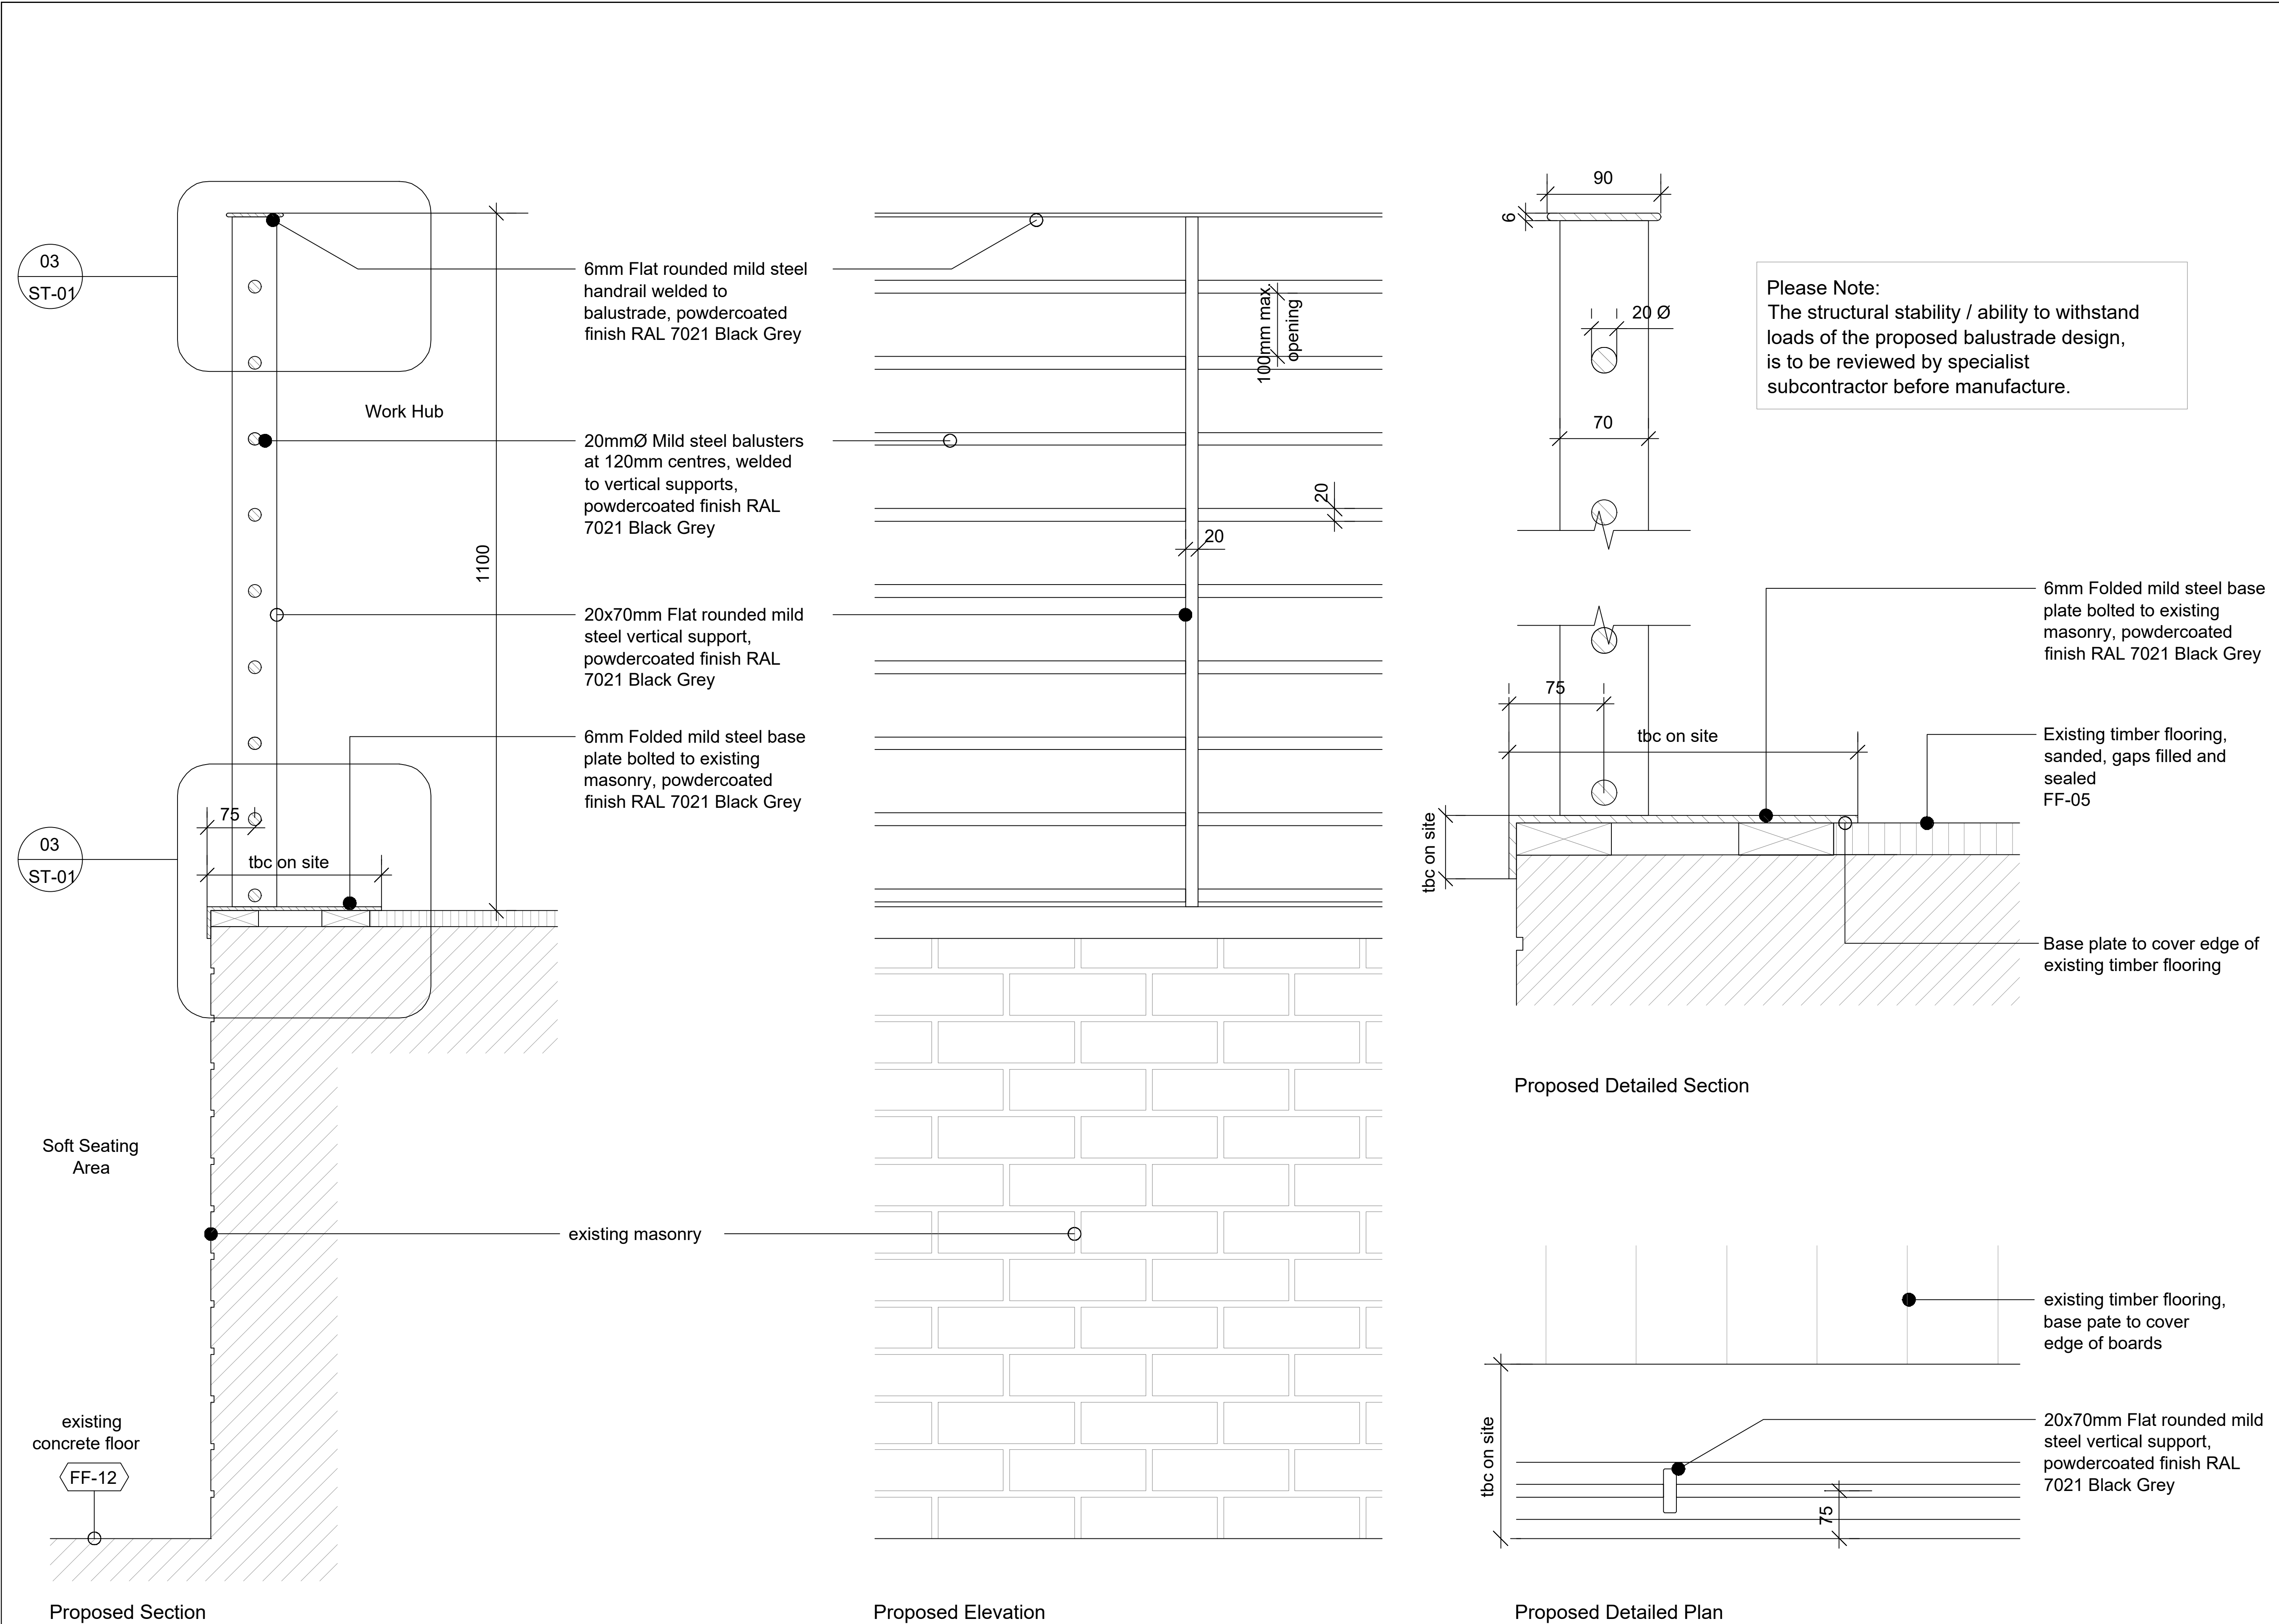

Notes:				
Do not scale from this drawing. All dimensions to be checked on-site by contractor to ensure accuracy prior to any installation. All design work produced by Amspec Ltd is for indicative purposes only. It is the client and contractors responsibility to ensure that building control and fire officer approval have been met prior to commencement of site work.				
REV:	DESCRIPTION:	BY:	DATE:	
STATUS: AS BUILT				
 DESIGN & BUILD SOLUTIONS t : 01942 621342 f : 01942 226552 www.amspec.co.uk				
CLIENT:	OBI 80 MOSELY STREET MANCHESTER M2 3FX			
ARCHITECT:				
SITE:	18 LOWER BYROM STREET MANCHESTER			
TITLE:	LEVEL 3 WORK HUB SOFT SEATING BALUSTRADE			
SCALE: AT: A1:	DATE: 28.06.19	DRAWN: CR	CHECKED: IC	
PROJECT NO: 1683	DRAWING NO: DP_ST-01	REVISION:		