

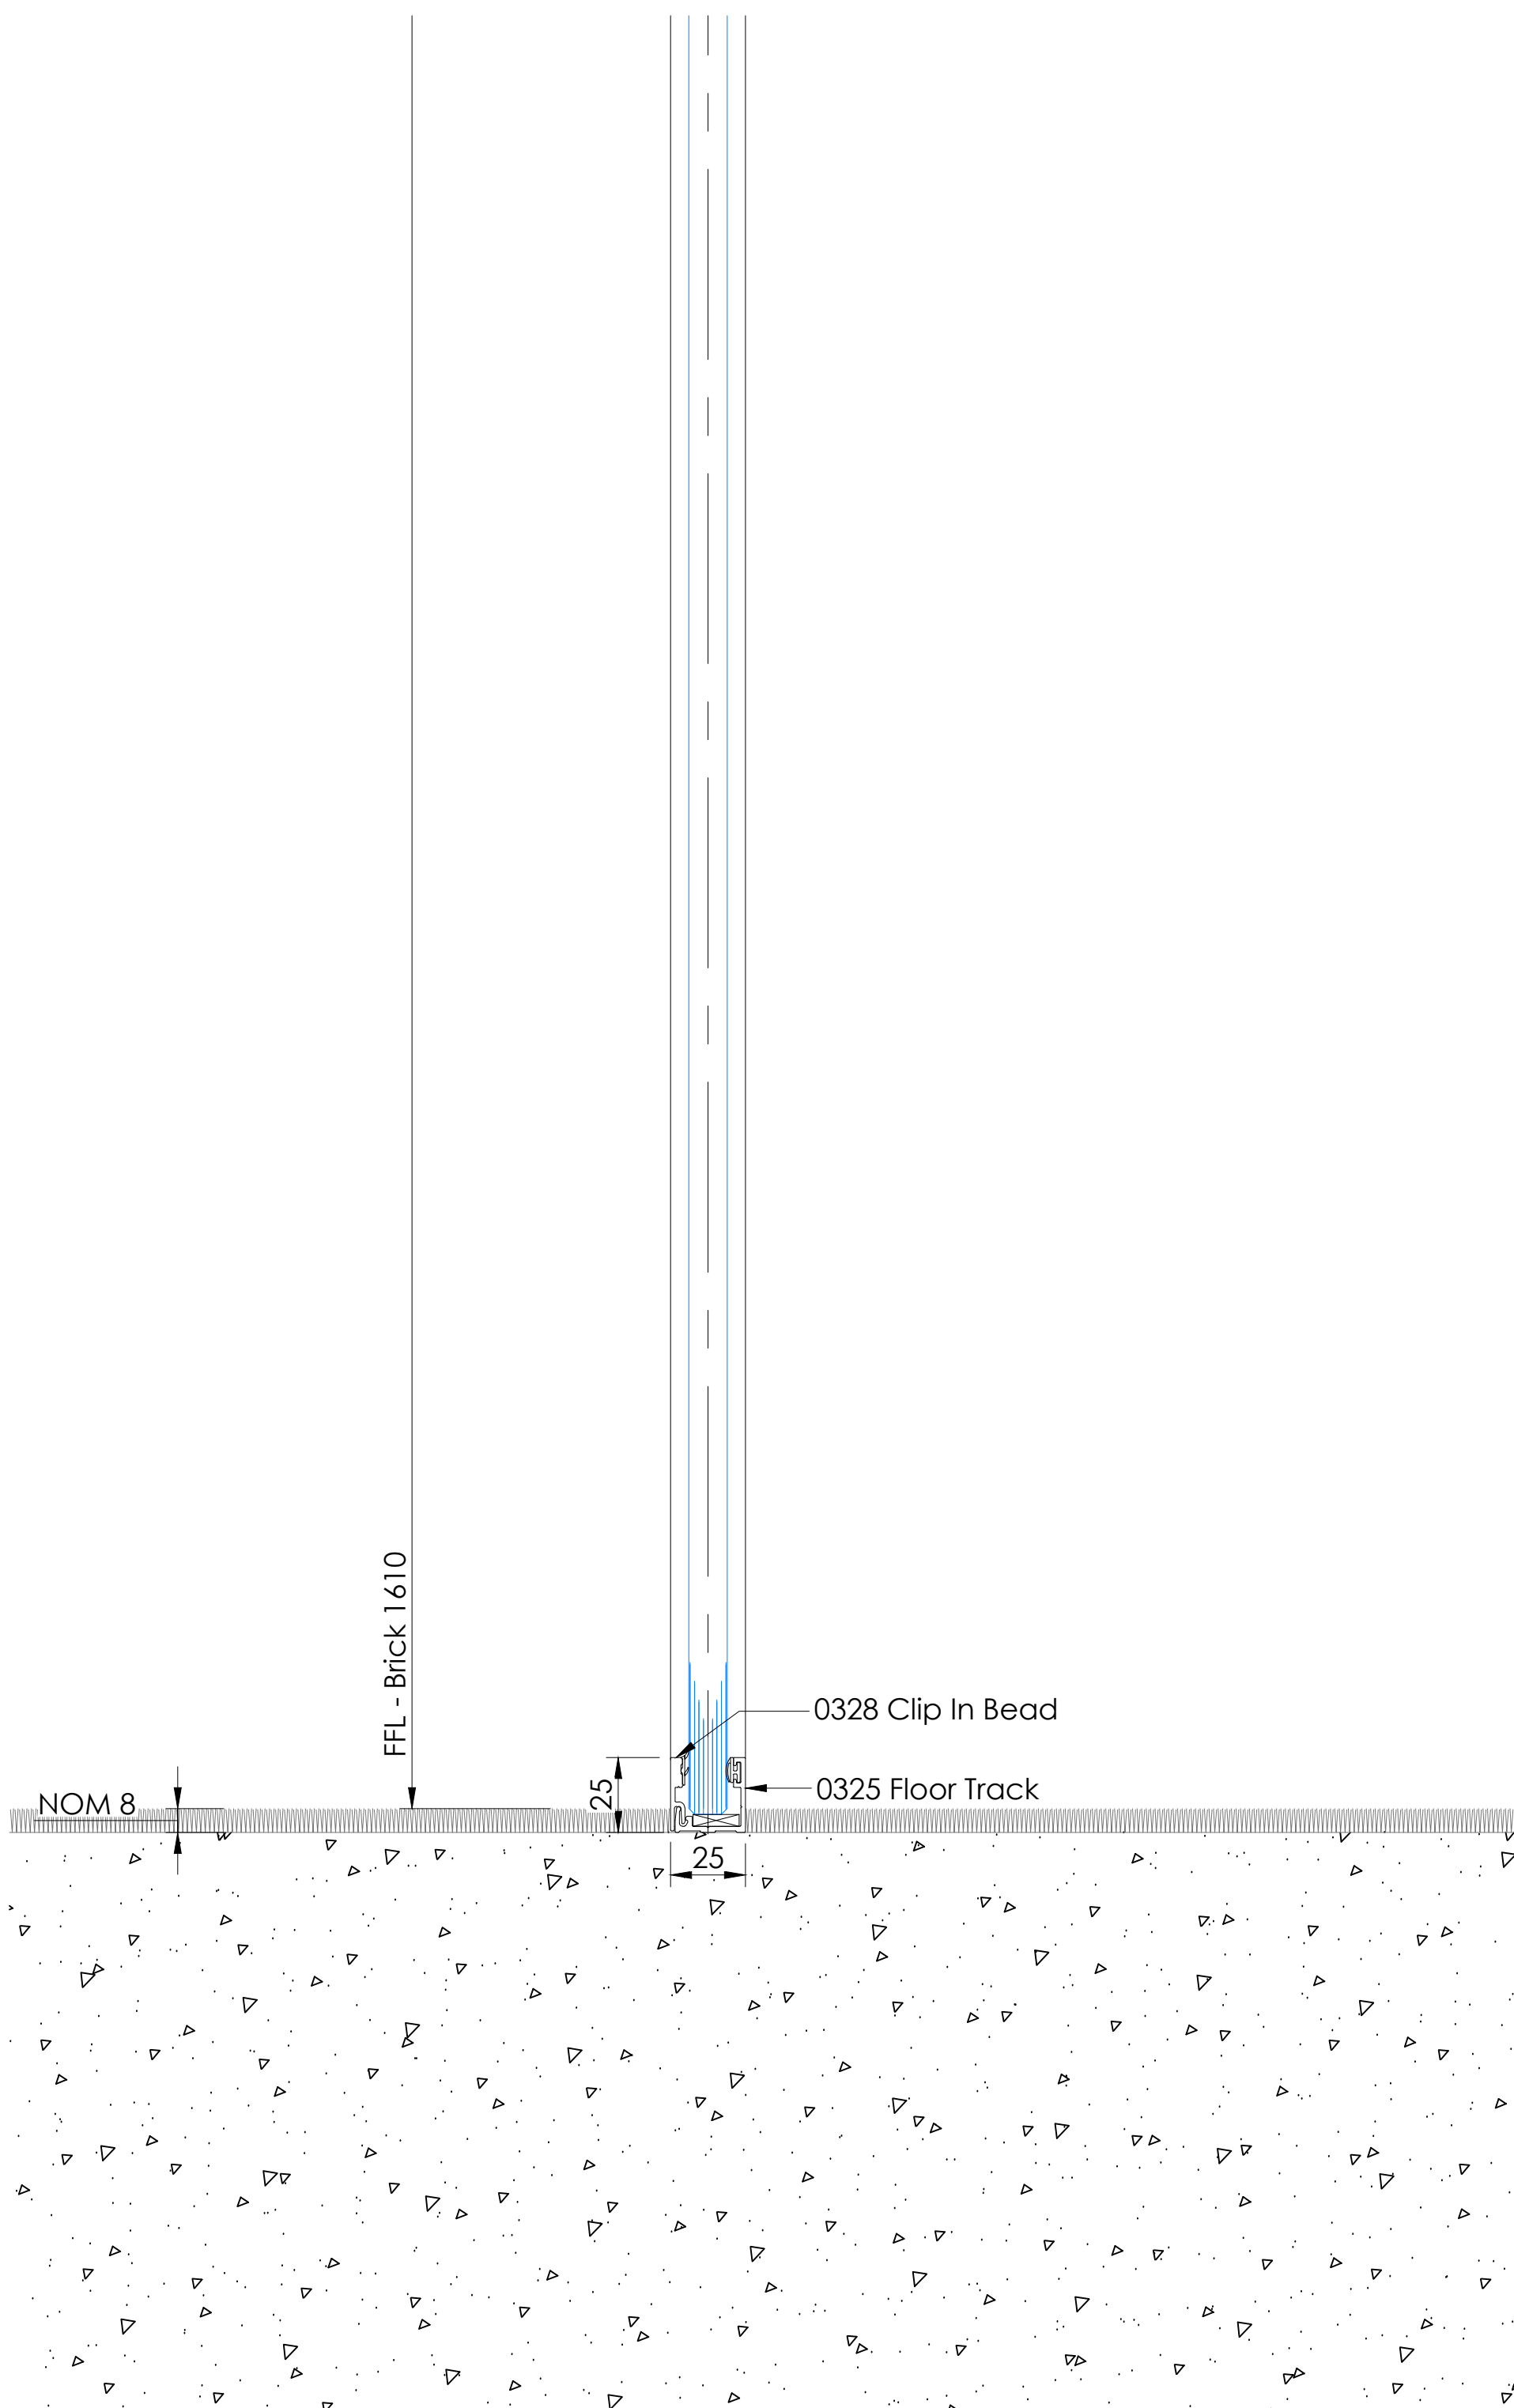


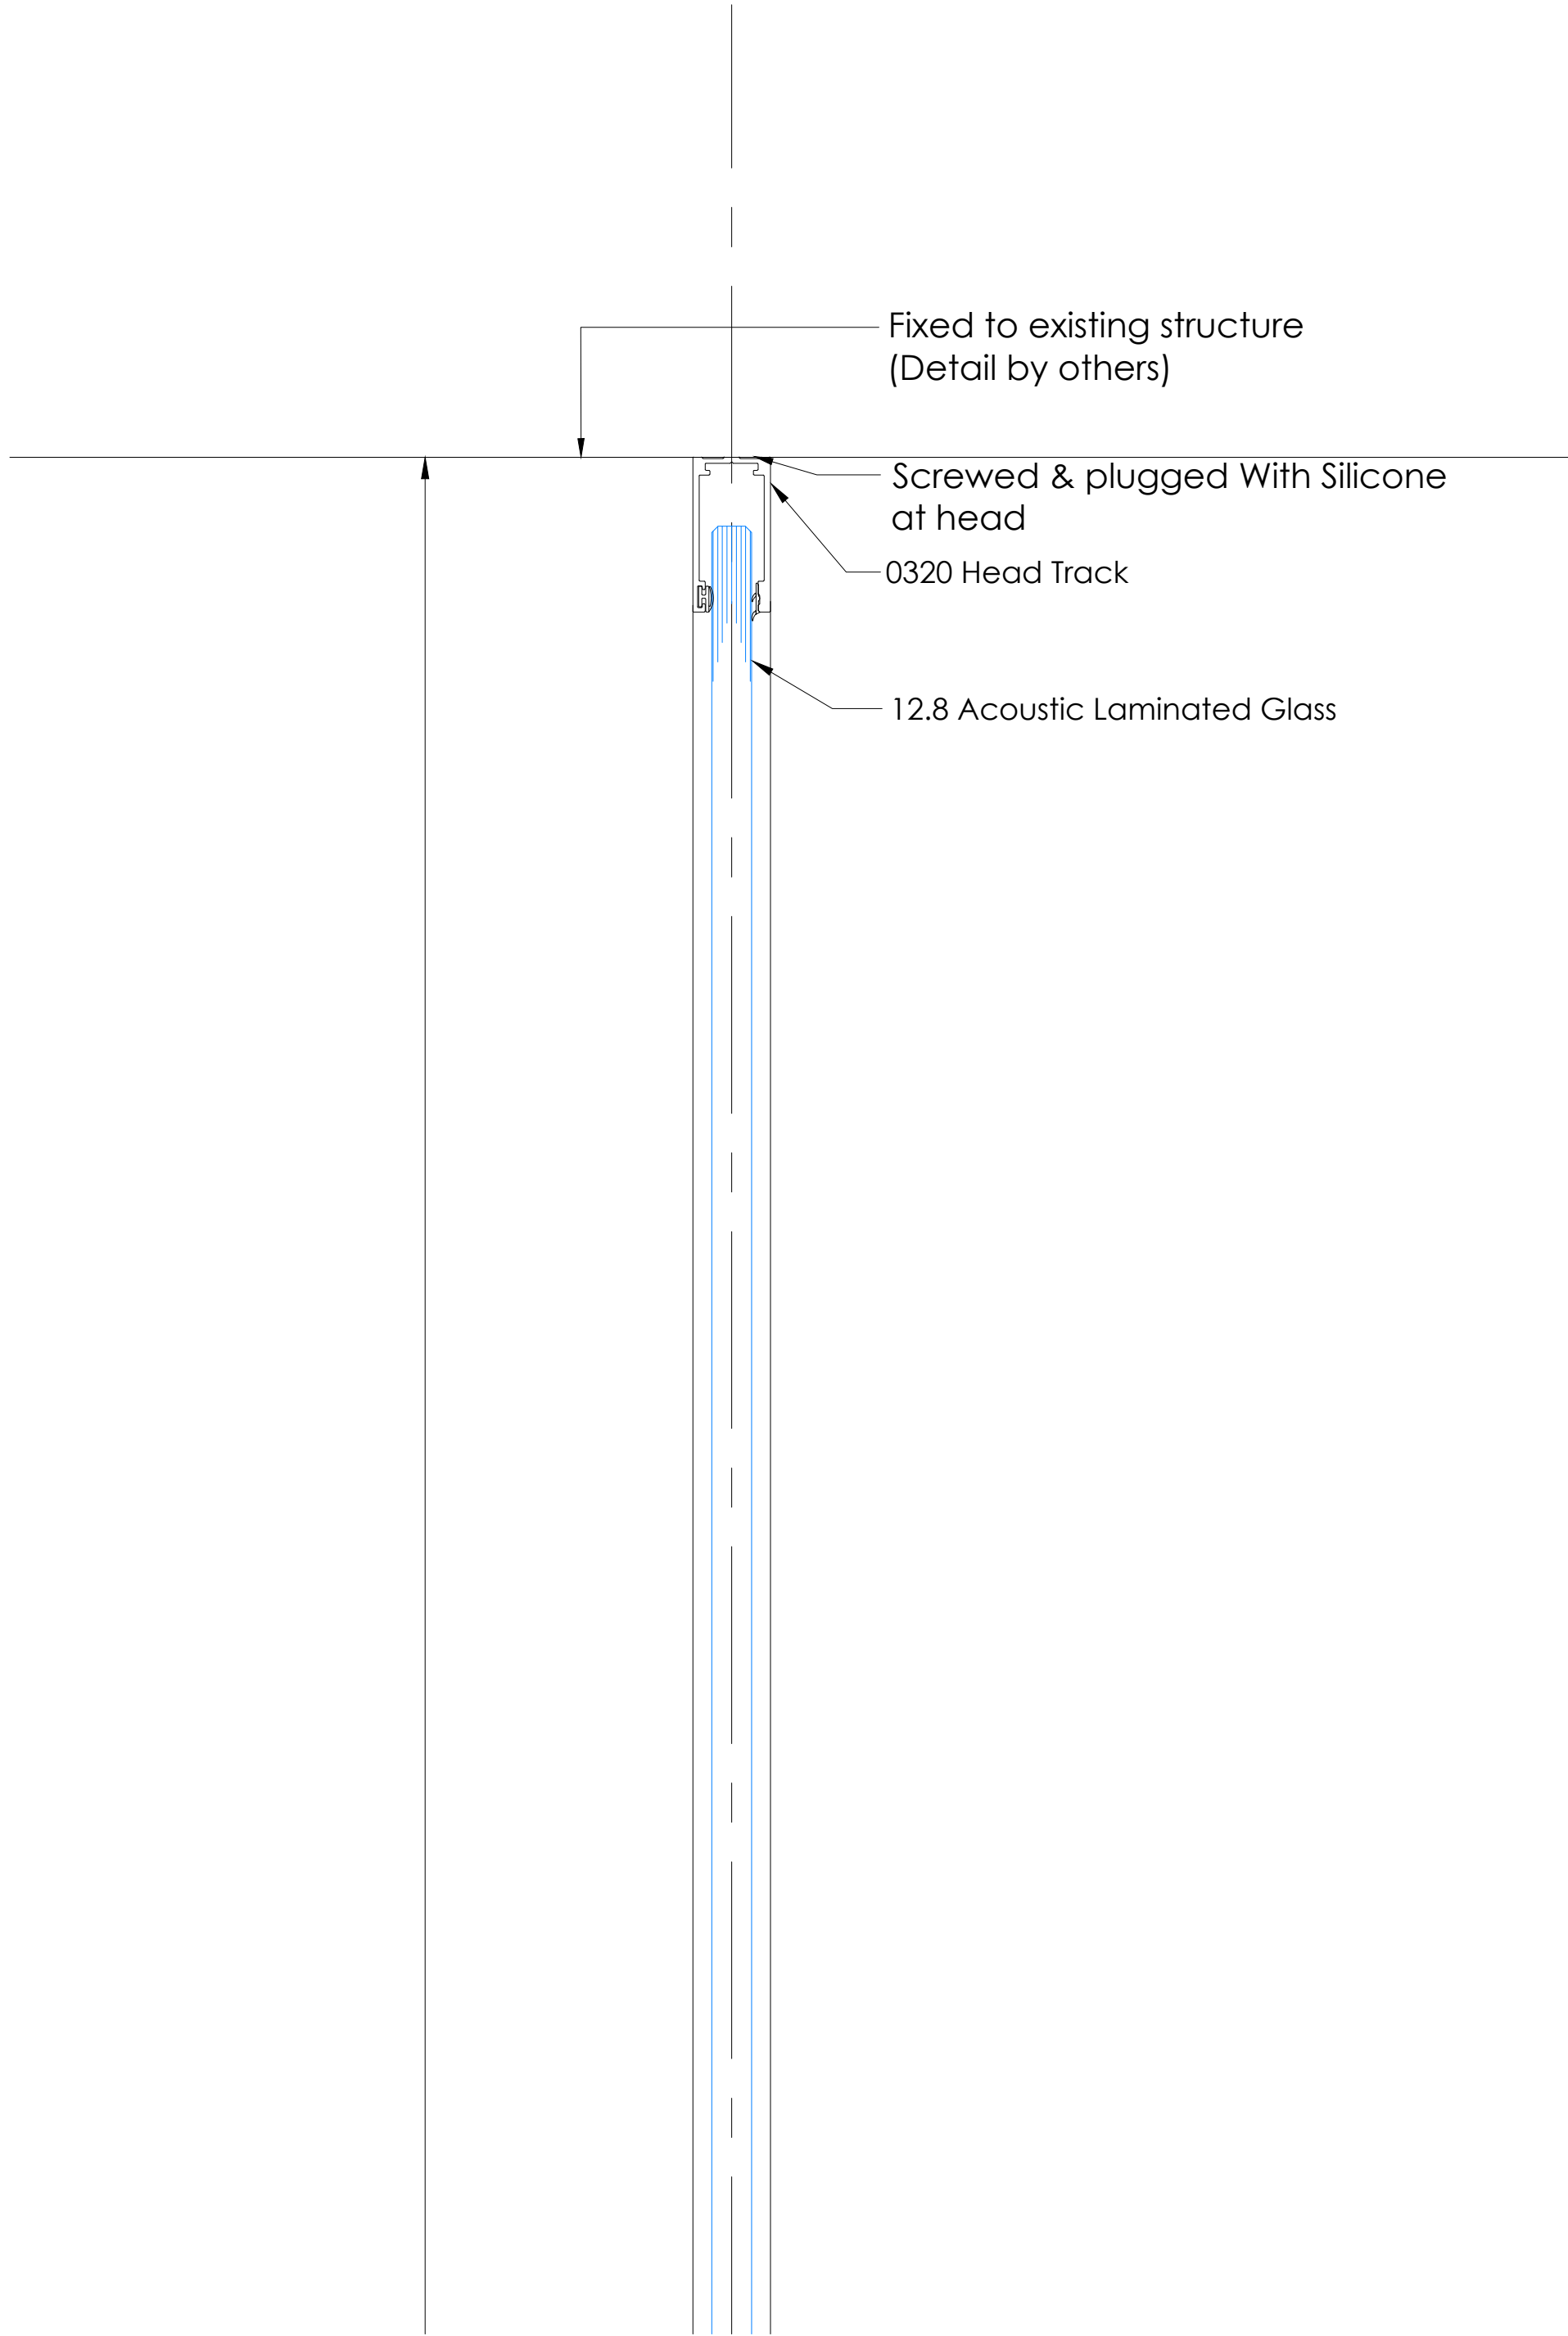


1 SECTION: Door
Axile Clarity

Scale 1:2

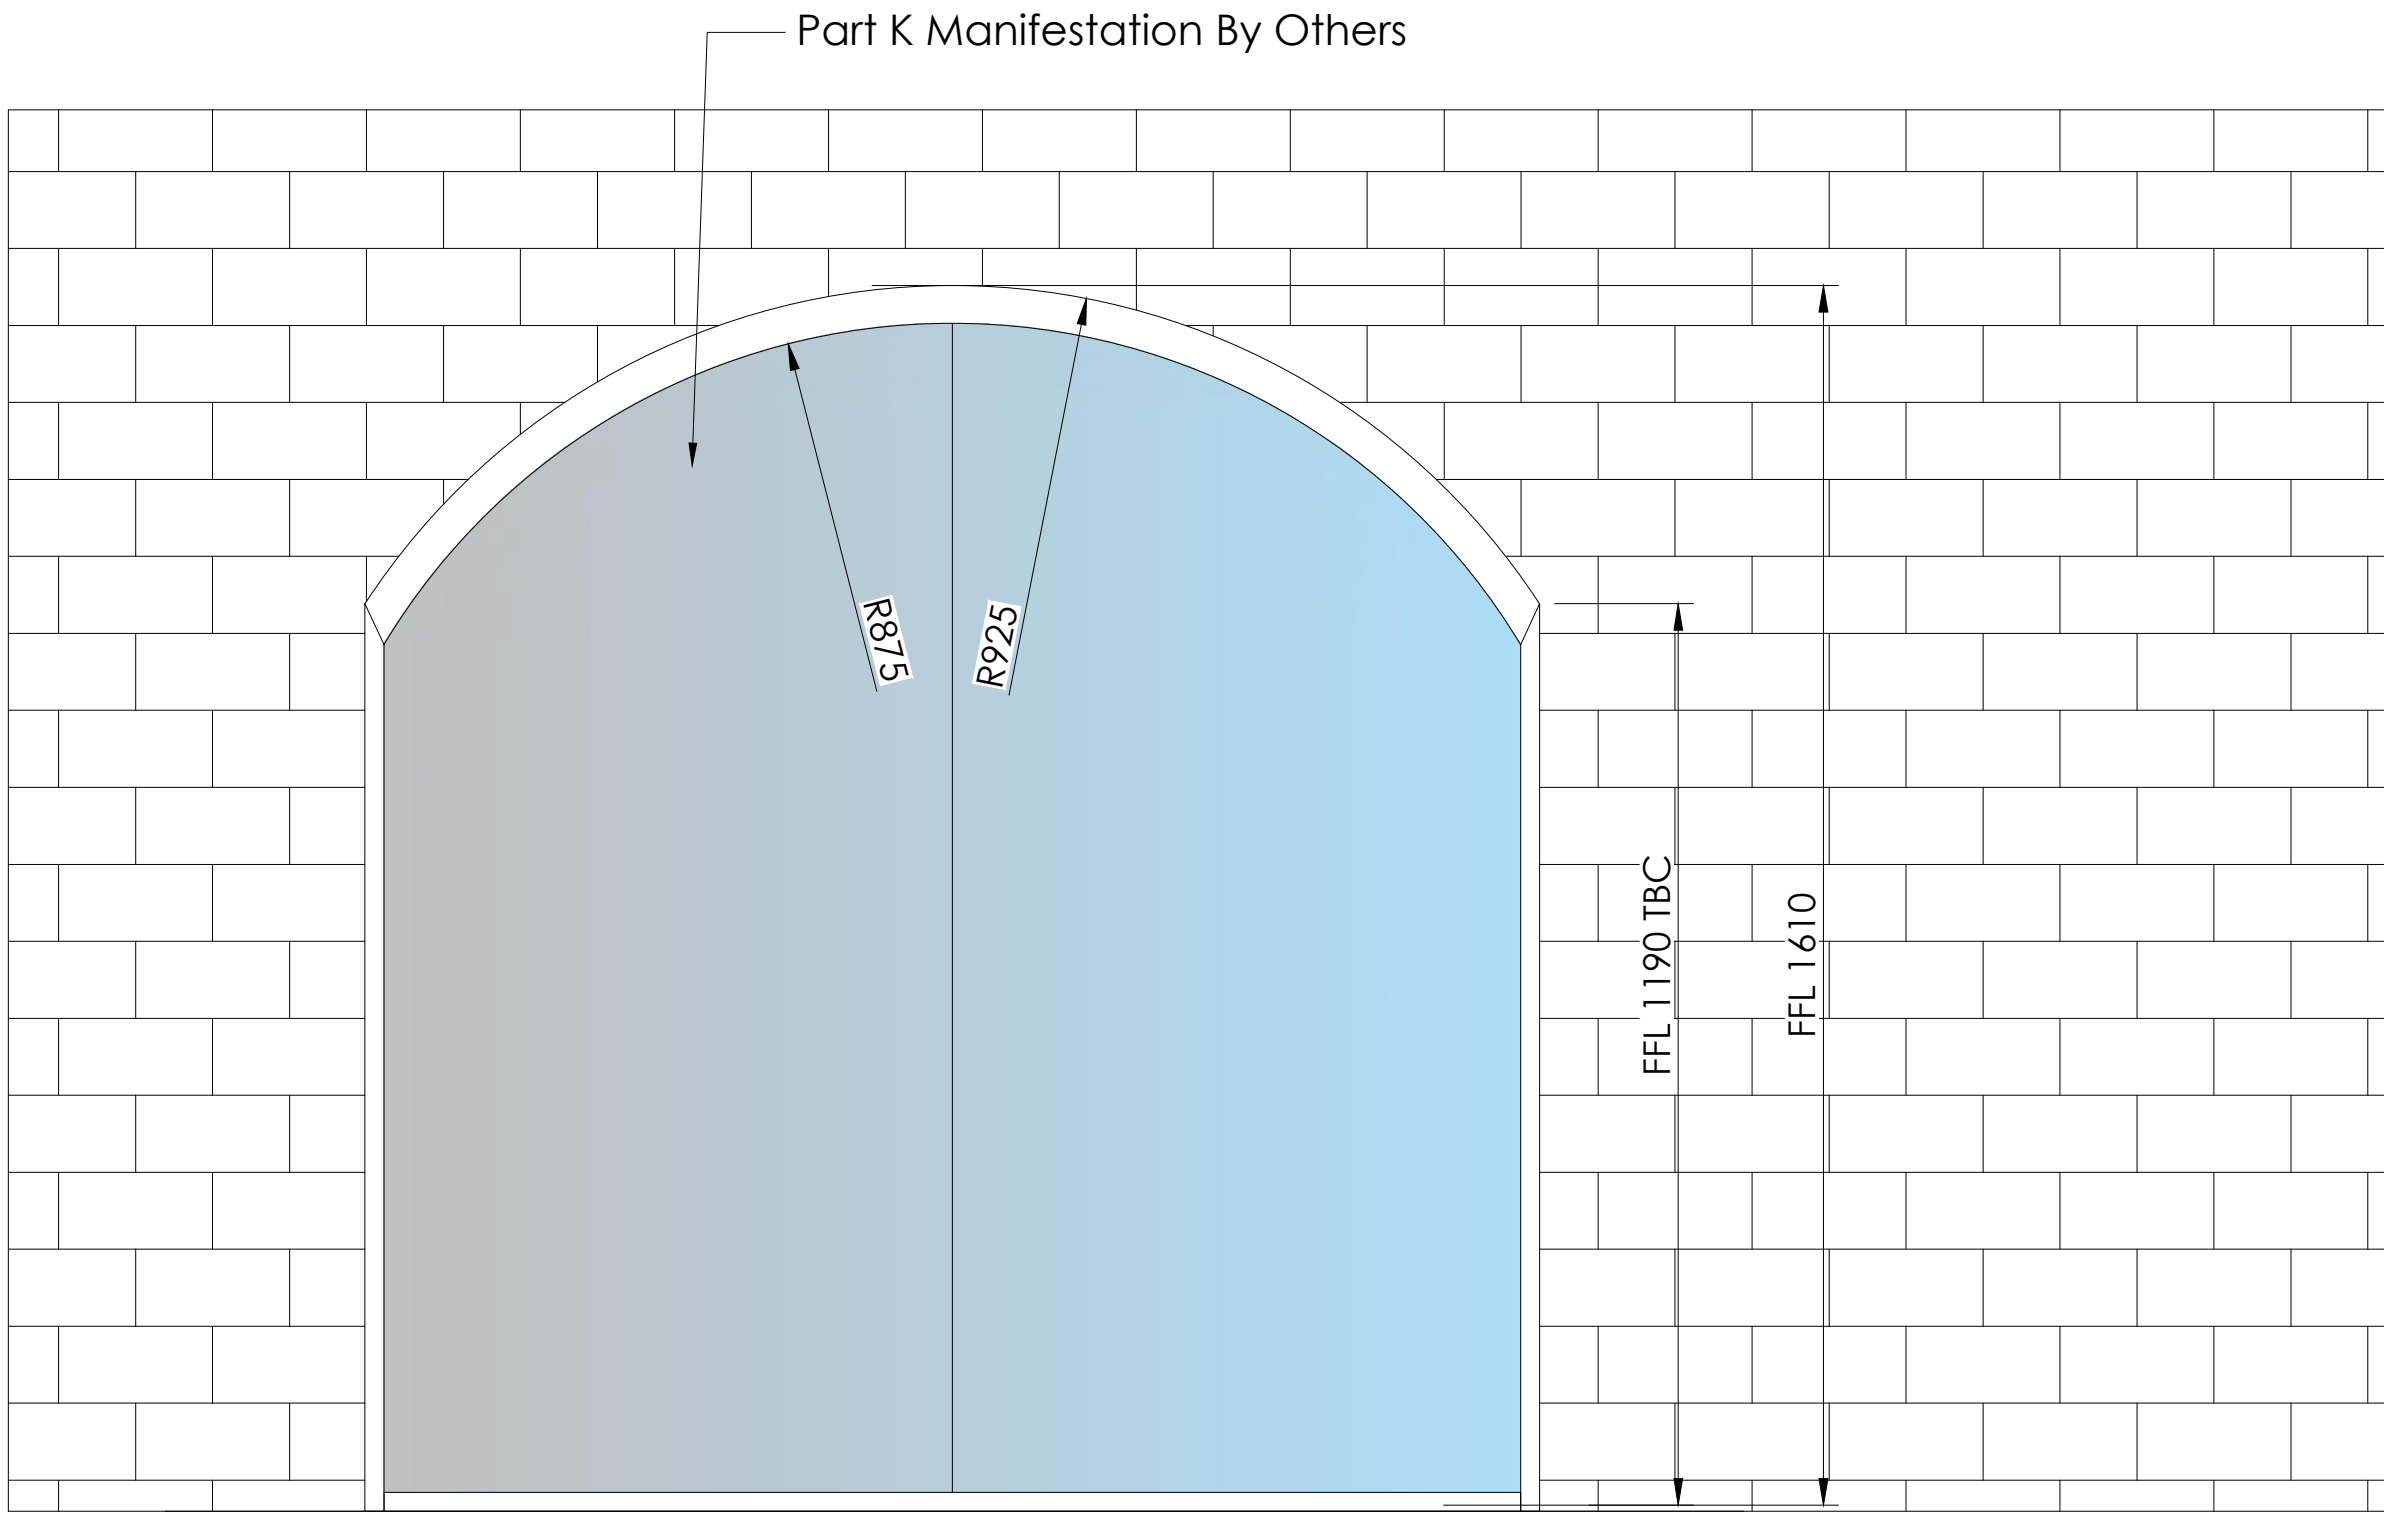


2 Elevation: Screen 7
117+

Scale 1:10

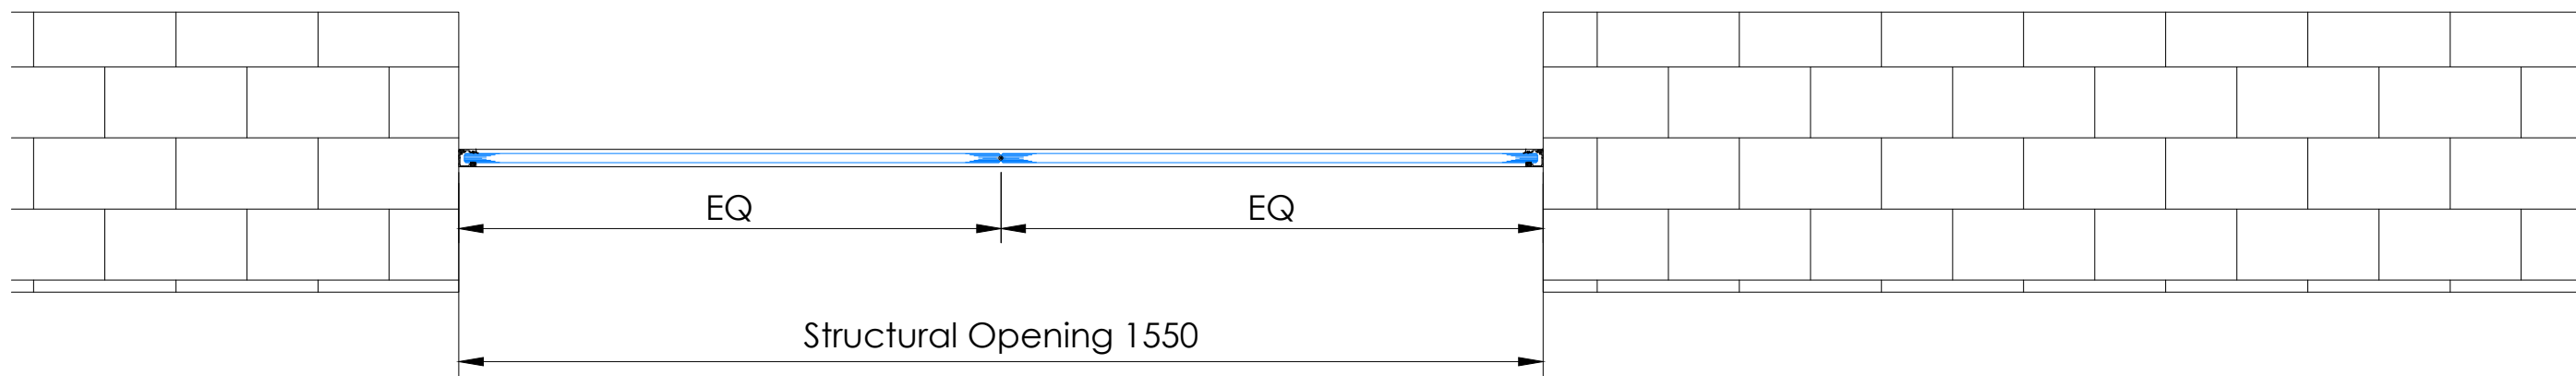

3 PLAN: Screen 7
117+

Scale 1:10

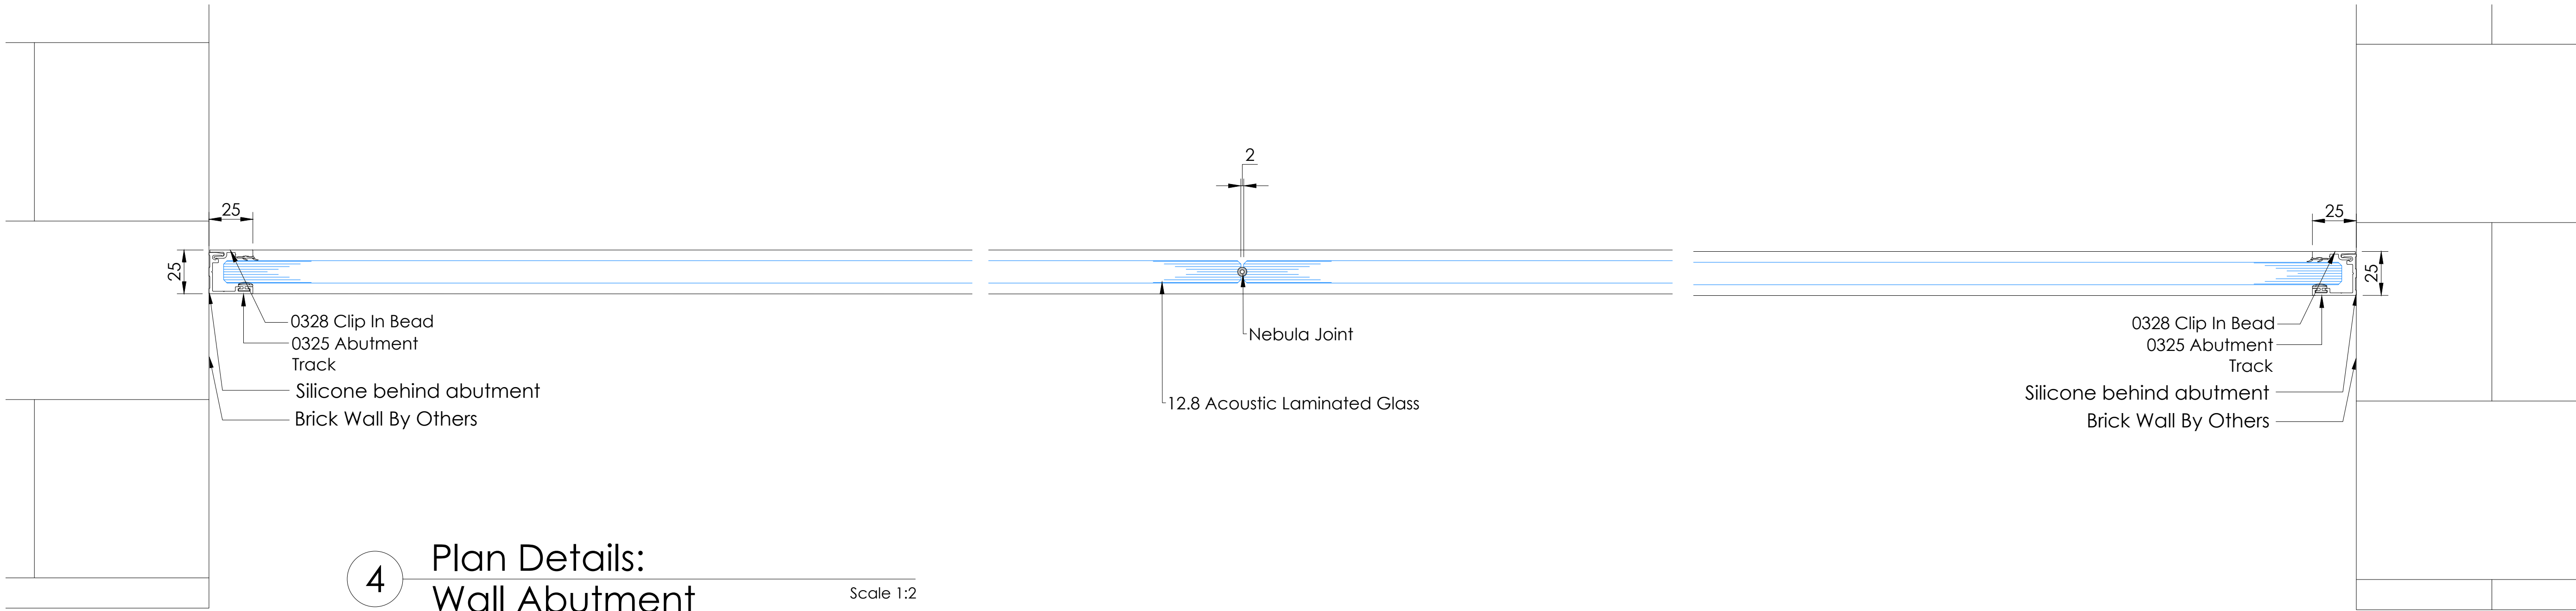

4 Plan Details:
Wall Abutment

Scale 1:2

Safety Health & Environmental Information Box
Construction Risks This project uses only materials that have been used in the region before. From a Designer viewpoint, Optima do not envisage any specific Construction Issues to communicate.
Maintenance / Cleaning Risks Optima, in the main, provide office partitioning, the components (specifically the glass) are tested to the relevant national or international standards of the day. As such CLEANING and MAINTENANCE of this project should be no specific risk. However, Optima would point out that all persons involved with maintenance and cleaning should themselves be subject to their own employer's specific risk assessment practices. Special care should be taken if working at height. In such cases the regulations of the day apply. Optima do not recommend any loadings against its products.
Demolition / Adaptation Risks From the viewpoint of a Designer, Optima have identified no significant risks for demolition and adaptation. However, the usual risk assessments are presumed to be implemented by the company proposing demolition and/or adaptation.
Environmental / Recycling Much of the Optima range of product is recyclable, cable. See original terms and conditions for clarification. Environmental issues are subject to the law of the day.
In addition to the hazards / risks normally associated with the types of work detailed on this drawing take note of the above. It is assumed that all work on this drawing will be carried out by competent contractors meeting where applicable, to an approved method statement.

General Information Table 1015	
Door/Partition	
Door/Partition Type	117+ - Screen 7
Floors	2
Acoustic Rating	Screen: Rw38dB
Ironmongery Set	N/A
Door Finish	N/A
Frame Finish	RAL 9005
Deflection	N/A
Glass	12.8 Acoustic Laminated Glass

Structural Openings To
Be Checked On Site

31/03/20 Rev: Rev00
AS BUILT

AB	31.03.20	As Built	CC	CT	GM
Rev	Date	Description	Dr	App	Ck
Status:					
As Built					
Optima					
© Optima Products Ltd.					
OPTIMA CONTRACTING LIMITED COURTYARD HOUSE WEST END ROAD HIGH WYCOMBE BUCKINGHAMSHIRE HP11 2QB			Tel: +44 (0) 1494 492600 Web: www.optimasystems.com		
PART OF THE OPTIMA GROUP					
Project:					
50195 Bonded Warehouse L2					
Title:					
117+ Screen 7					
Scale @ A0:	Drawing No.:		Revision:		
VARIES	OPT-DRG-1015		AB		