


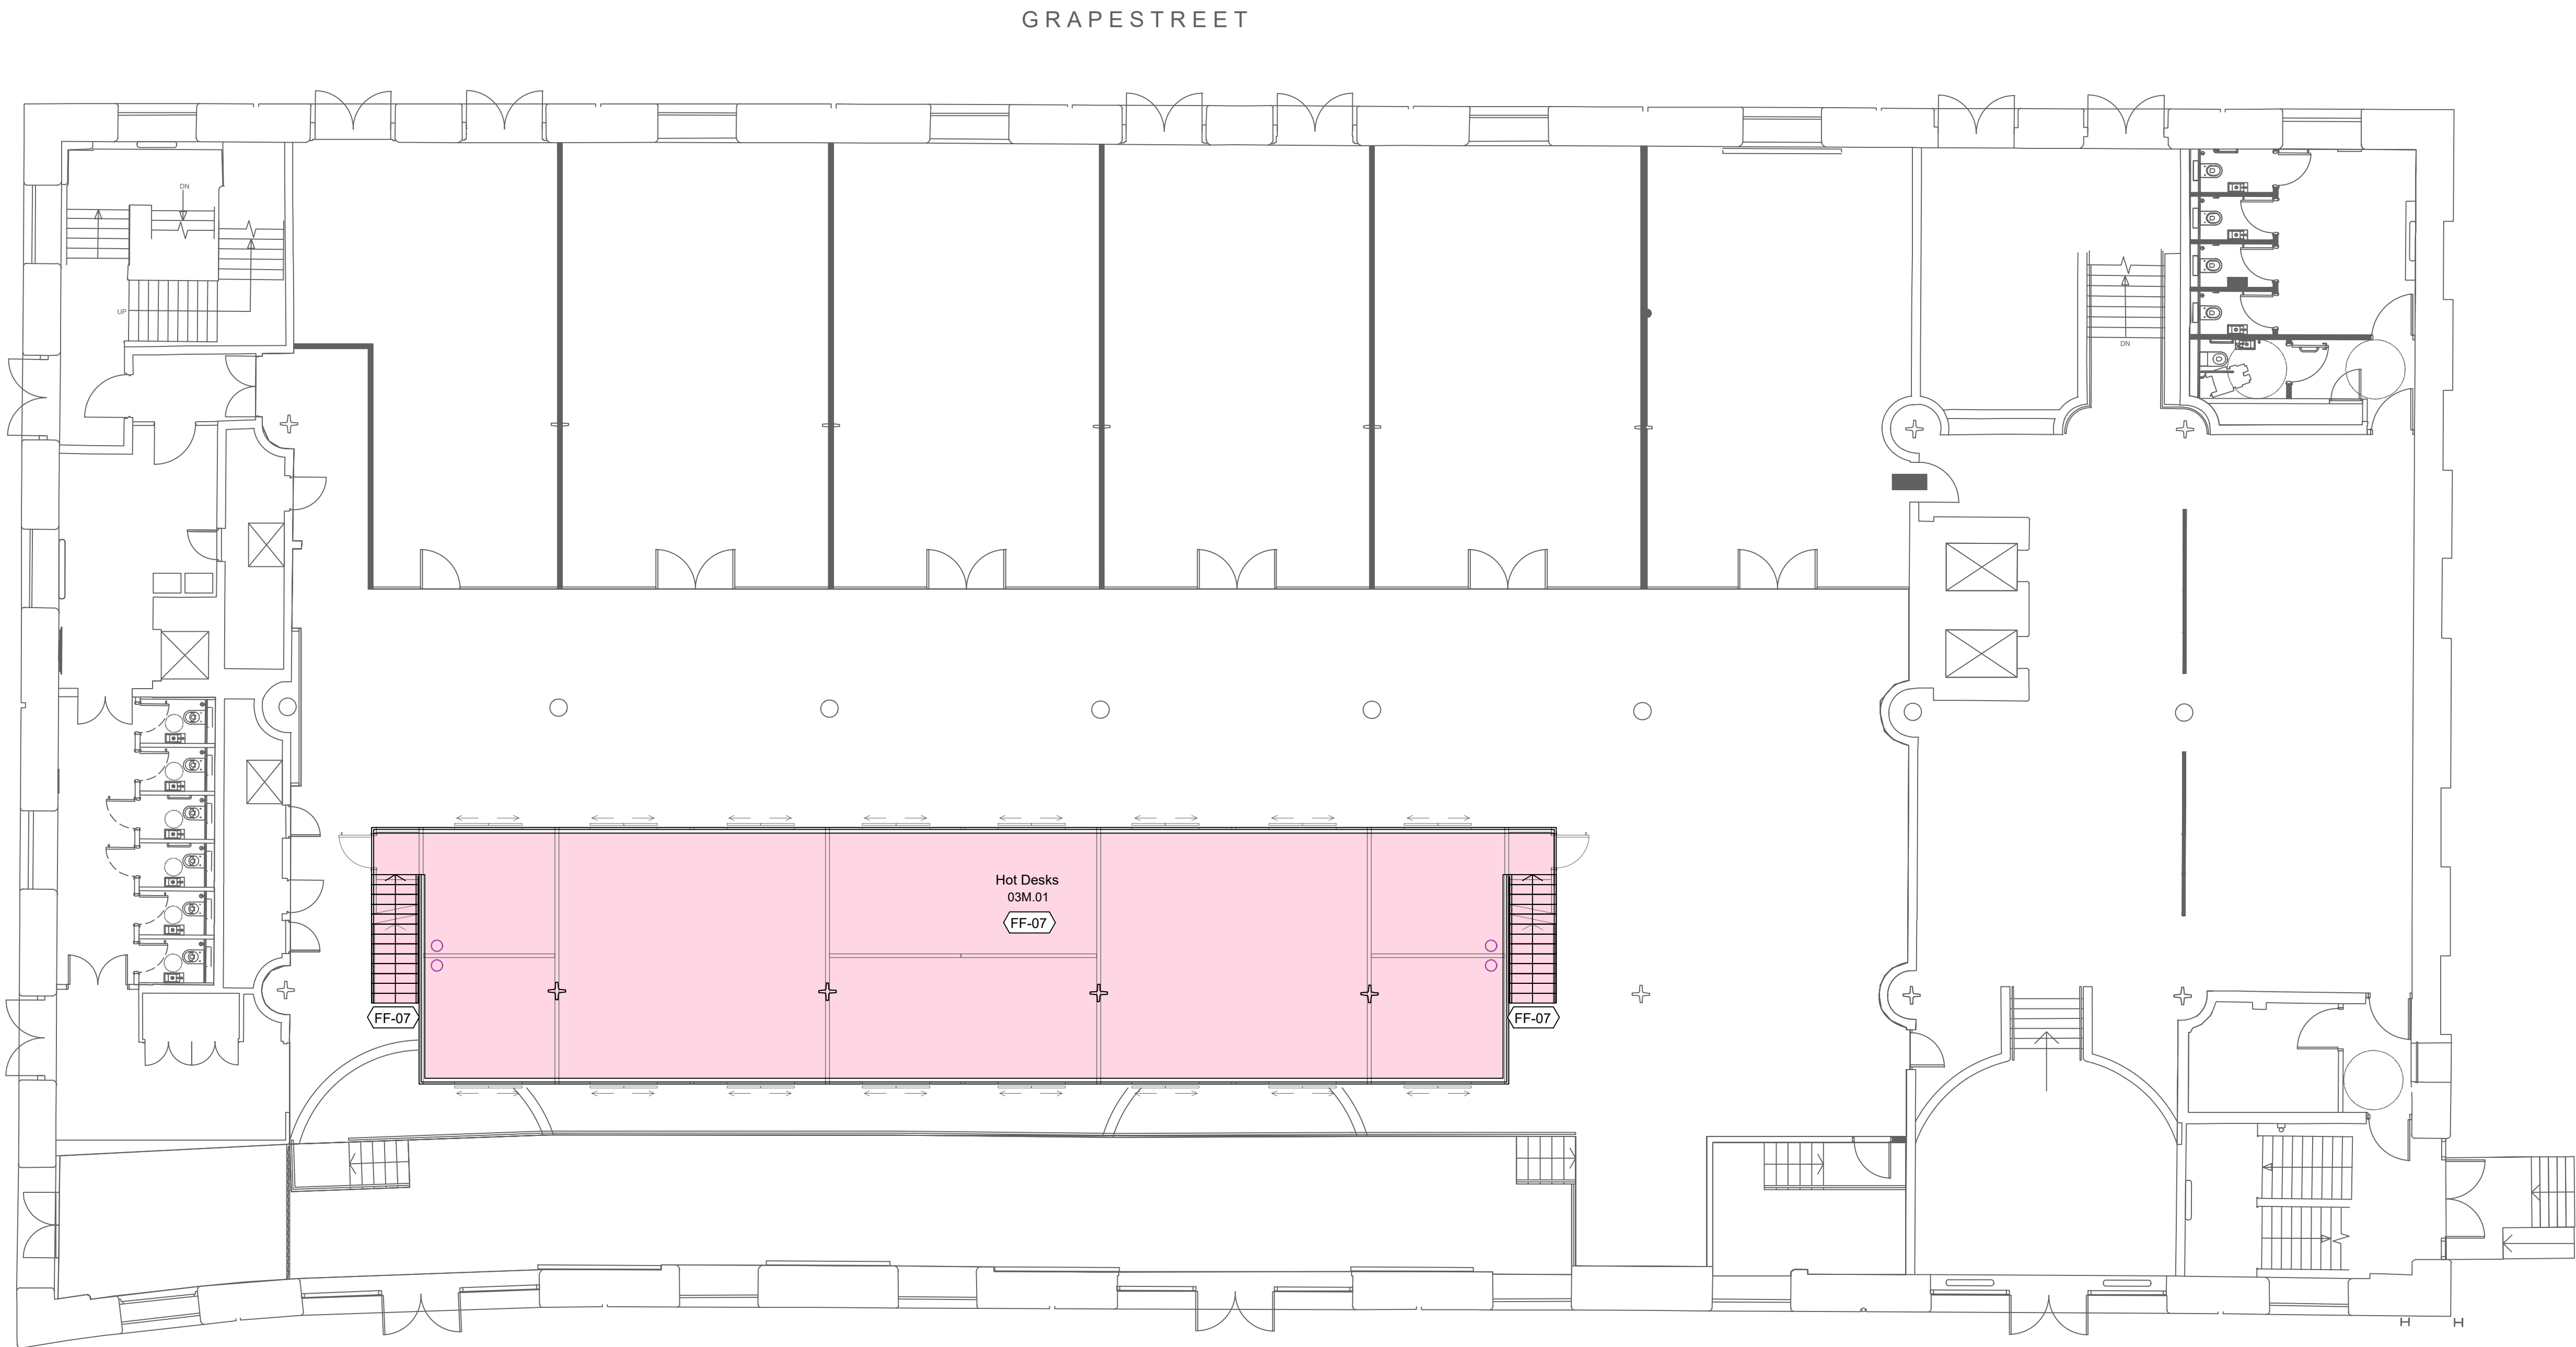

Notes:

Do not scale from this drawing. All dimensions to be checked on-site by contractor to ensure accuracy prior to any installation. All design work produced by Amspec Ltd is for indicative purposes only. It is the client and contractors responsibility to ensure that building control and fire officer approval have been met prior to commencement of site work.

Drawing Key

FF-07
Black rubber with treadplate pattern

REV: DESCRIPTION: BY: DATE:

STATUS: AS BUILT



CLIENT: OBI
80 MOSELY STREET
MANCHESTER
M2 3FX

ARCHITECT:

SITE: 18 LOWER BYROM STREET
MANCHESTER

TITLE: LEVEL 3 MEZZANINE
FLOOR FINISHES

SCALE: AT: A1: 1:100 DATE: 27.06.19 DRAWN: CR CHECKED: IC

PROJECT NO: 1683 DRAWING NO: DP_FF-03M REVISION: