


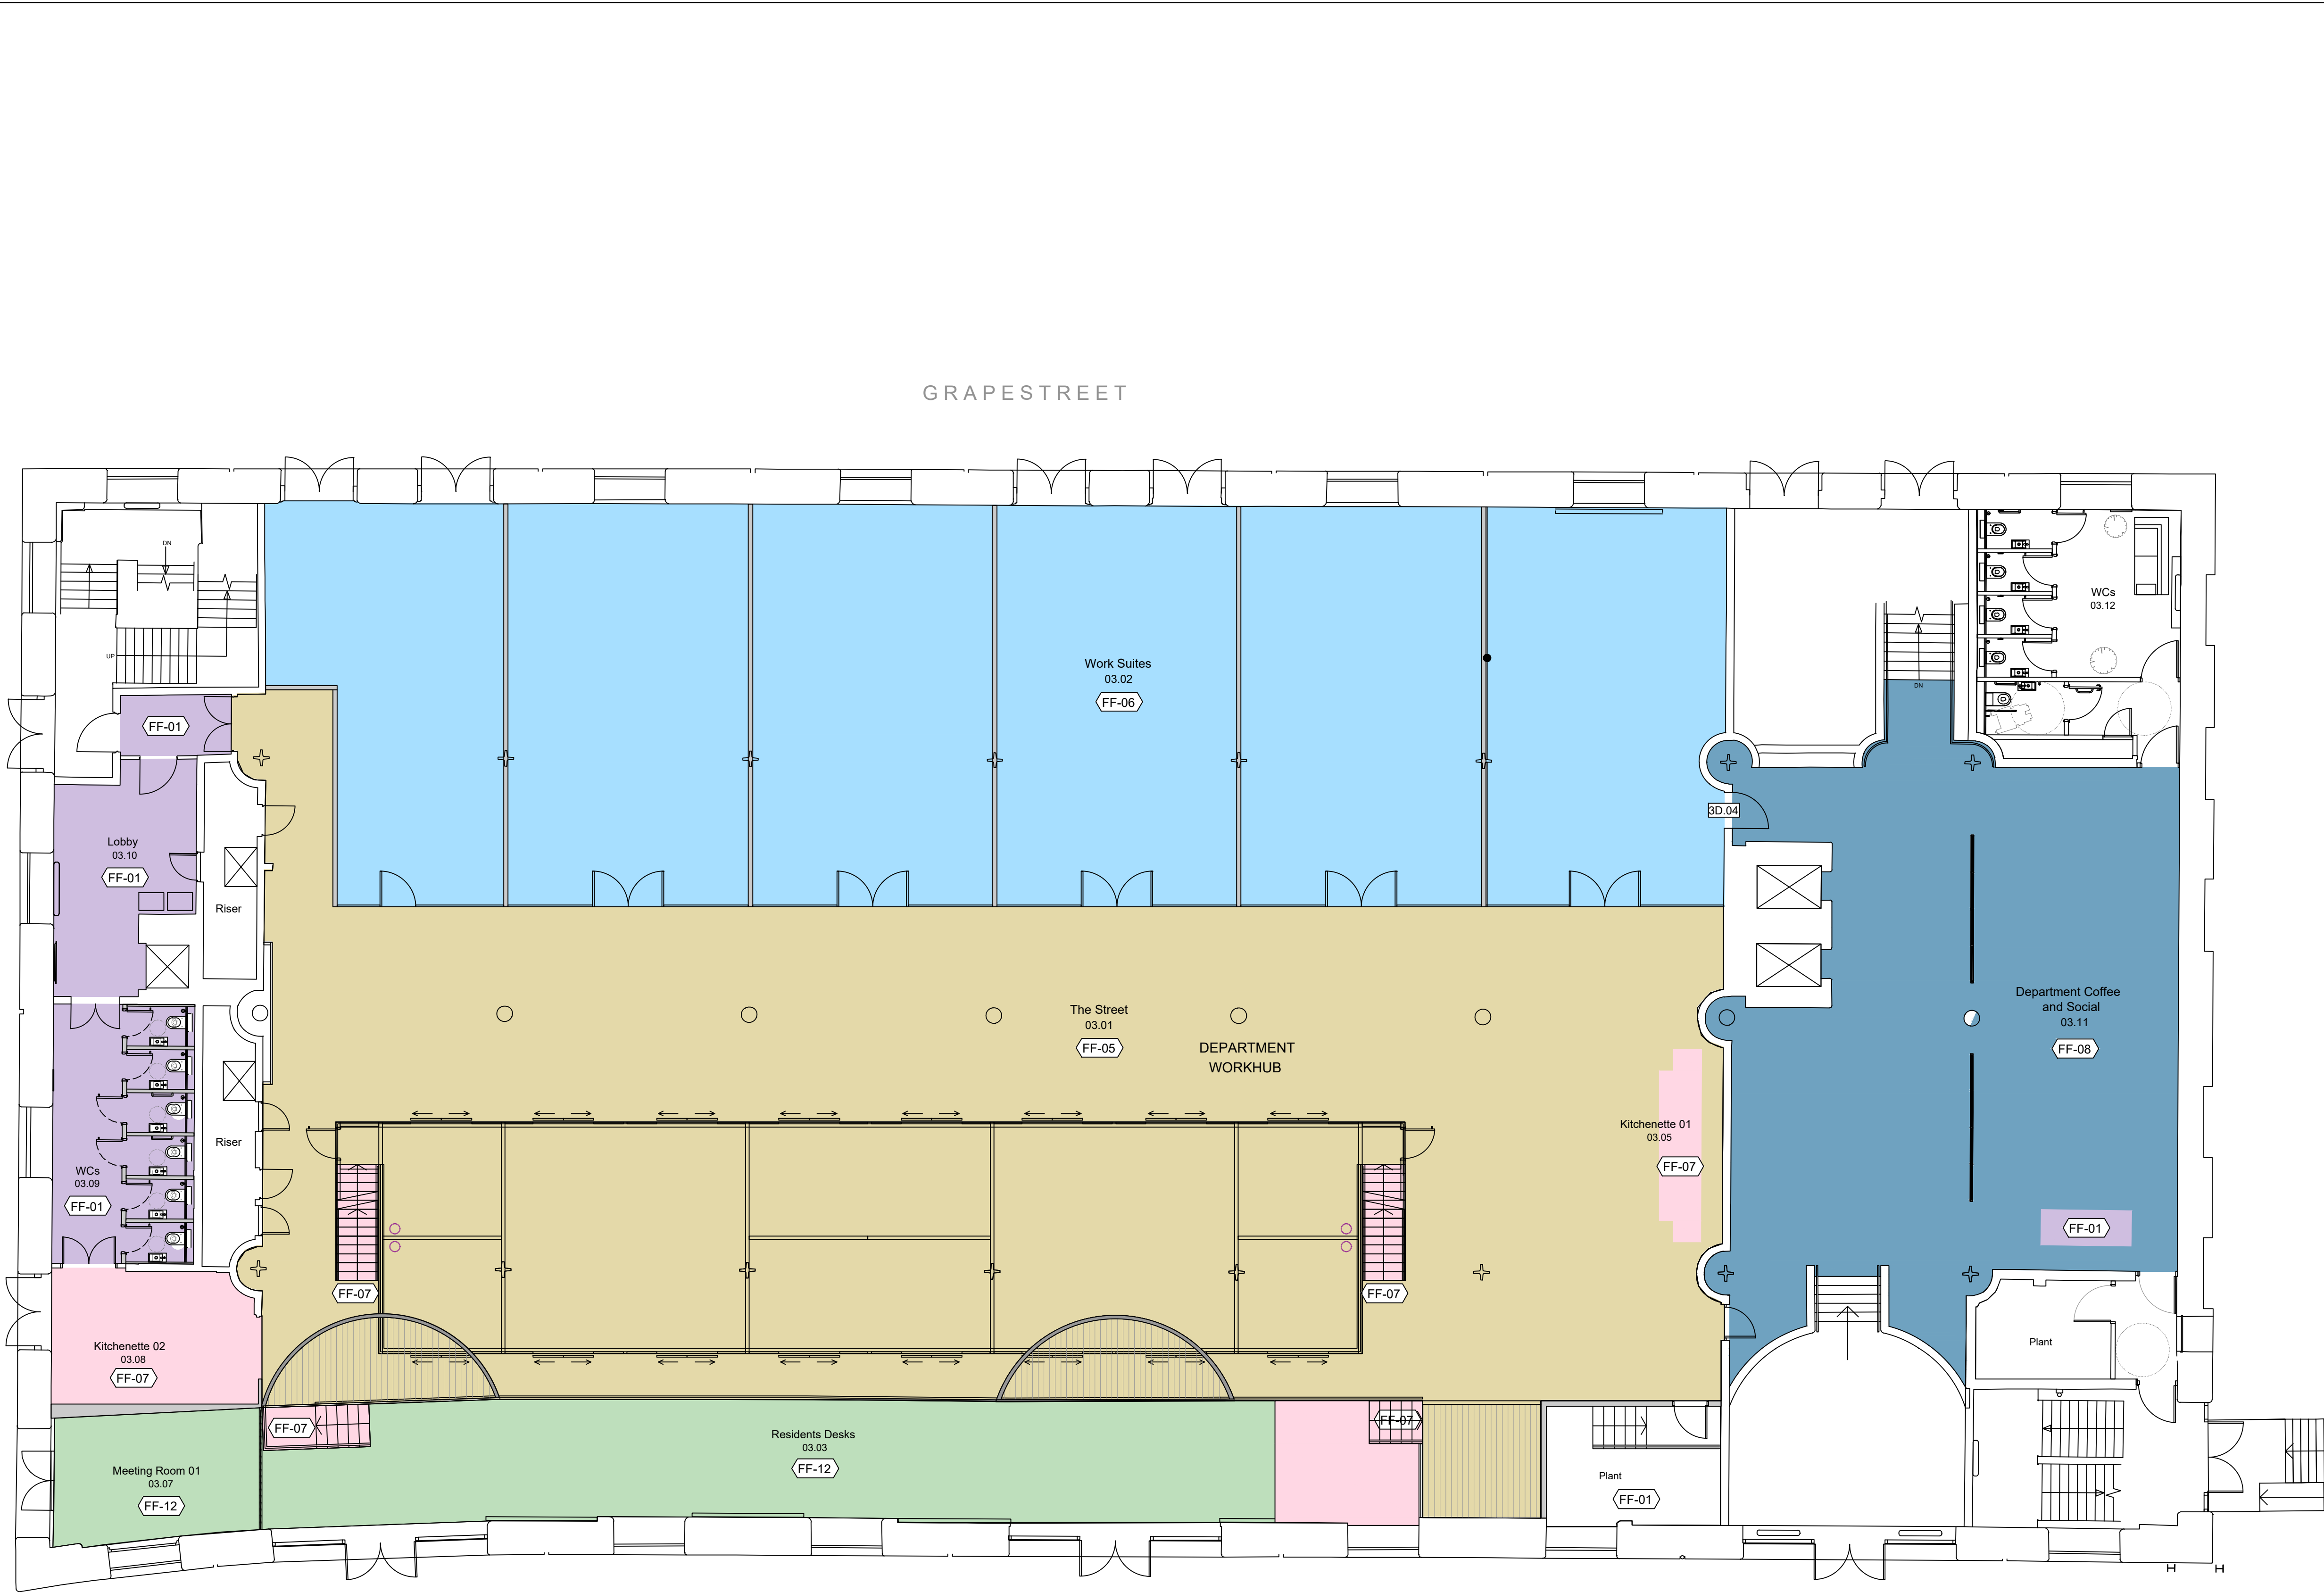

Notes:

Do not scale from this drawing. All dimensions to be checked on-site by contractor to ensure accuracy prior to any installation. All design work produced by Amspec Ltd is for indicative purposes only. It is the client and contractors responsibility to ensure that building control and fire officer approval have been met prior to commencement of site work.

Drawing Key

- FF-01 Altro Suprema Loam SU2047 safety flooring
- FF-05 Existing timber flooring
- FF-06 Bolon Elements Birch woven vinyl floor tiles
- FF-07 Black rubber with treadplate pattern
- FF-08 Existing timber flooring
- FF-12 Existing concrete floor
- FF-14 Plywood band

REV:	DESCRIPTION:	BY:	DATE:
STATUS: AS BUILT			
amspec DESIGN & BUILD SOLUTIONS t : 01942 621342 f : 01942 226552 www.amspec.co.uk			
CLIENT:	OBI 80 MOSELY STREET MANCHESTER M2 3FX		
ARCHITECT:			
SITE:	18 LOWER BYROM STREET MANCHESTER		
TITLE:	LEVEL 3 FLOOR FINISHES		
SCALE AT A1:	DATE:	DRAWN:	CHECKED:
1:100	27.06.19	CR	IC
PROJECT NO:	DRAWING NO:	REVISION:	
1683	DP_FF-03		