




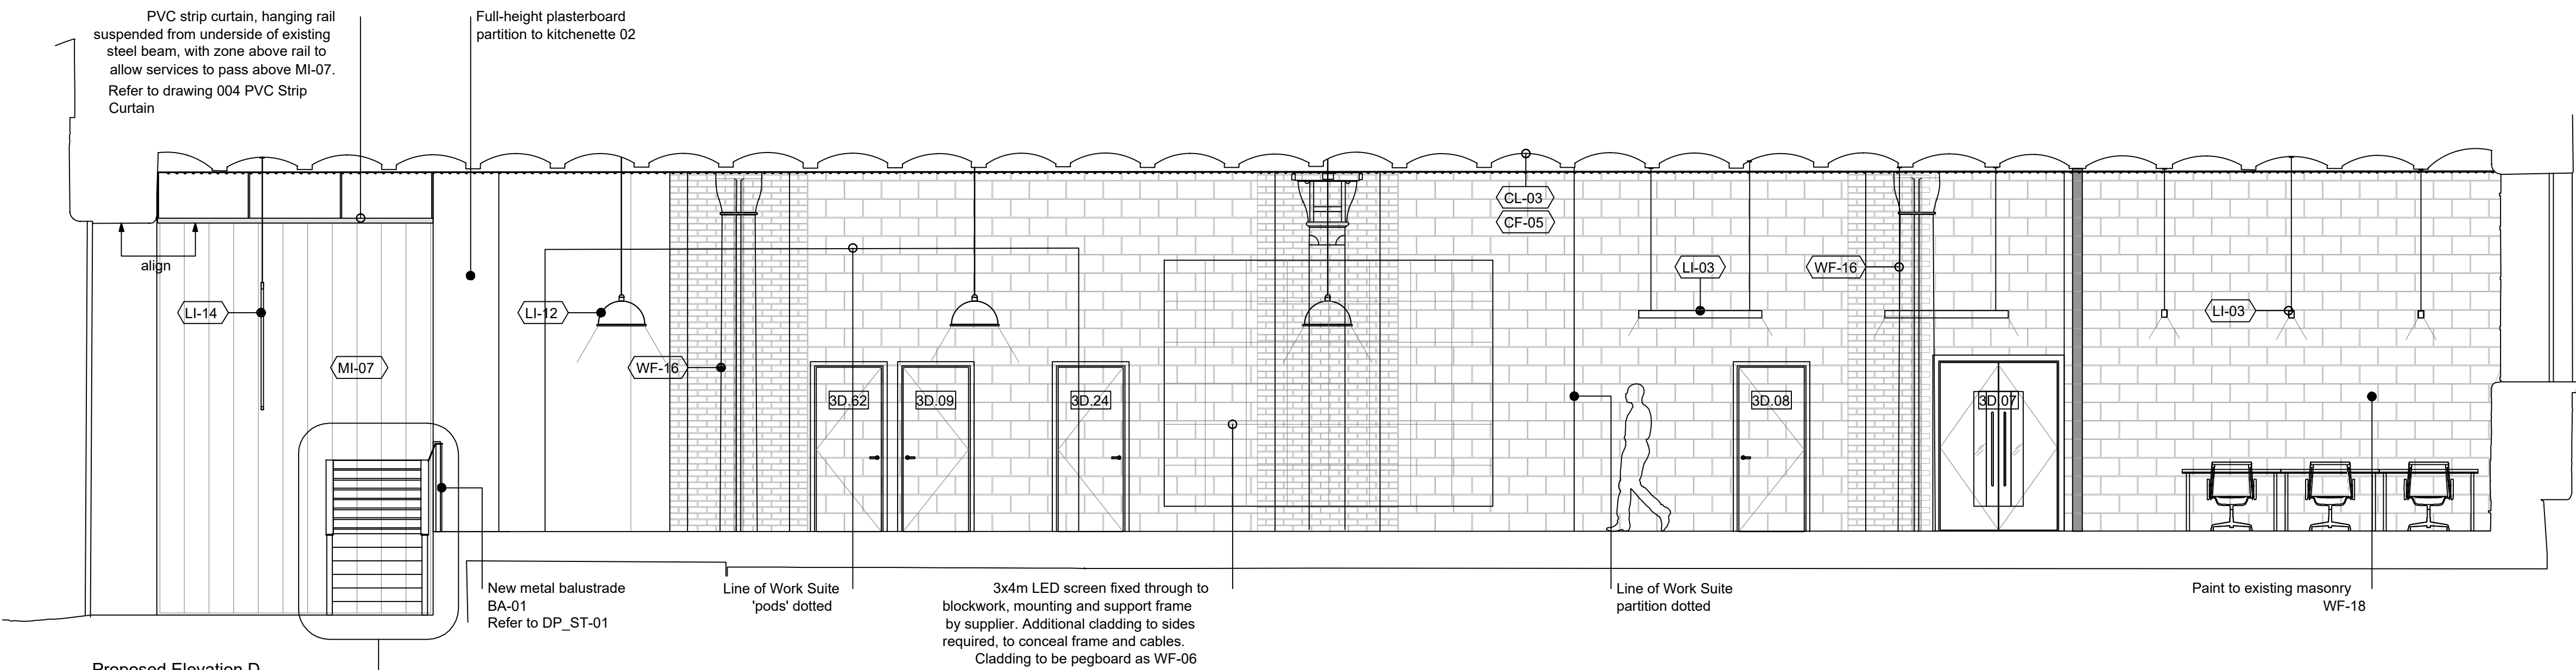

Proposed Elevation D

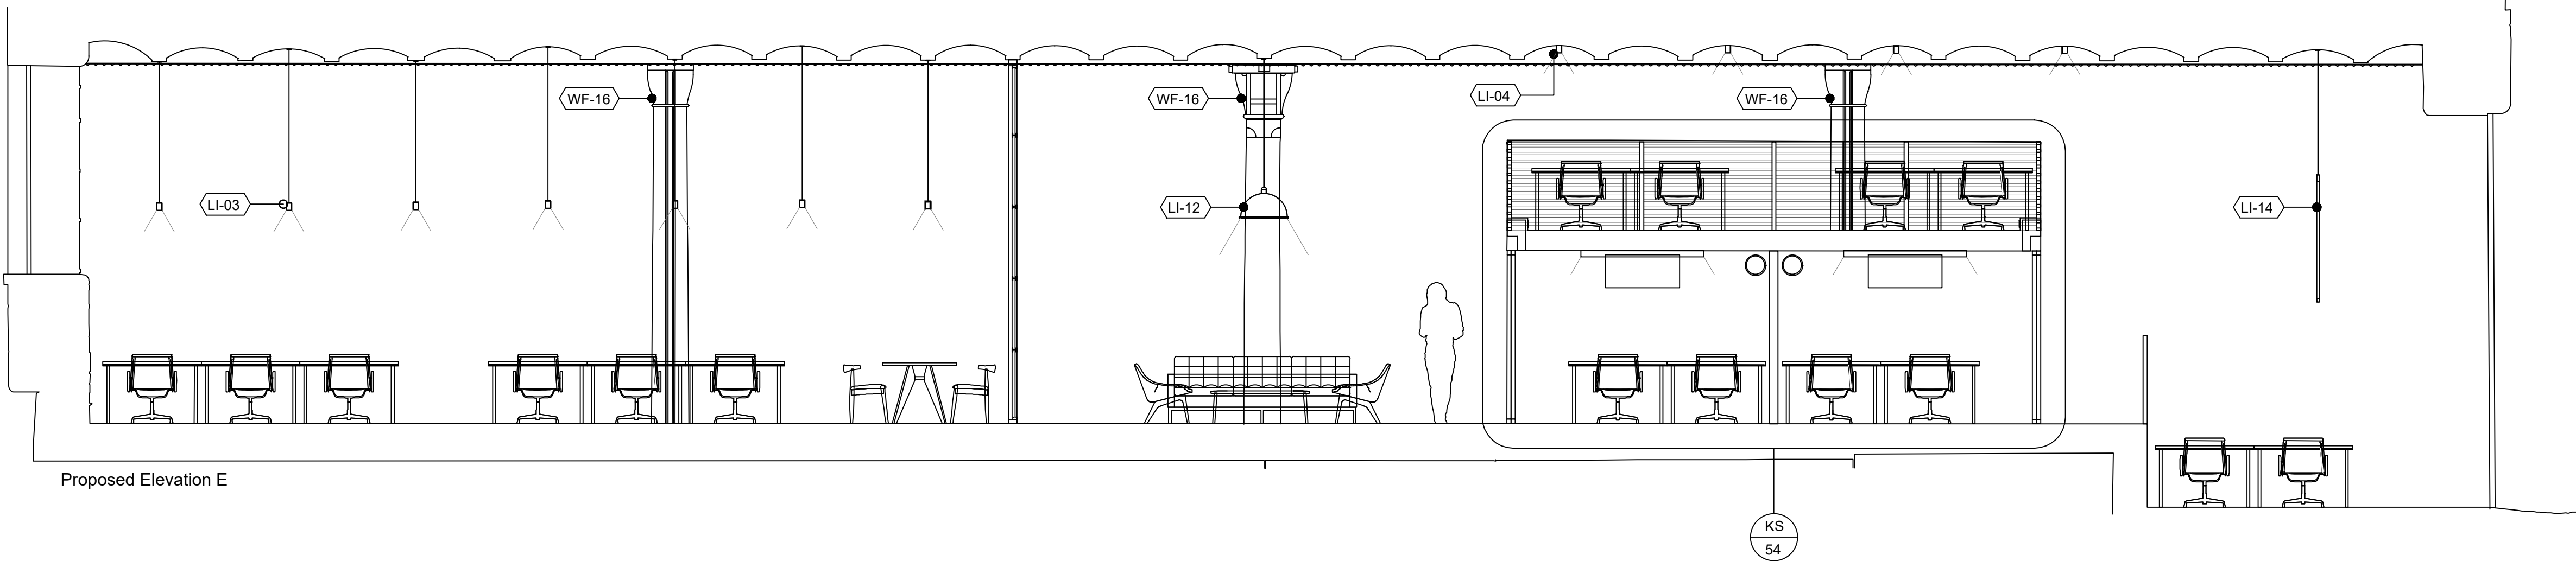


Proposed Elevation E

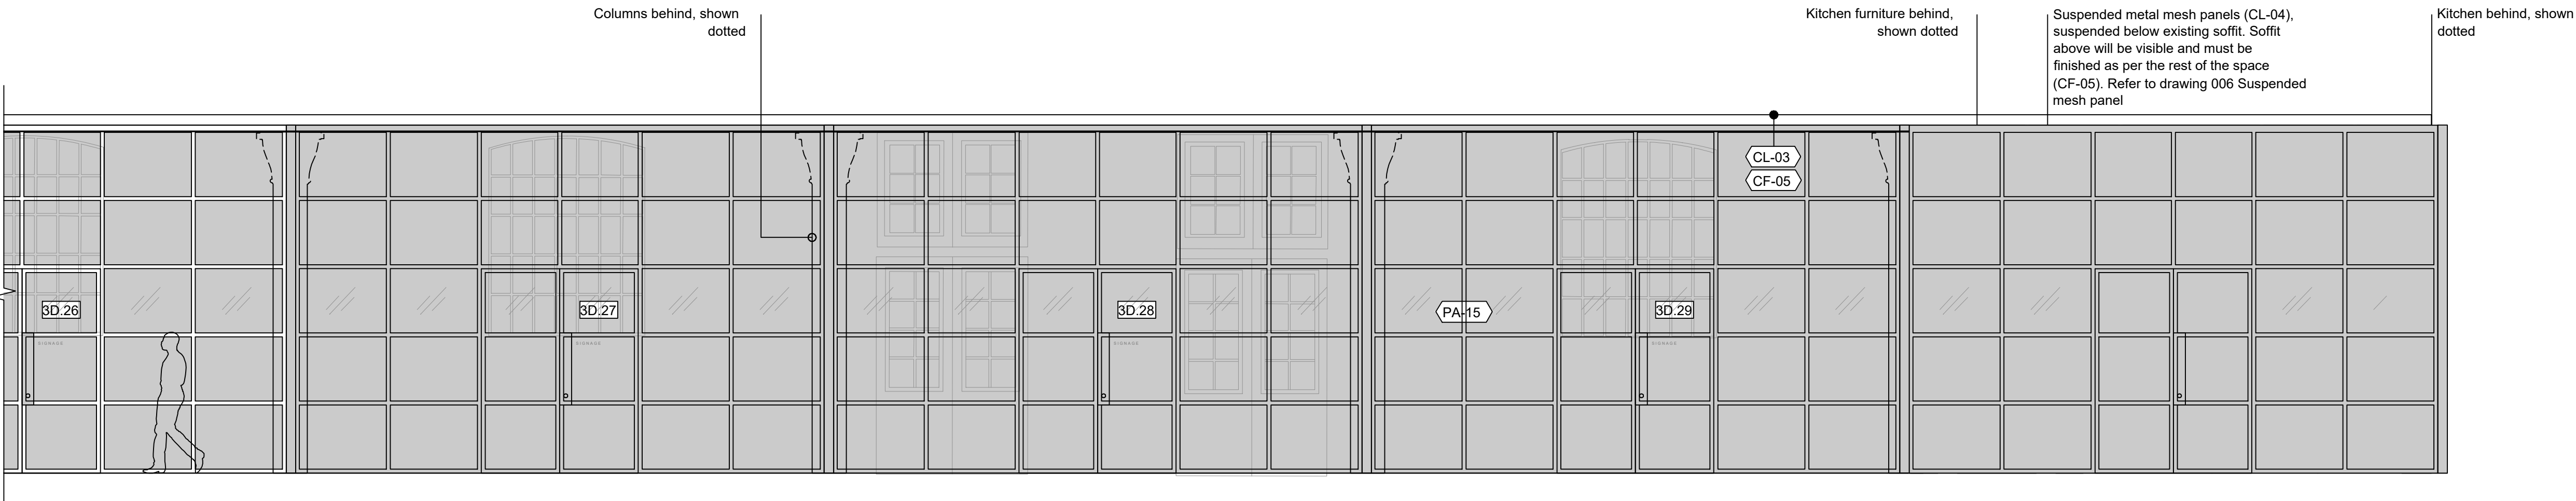

Proposed Elevation F

Notes:

Do not scale from this drawing. All dimensions to be checked on-site by contractor to ensure accuracy prior to any installation. All design work produced by Amspec Ltd is for indicative purposes only. It is the client and contractors responsibility to ensure that building control and fire officer approval have been met prior to commencement of site work.

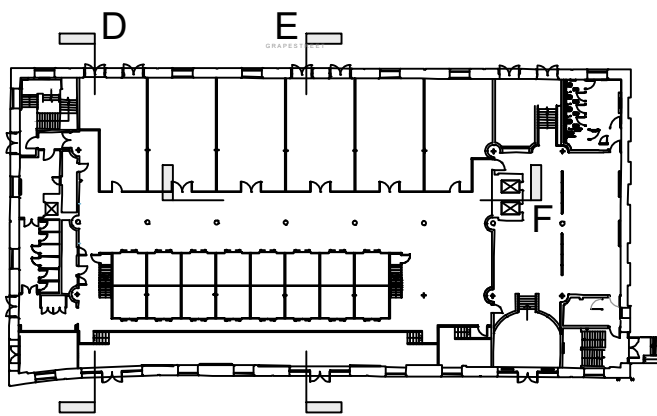

REV:	DESCRIPTION:	BY:	DATE:
STATUS:	AS BUILT		



CLIENT:	OBI 80 MOSELY STREET MANCHESTER M2 3FX
ARCHITECT:	

SITE:	18 BYROM STREET MANCHESTER
-------	-------------------------------

TITLE:	LEVEL 3 DP WORKS HUB ELEVATIONS D& E
--------	---

SCALE: AT: A1:	DATE:	DRAWN:	CHECKED:
1:50	27.06.19	CR	IC
PROJECT: NO:	DRAWING: NO:	REVISION:	
1683	DP_KS-55		