



Door Type B1: Plant and Riser Door

GENERAL NOTE
To be read in conjunction with Schedule of Works, Door Schedule and GA plans.


3D.05

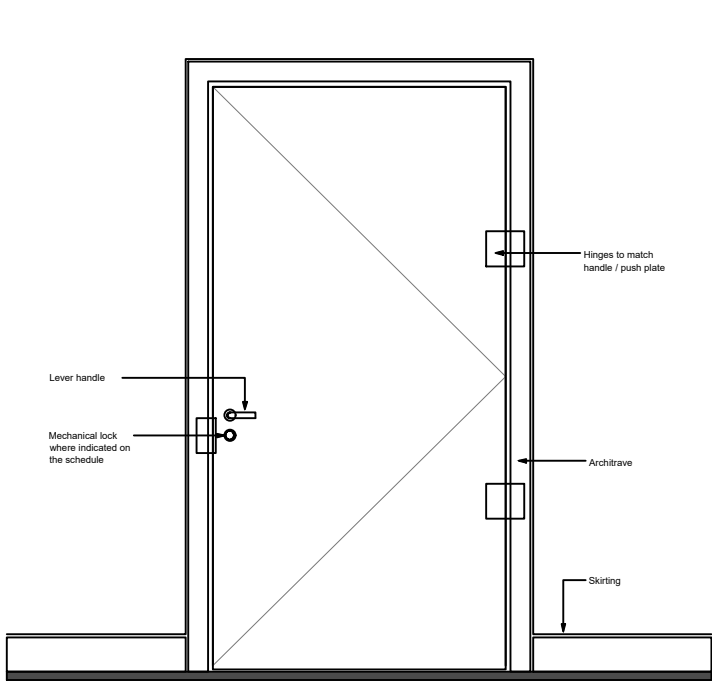


Type B1 : Front Elevation, Single arrangement

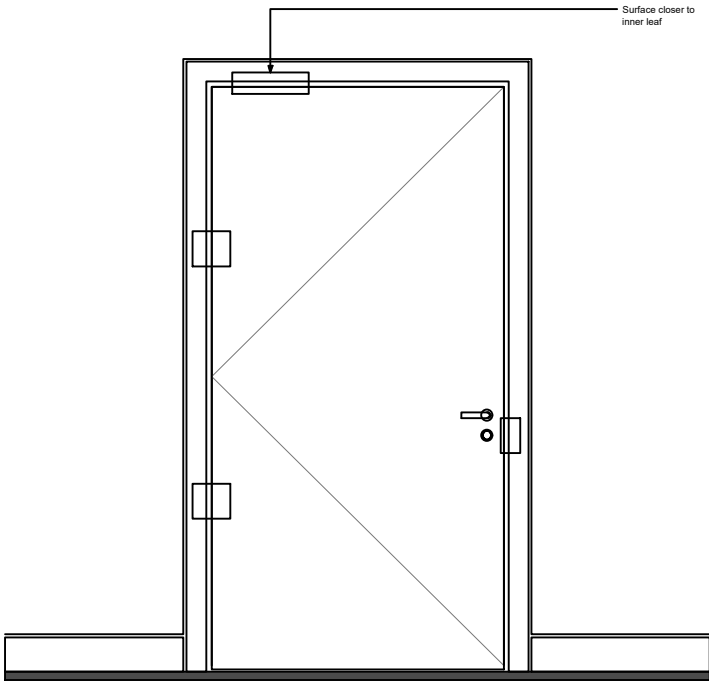

Type B1 : Rear Elevation, Single arrangement

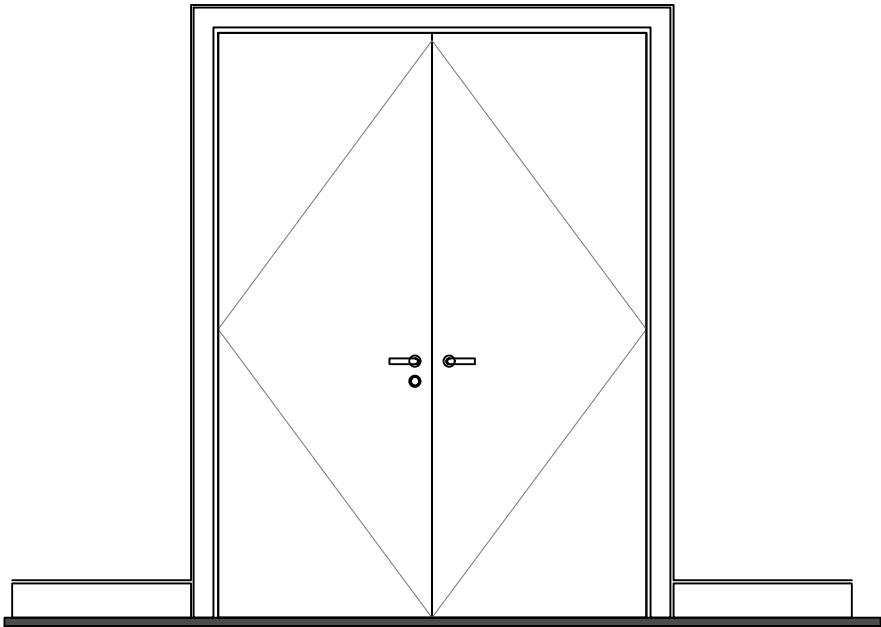


Type B1 : Front Elevation, Double arrangement

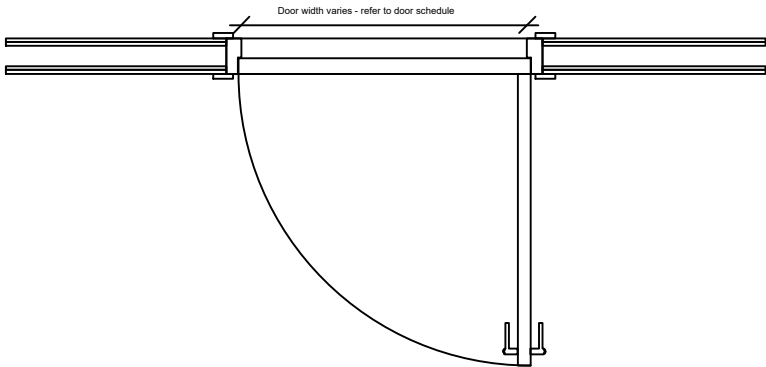

Type B1 : Plan, single arrangement

Door Type B1 : Plant / Riser Access
Painted Timber Door
NOTES:
54mm thick solid core door.
Fire rating: 30mins
Signage Design TBC

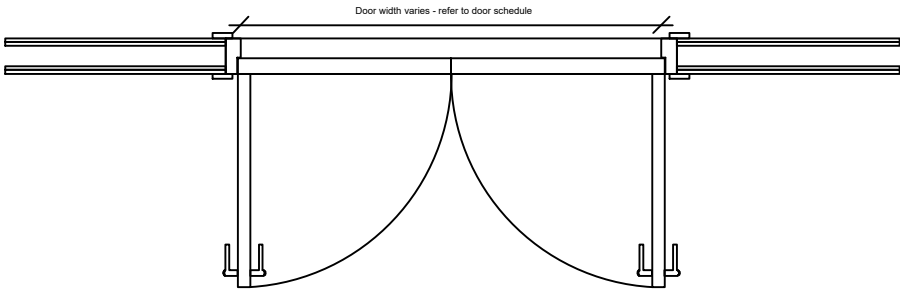

Type B1 : Plan, double arrangement

Notes:

Do not scale from this drawing. All dimensions to be checked on-site by contractor to ensure accuracy prior to any installation. All design work produced by Amspec Ltd is for indicative purposes only. It is the client and contractors responsibility to ensure that building control and fire officer approval have been met prior to commencement of site work

REV:	DESCRIPTION:	BY:	DATE:
STATUS: AS BUILT			
amspec DESIGN & BUILD SOLUTIONS f : 01942 621342 f : 01942 226552 www.amspec.co.uk			
CLIENT:	OBI 80 MOSELY STREET MANCHESTER M2 3FX		
ARCHITECT:			
SITE:	18 LOWER BYROM STREET MANCHESTER		
TITLE:	LEVEL 3 DOOR TYPE B1		
SCALE AT A3: 1:25	DATE: 28.06.19	DRAWN: CR	CHECKED: IC
PROJECT NO: 1683	DRAWING NO: DP_DT-07	REVISION:	