




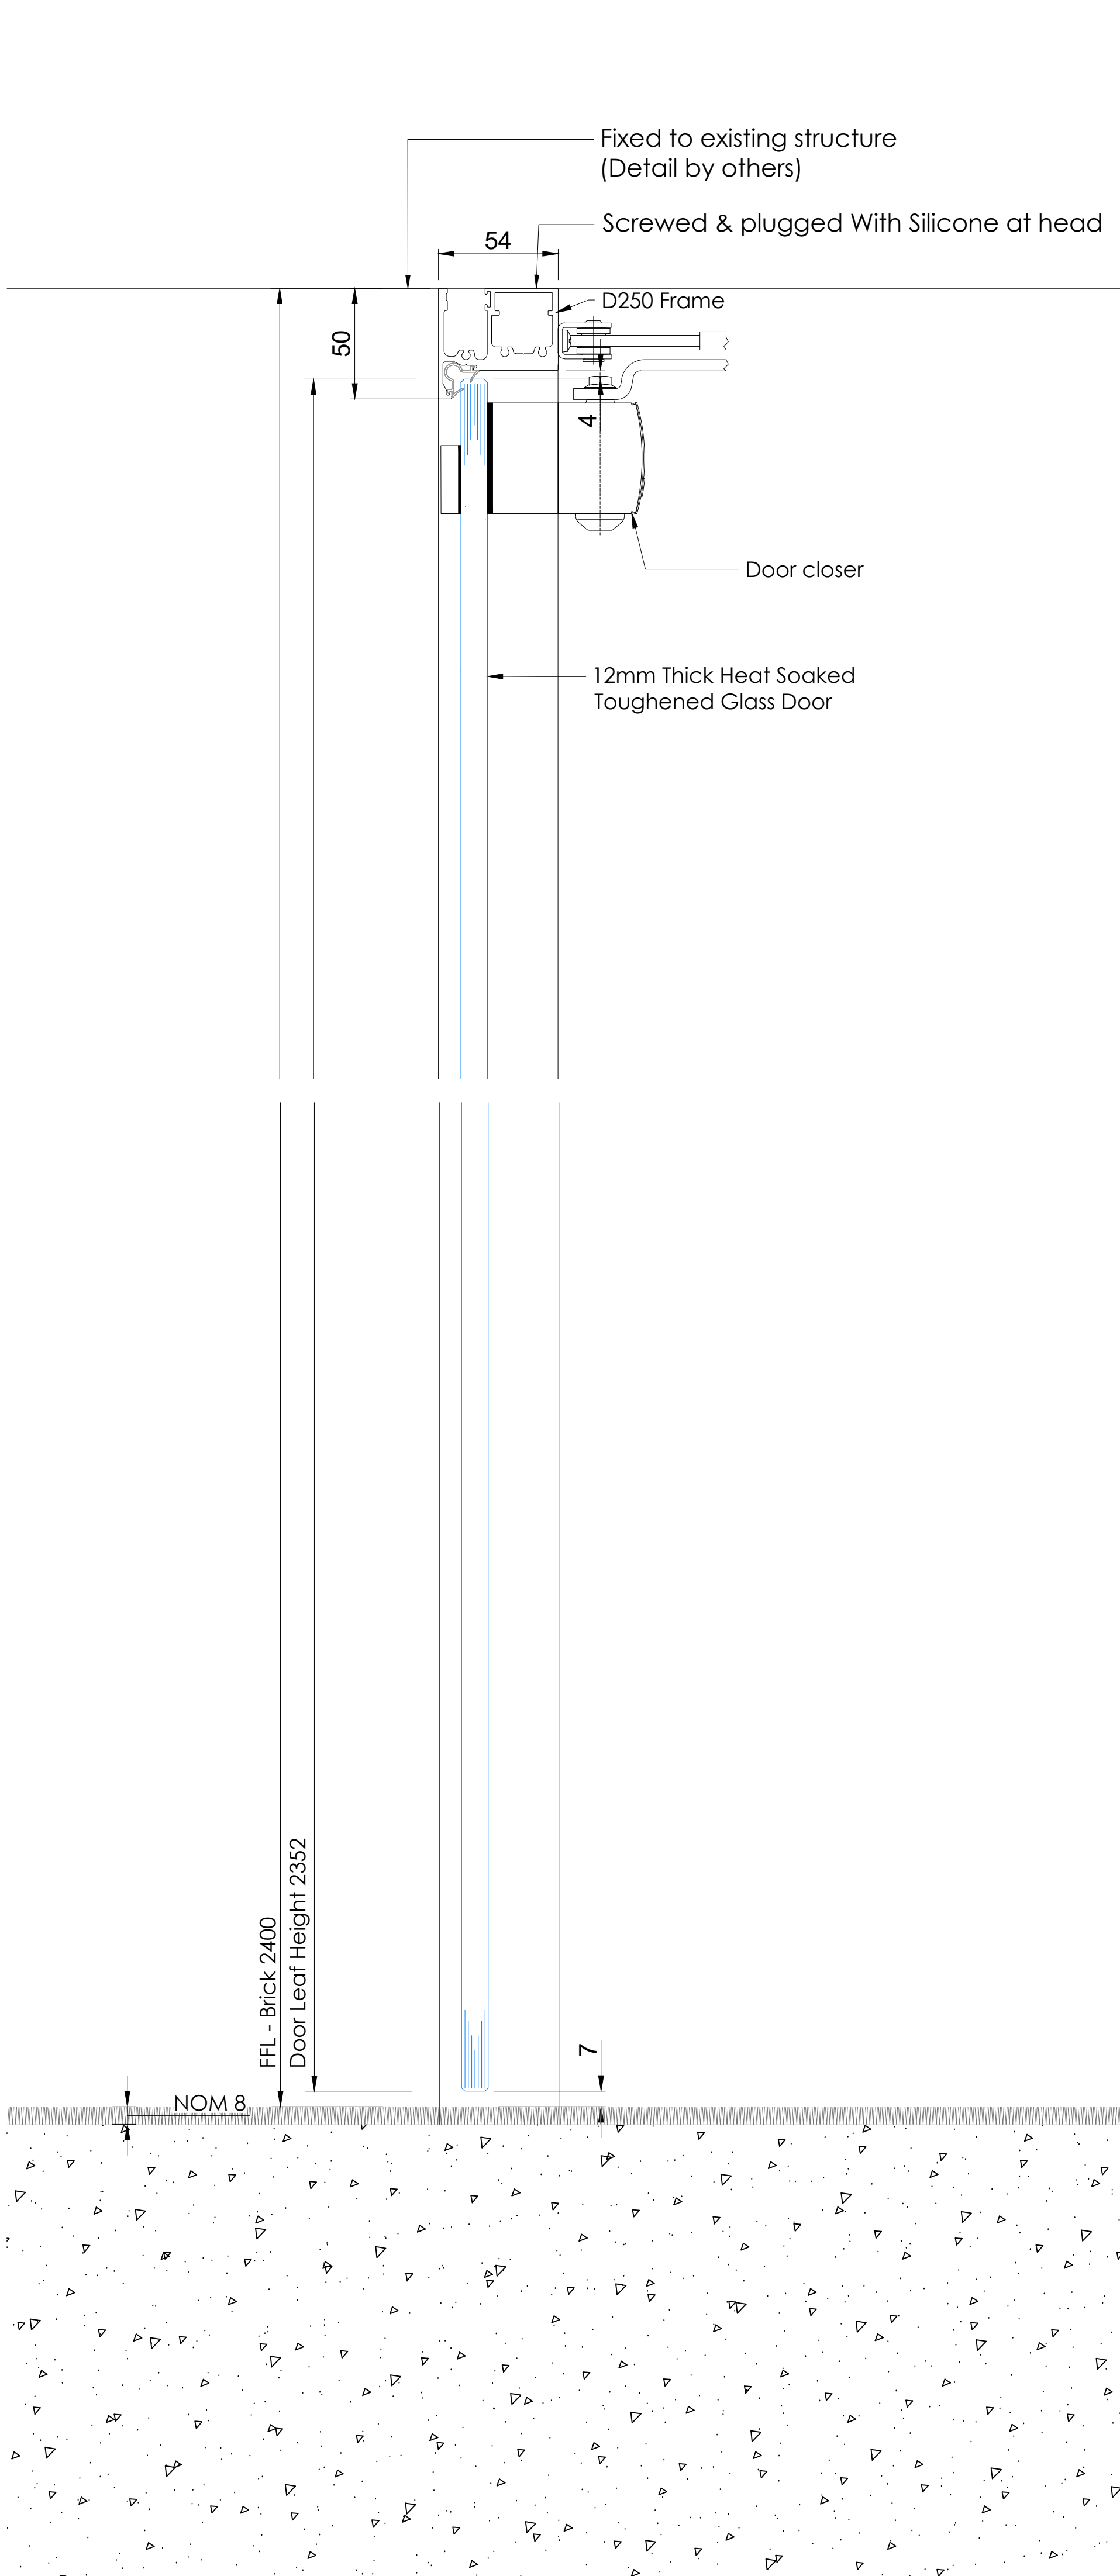


1 SECTION: Door Axile Clarity Scale 1:2

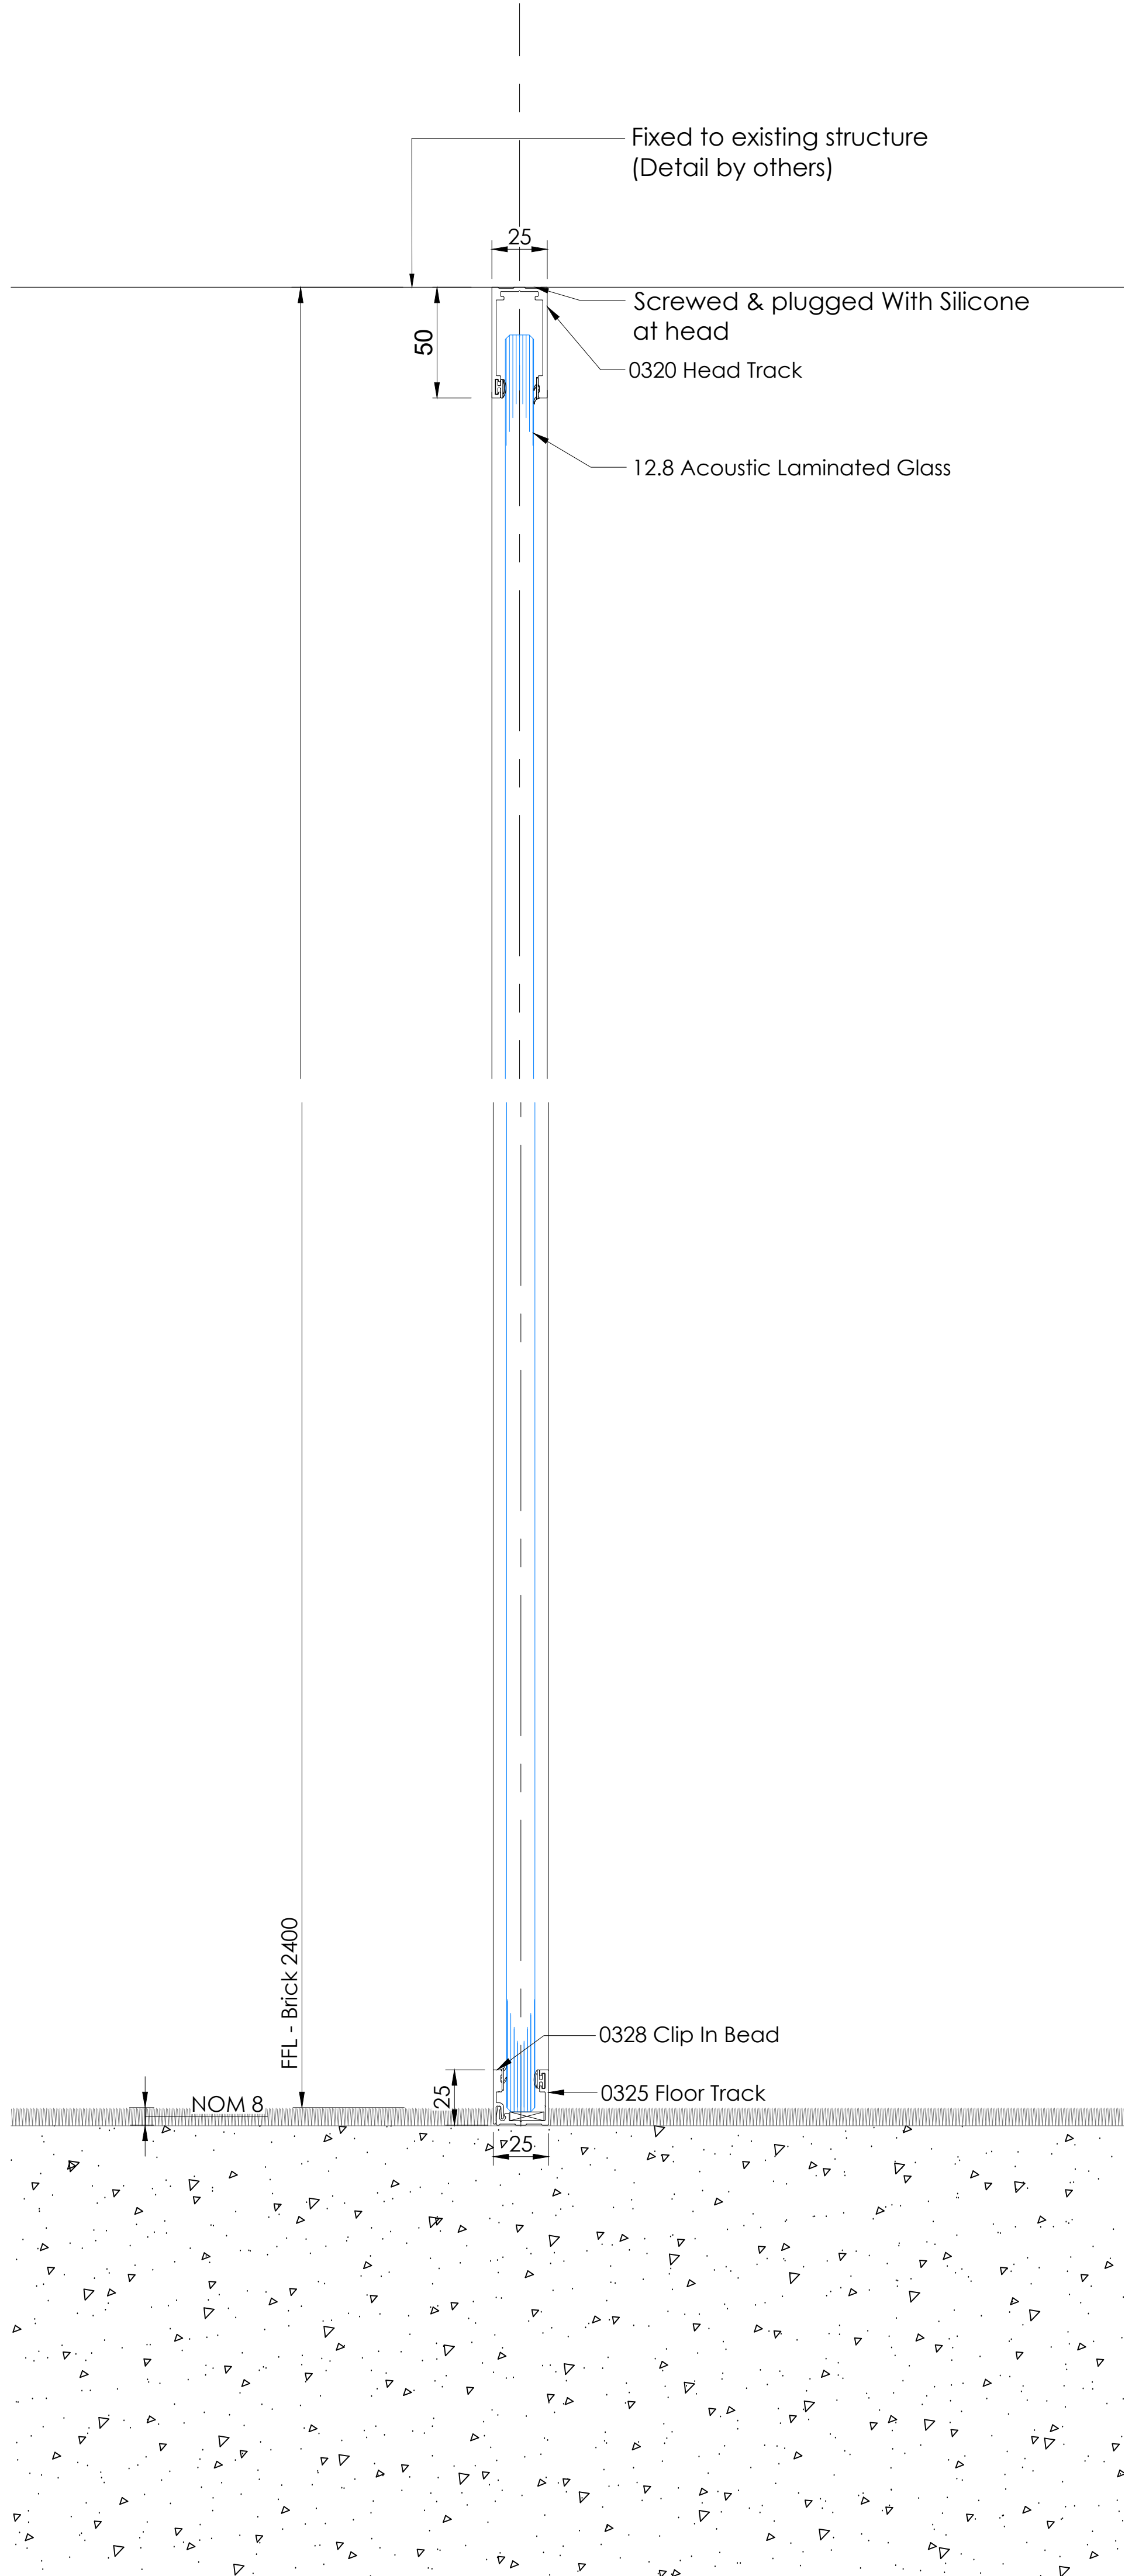


2 SECTION: Screen 13 117+ Scale 1:2

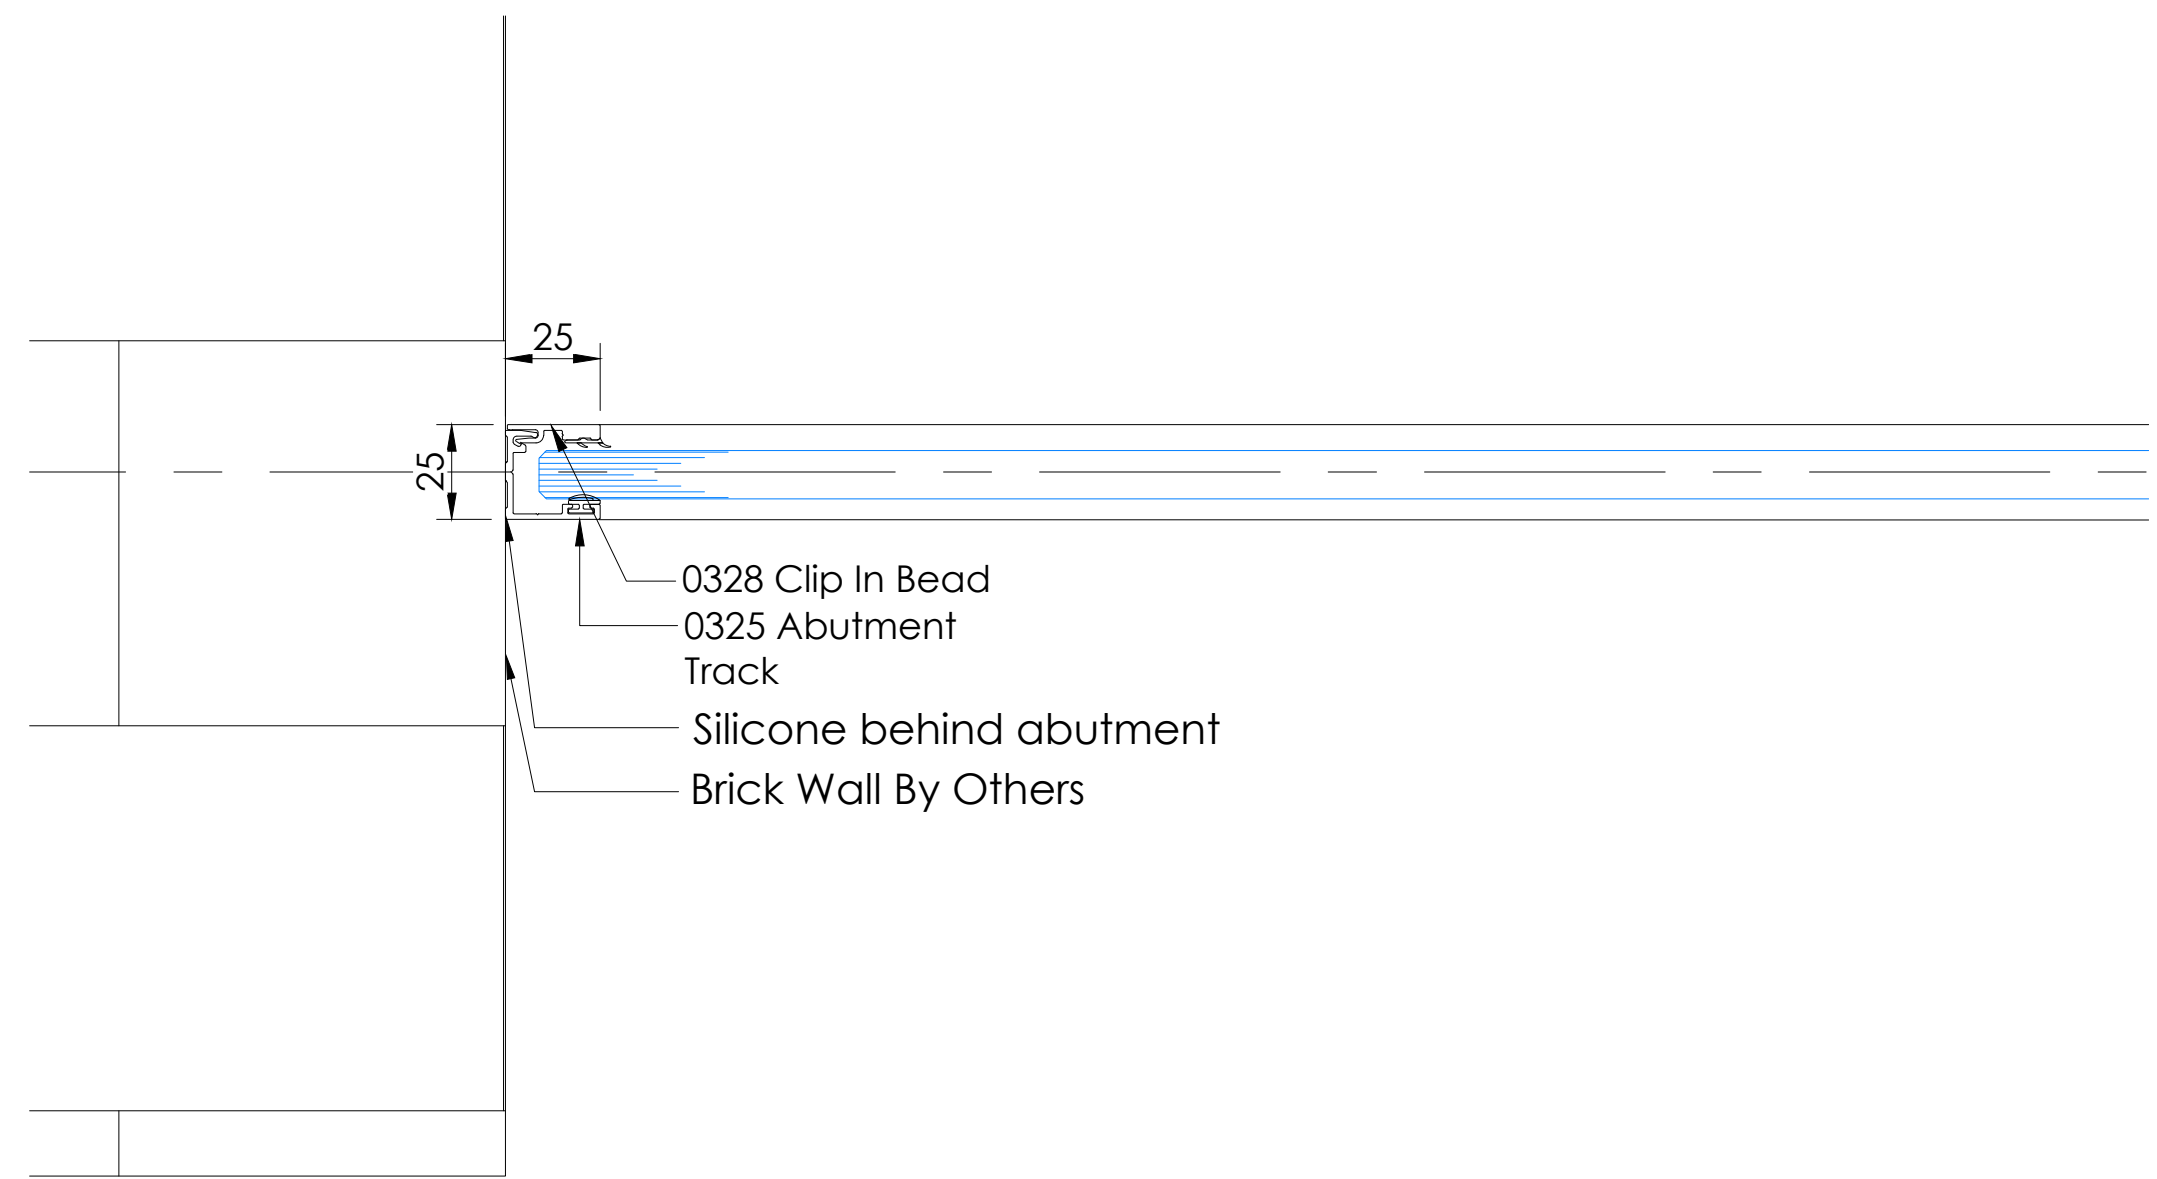


3 Plan Details: Wall Abutment Scale 1:2

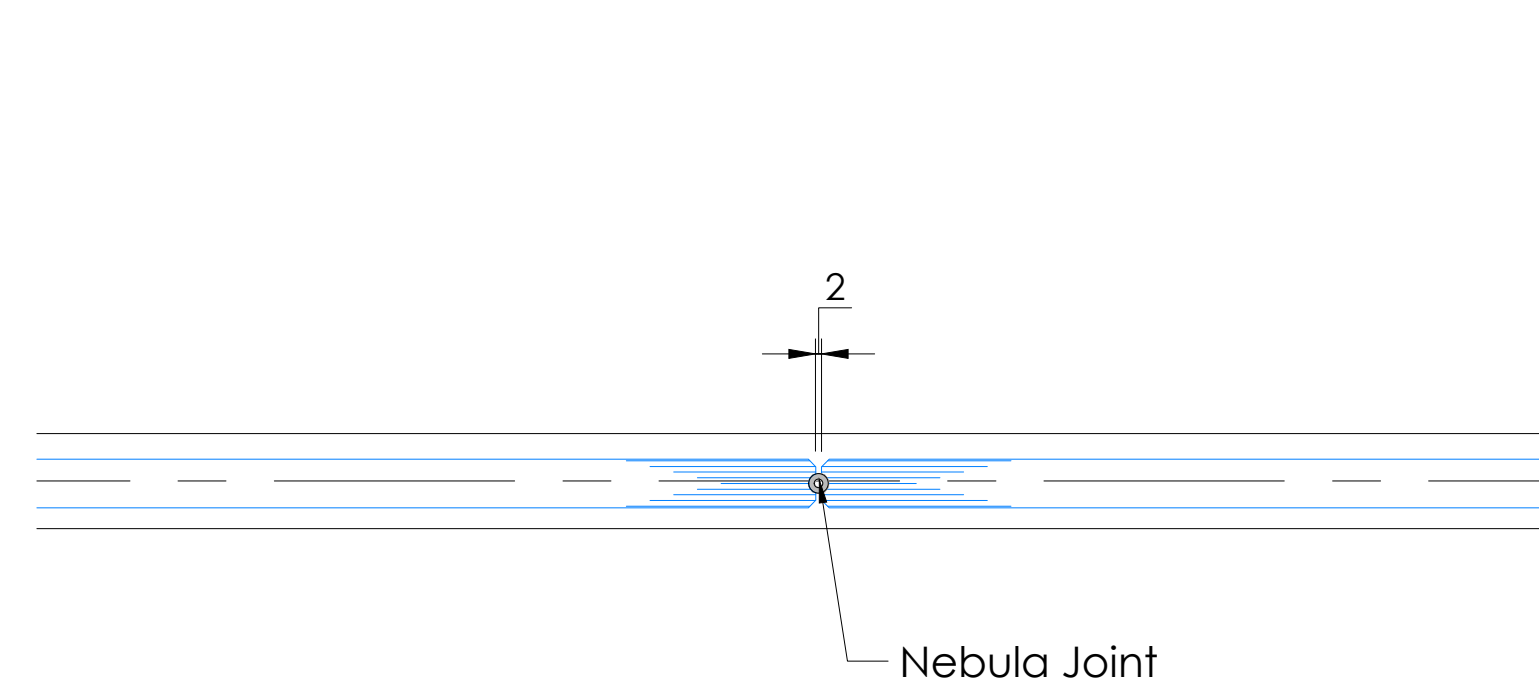


4 Plan Details: Nebula Joint Scale 1:2

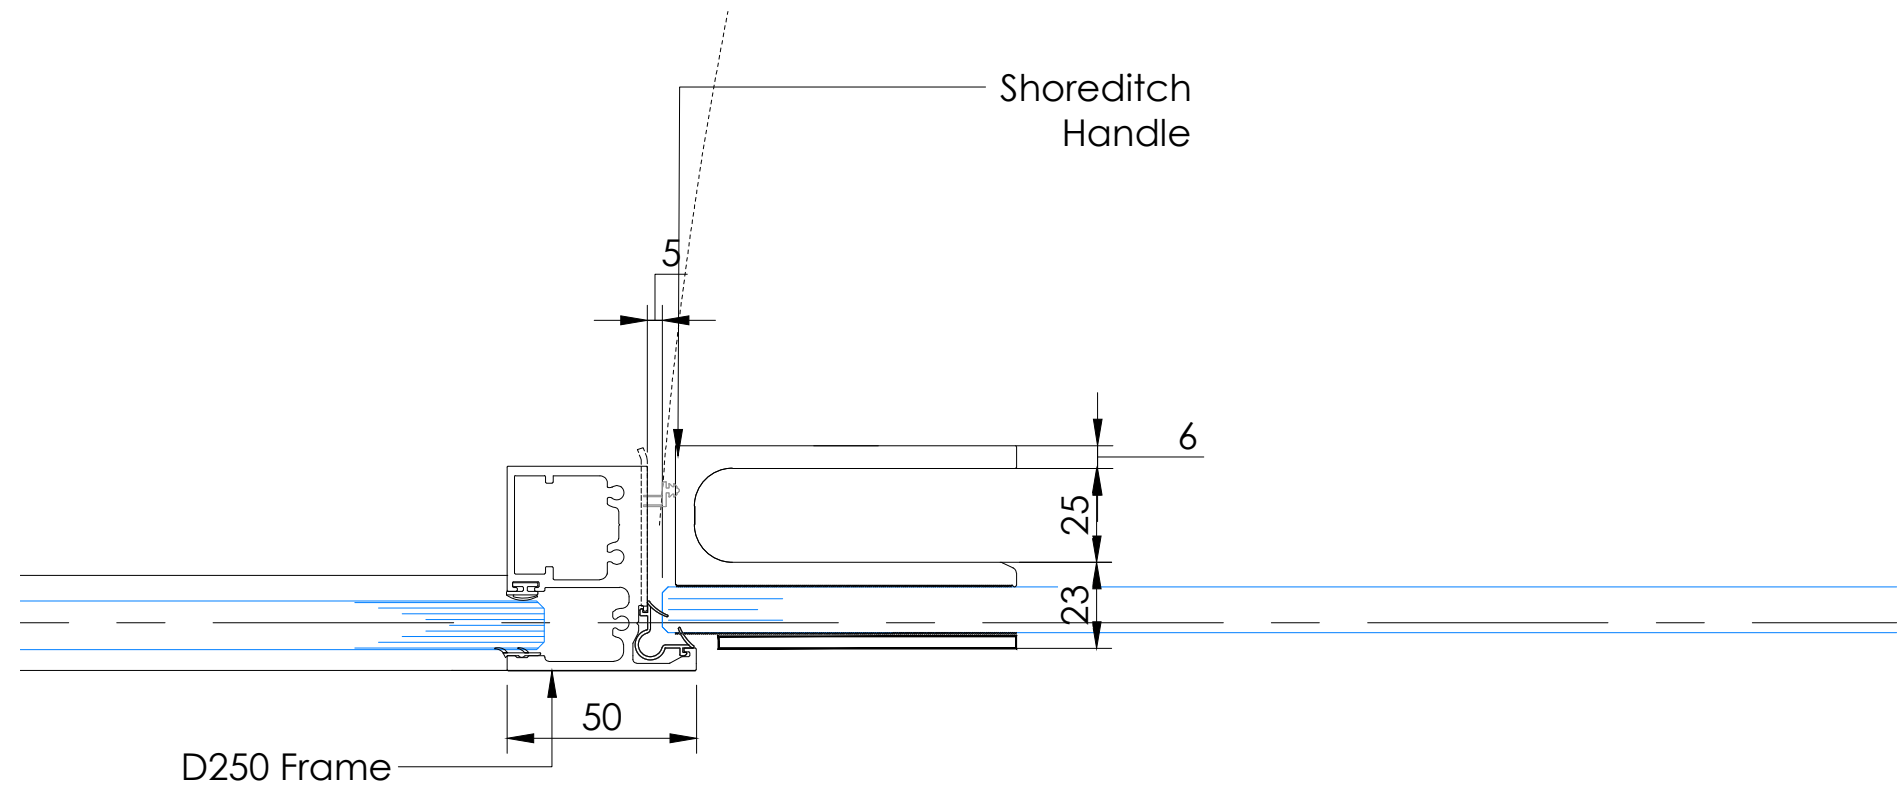


5 Plan Details: Door Jamb Scale 1:2

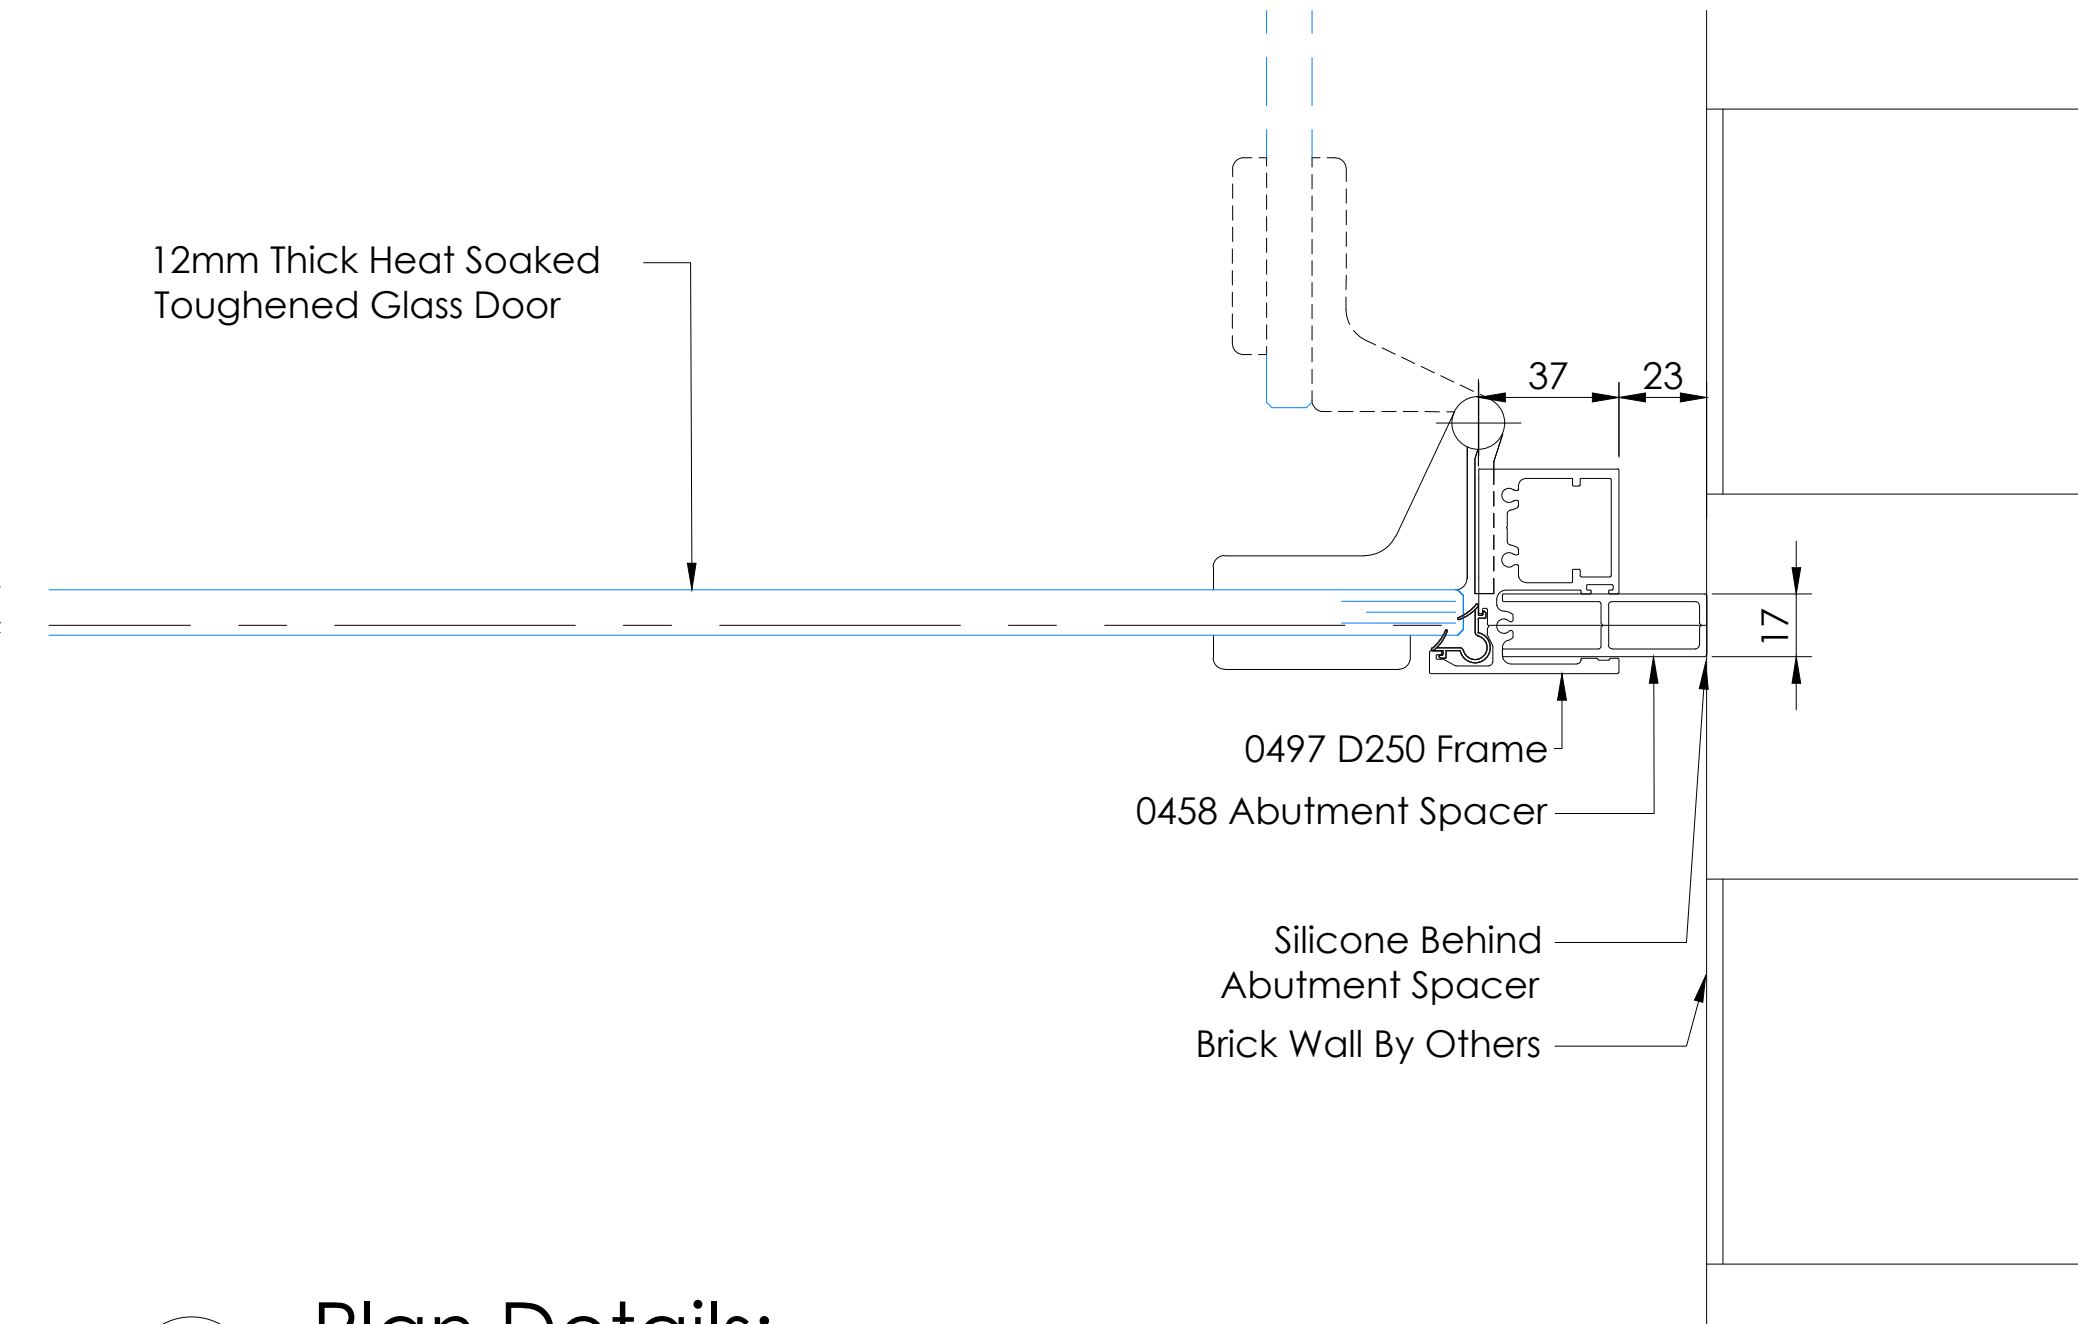

6 Plan Details: Abutment Spacer Scale 1:2

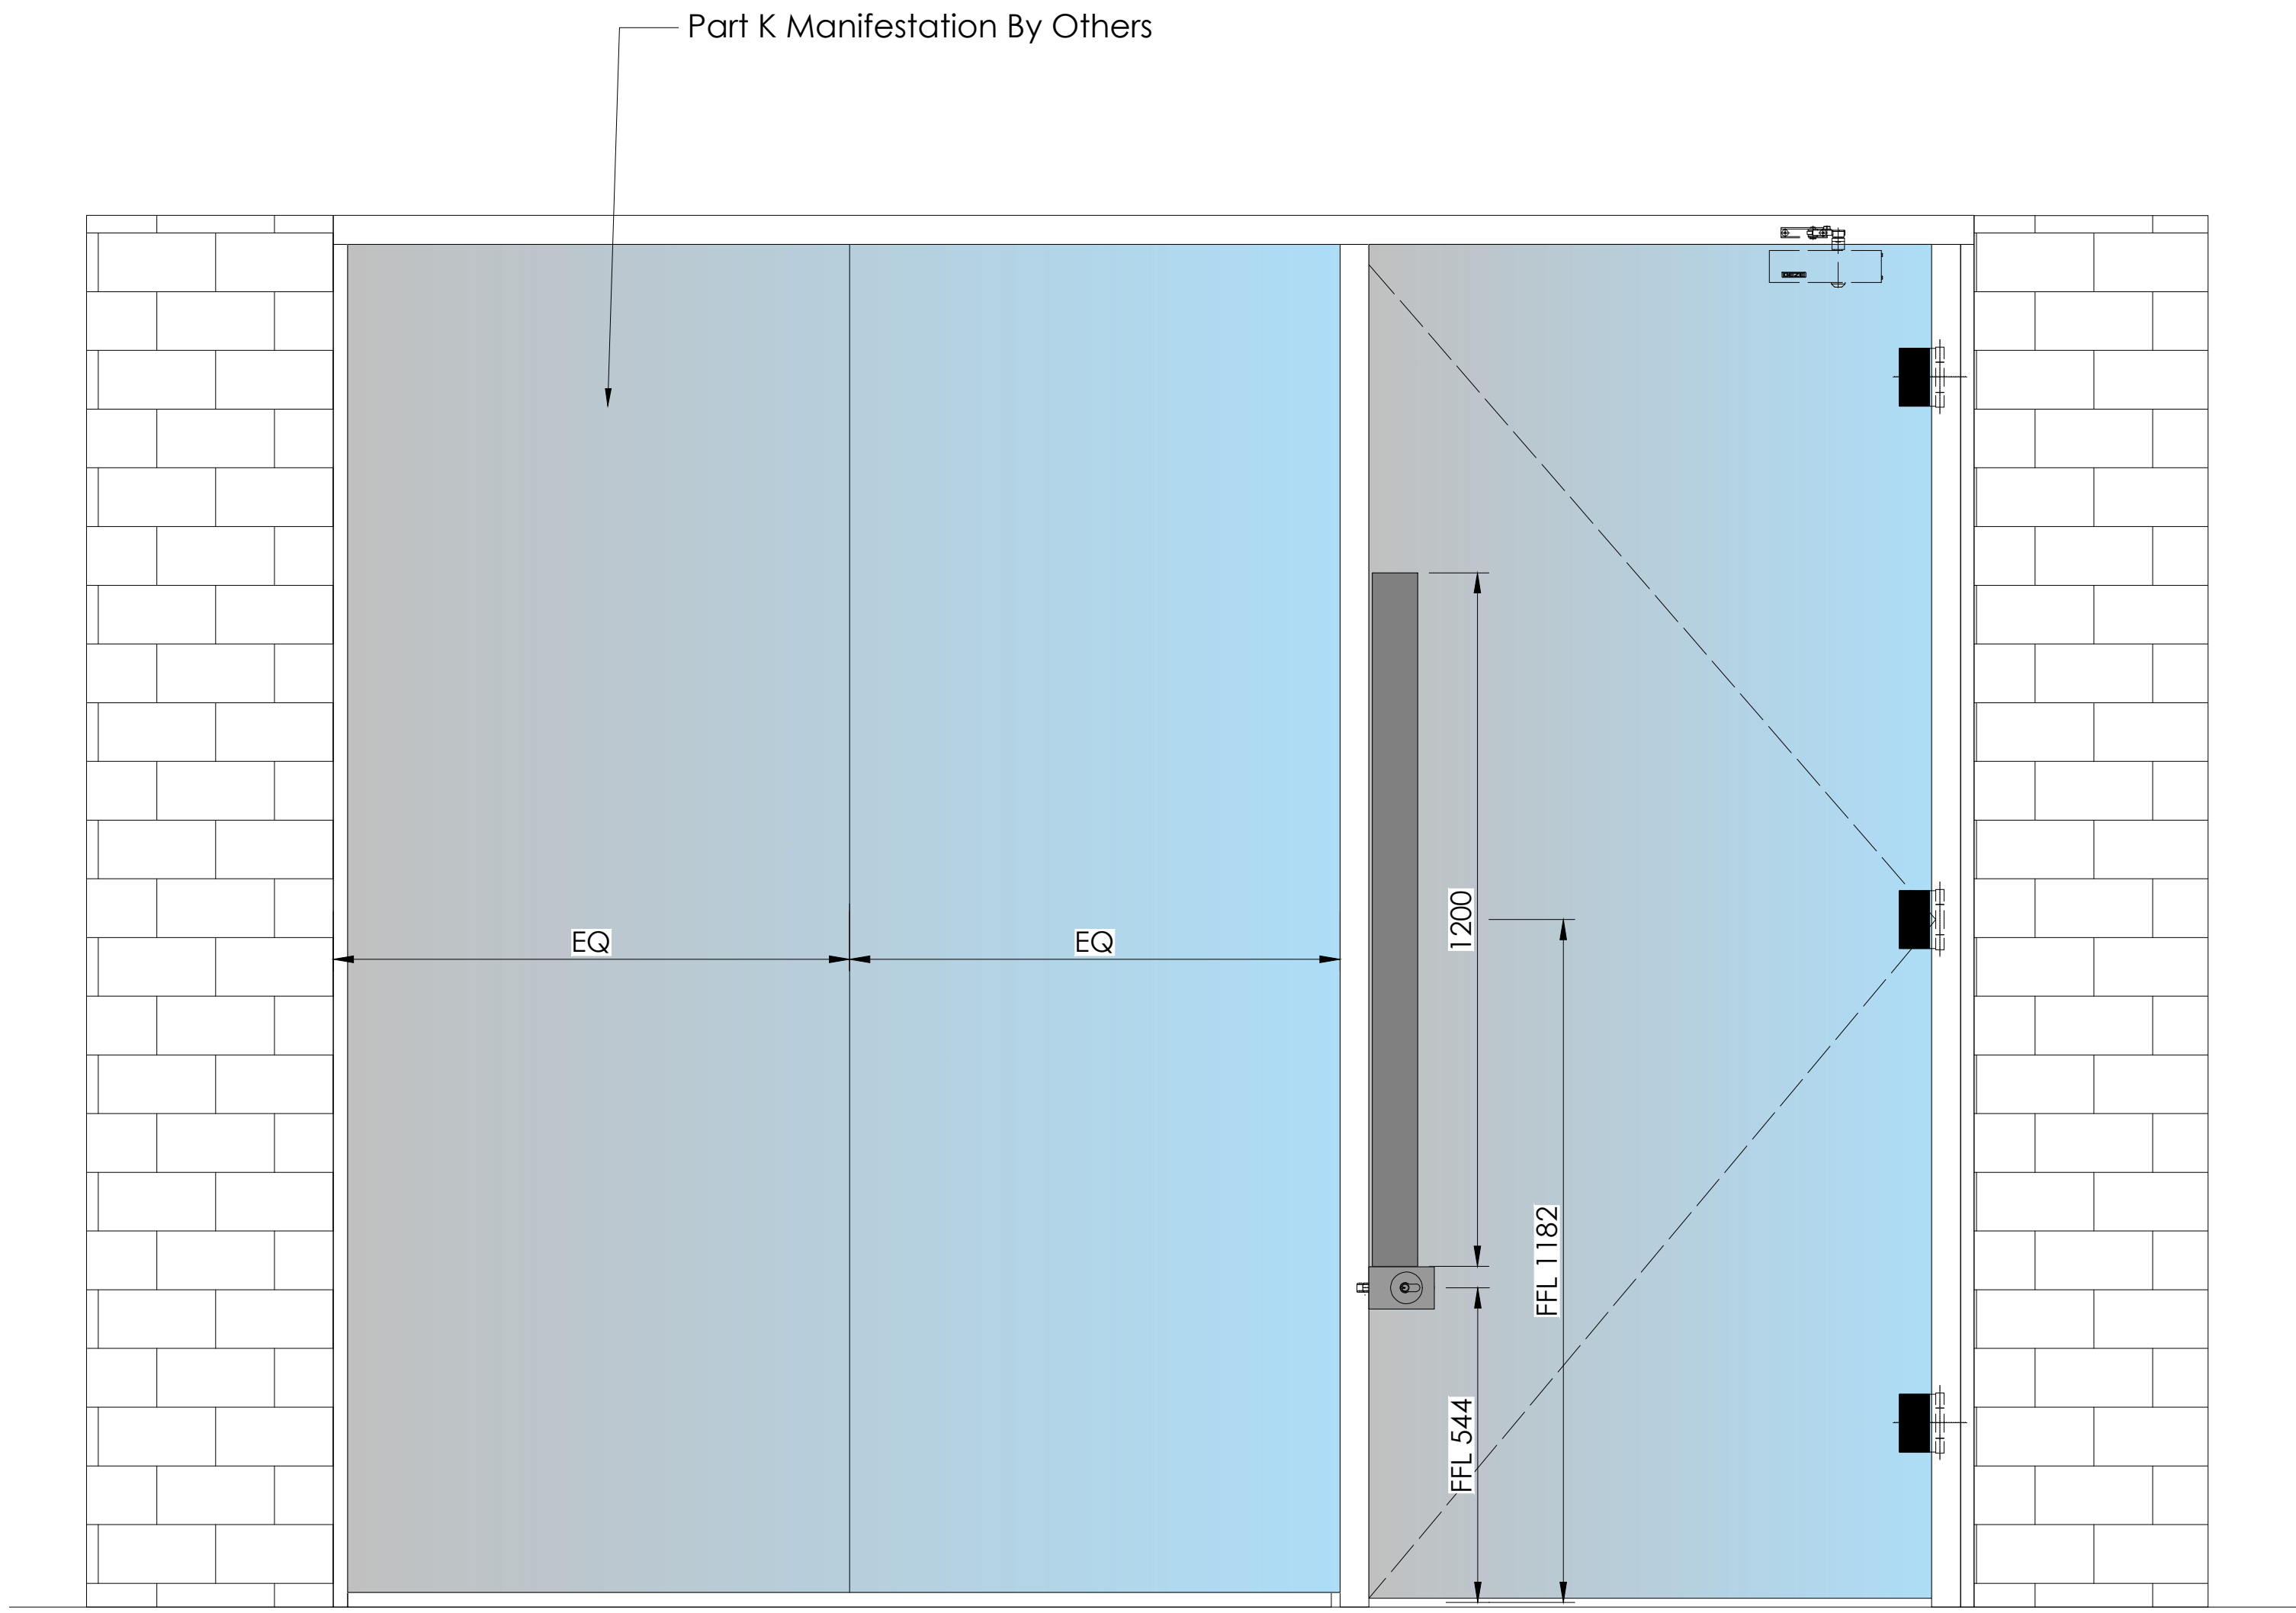

3 Elevation: Screen 13 117+ - Axile Clarity Door Scale 1:10

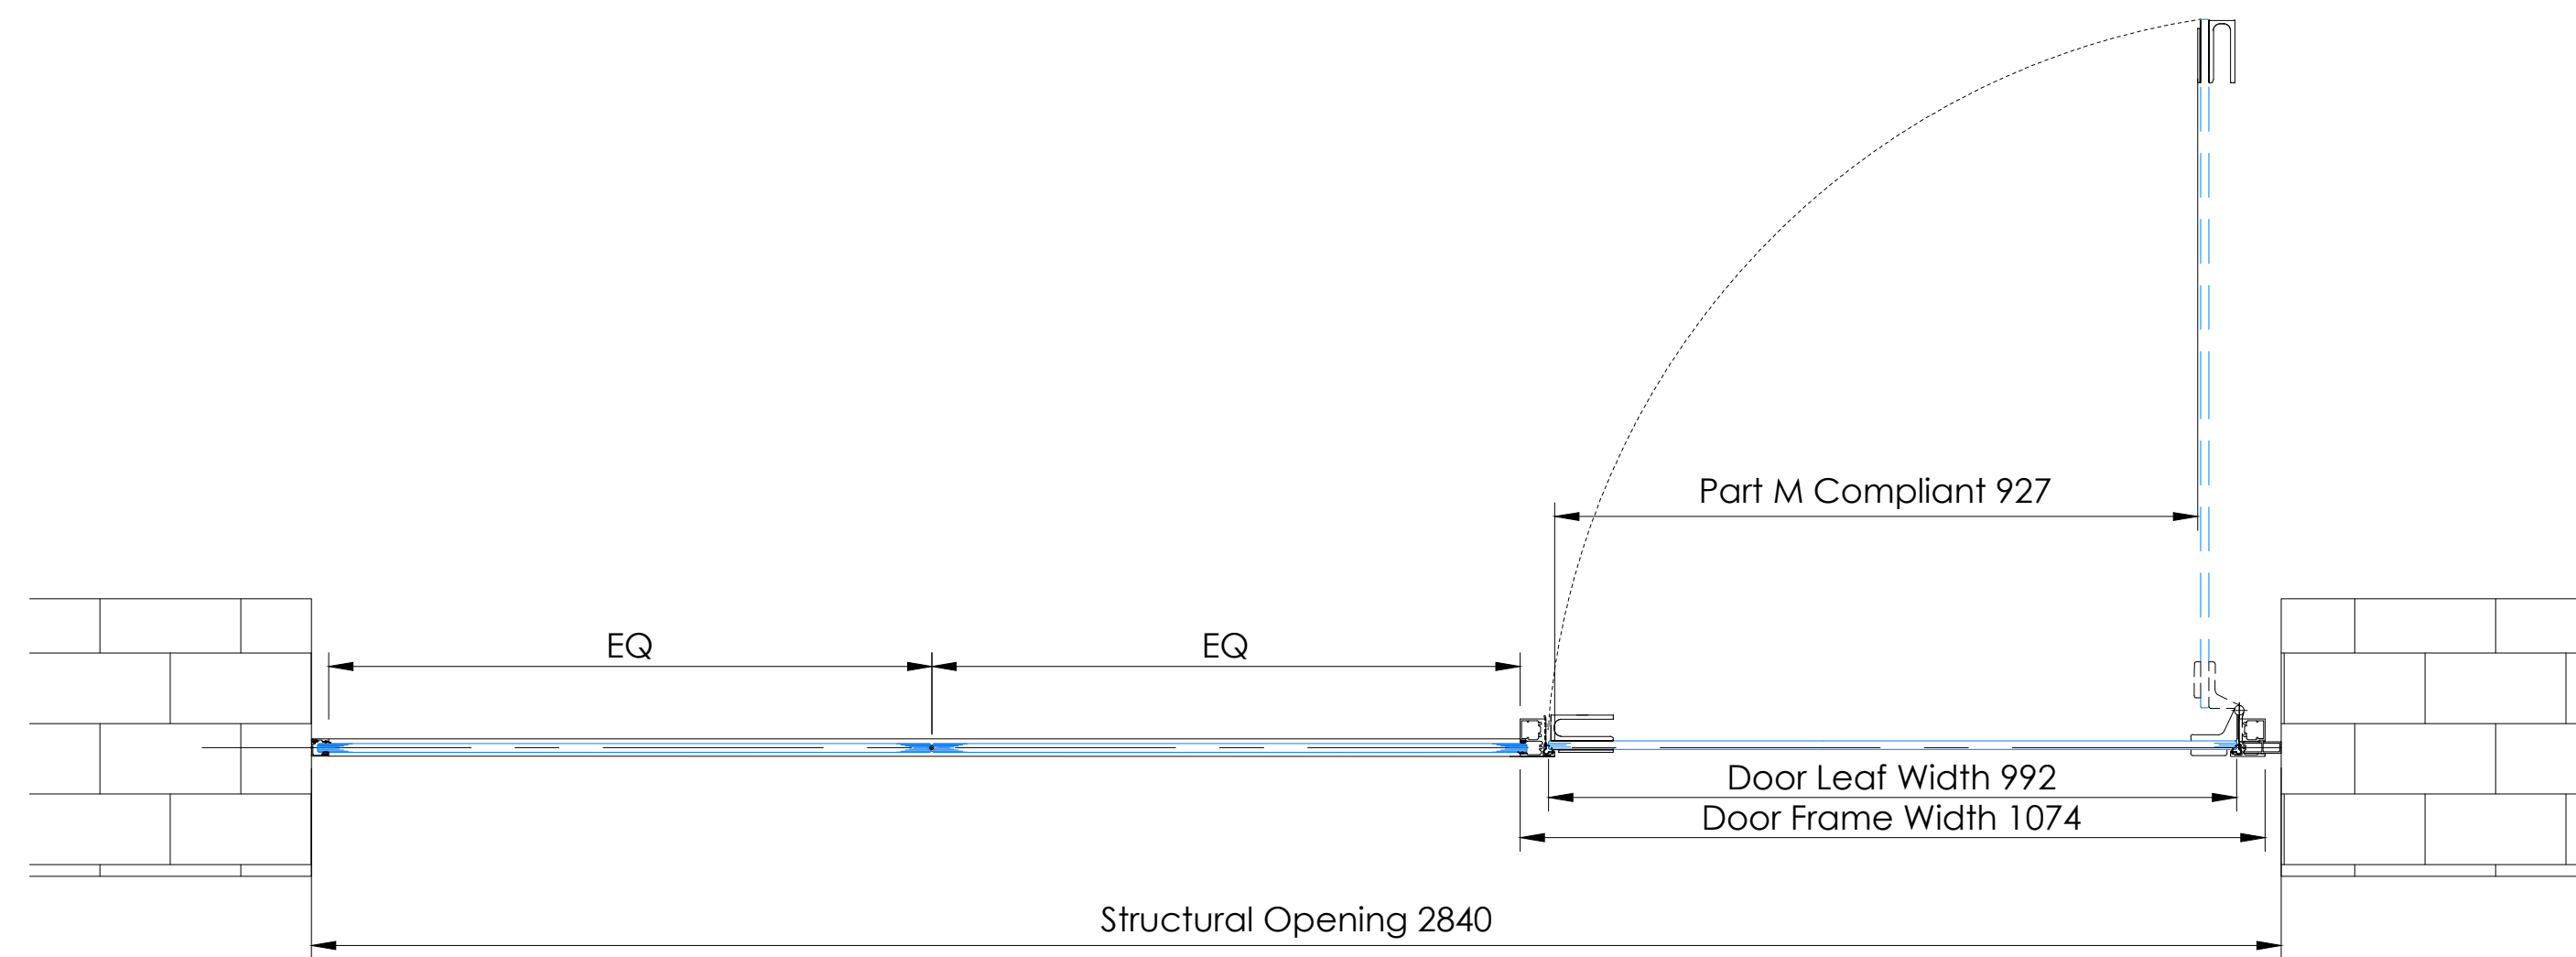

4 PLAN: Screen 13 117+ - Axile Clarity Door Scale 1:10

Safety Health & Environmental Information Box	
Construction Risks	This project uses any materials that have been used in this manner before. From a Designer viewpoint Optima do not envisage any specific Construction issues to communicate.
Maintenance / Cleaning Risks	Optima in the main provide office partitioning, the components (specifically the glass) are tested to the relevant standard of international standards of the glass. As such CLEANING and MAINTENANCE of this product is not a specific risk. However, Optima do not point out that all persons involved with maintenance and cleaning should themselves be subject to their own employer specific risk assessment practices. Special care should be taken if working at height. In such cases the regulations of the day apply. Optima do not recommend any loadings against its products.
Demolition / Adaptation Risks	From the viewpoint of a Designer, Optima have identified no significant risk for demolition and adaptation. However, the actual risk assessments are presented as implemented by the company proposing demolition and/or adaptation.
Environmental / Recycling	Much of the Optima range of product is recyclable, cable. See original terms and conditions for clarification. Environmental issues are subject to the law of the day.
In addition to the hazards & risks normally associated with the types of work detailed on this drawing take note of the above. It is assumed that all work on this drawing will be carried out by competent contractors meeting where applicable, to an approved method statement.	

General Information Table 1013	
Door/Partition	
Door/Partition Type	117+ - Screen 13/ Axile Clarity Door
Floors	2
Acoustic Rating	Screen: Rw38dB/ Door: N/A
Ironmongery Set	Shoreditch Pull Handles/ Door Closer/ Dorma Manef Lock/ patch fittings RAL 9005
Door Finish	N/A
Frame Finish	RAL 9005
Deflection	N/A
Glass	12mm thick heat soaked toughened/ 12.8 Acoustic laminated Glass

Structural Openings To Be Checked On Site

31/03/20 Rev: Rev00 AS BUILT					
AB	31.03.20	As Built	CC	CT	GM
Rev	Date	Description	Dr	App	Ck
Status:					
As Built					
Optima © Optima Products Ltd. OPTIMA CONTRACTING LIMITED COURTYARD HOUSE WEST END ROAD HIGH WYCOMBE BUCKINGHAMSHIRE HP11 2QB Tel: +44 (0) 1494 492600 Web: www.optimasytems.com					
PART OF THE OPTIMA GROUP					
Project:					
50195 Bonded Warehouse L2					
Title:					
117+					
Screen 13 With Axile Clarity Door					
Scale @ A0:		Drawing No.:		Revision:	
VARIES		OPT-DRG-1013		AB	