


Door Type C1 : FOH General Door


GENERAL NOTE

To be read in conjunction with Schedule of Works, Door Schedule and GA plans.


3D.07

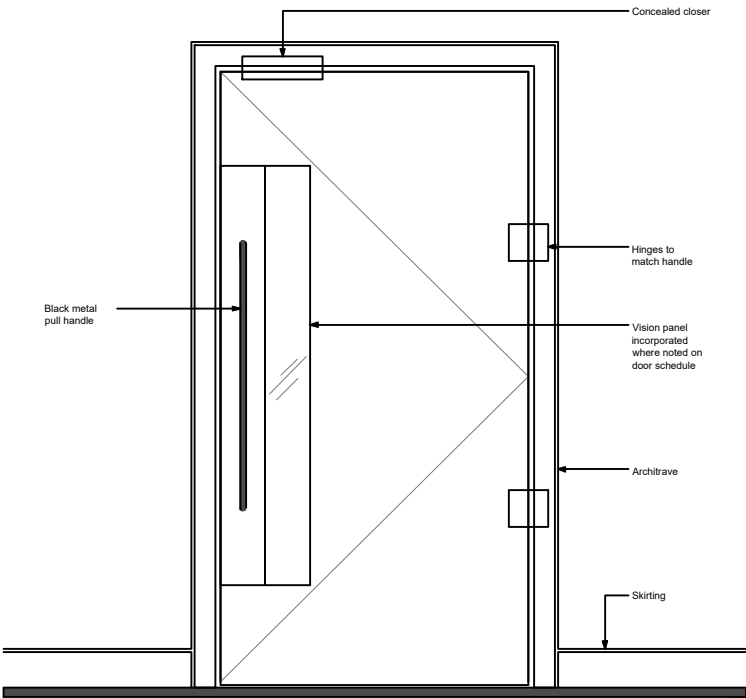


Type C1 : Front Elevation, Single Arrangement

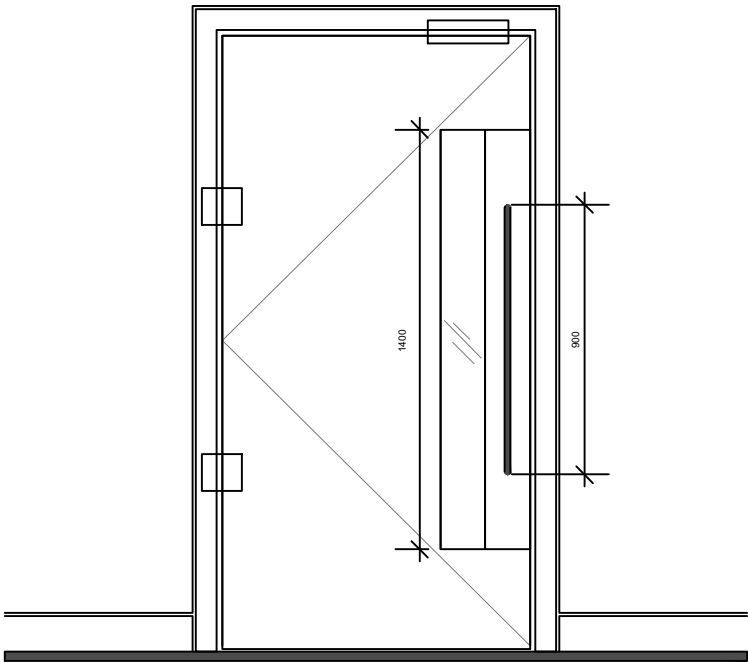

Type C1 : Rear Elevation, Single Arrangement

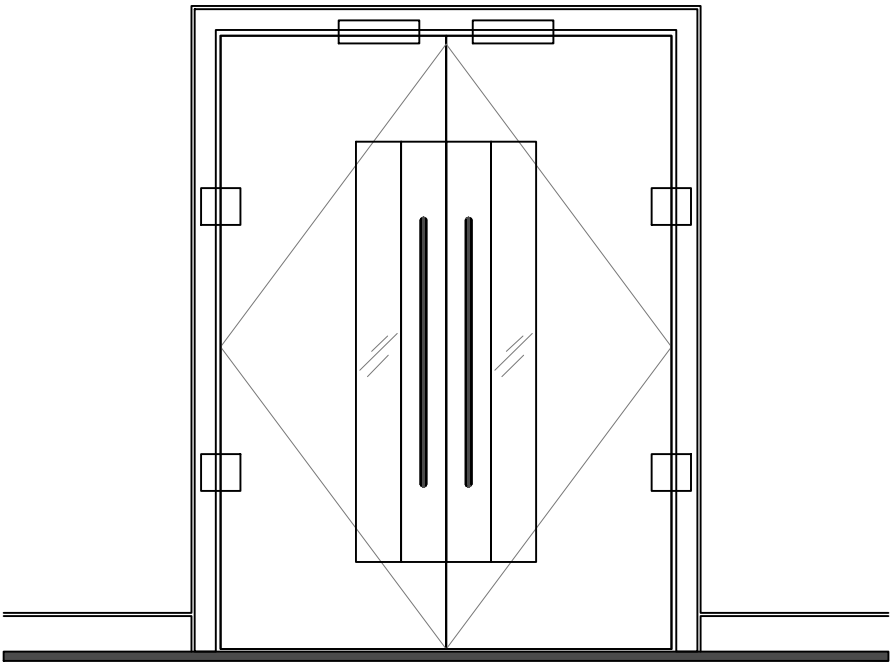


Type C1 : Front Elevation, Double Arrangement

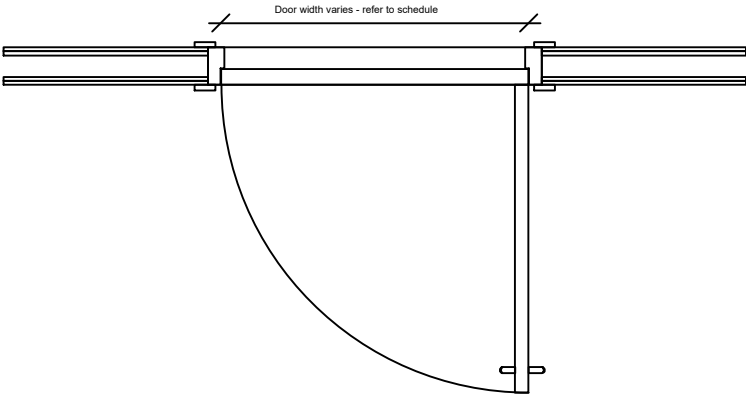

Type C1 : Plan, Single Arrangement

Door Type C1 : FOH General Door
Lacquered Faced Timber Door

NOTES:
54mm thick solid core door.
Black metal ironmongery
Fire rating: 30mins
Fire door signs to be fixed to leading edge of doors

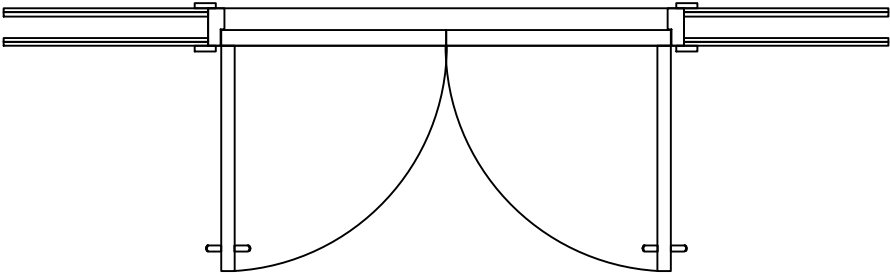

Type C1 : Plan, Double Arrangement

Notes:

Do not scale from this drawing. All dimensions to be checked on-site by contractor to ensure accuracy prior to any installation. All design work produced by Amspec Ltd is for indicative purposes only. It is the client and contractors responsibility to ensure that building control and fire officer approval have been met prior to commencement of site work

REV:	DESCRIPTION:	BY:	DATE:
STATUS: AS BUILT			
amspec DESIGN & BUILD SOLUTIONS f : 01942 621342 f : 01942 226552 www.amspec.co.uk			
CLIENT: OBI 80 MOSELY STREET MANCHESTER M2 3FX			
ARCHITECT:			
SITE: 18 LOWER BYROM STREET MANCHESTER			
TITLE: LEVEL 3 DOOR TYPE C1			
SCALE AT A3: 1:25	DATE: 28.06.19	DRAWN: CR	CHECKED: IC
PROJECT NO: 1683	DRAWING NO: DP_DT-01	REVISION:	