


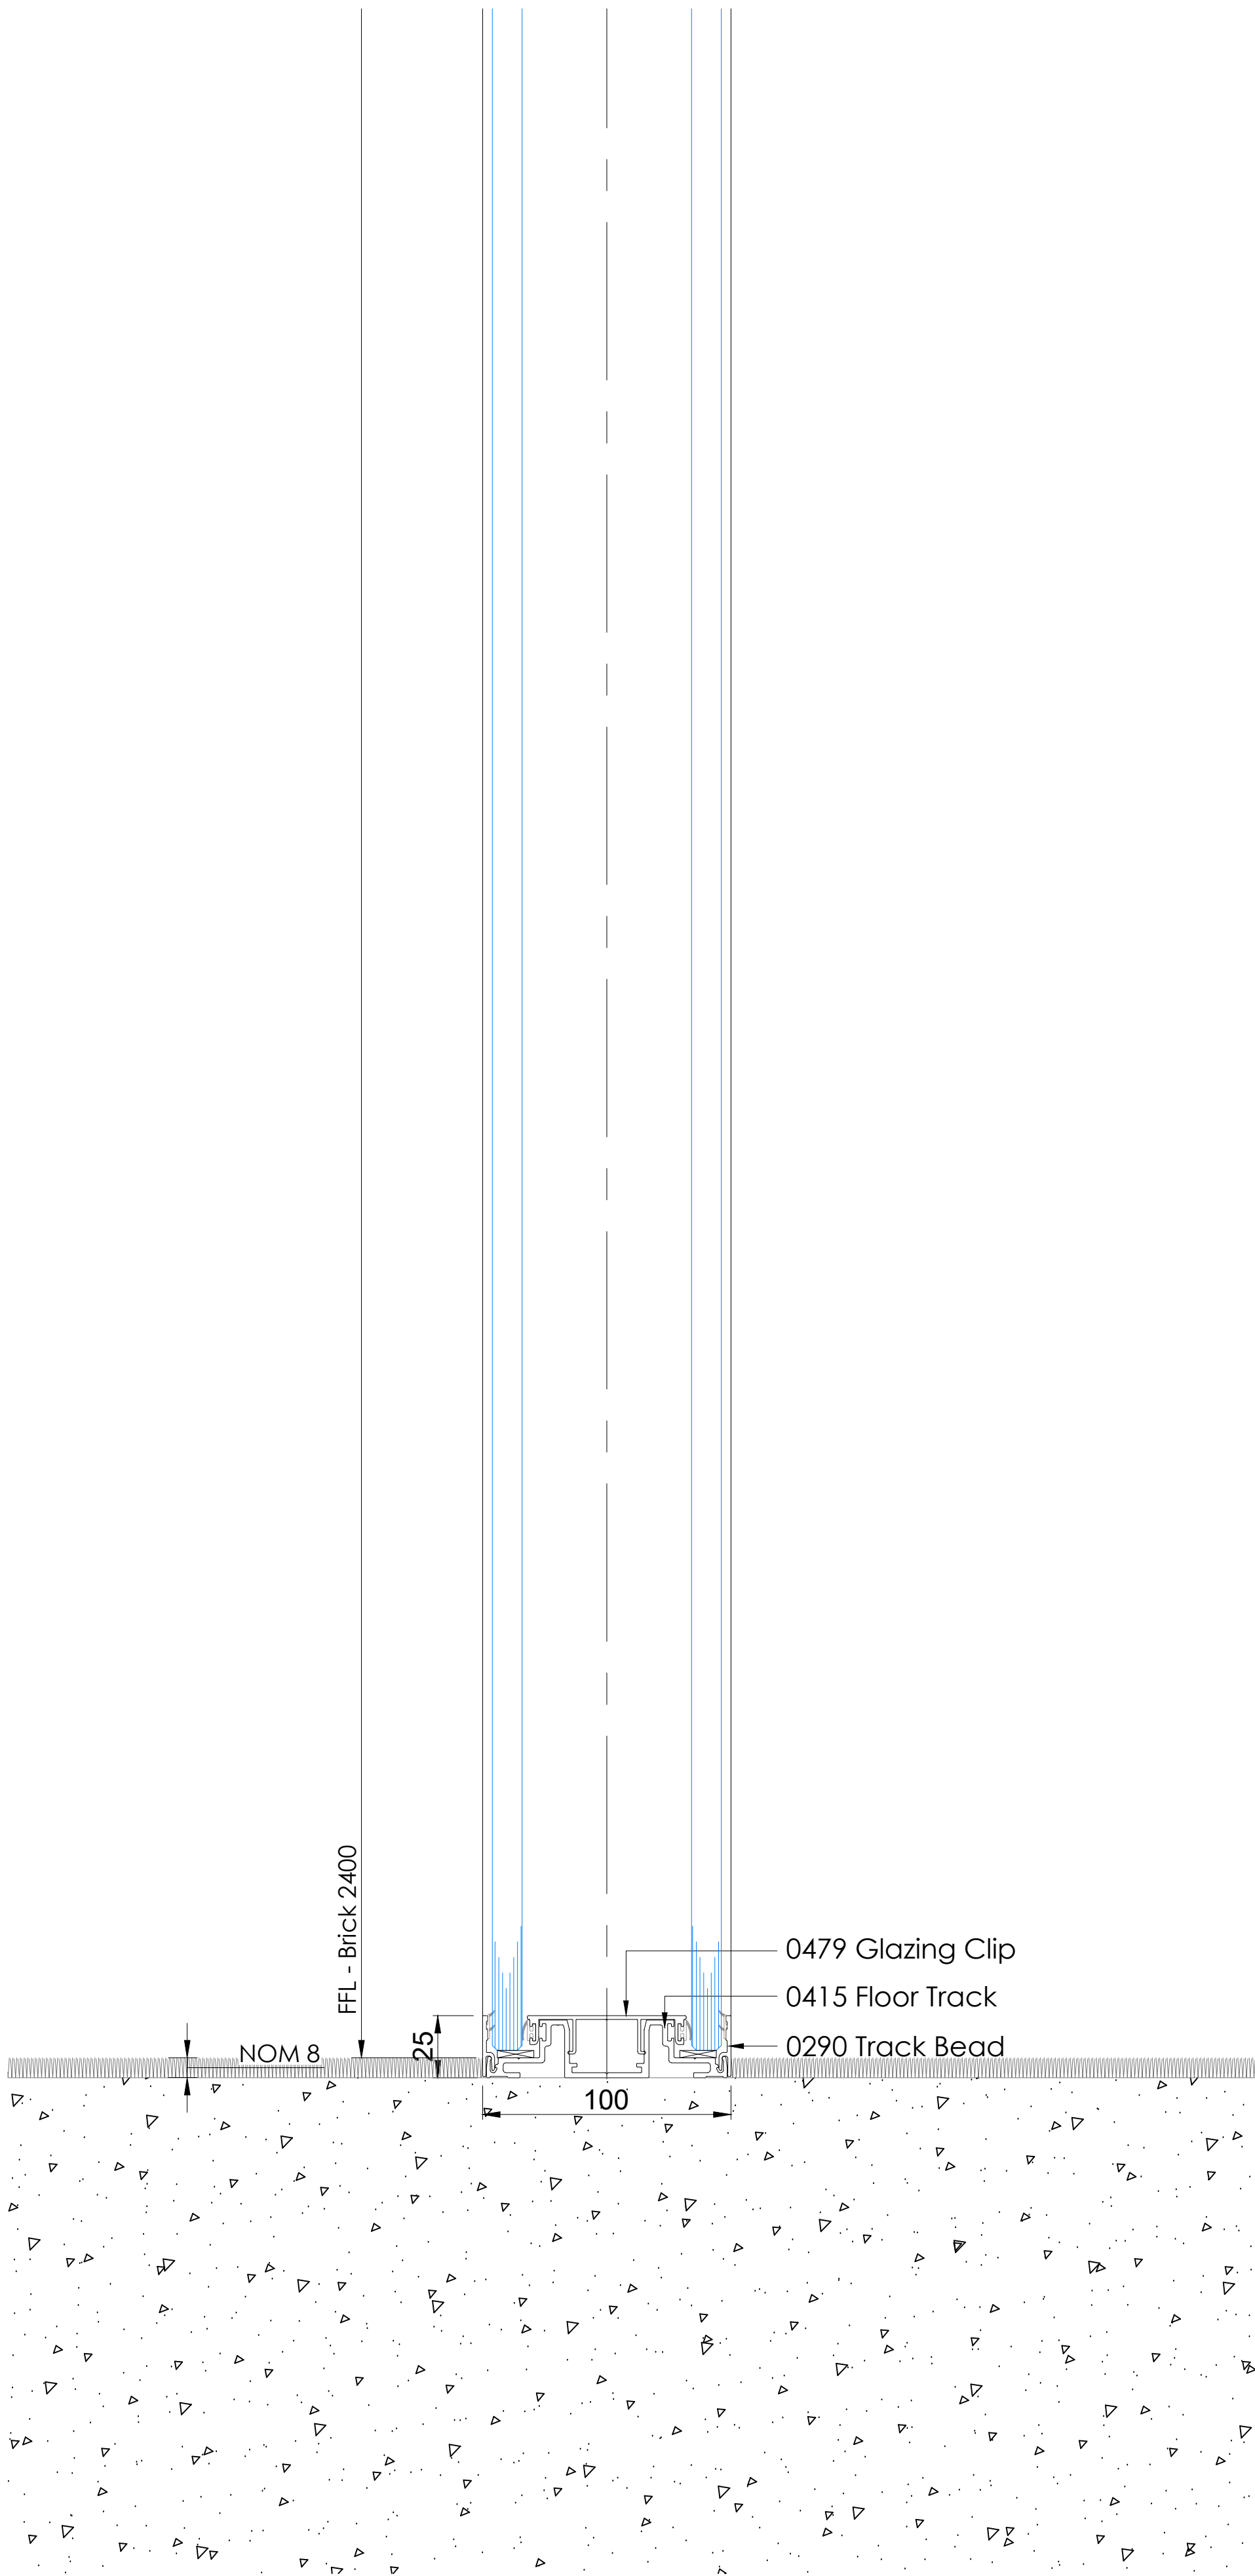


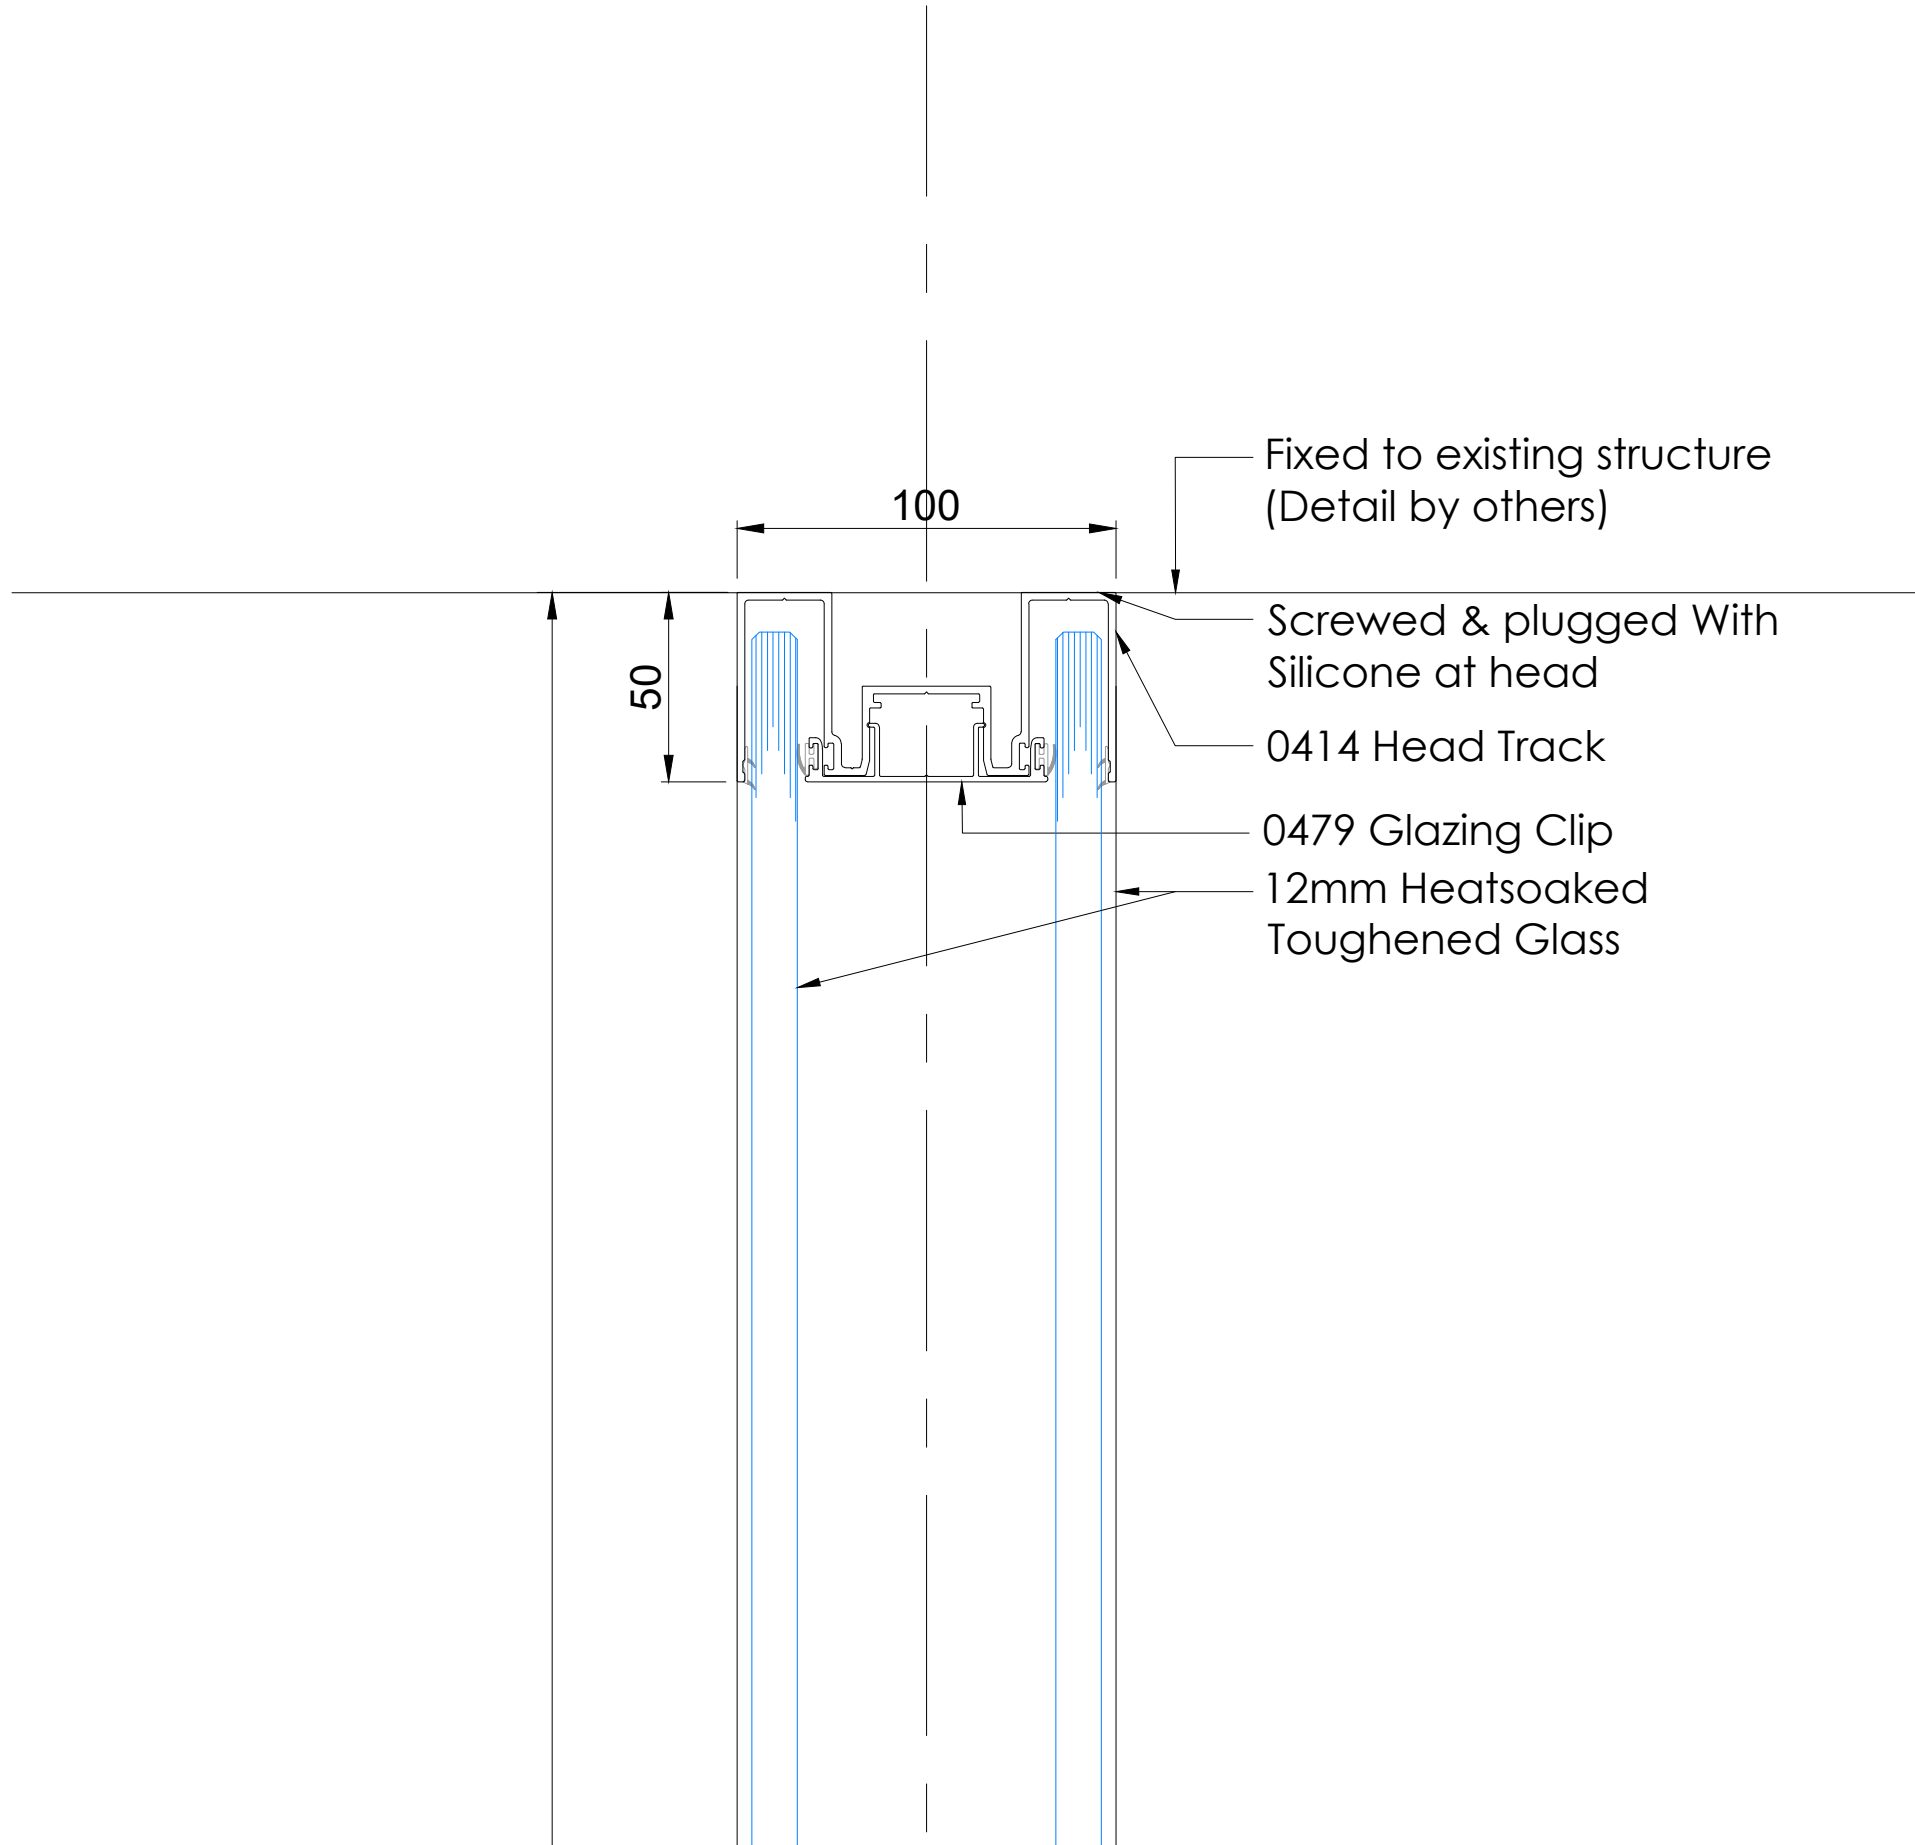


1 SECTION: Screen 5
Revolution 100
Scale 1:2

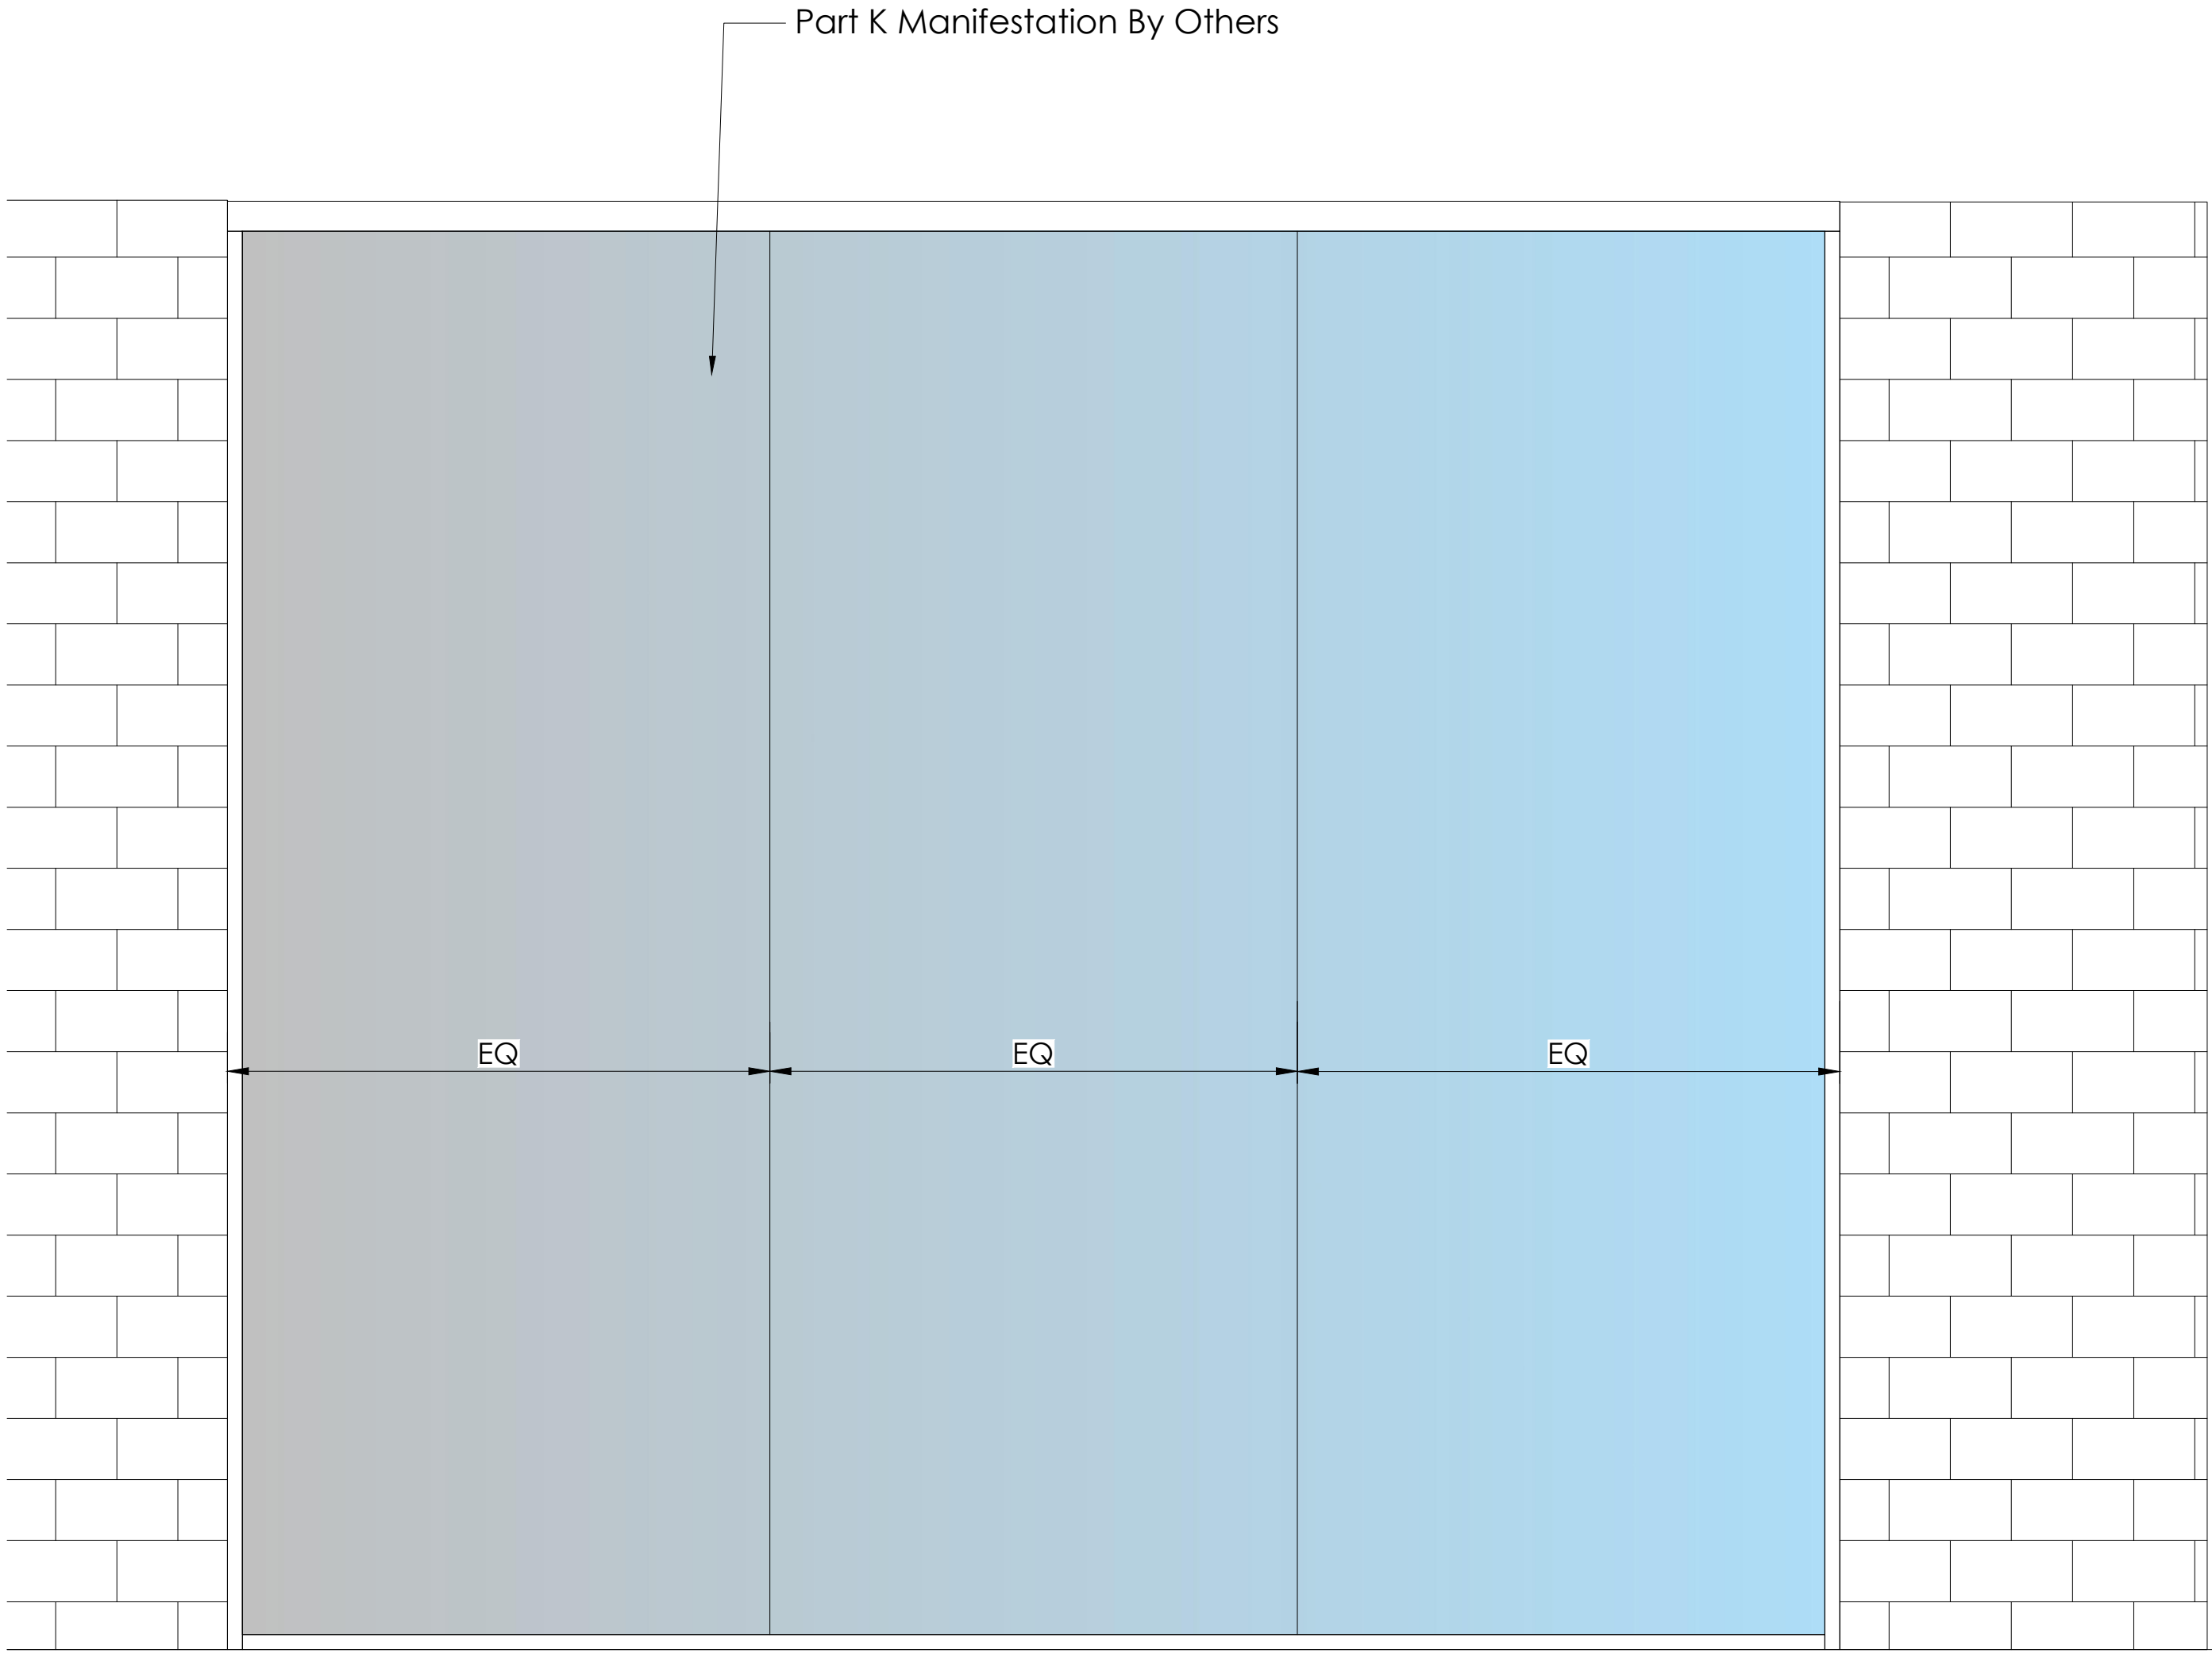


2 Elevation: Screen 5
Revolution 100
Scale 1:10

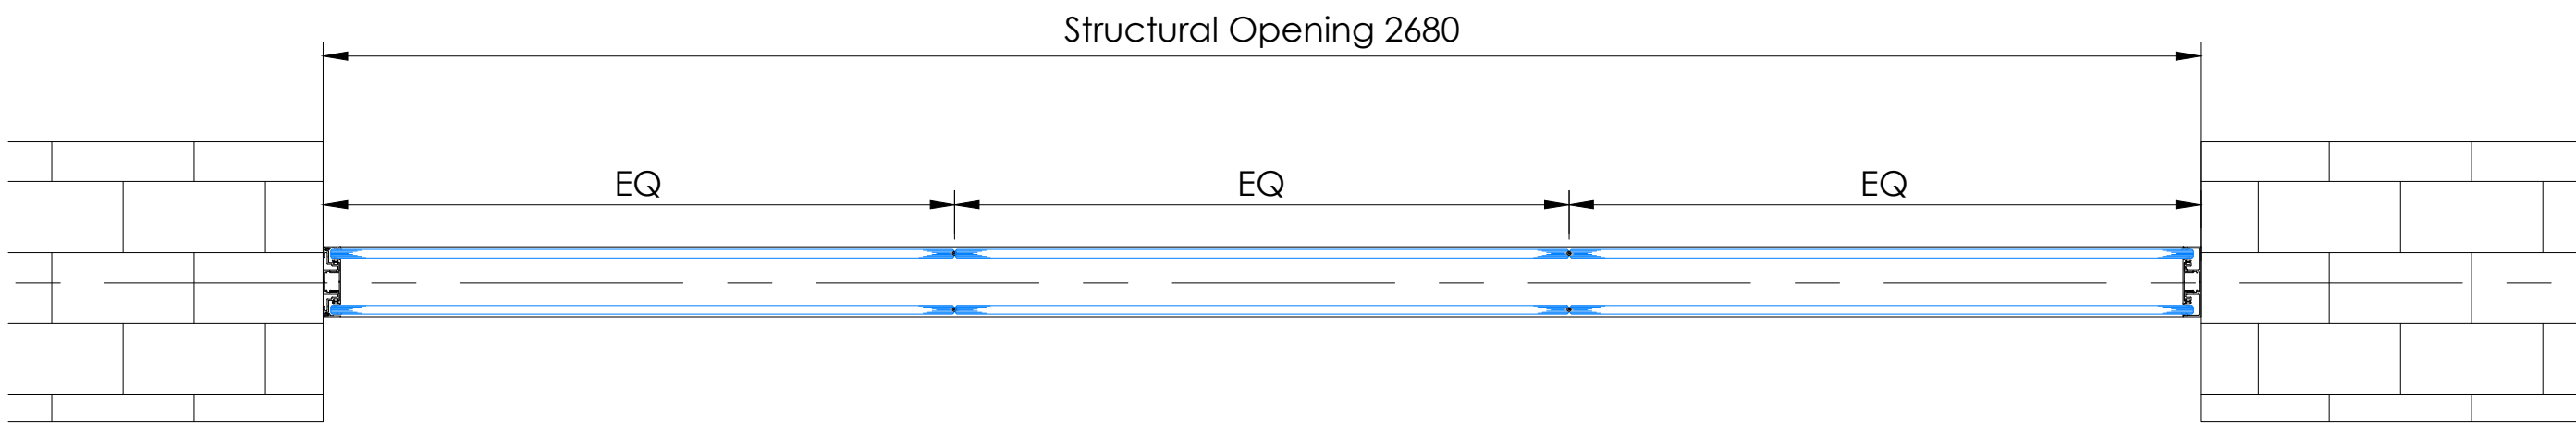


3 PLAN: Screen 5
Revolution 100
Scale 1:10

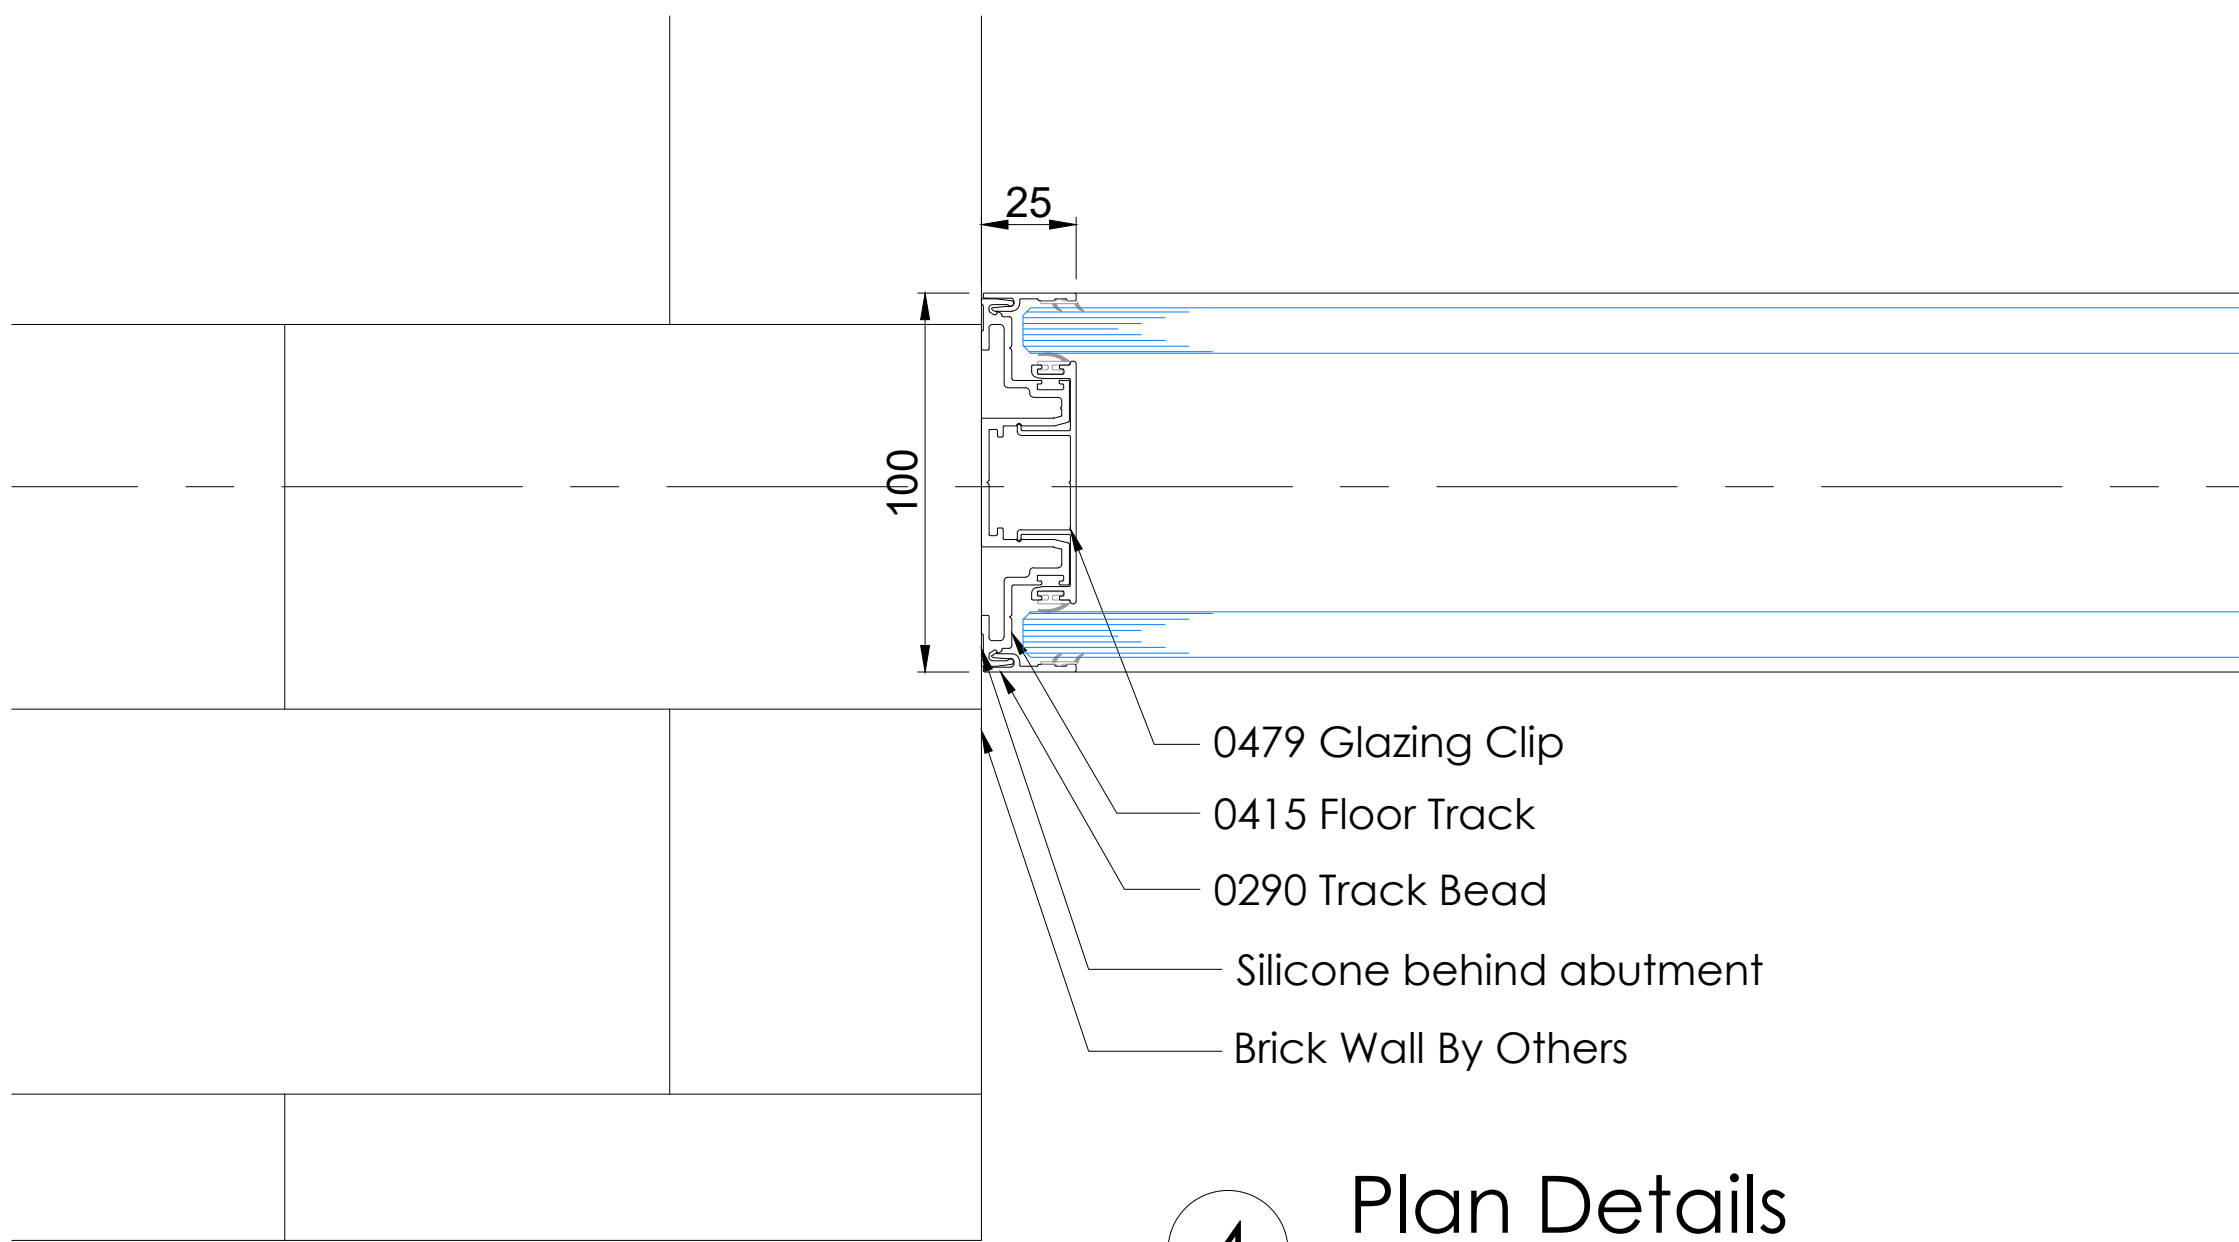

4 Plan Details
Wall Abutment
Scale 1:2

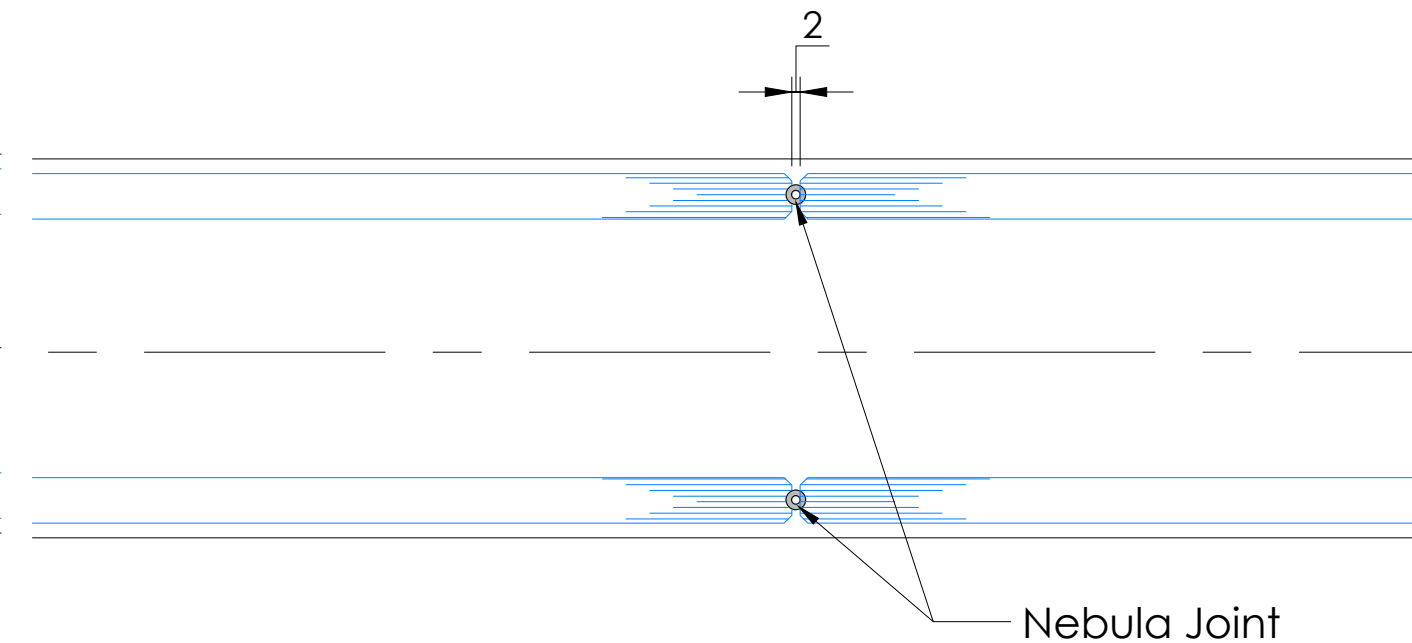

5 Plan Details
Nebula
Scale 1:2

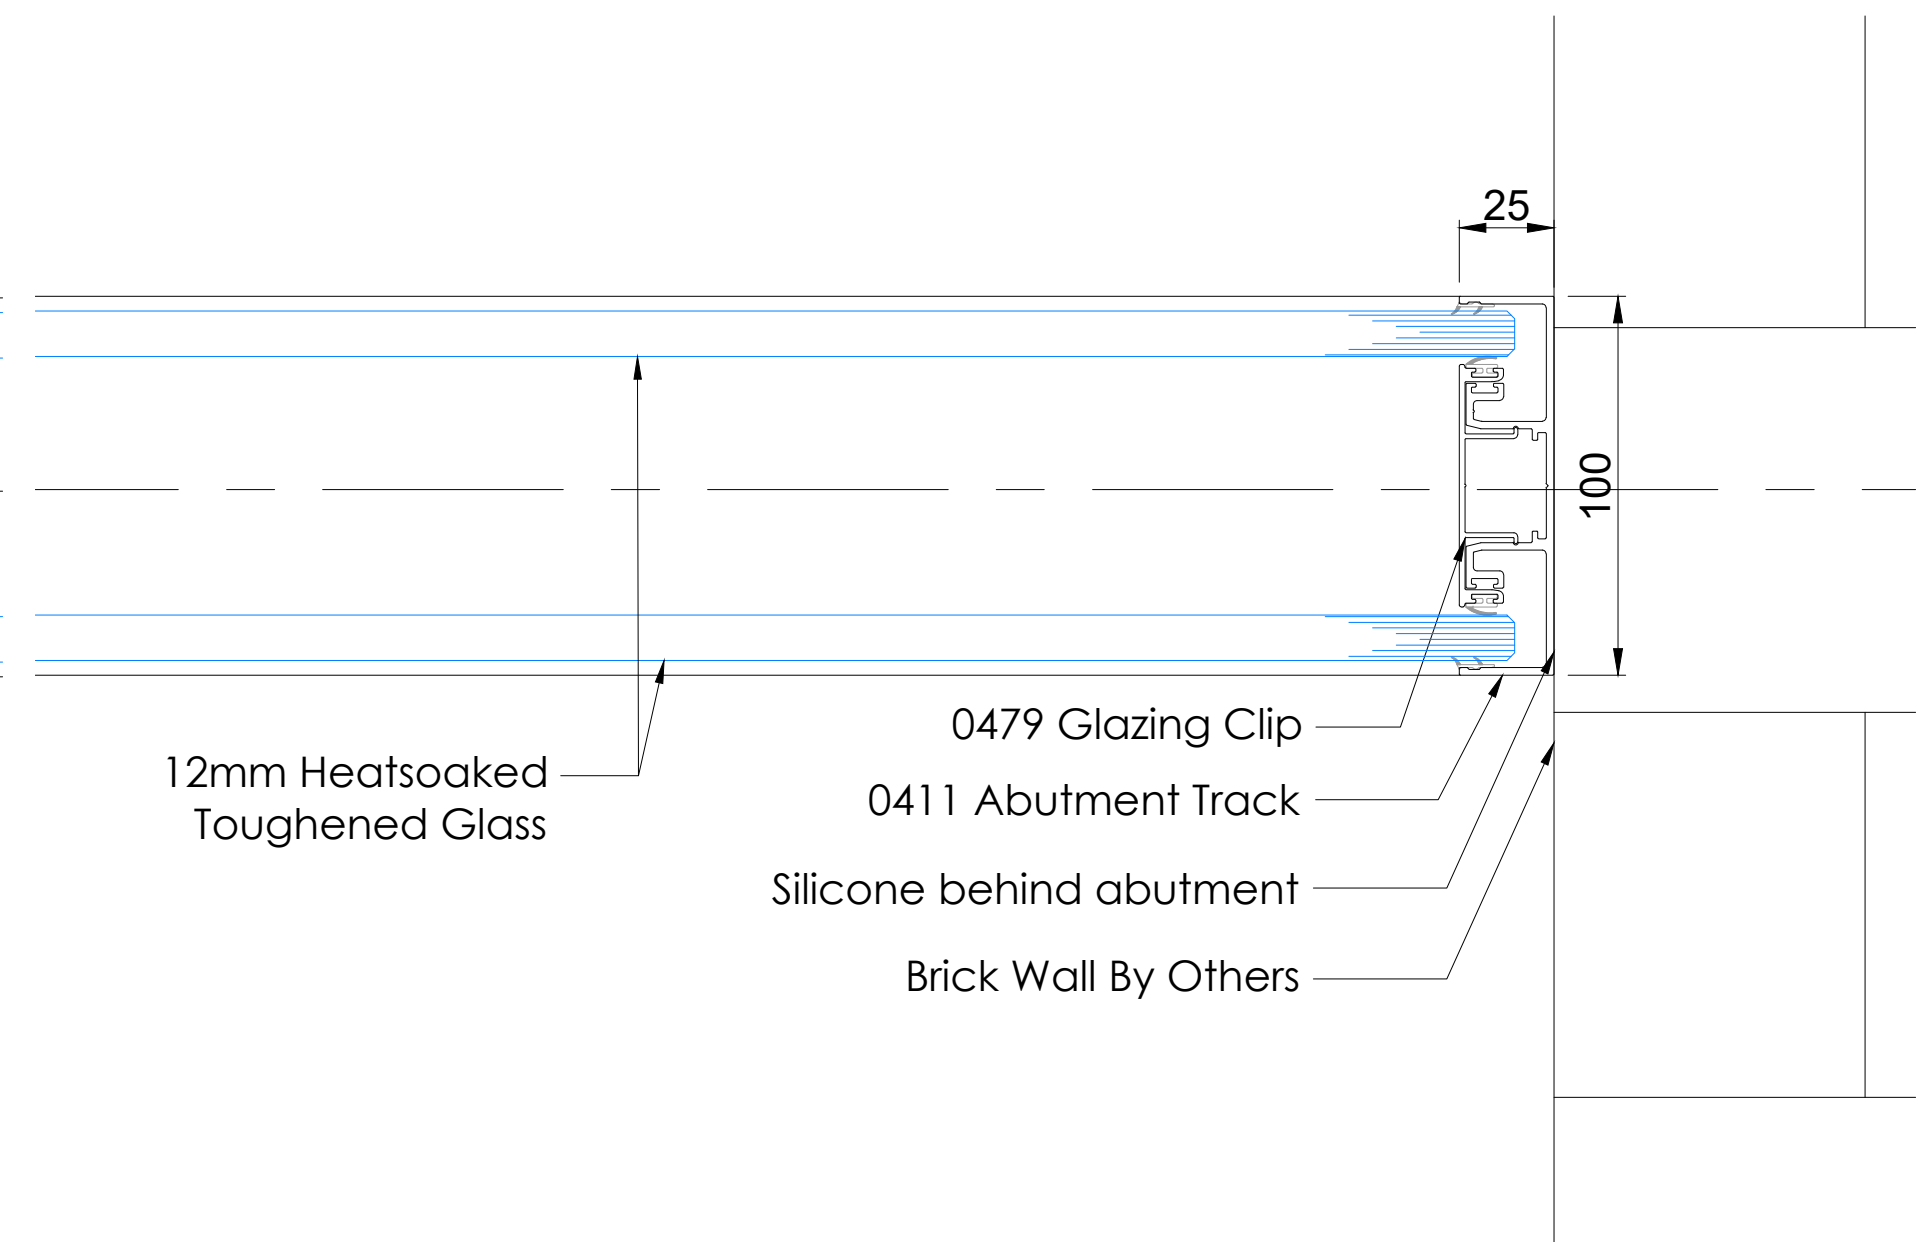

Safety Health & Environmental Information Box
Construction Risks This project uses only materials that have been used in the region before. From a Designer viewpoint, Optima do not envisage any specific Construction Issues to communicate.
Maintenance / Cleaning Risks Optima, in the main, provide office partitioning, the components (specifically the glass) are tested to the relevant standard or international standard of the day. As such CLEANING and MAINTENANCE of this project should be no specific risk. However, Optima would point out that all persons involved with maintenance and cleaning should themselves be subject to their own employer's specific risk assessment process. Specific care should be taken of height. In such cases the regulations of the day apply. Optima do not recommend any loadings against its products.
Demolition / Adaptation Risks From the viewpoint of a Designer, Optima have identified no significant risks for demolition and adaptation. However, the usual risk assessments are presented as implemented by the company proposing demolition and/or adaptation.
Environmental / Recycling Much of the Optima range of product is recyclable, cable. See original terms and conditions for clarification. Environmental issues are subject to the law of the day.
In addition to the hazards / risks normally associated with the types of work detailed on this drawing take note of the above. It is assumed that all work on this drawing will be carried out by competent contractors meeting relevant standards. It is not intended to be a design document.

General Information Table 1006	
Door/Partition	
Door/Partition Type	Revolution 100 - Screen 5
Floors	2
Acoustic Rating	Screen: Rw45dB
Ironmongery Set	N/A
Door Finish	N/A
Frame Finish	RAL 9005
Deflection	N/A
Glass	X2 12mm thick heat soaked toughened

Structural Openings To Be Checked On Site

31/03/20
Rev: Rev 00
AS BUILT

AB	31.03.20	As Built	CC	CT	GM
Rev	Date	Description	Dr	App	Ck

Status:

As Built

Optima

© Optima Products Ltd.

OPTIMA CONTRACTING LIMITED
COURTYARD HOUSE
WEST END ROAD
HIGH WYCOMBE
BUCKINGHAMSHIRE
HP11 2QB

Tel: +44 (0) 1494 492600
Web: www.optimaystems.com

PART OF THE OPTIMA GROUP
Project:

50195 Bonded Warehouse L2

Title:

Revolution 100
Screen 5

Scale @ A0:	Drawing No.:	Revision:
VARIES	OPT-DRG-1006	AB