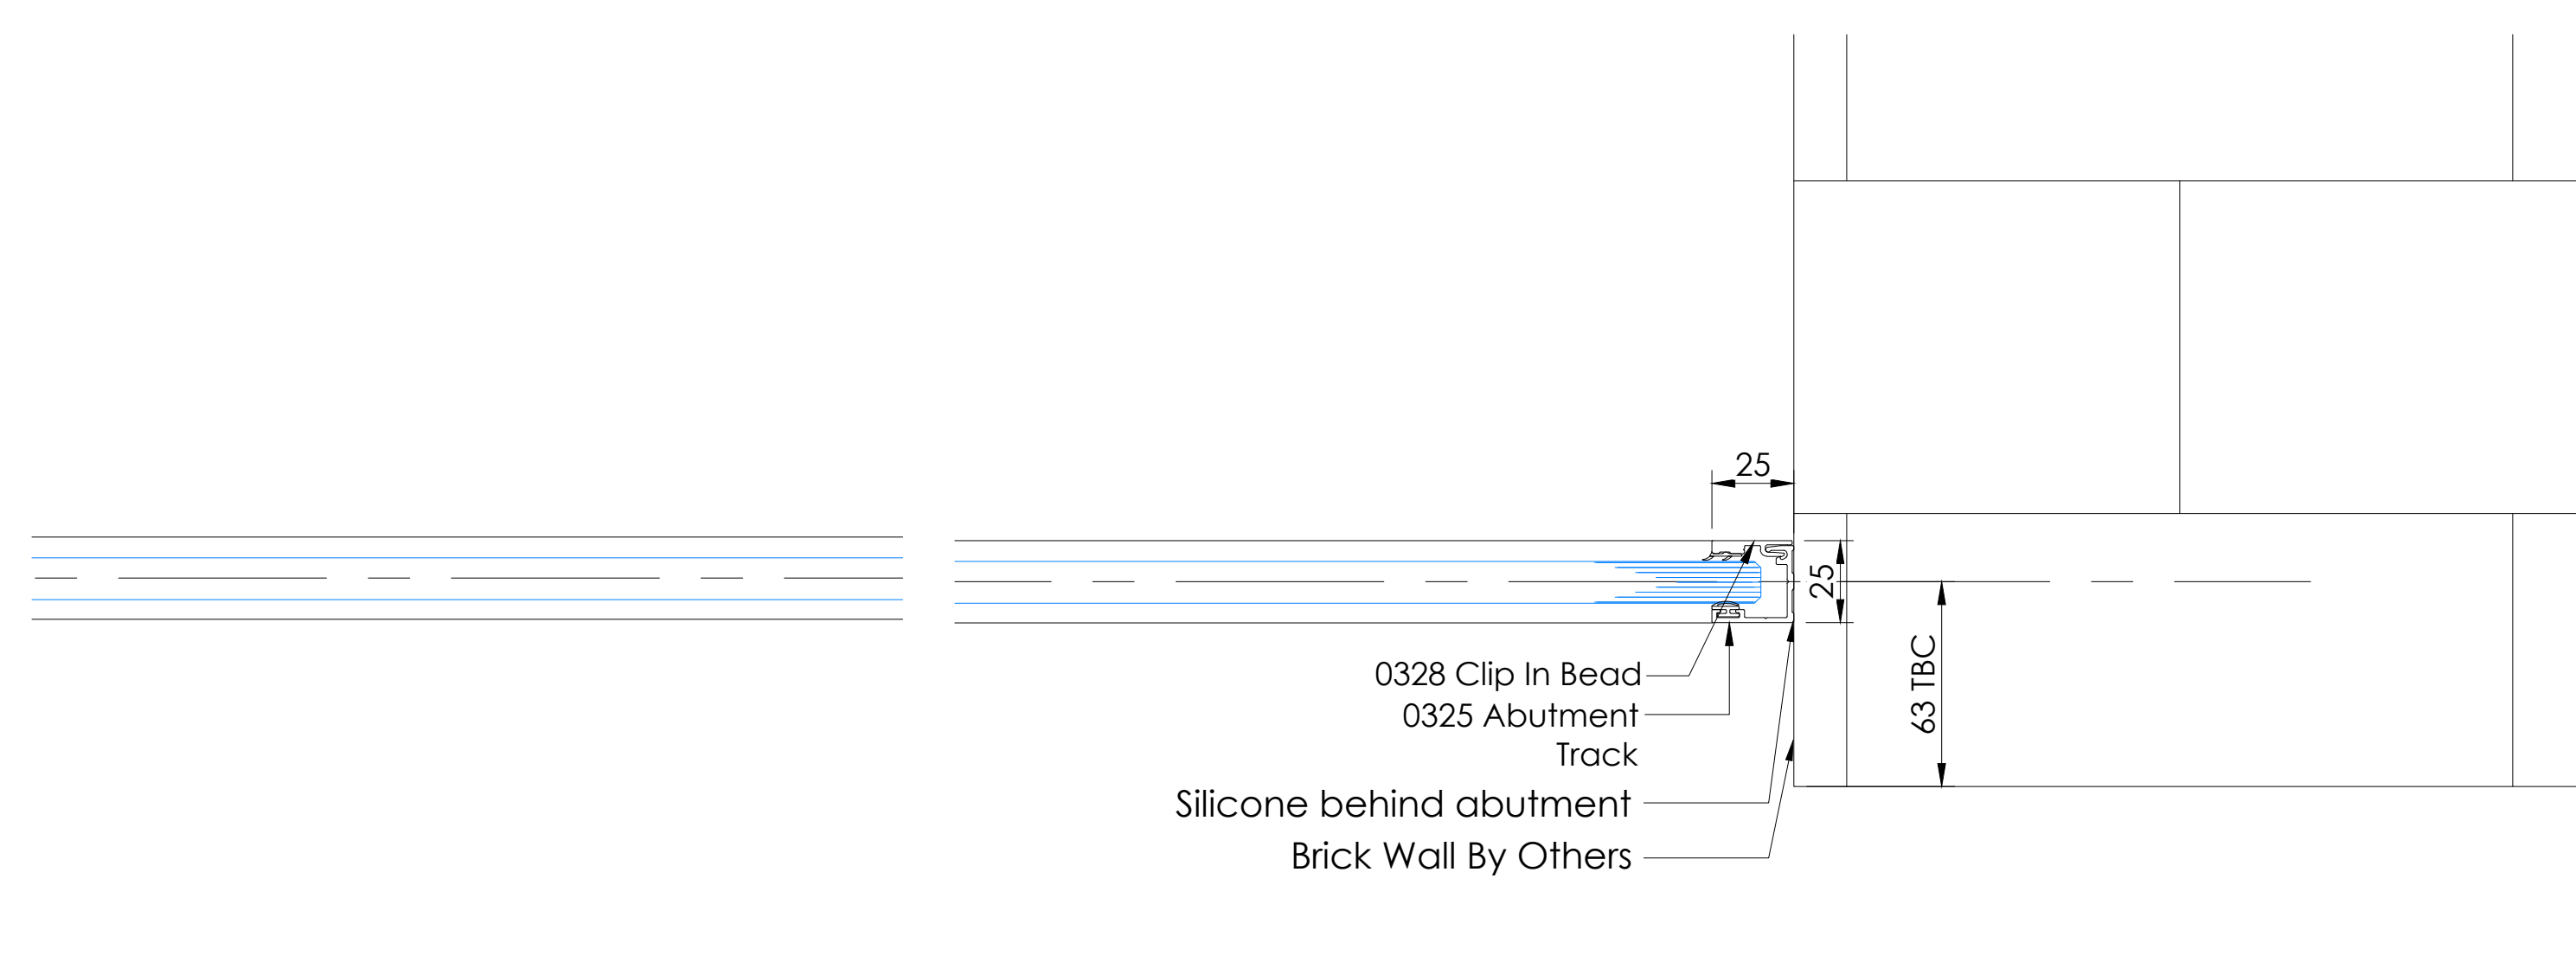
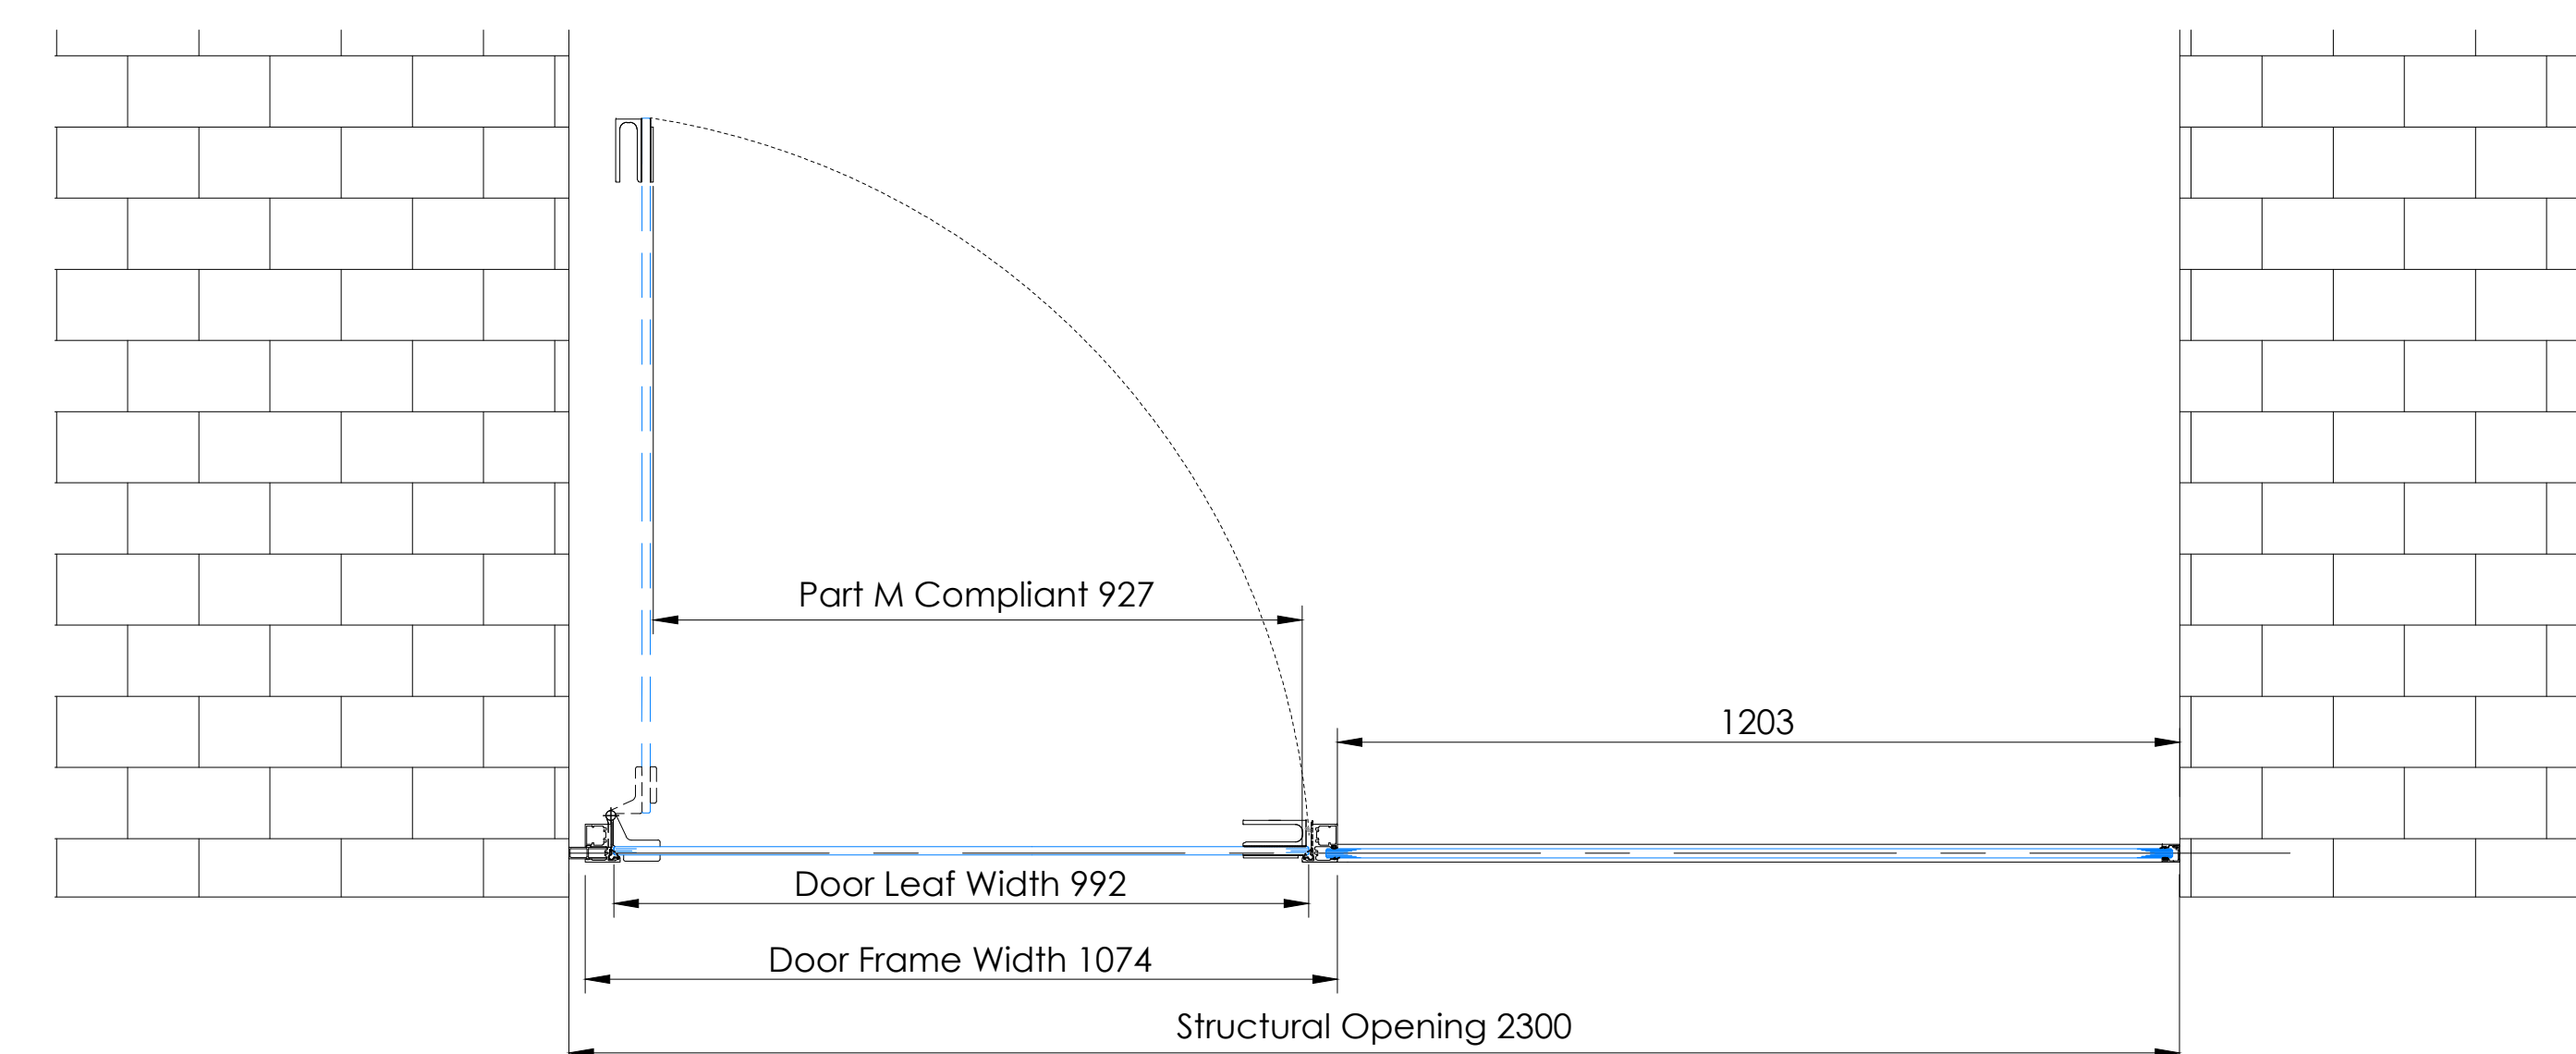
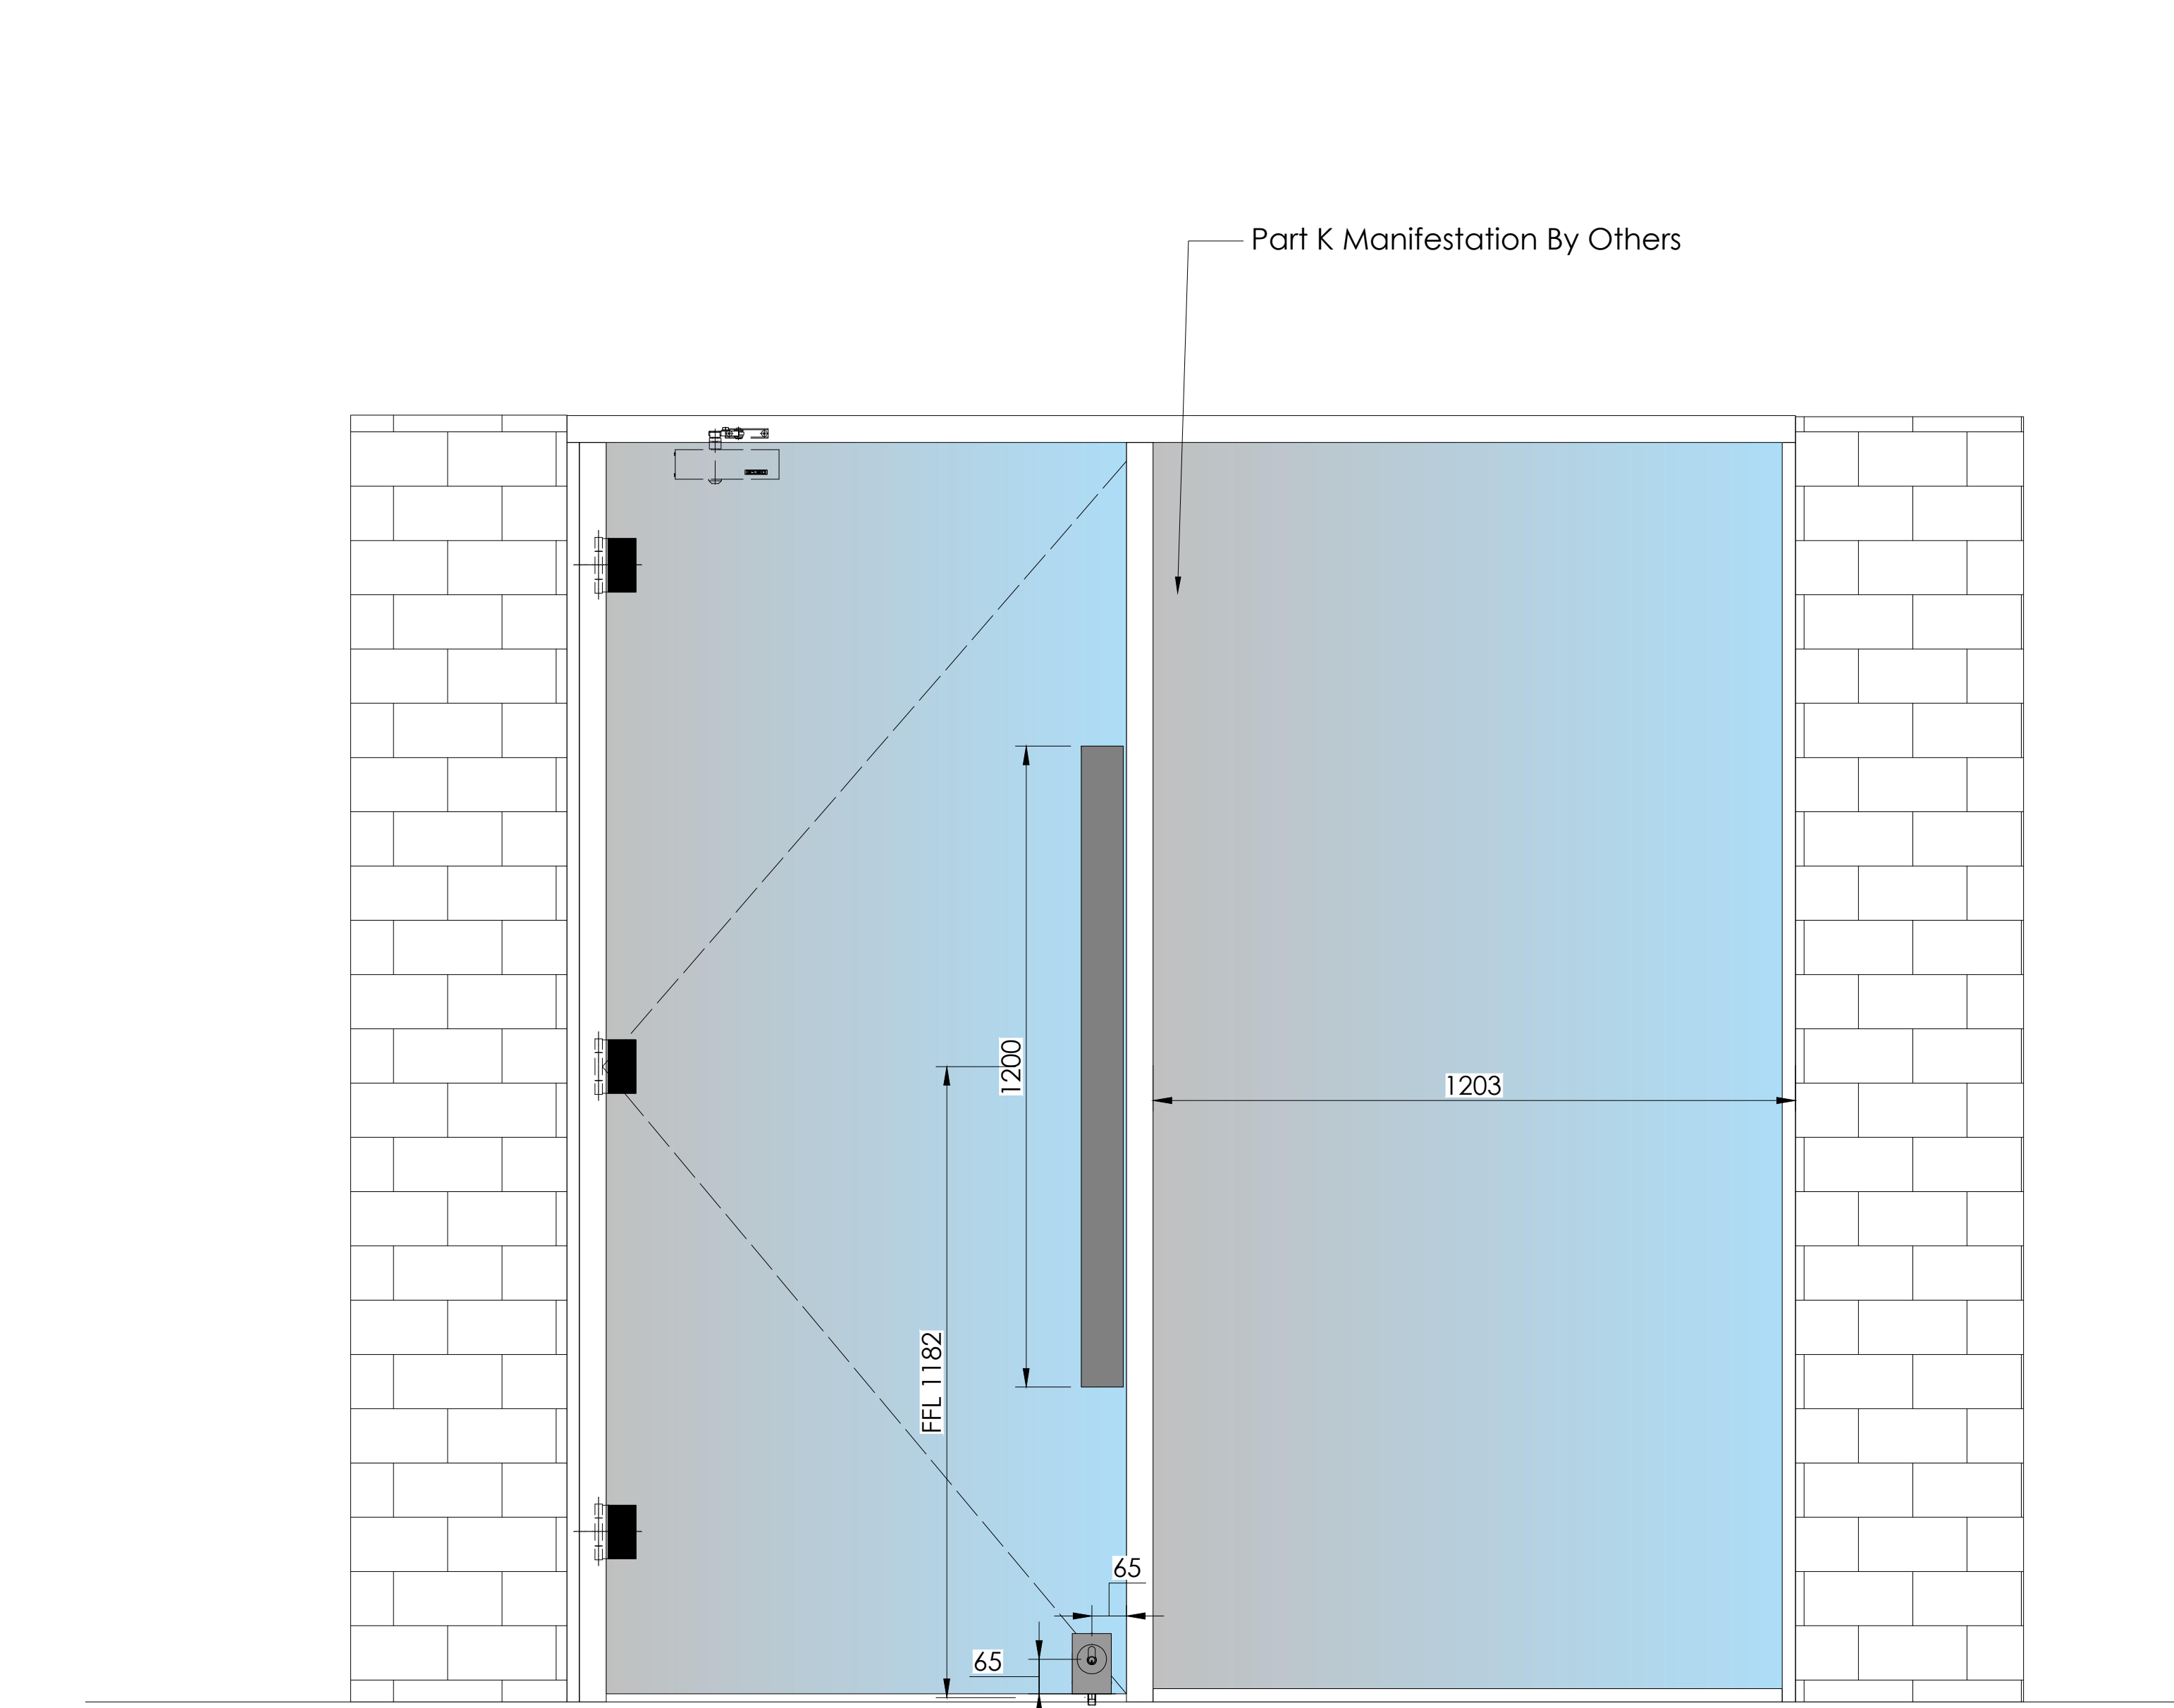
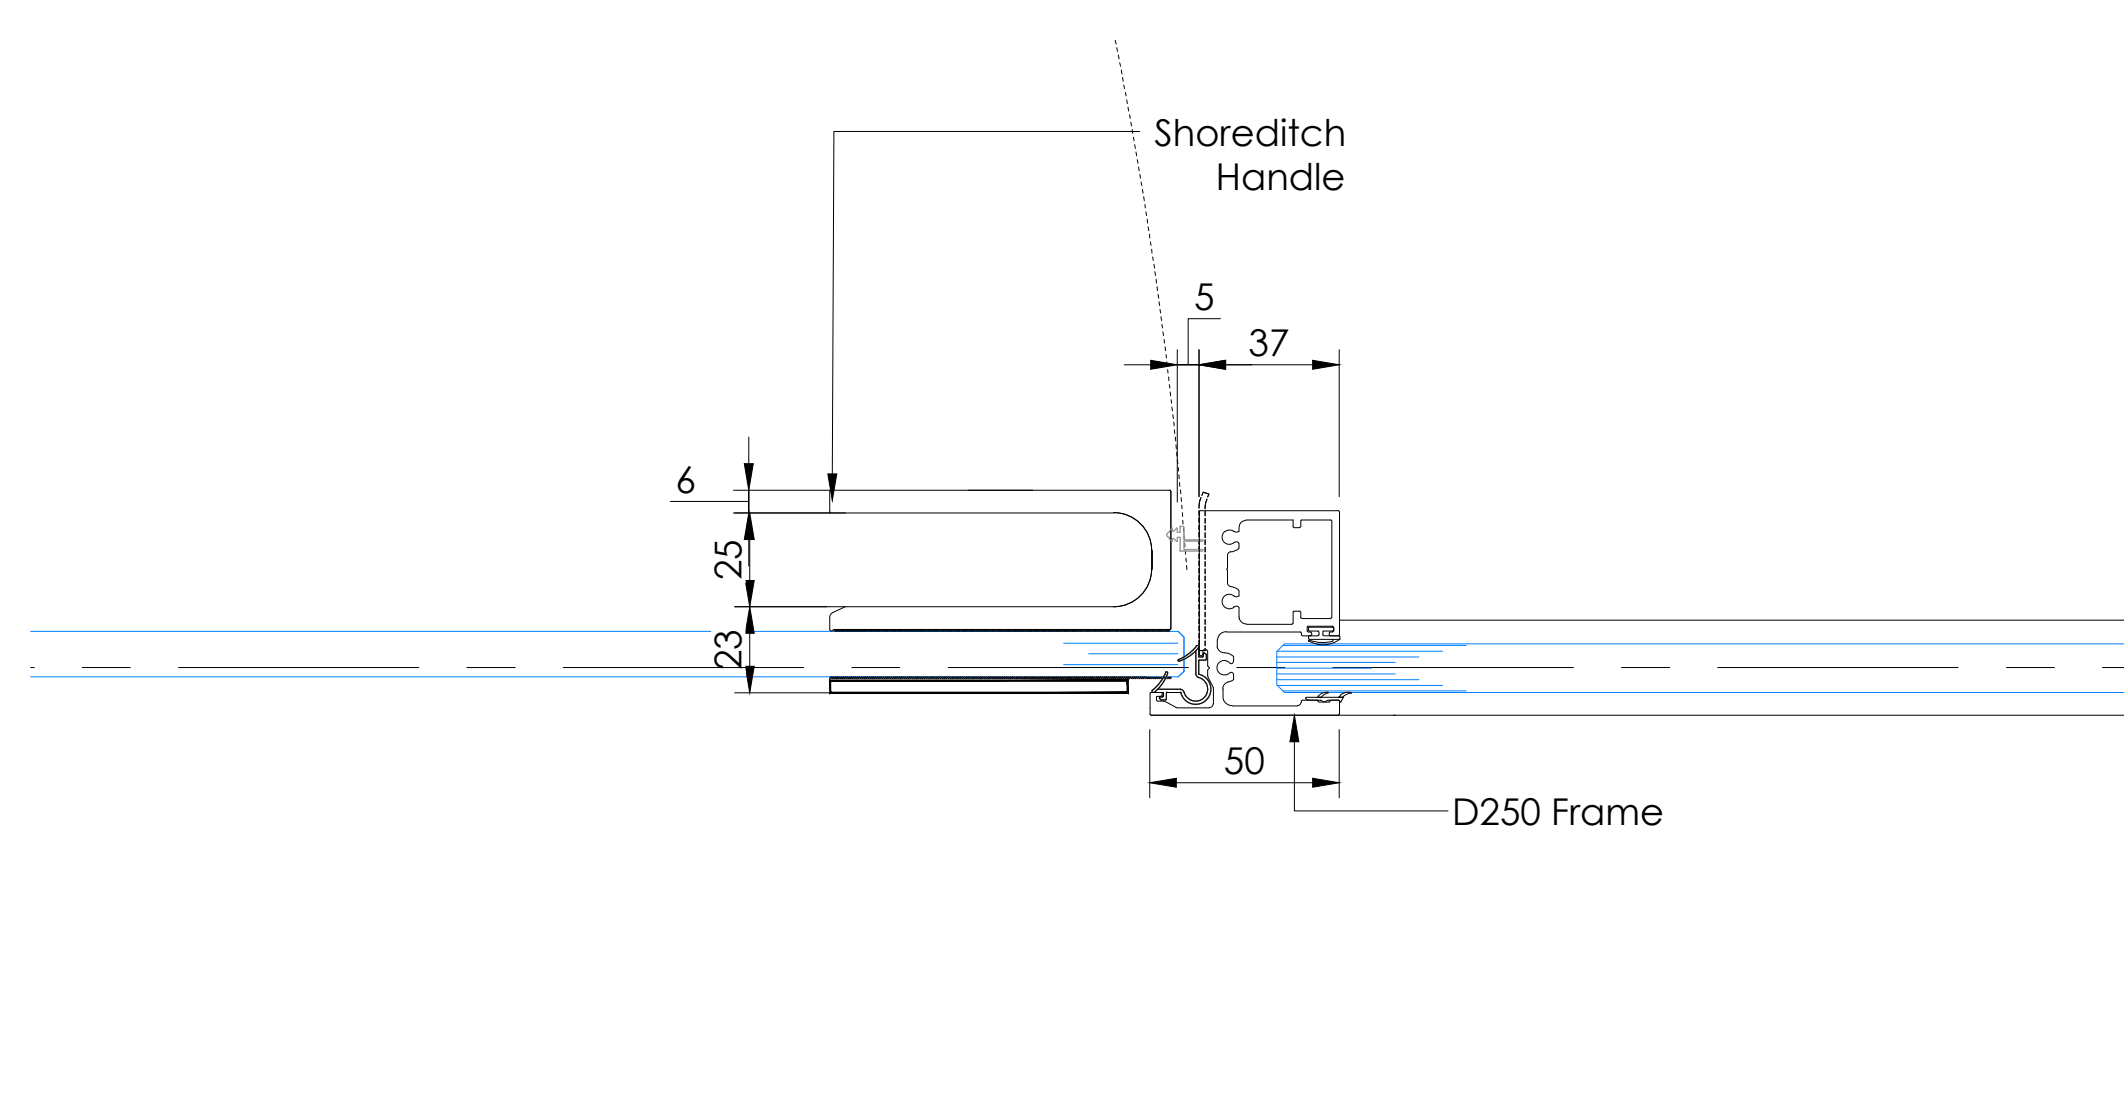
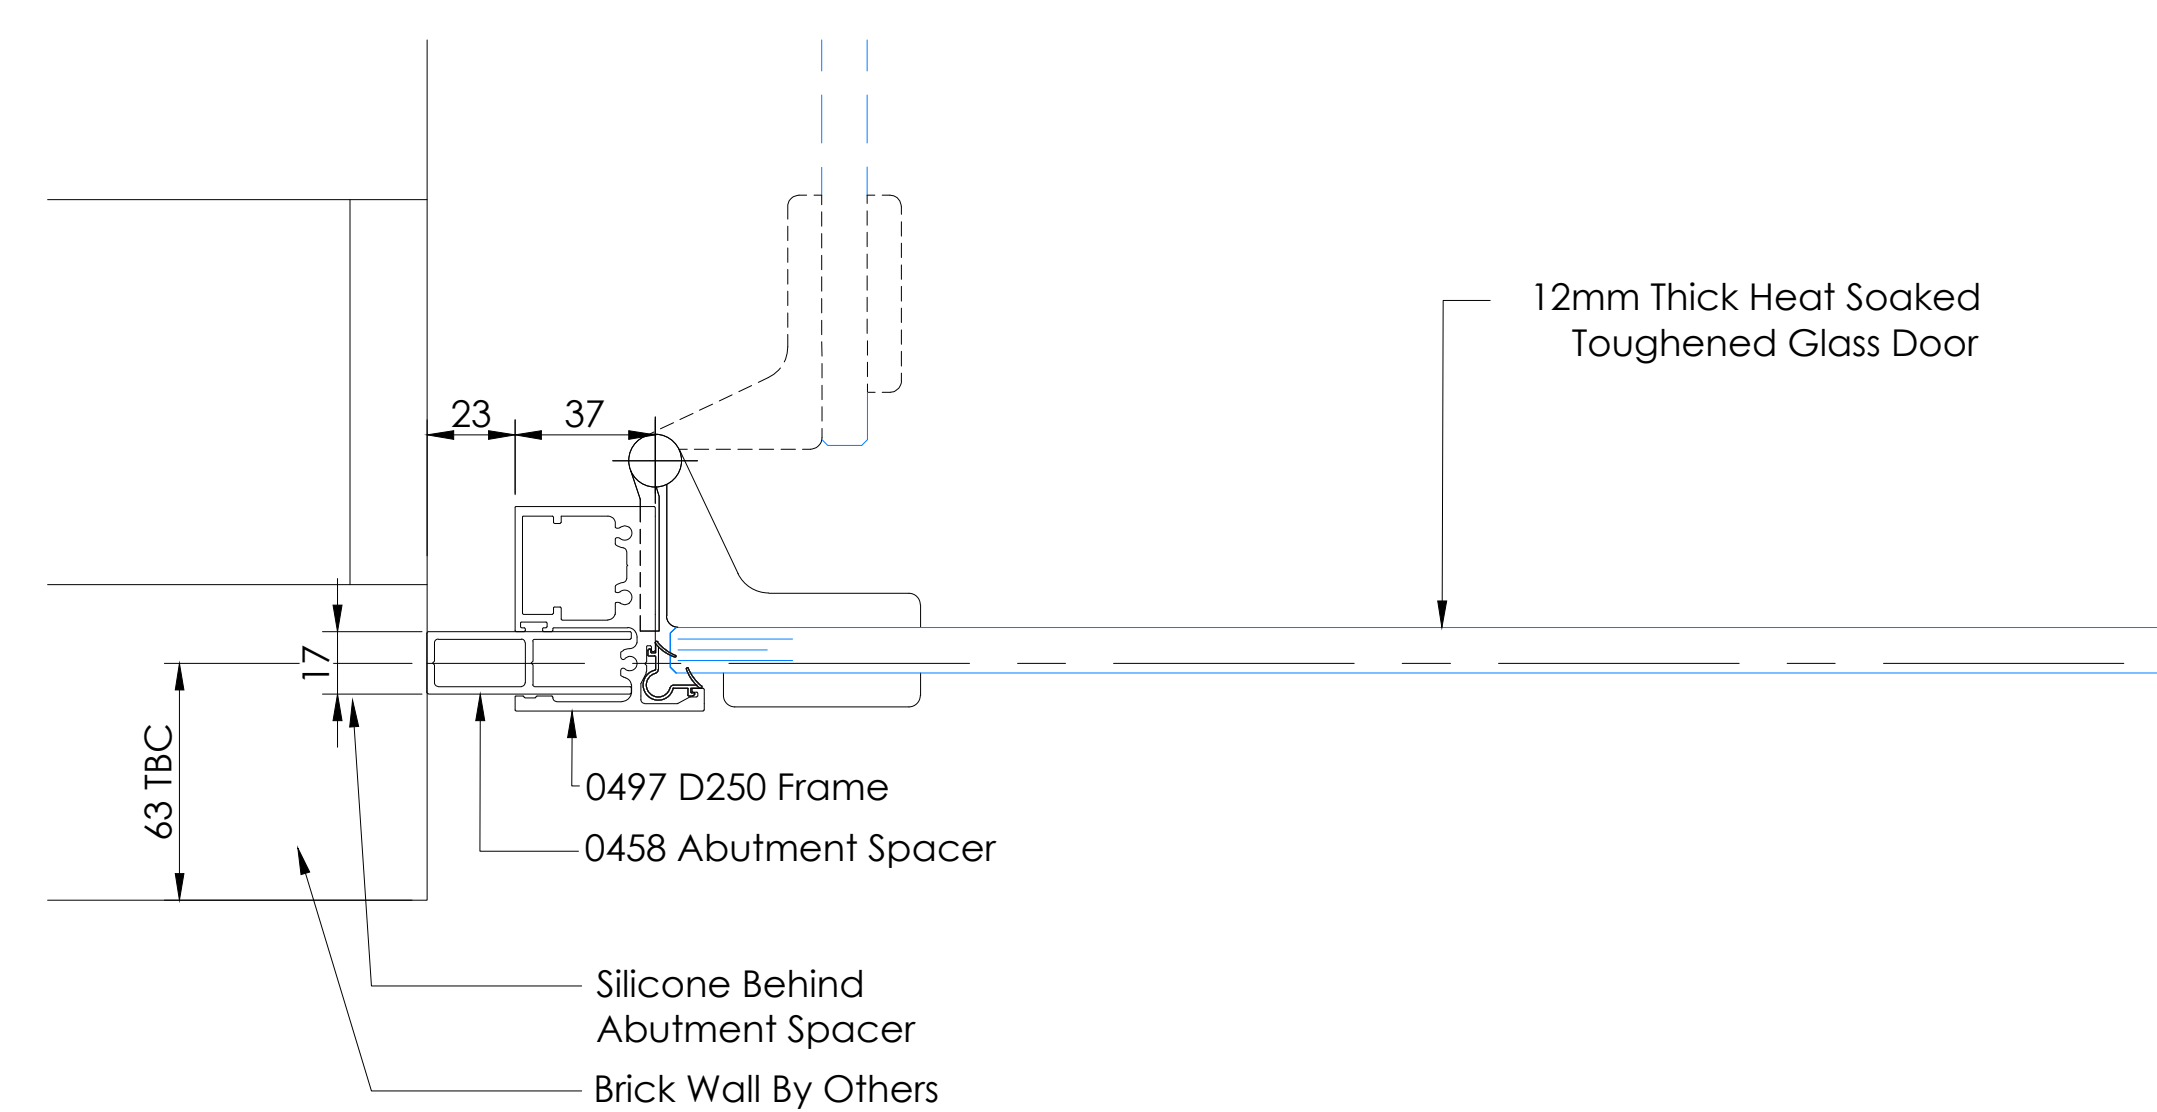
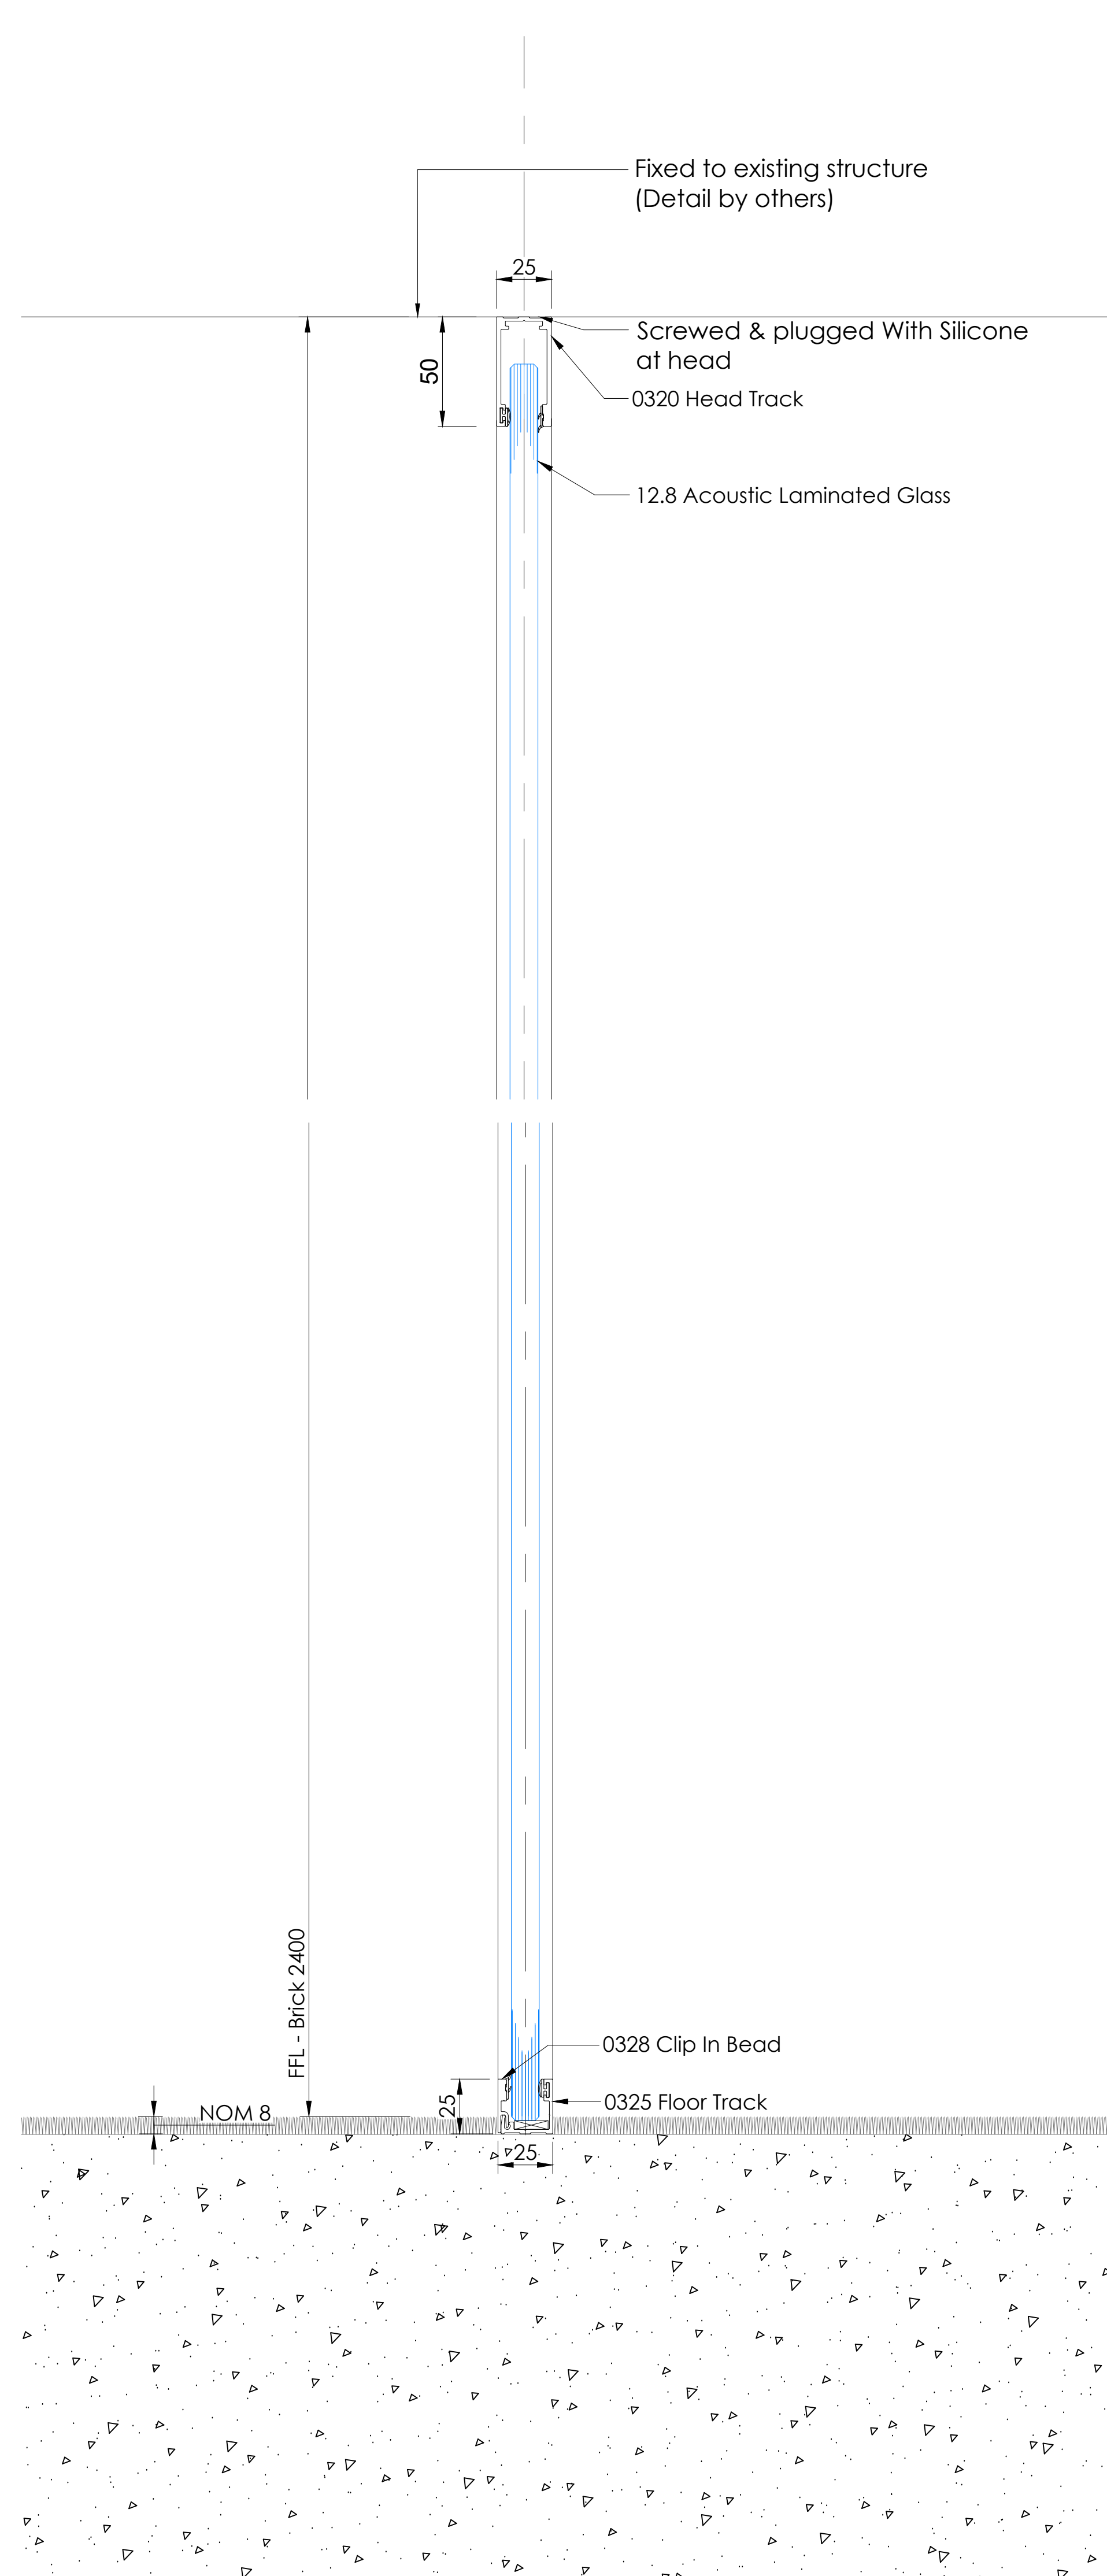
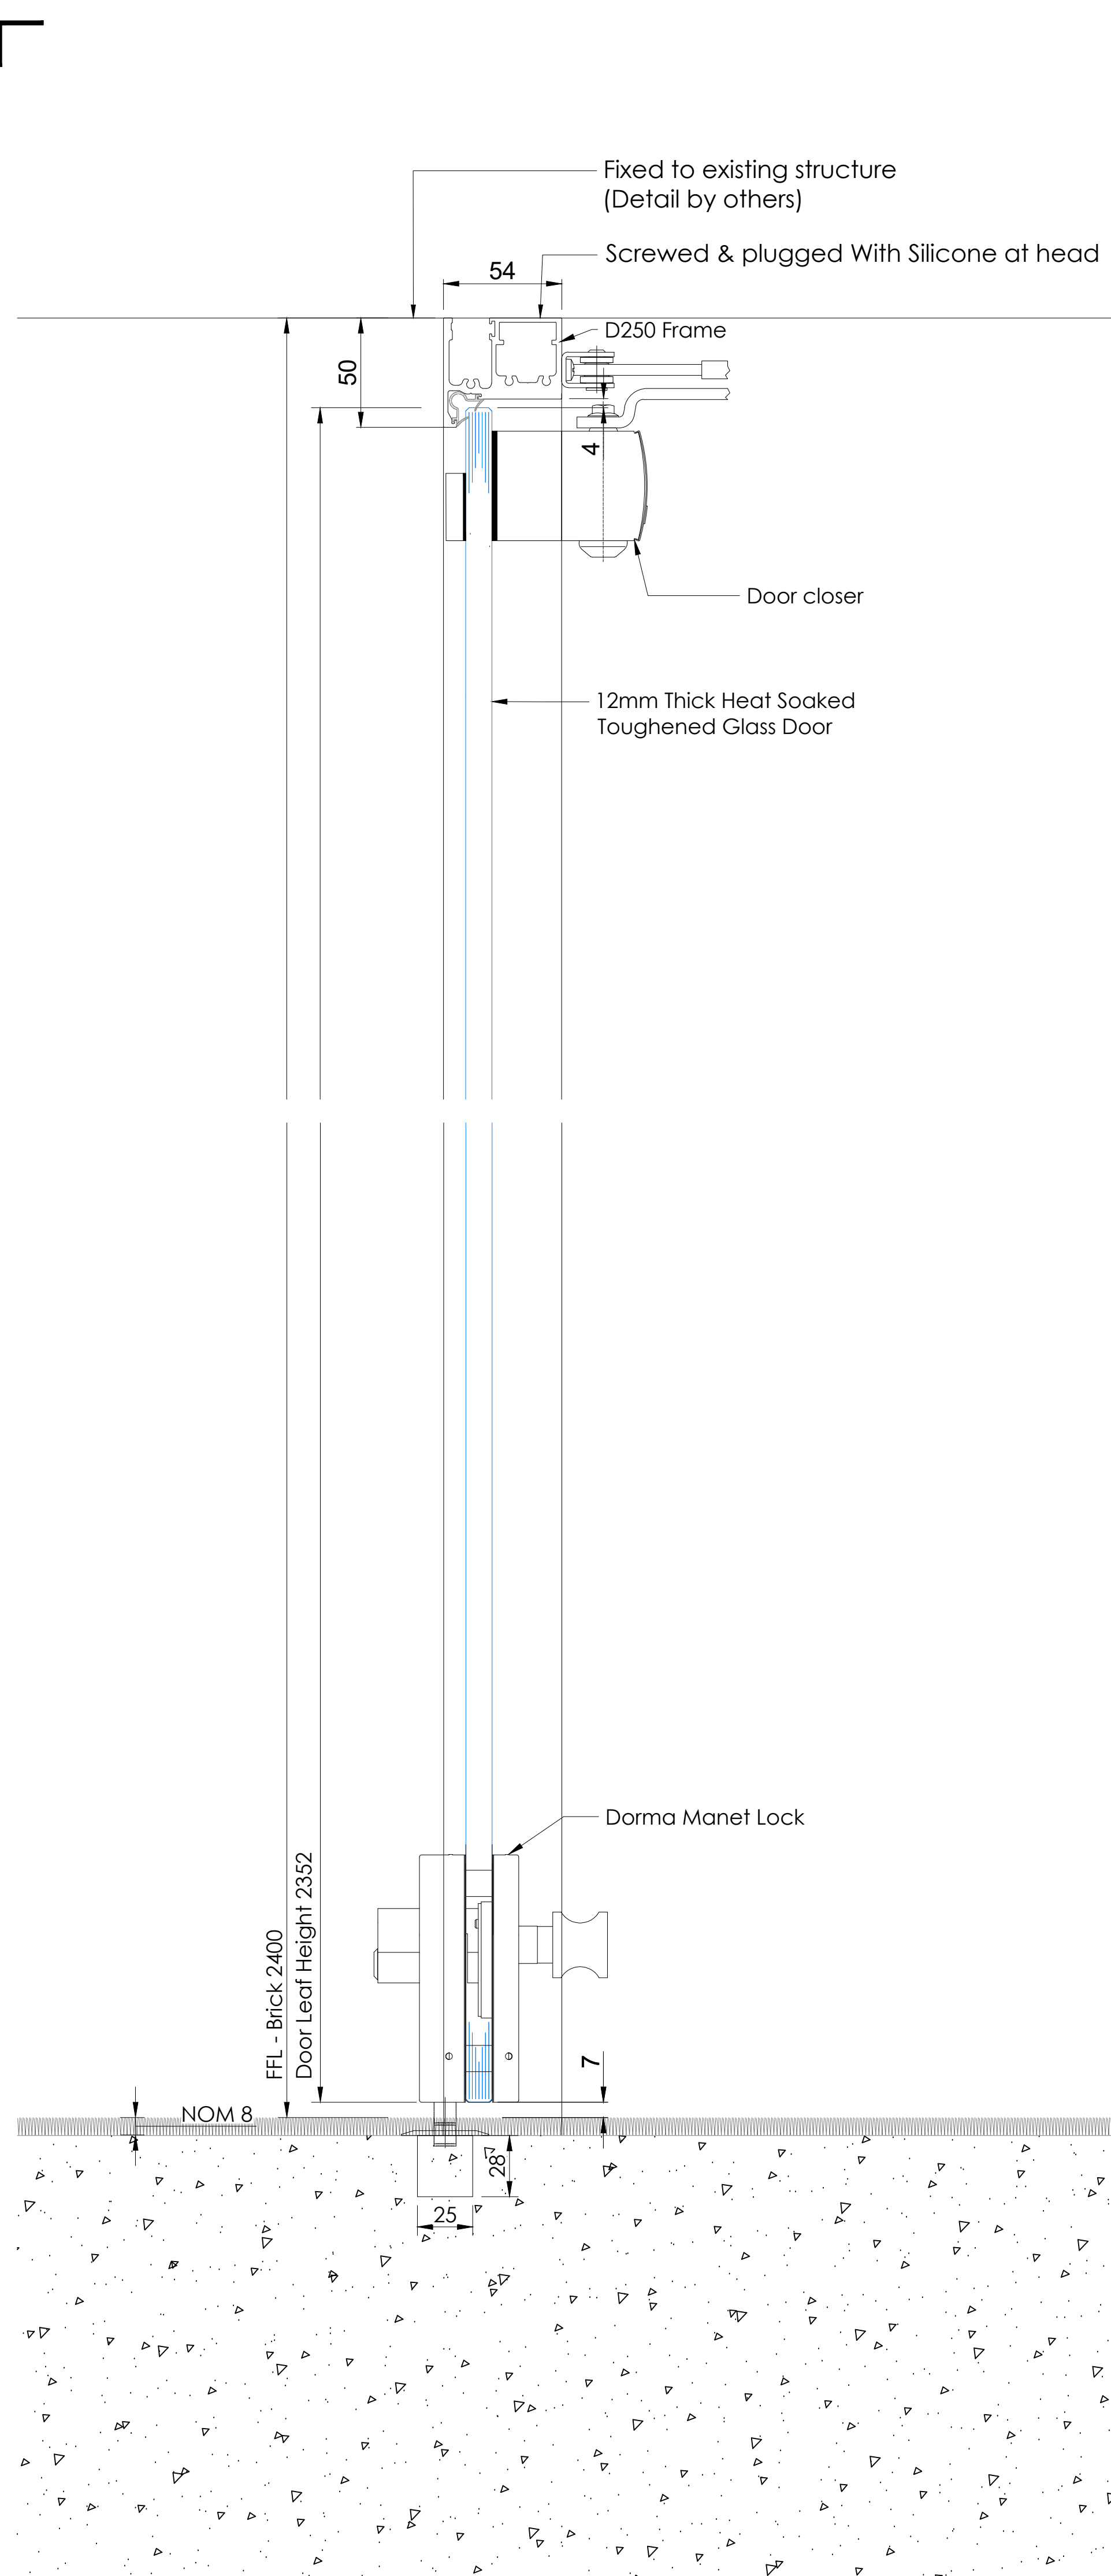


[illegible]

General Information Table 1012	
Door/Partition	
Door/Partition Type	117+ - Screen 12/ Axle Clarity Door
Floors	2
Acoustic Rating	Screen; Rw38dB/ Door: N/A
Ironmongery Set	Storefixed Pull Handles/ Door Closer/Dorma Metal Lock/ Patco fittings RAL 9005
Door Finish	N/A
Frame Finish	RAL 9005
Deflection	N/A
Glass	12mm thick heat soaked toughened/ 12.8 Acoustic Laminated Glass

Structural Openings To Be Checked On Site

31/03/20 Rev: Rev 00 AS BUILT					
AB	31.03.20	As Built	CC	CT	CR
Rev	Date	Description	Dr	App	C
Status:					
As Built					
Optima					
© Optima Products Ltd.					
OPTIMA CONTRACTING LIMITED COURTYARD HOUSE WEST END ROAD HIGH WYCOMBE BUCKINGHAMSHIRE HP11 2QB			Tel: +44 (0) 1494 492600 Web: www.optimaystems.com		
PART OF THE OPTIMA GROUP Project:					
50195 Bonded Warehouse L2					
Title: 117+ Screen 12 With Axile Clarity Door					
Scale @ A0:	Drawing No.:		Revision:		
VARIES	OPT-DRG-1012		AB		