



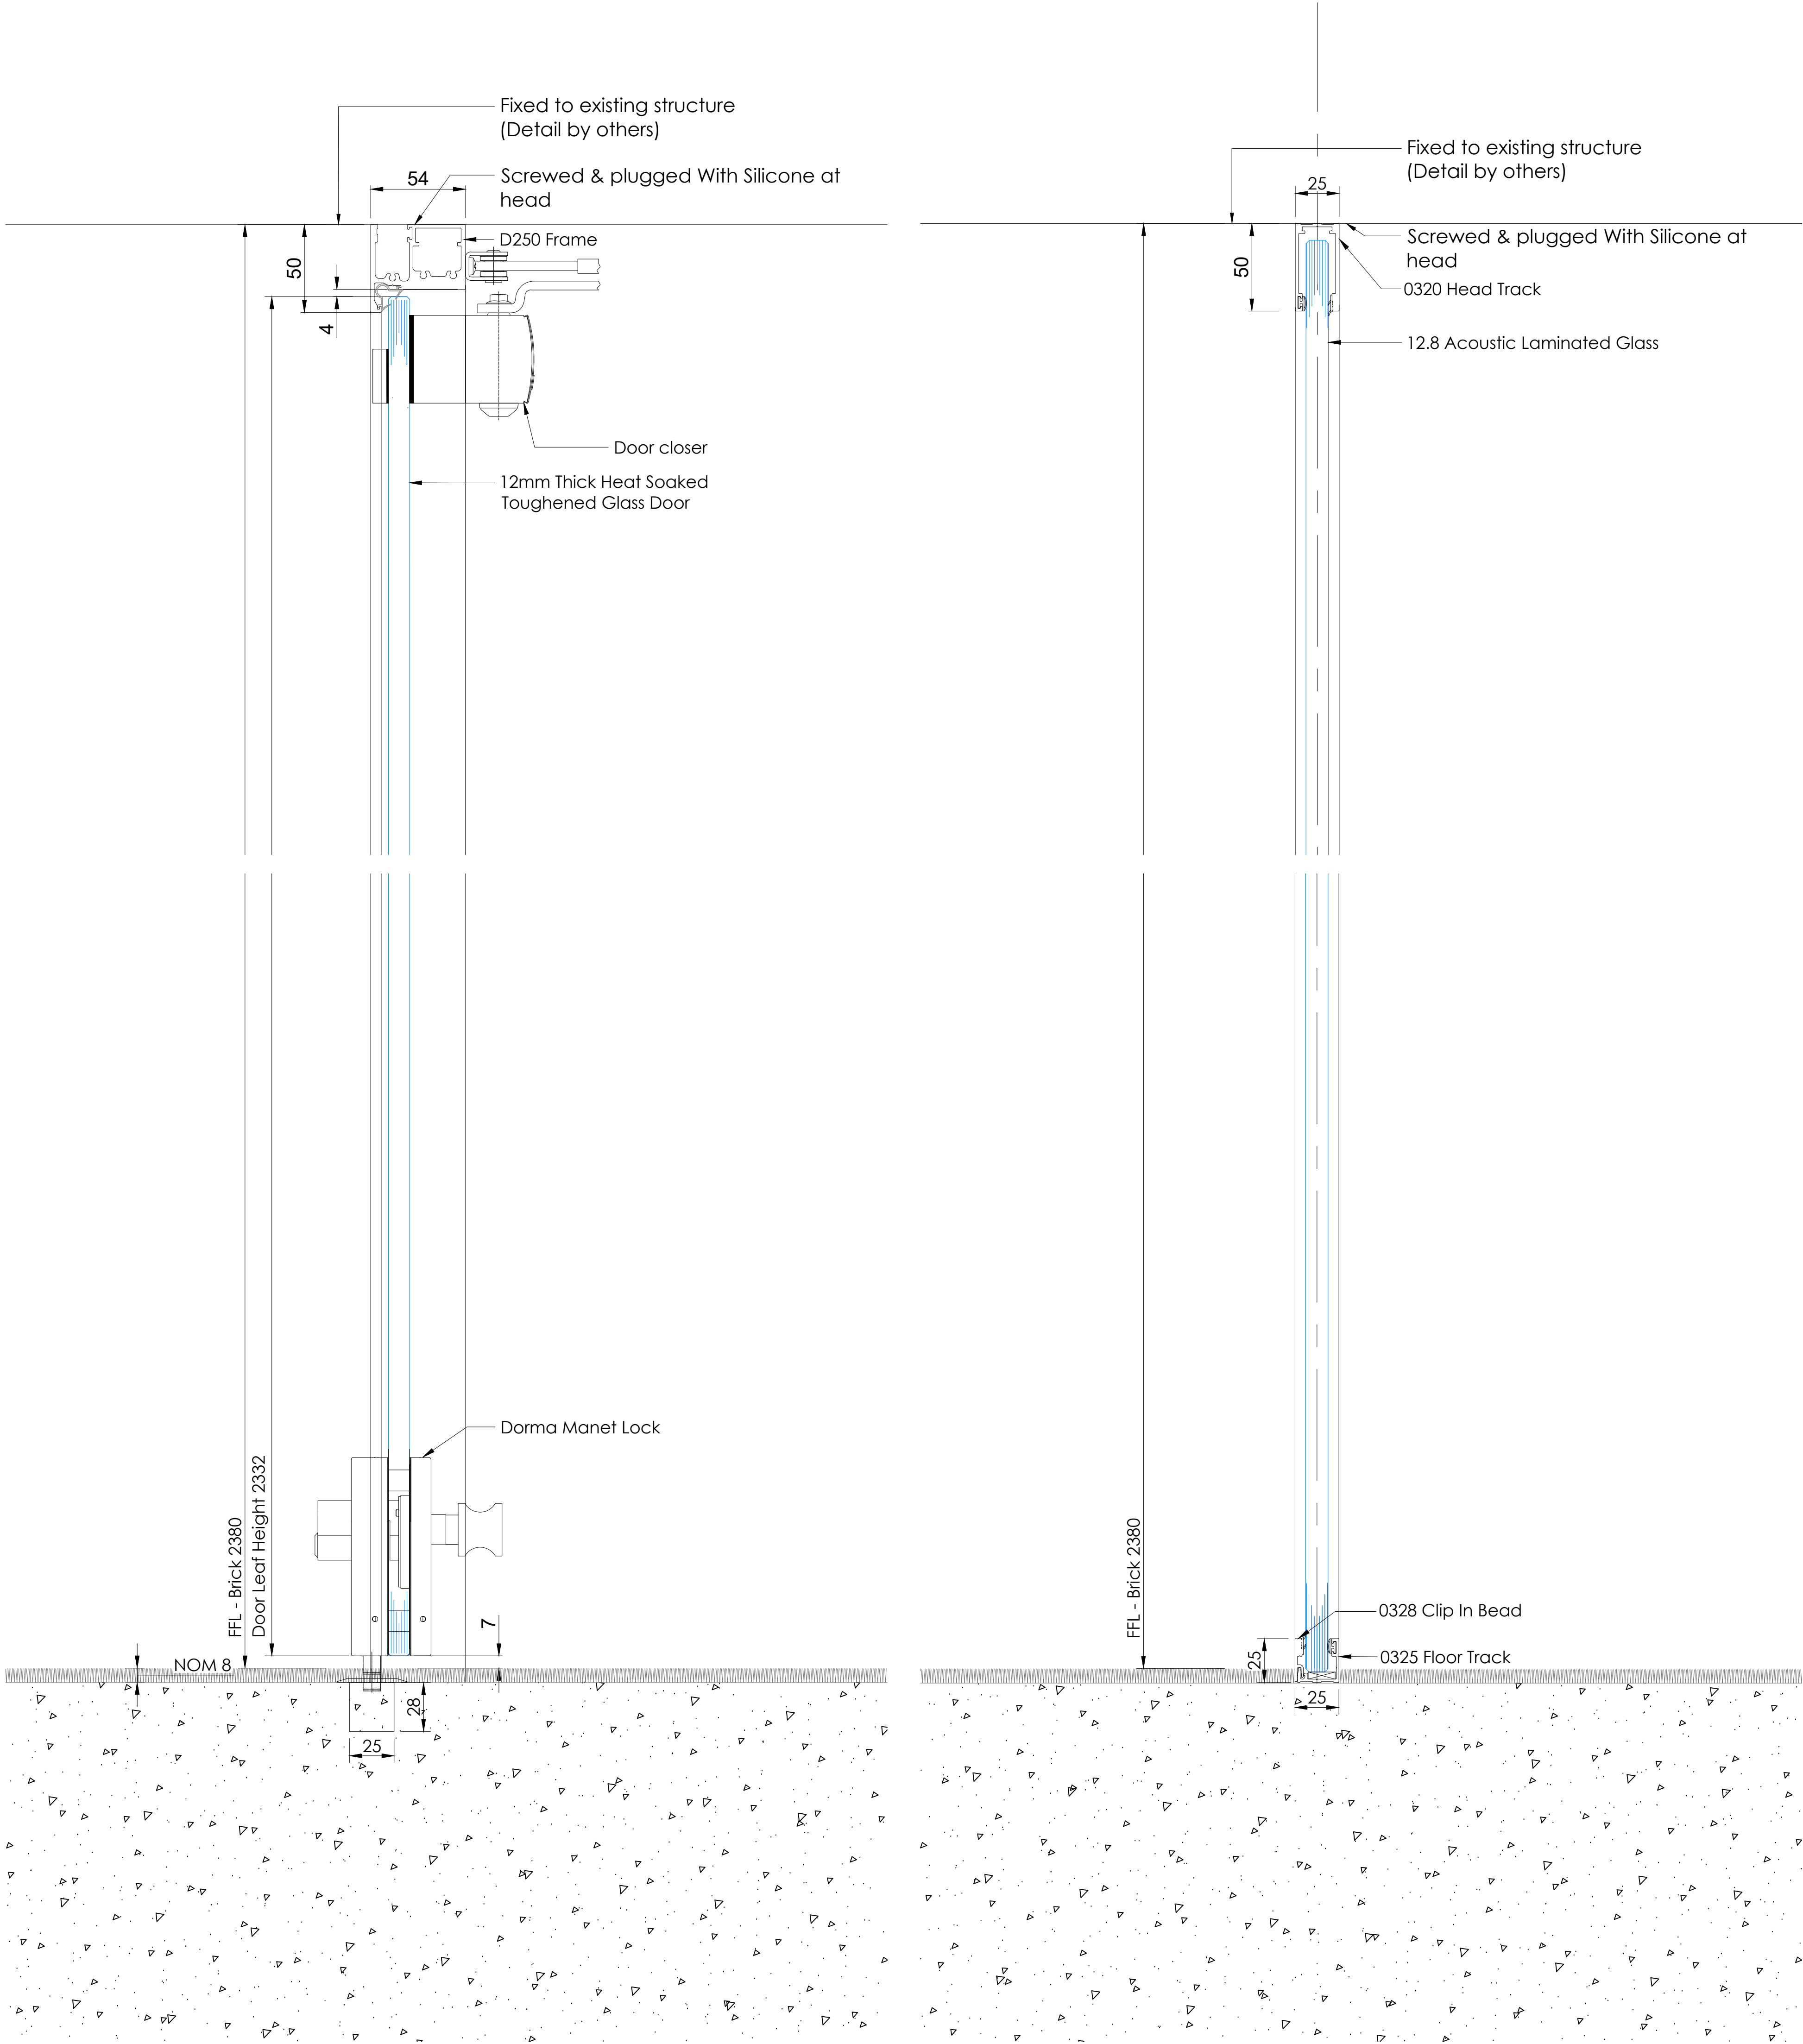


1 SECTION: Door Axile Clarity Scale 1:2

2 SECTION: Screen 9 117+ Scale 1:2

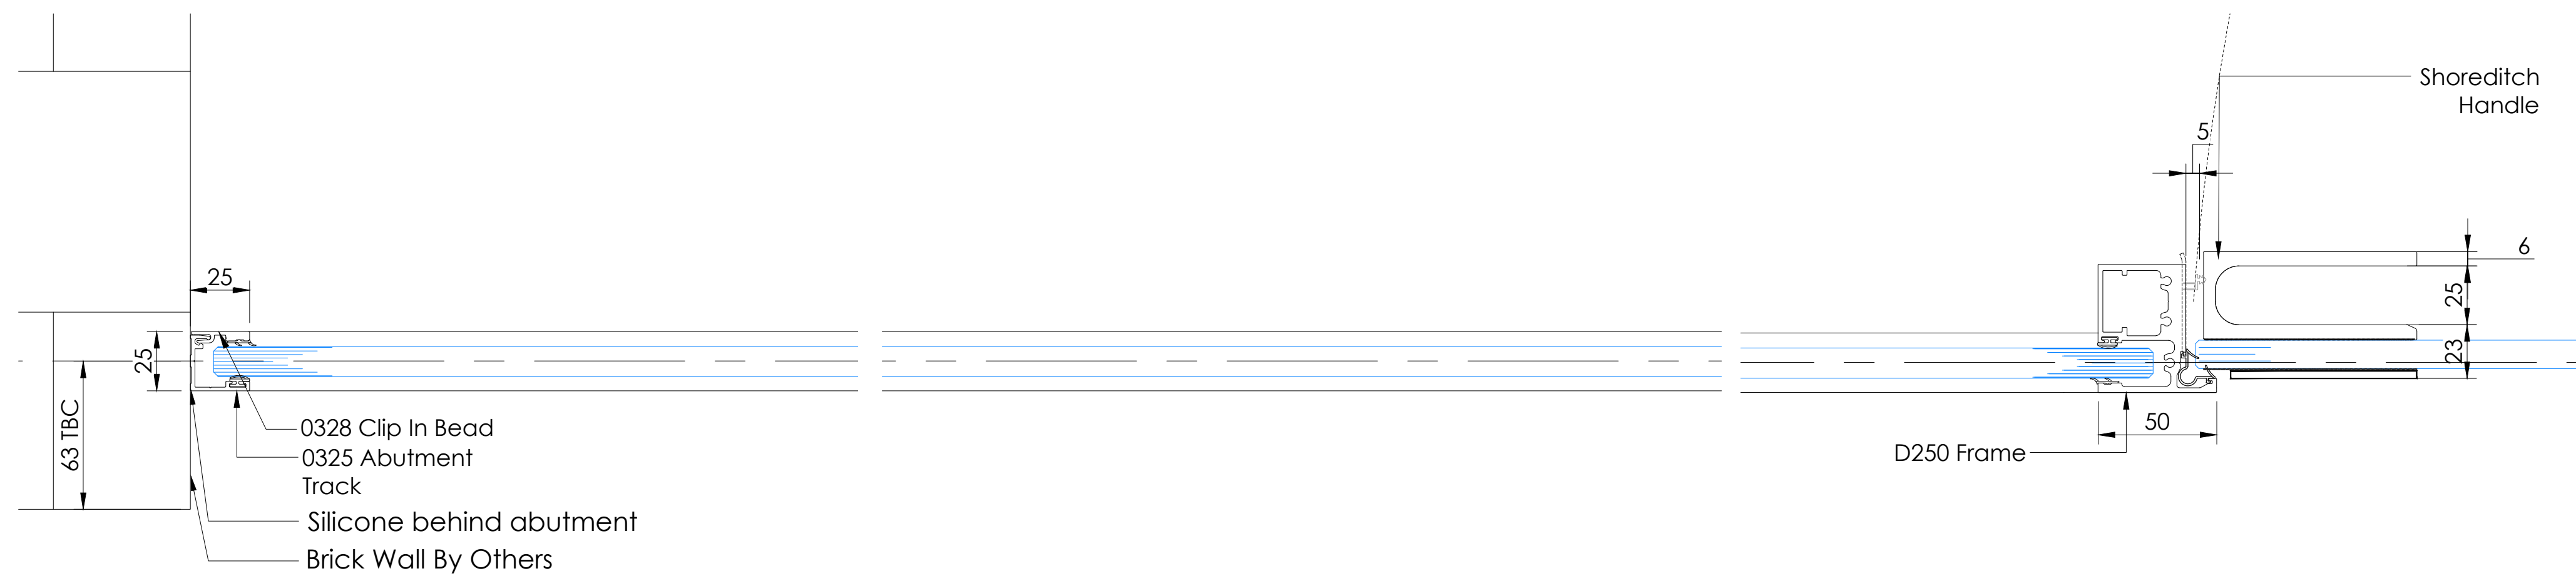


5 Plan Details: Wall Abutment Scale 1:2


6 Plan Details: Door Jamb Scale 1:2

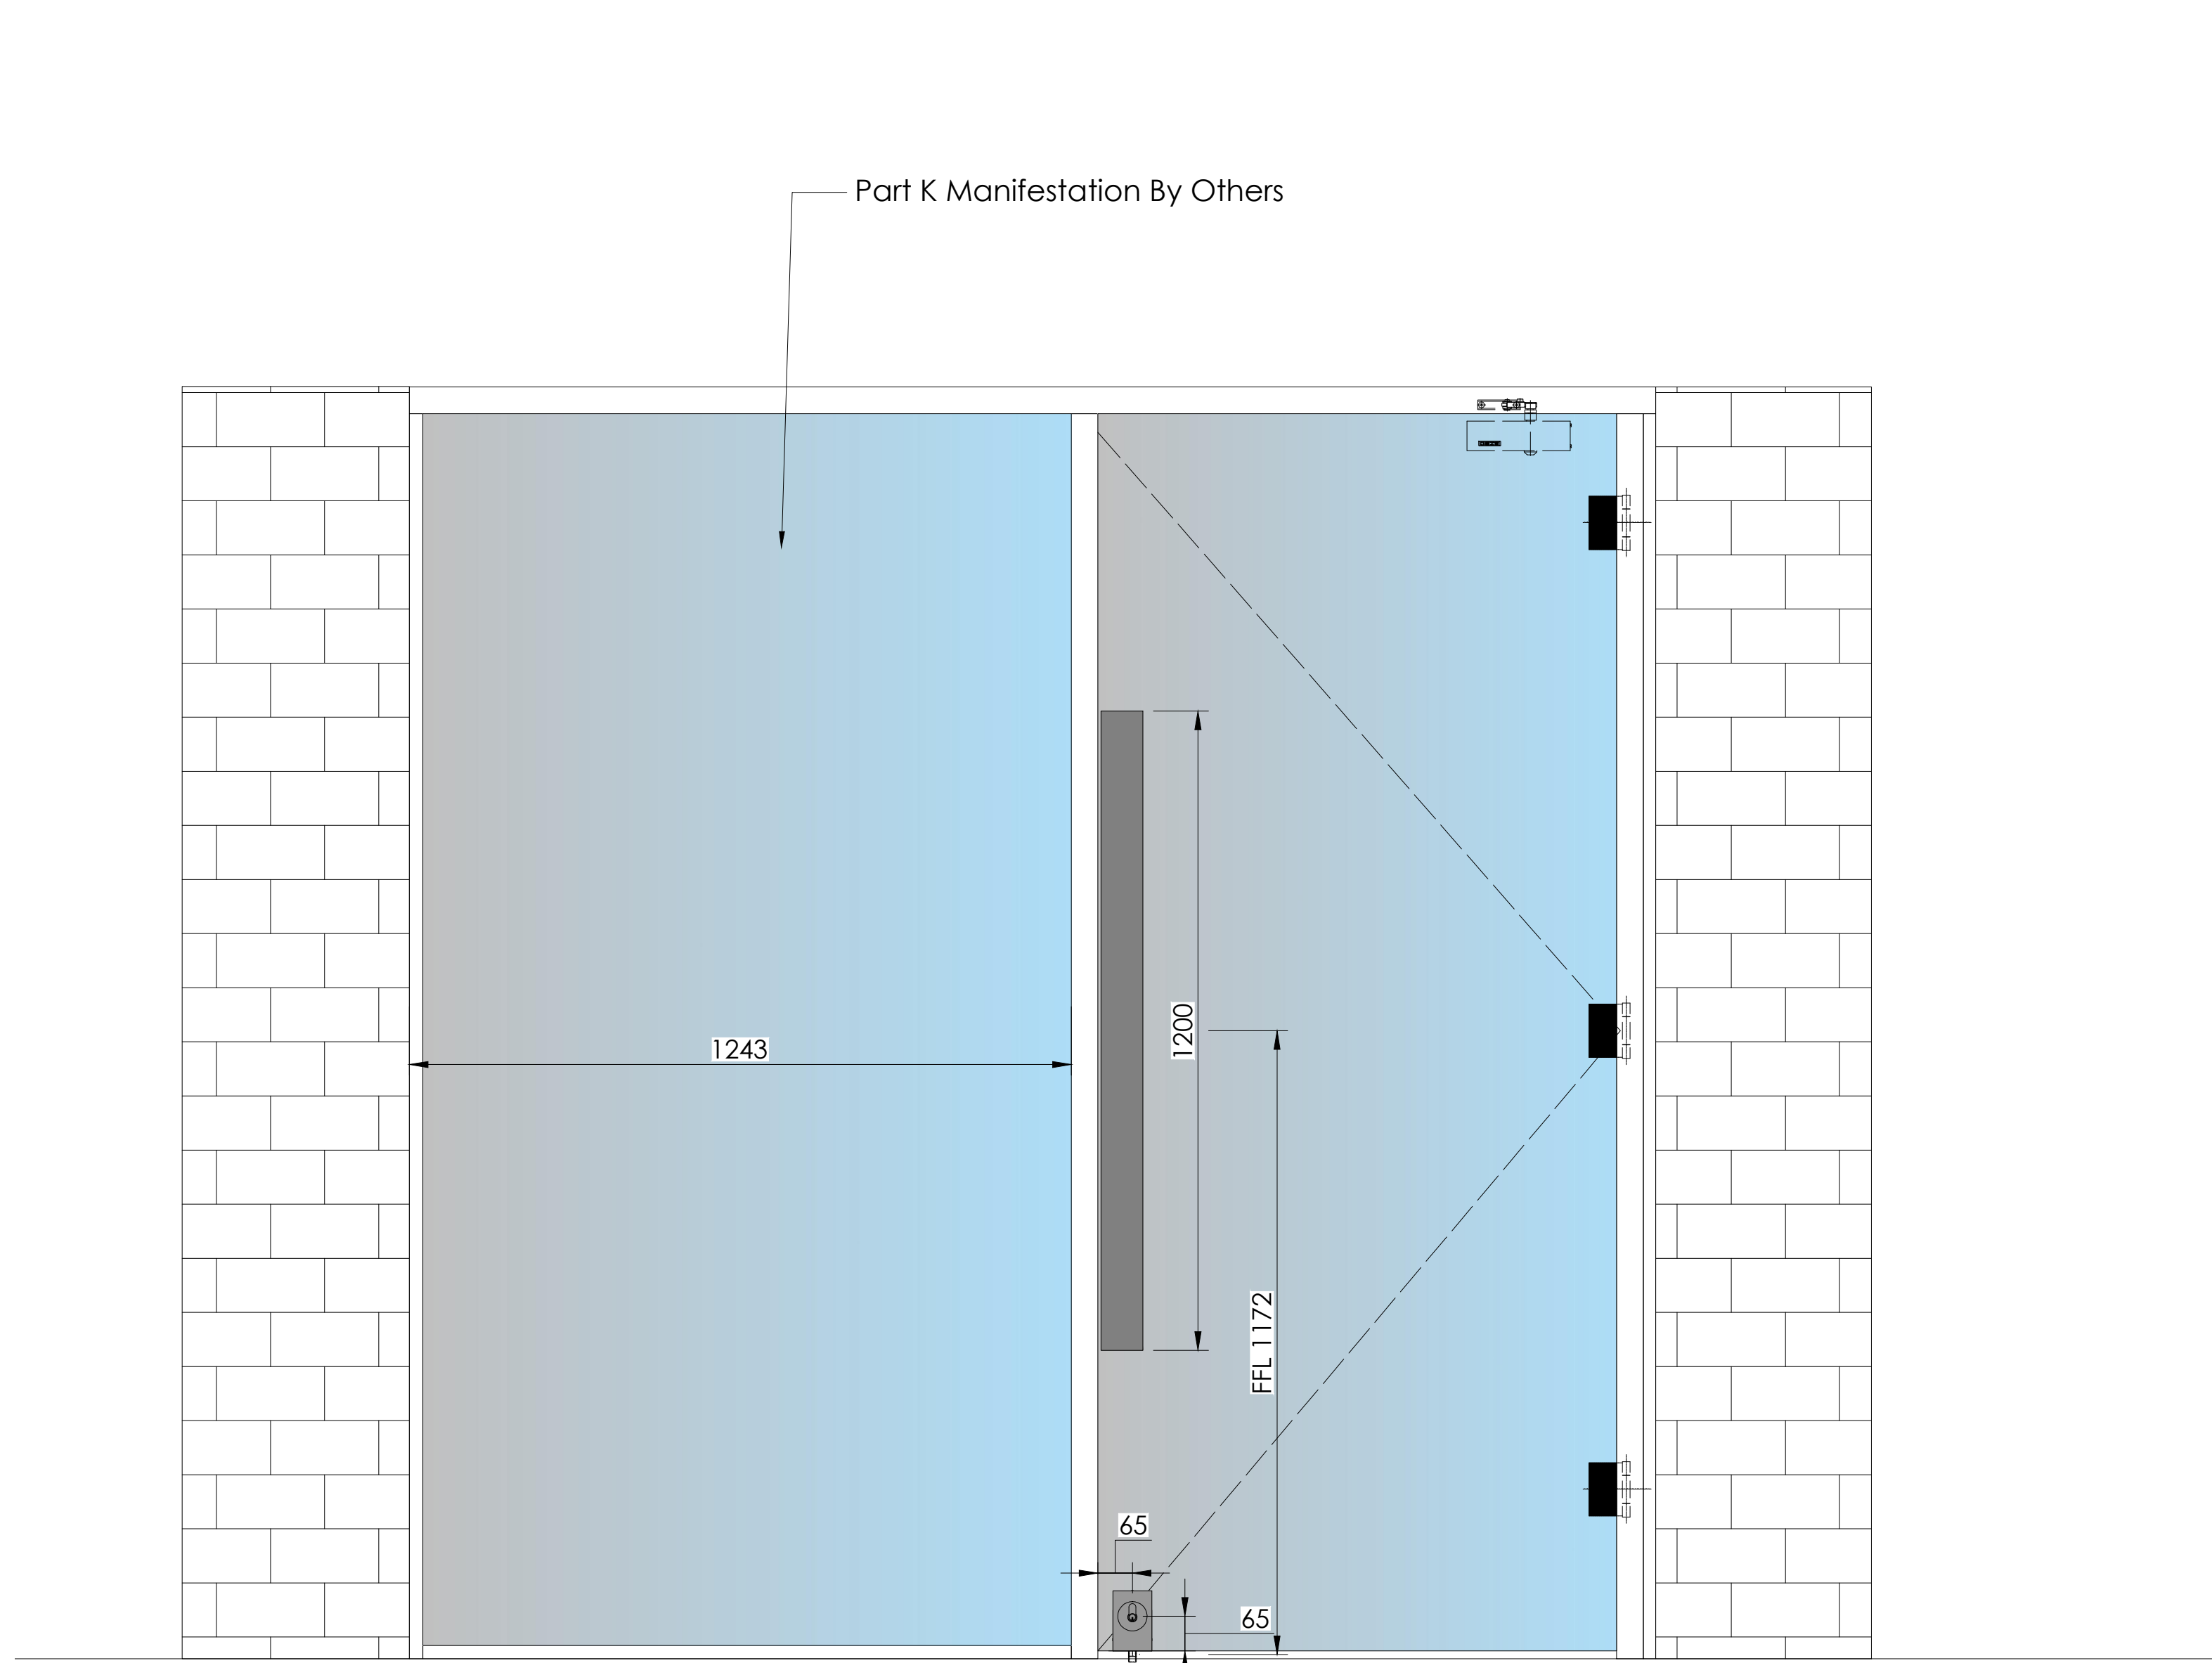

3 Elevation: Screen 9 117+ - Axile Clarity Door Scale 1:10

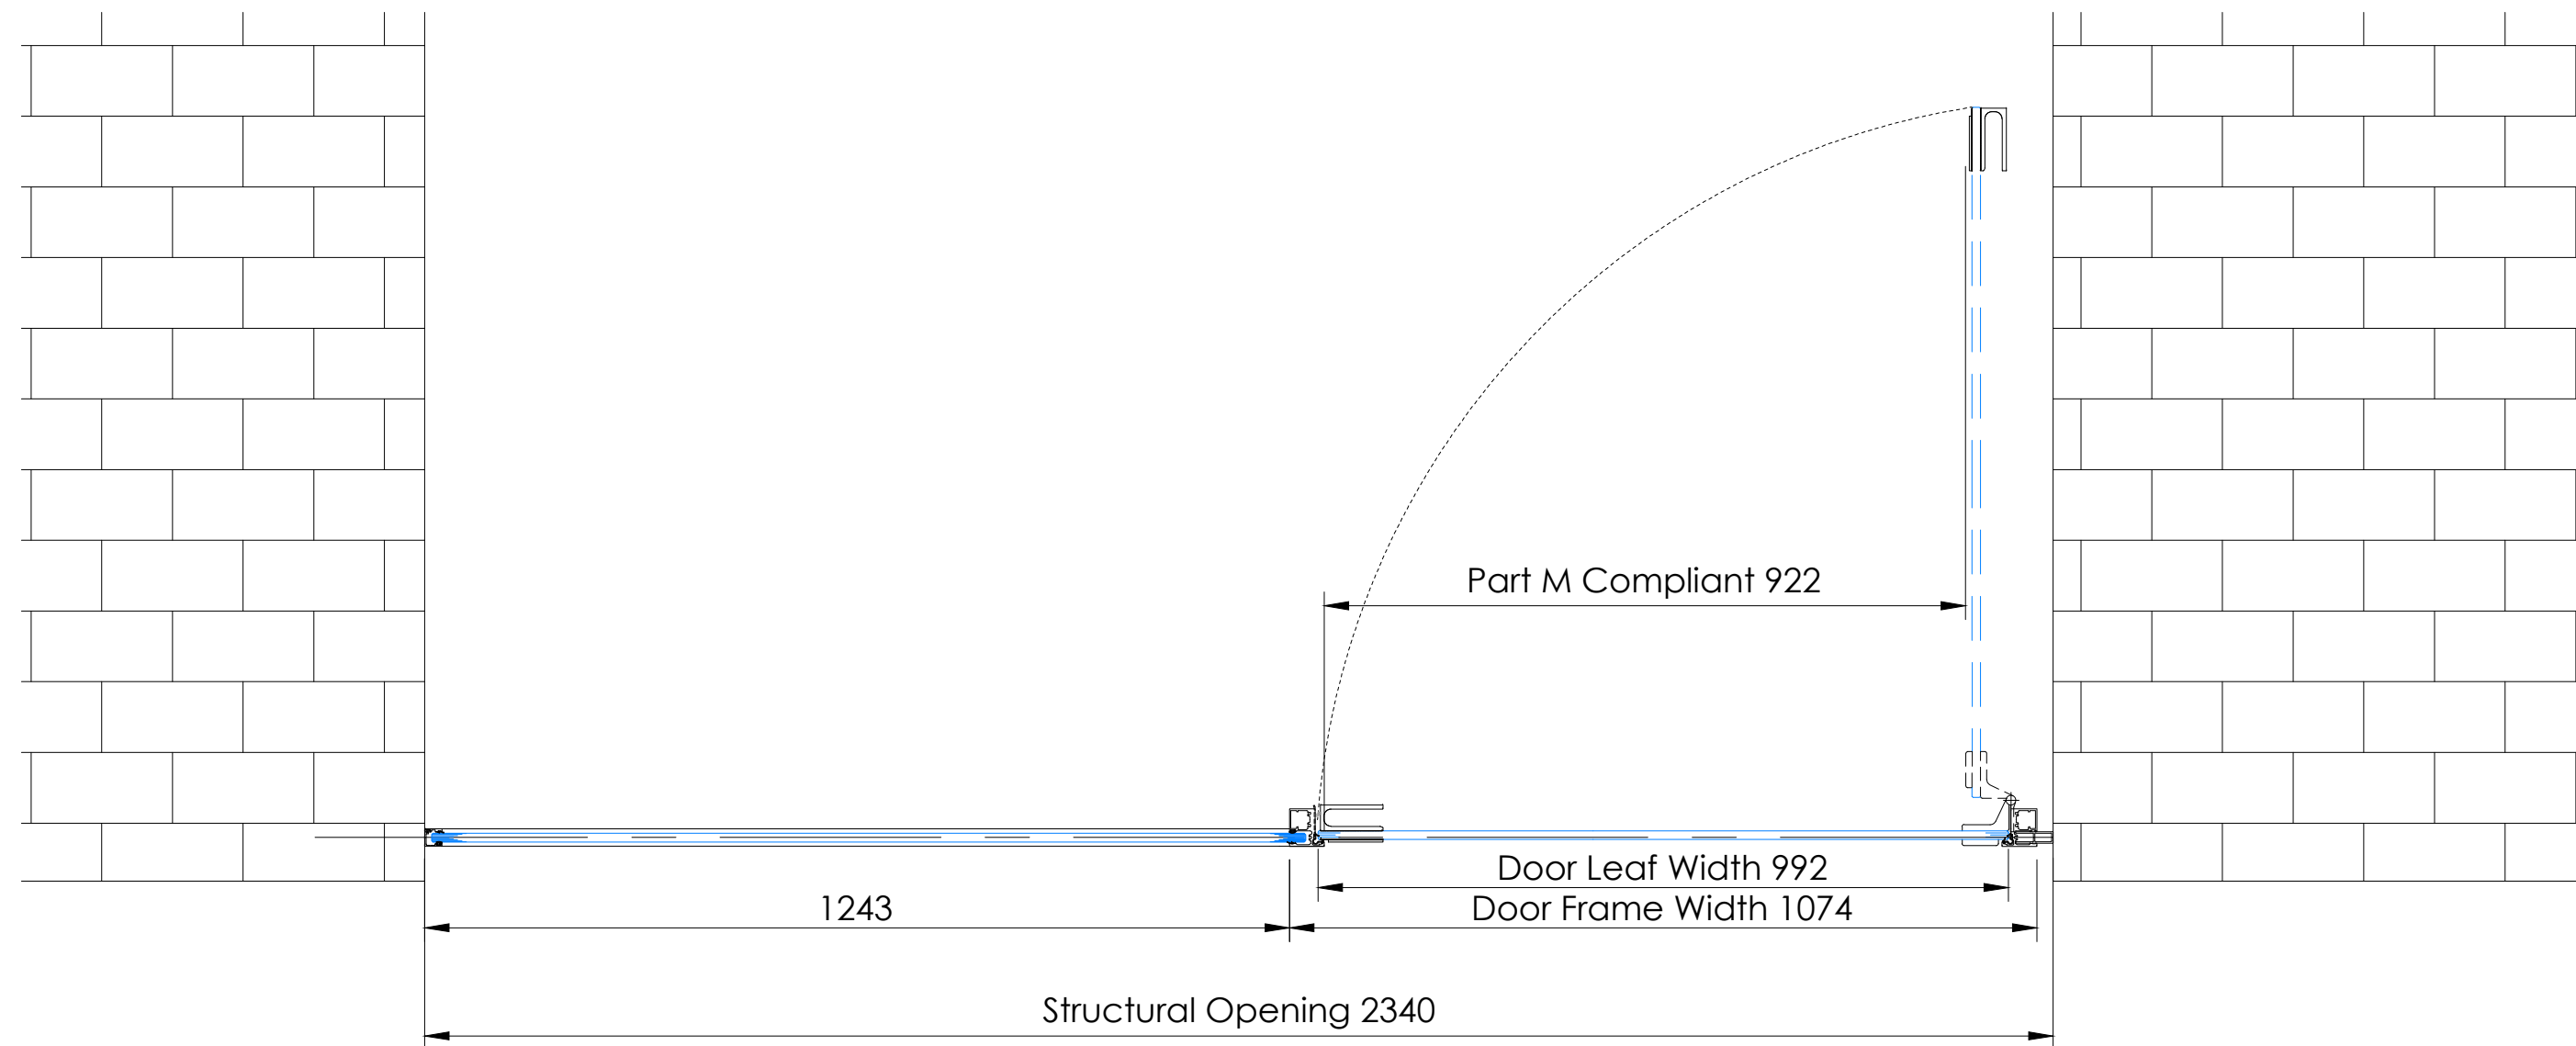

4 PLAN: Screen 9 117+ - Axile Clarity Door Scale 1:10

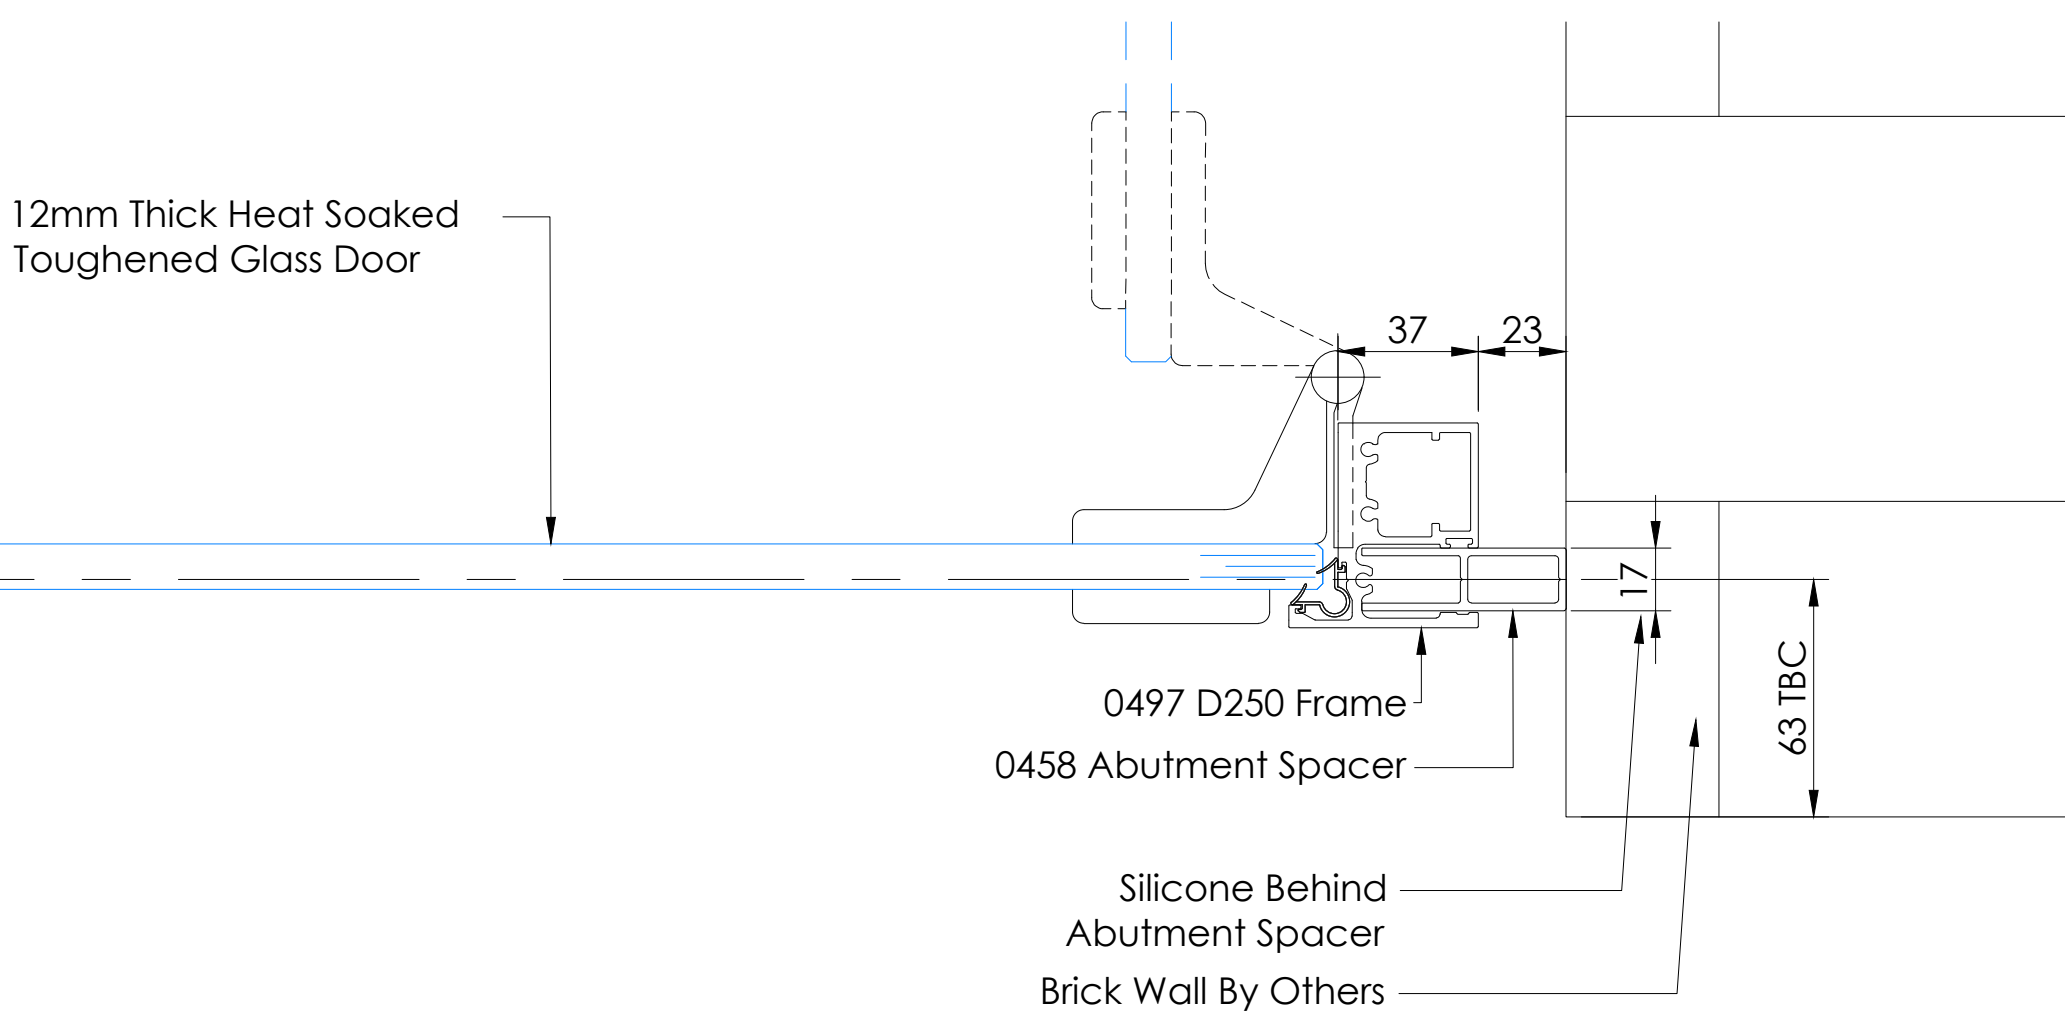

7 Plan Details: Abutment Spacer Scale 1:2

Safety Health & Environmental Box
Construction Risks This project uses any materials that have been used in the region before. From a Designer viewpoint, Optima do not envisage any specific Construction Issues to communicate.
Maintenance / Cleaning Risks Optima, in the main, provide office partitioning, the components (specifically the glass) are tested to the relevant standard or international standard of the glass. As such, CLEANING and MAINTENANCE of this product should be no specific risk. However, Optima would point out that all persons involved with maintenance and cleaning should themselves be subject to their own employer specific risk assessment practices. Specific care should be taken at working at height. In such cases the regulations of the day apply. Optima do not recommend any loadings against its products.
Demolition / Adaptation Risks From the viewpoint of a Designer, Optima have identified no significant risks for demolition and adaptation. However, the usual risk assessments are presented as implemented by the company proposing demolition and/or adaptation.
Environmental / Recycling Much of the Optima range of product is recyclable, cable. See original terms and conditions for clarification. Environmental issues are subject to the law of the day.
In addition to the hazards / risks normally associated with the types of work detailed on this drawing take note of the above. It is assumed that all work on this drawing will be carried out by competent personnel using appropriate tools and approved methods of work.

General Information Table 1011	
Door/Partition	
Door/Partition Type	117+ - Screen 9/ Axile Clarity Door
Floors	2
Acoustic Rating	Screen: Rw38dB/ Door: N/A
Ironmongery Set	Shoreditch Pull Handles/ Door Closer/ Dorma Manet Lock/ patch fittings RAL 9005
Door Finish	N/A
Frame Finish	RAL 9005
Deflection	N/A
Glass	12mm thick heat soaked toughened/ 12.8 Acoustic Laminated Glass

Structural Openings To Be Checked On Site

31/03/20 Rev: Rev 00 AS BUILT					
AB	31.03.20	As Built	CC	CT	GW
Rev	Date	Description	Dr	App	Ck
Status:					
As Built					
Optima					
© Optima Products Ltd.					
OPTIMA CONTRACTING LIMITED COURTYARD HOUSE WEST END ROAD HIGH WYCOMBE BUCKINGHAMSHIRE HP11 2QB			Tel: +44 (0) 1494 492600 Web: www.optimasytems.com		
PART OF THE OPTIMA GROUP					
Project:					
50195 Bonded Warehouse L2					
Title:					
117+					
Screen 9 With Axile Clarity Door					
Scale @ A0:	Drawing No.:		Revision:		
VARIES	OPT-DRG-1011		AB		