




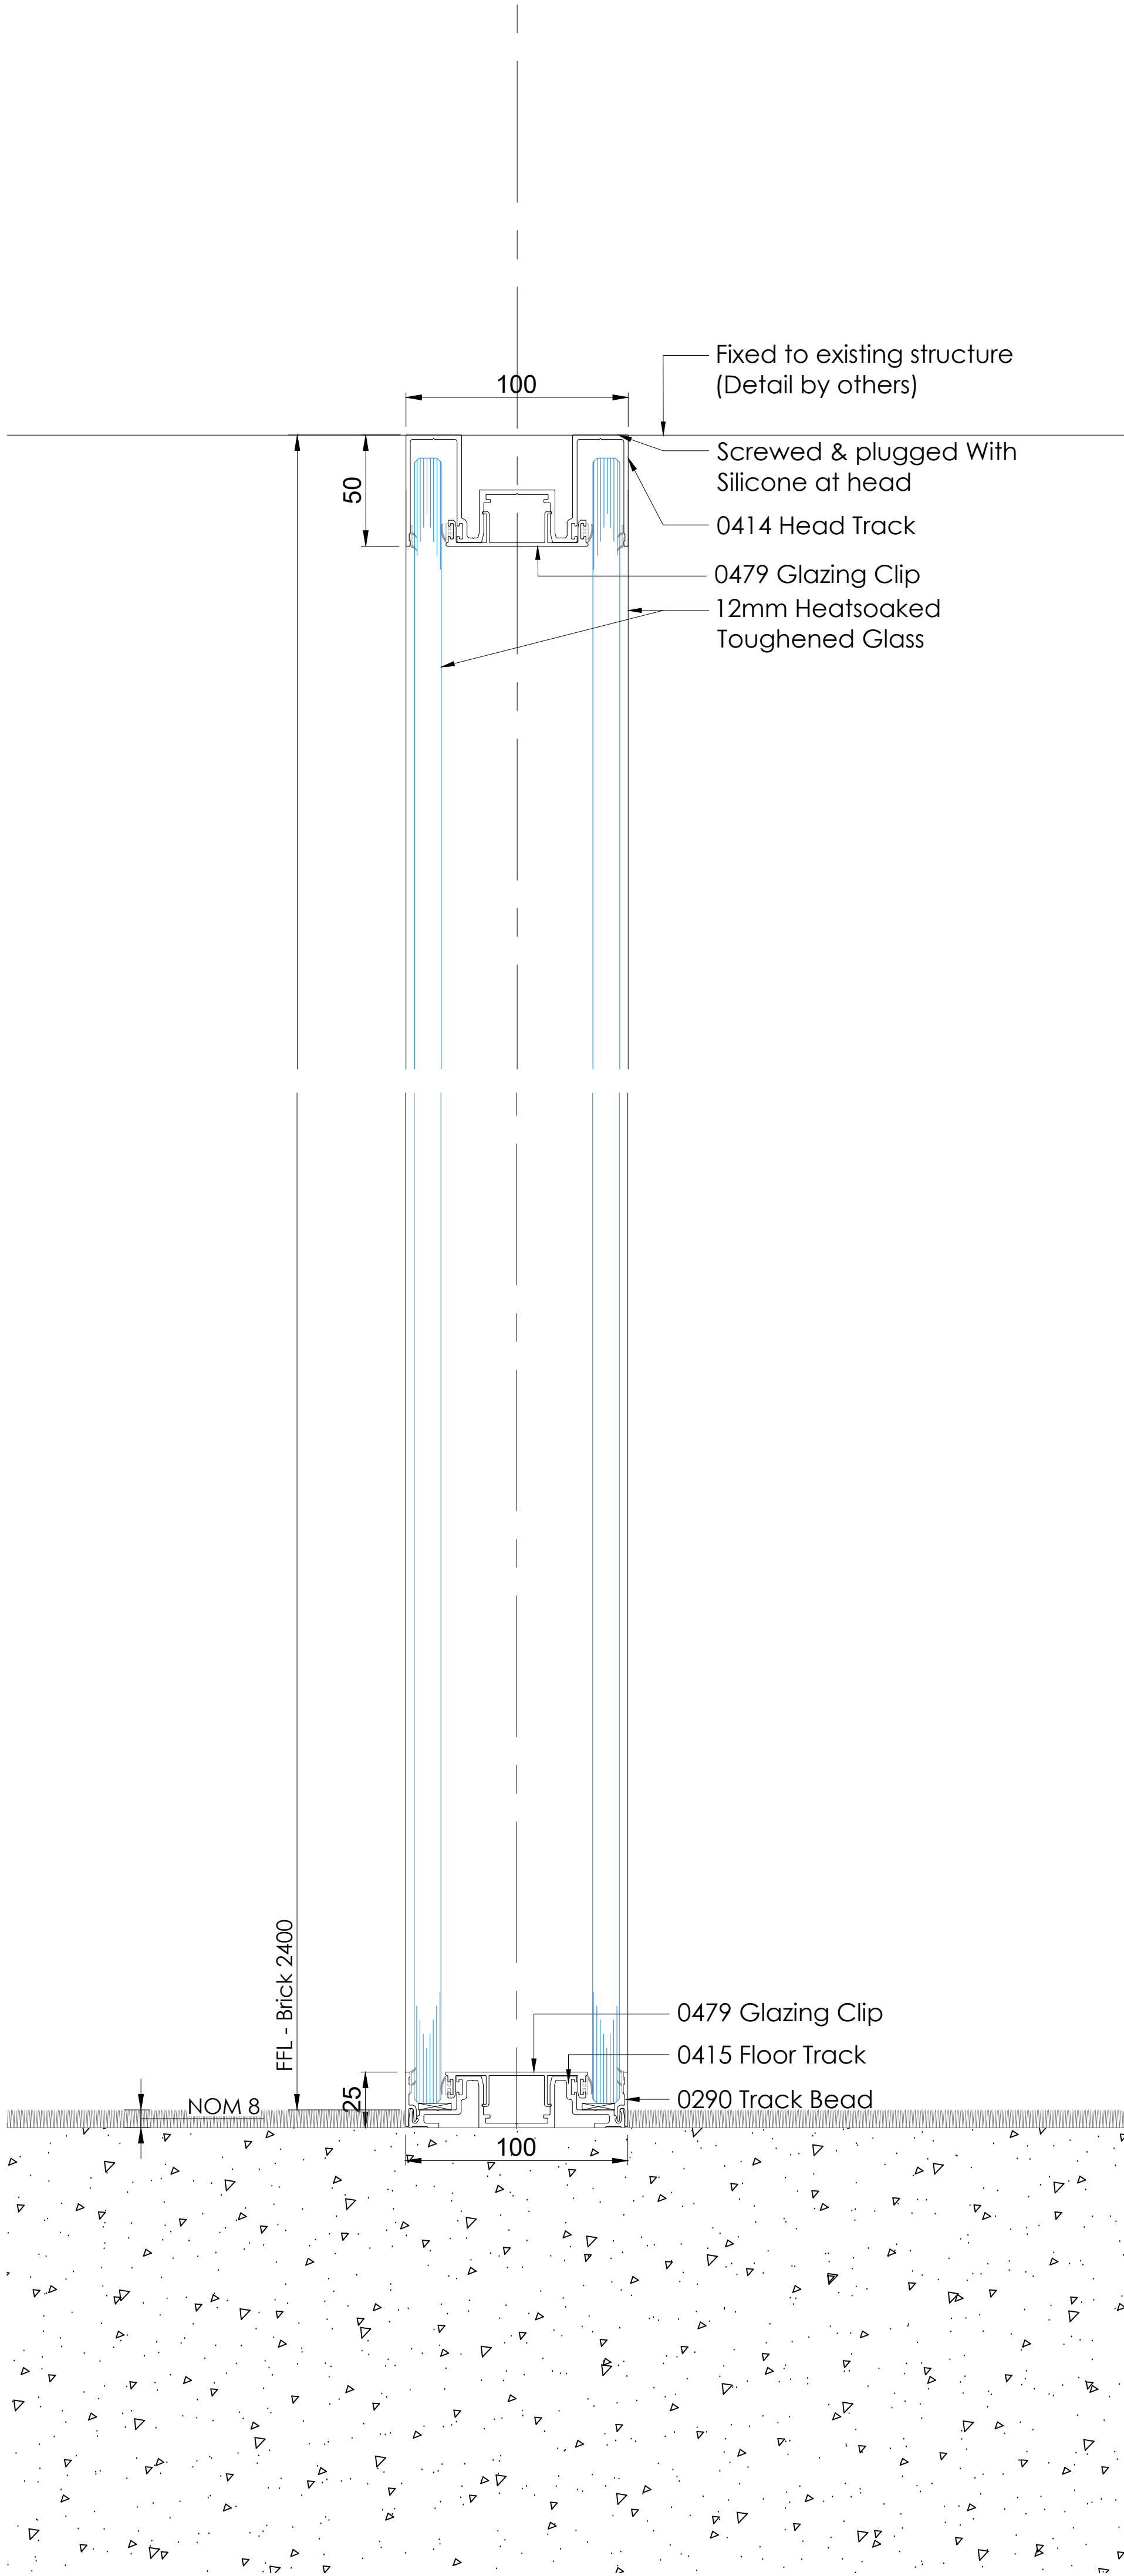


1 SECTION: Screen 4 Revolution 100 Scale 1:2

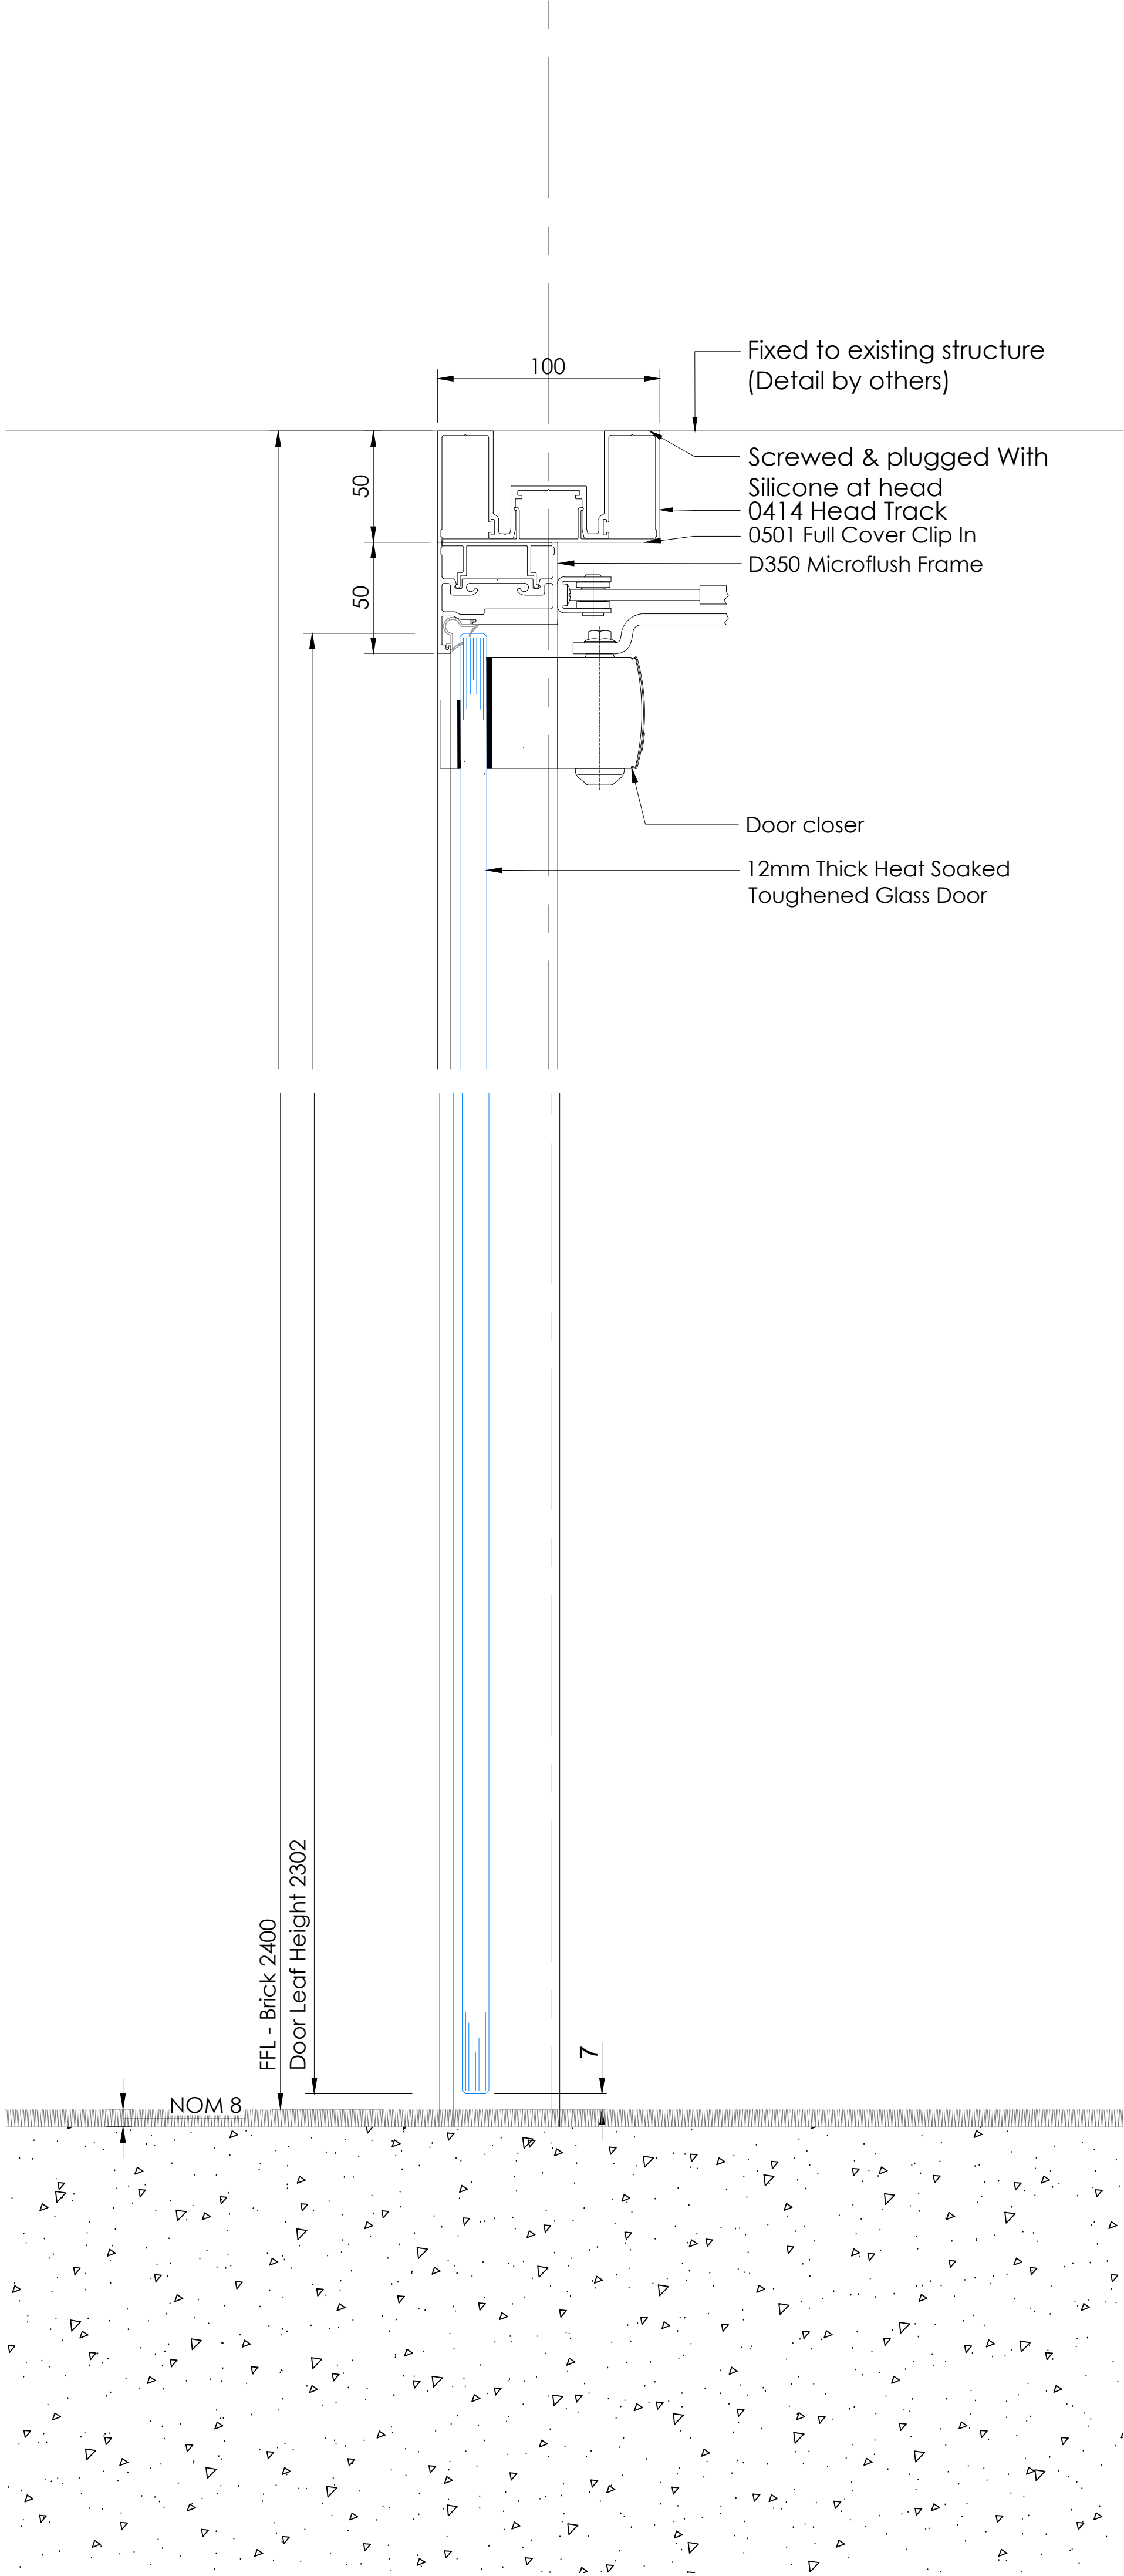


2 SECTION: Door Axile Clarity Scale 1:2

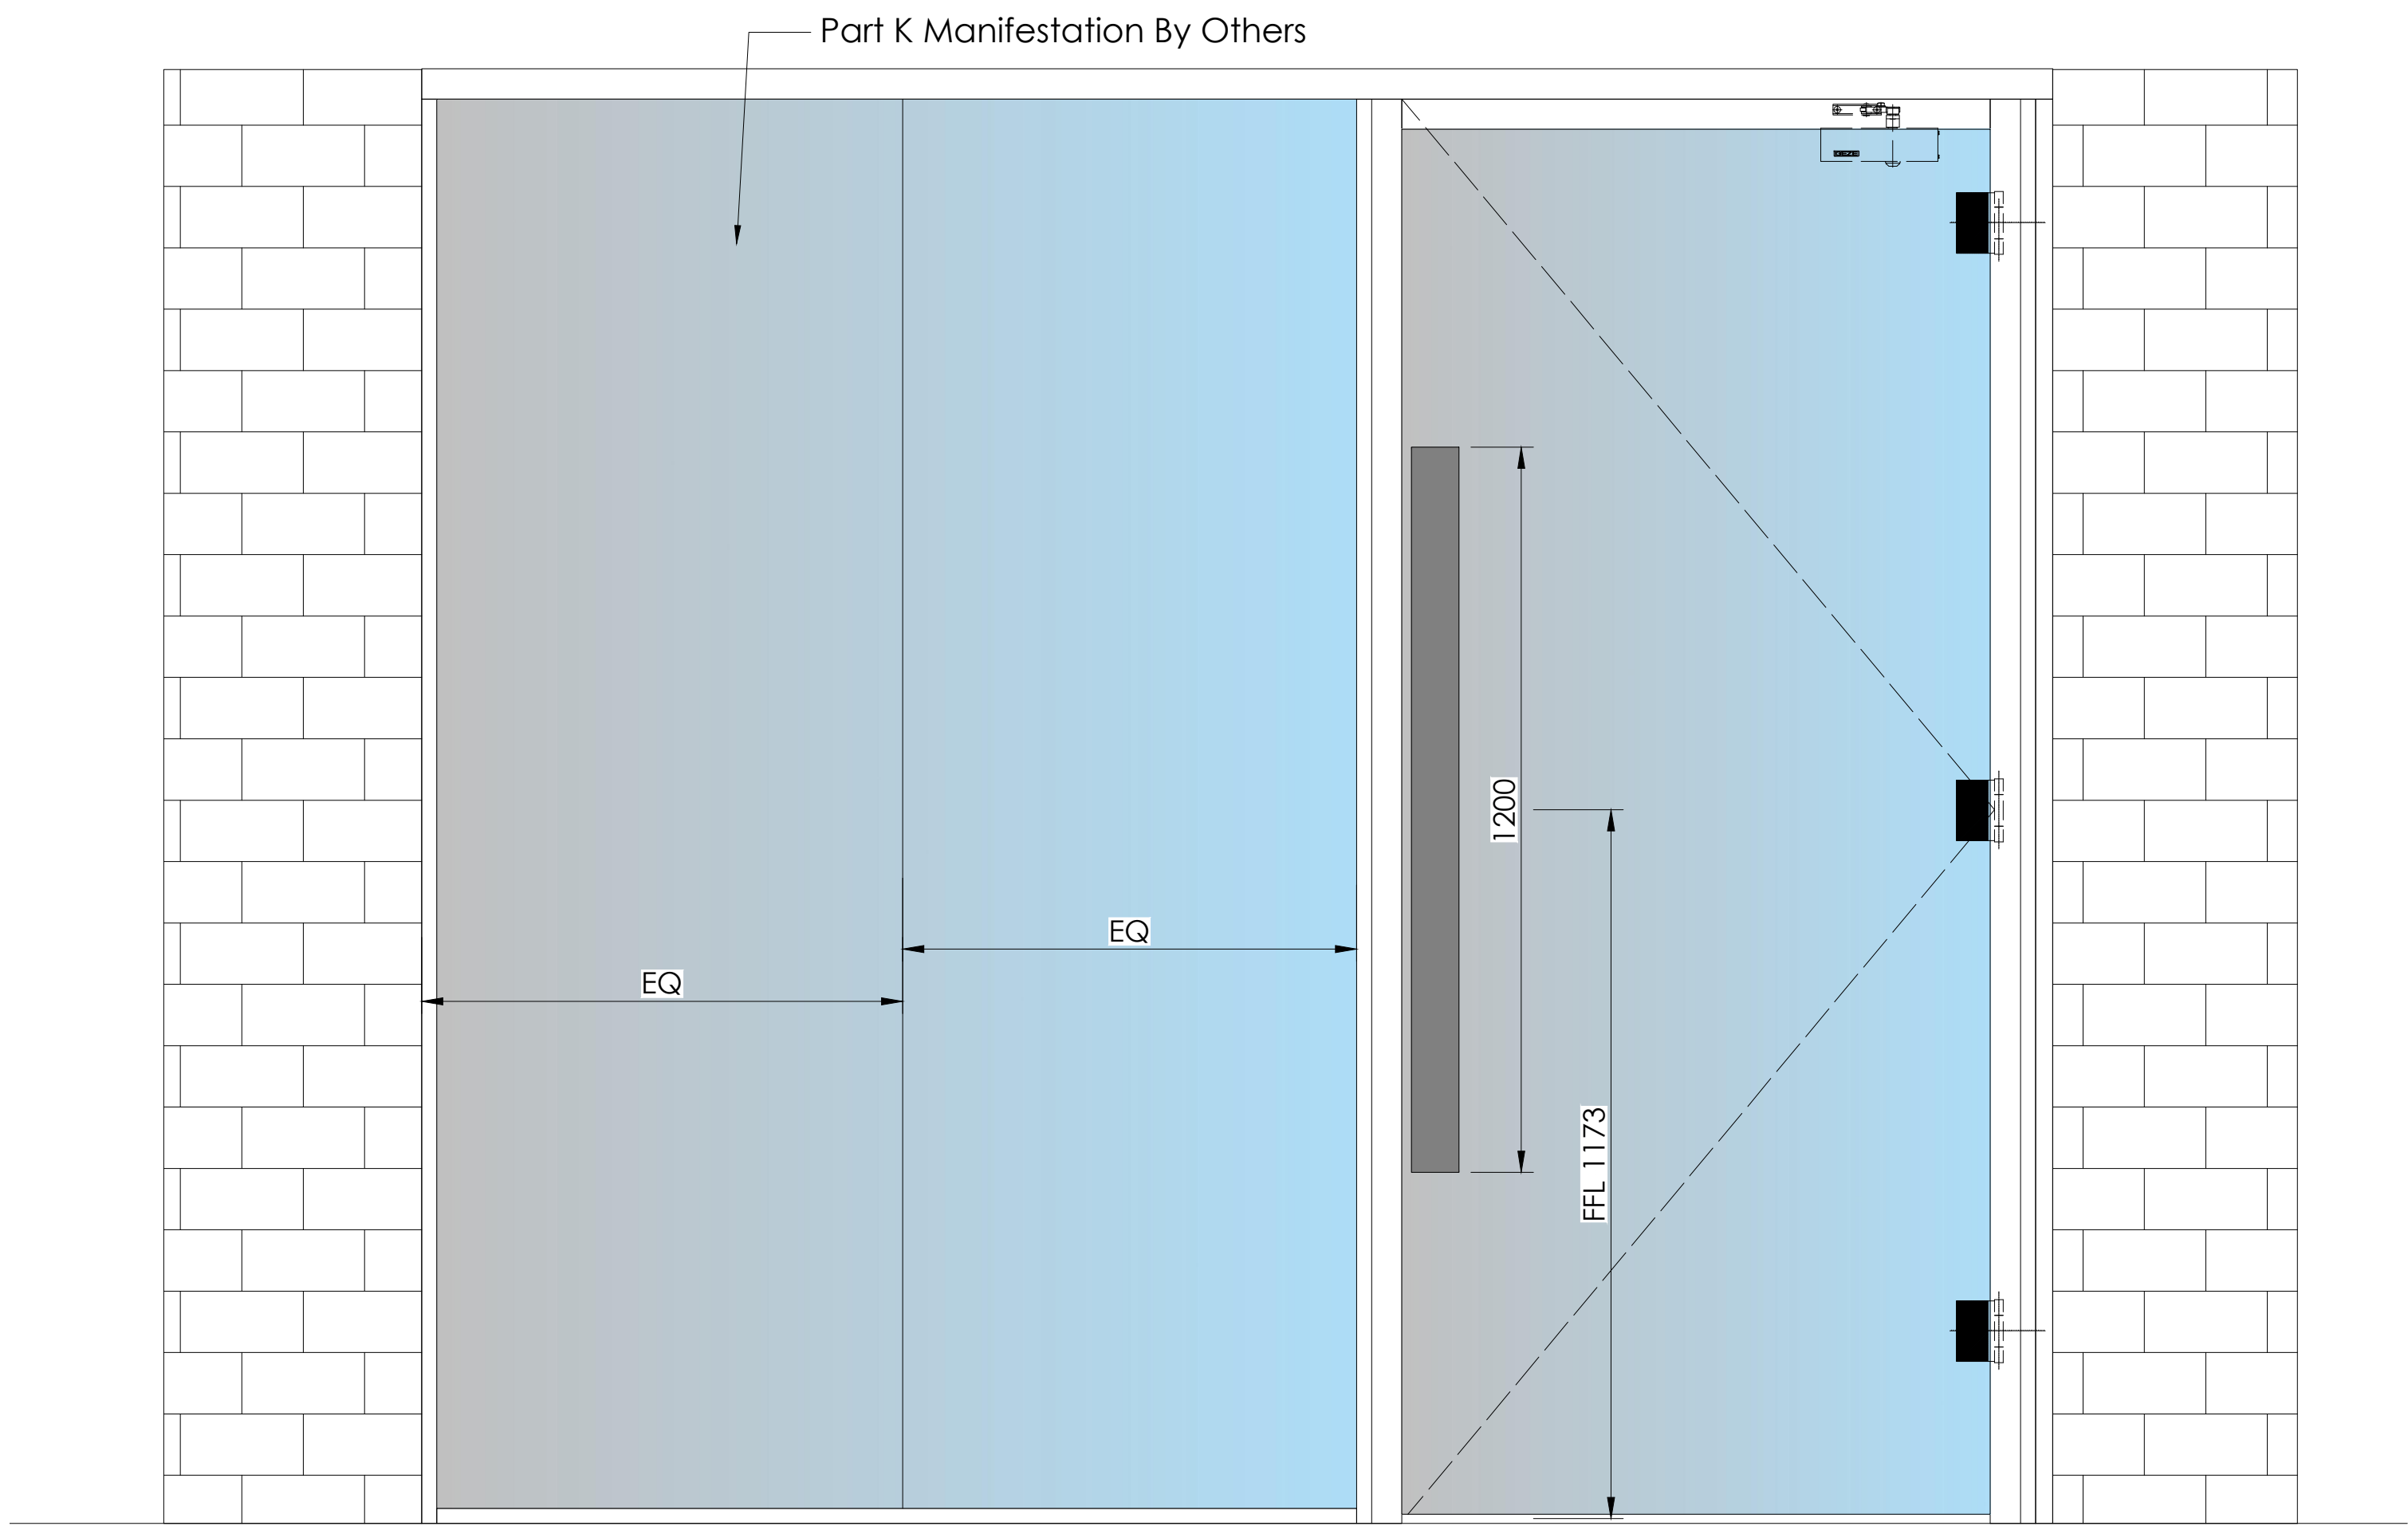


3 Elevation: Screen 4 Revolution 100 - Axile Clarity Door Scale 1:10

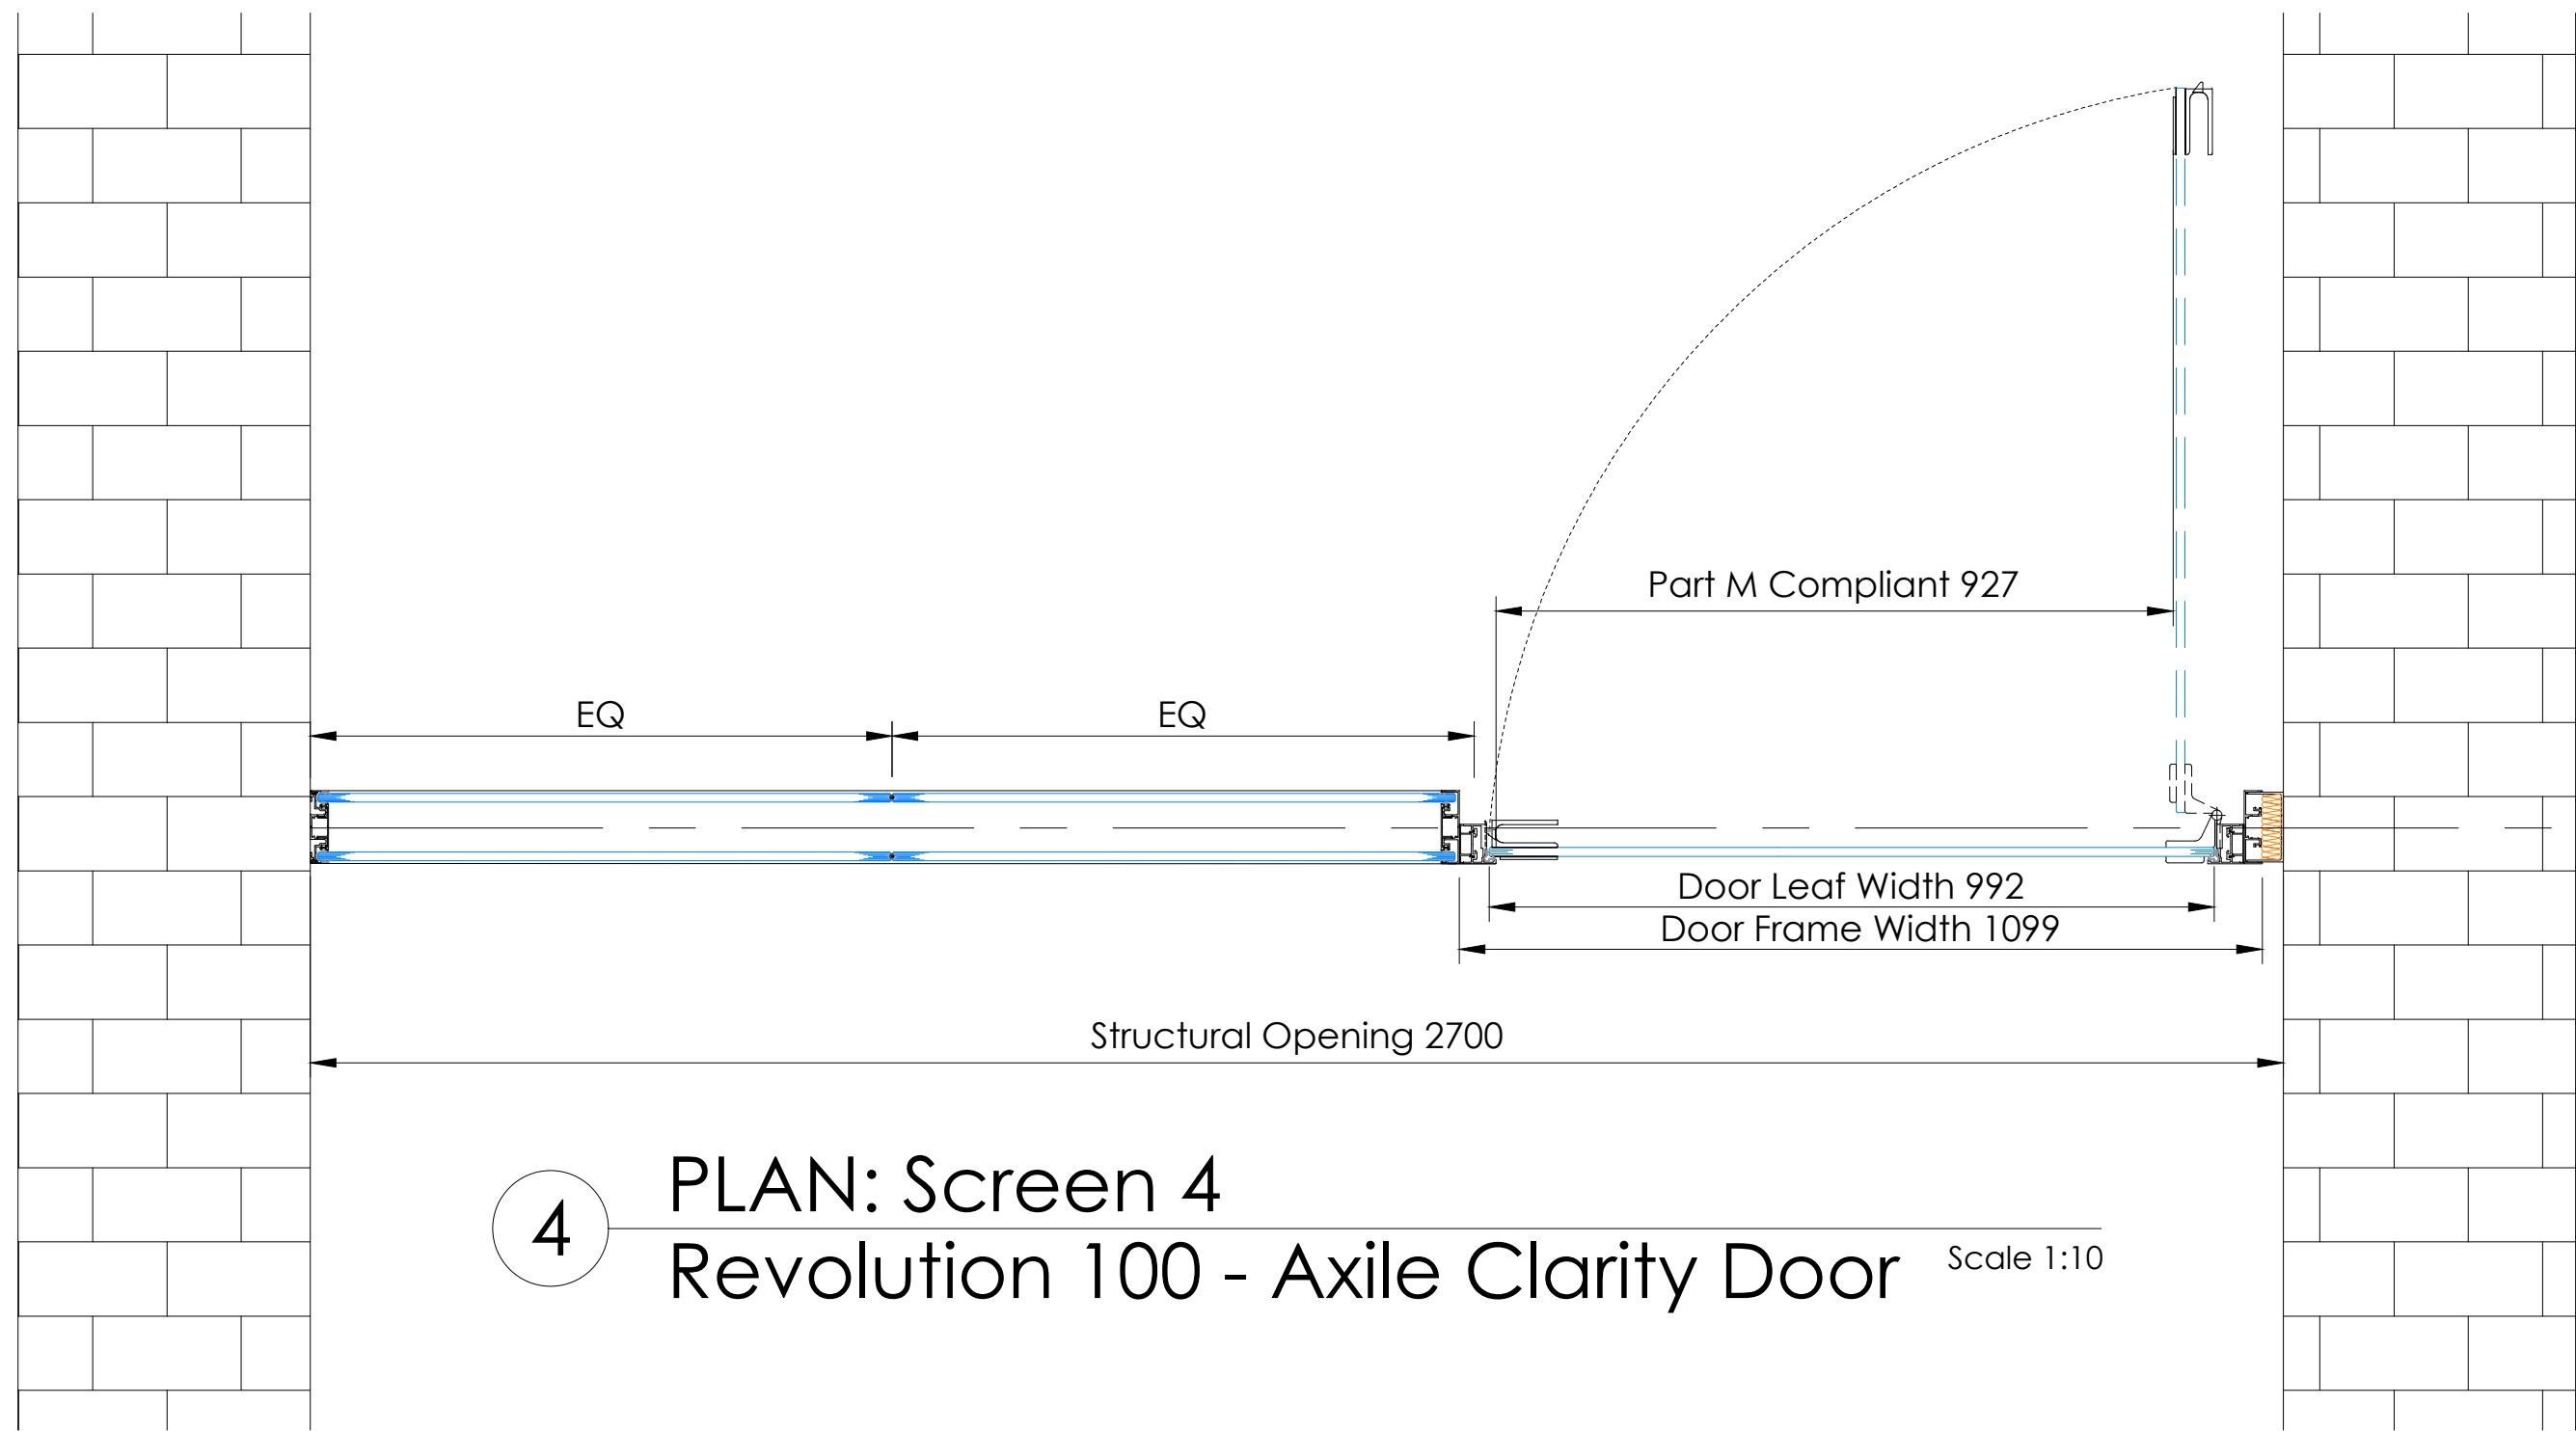


4 PLAN: Screen 4 Revolution 100 - Axile Clarity Door Scale 1:10

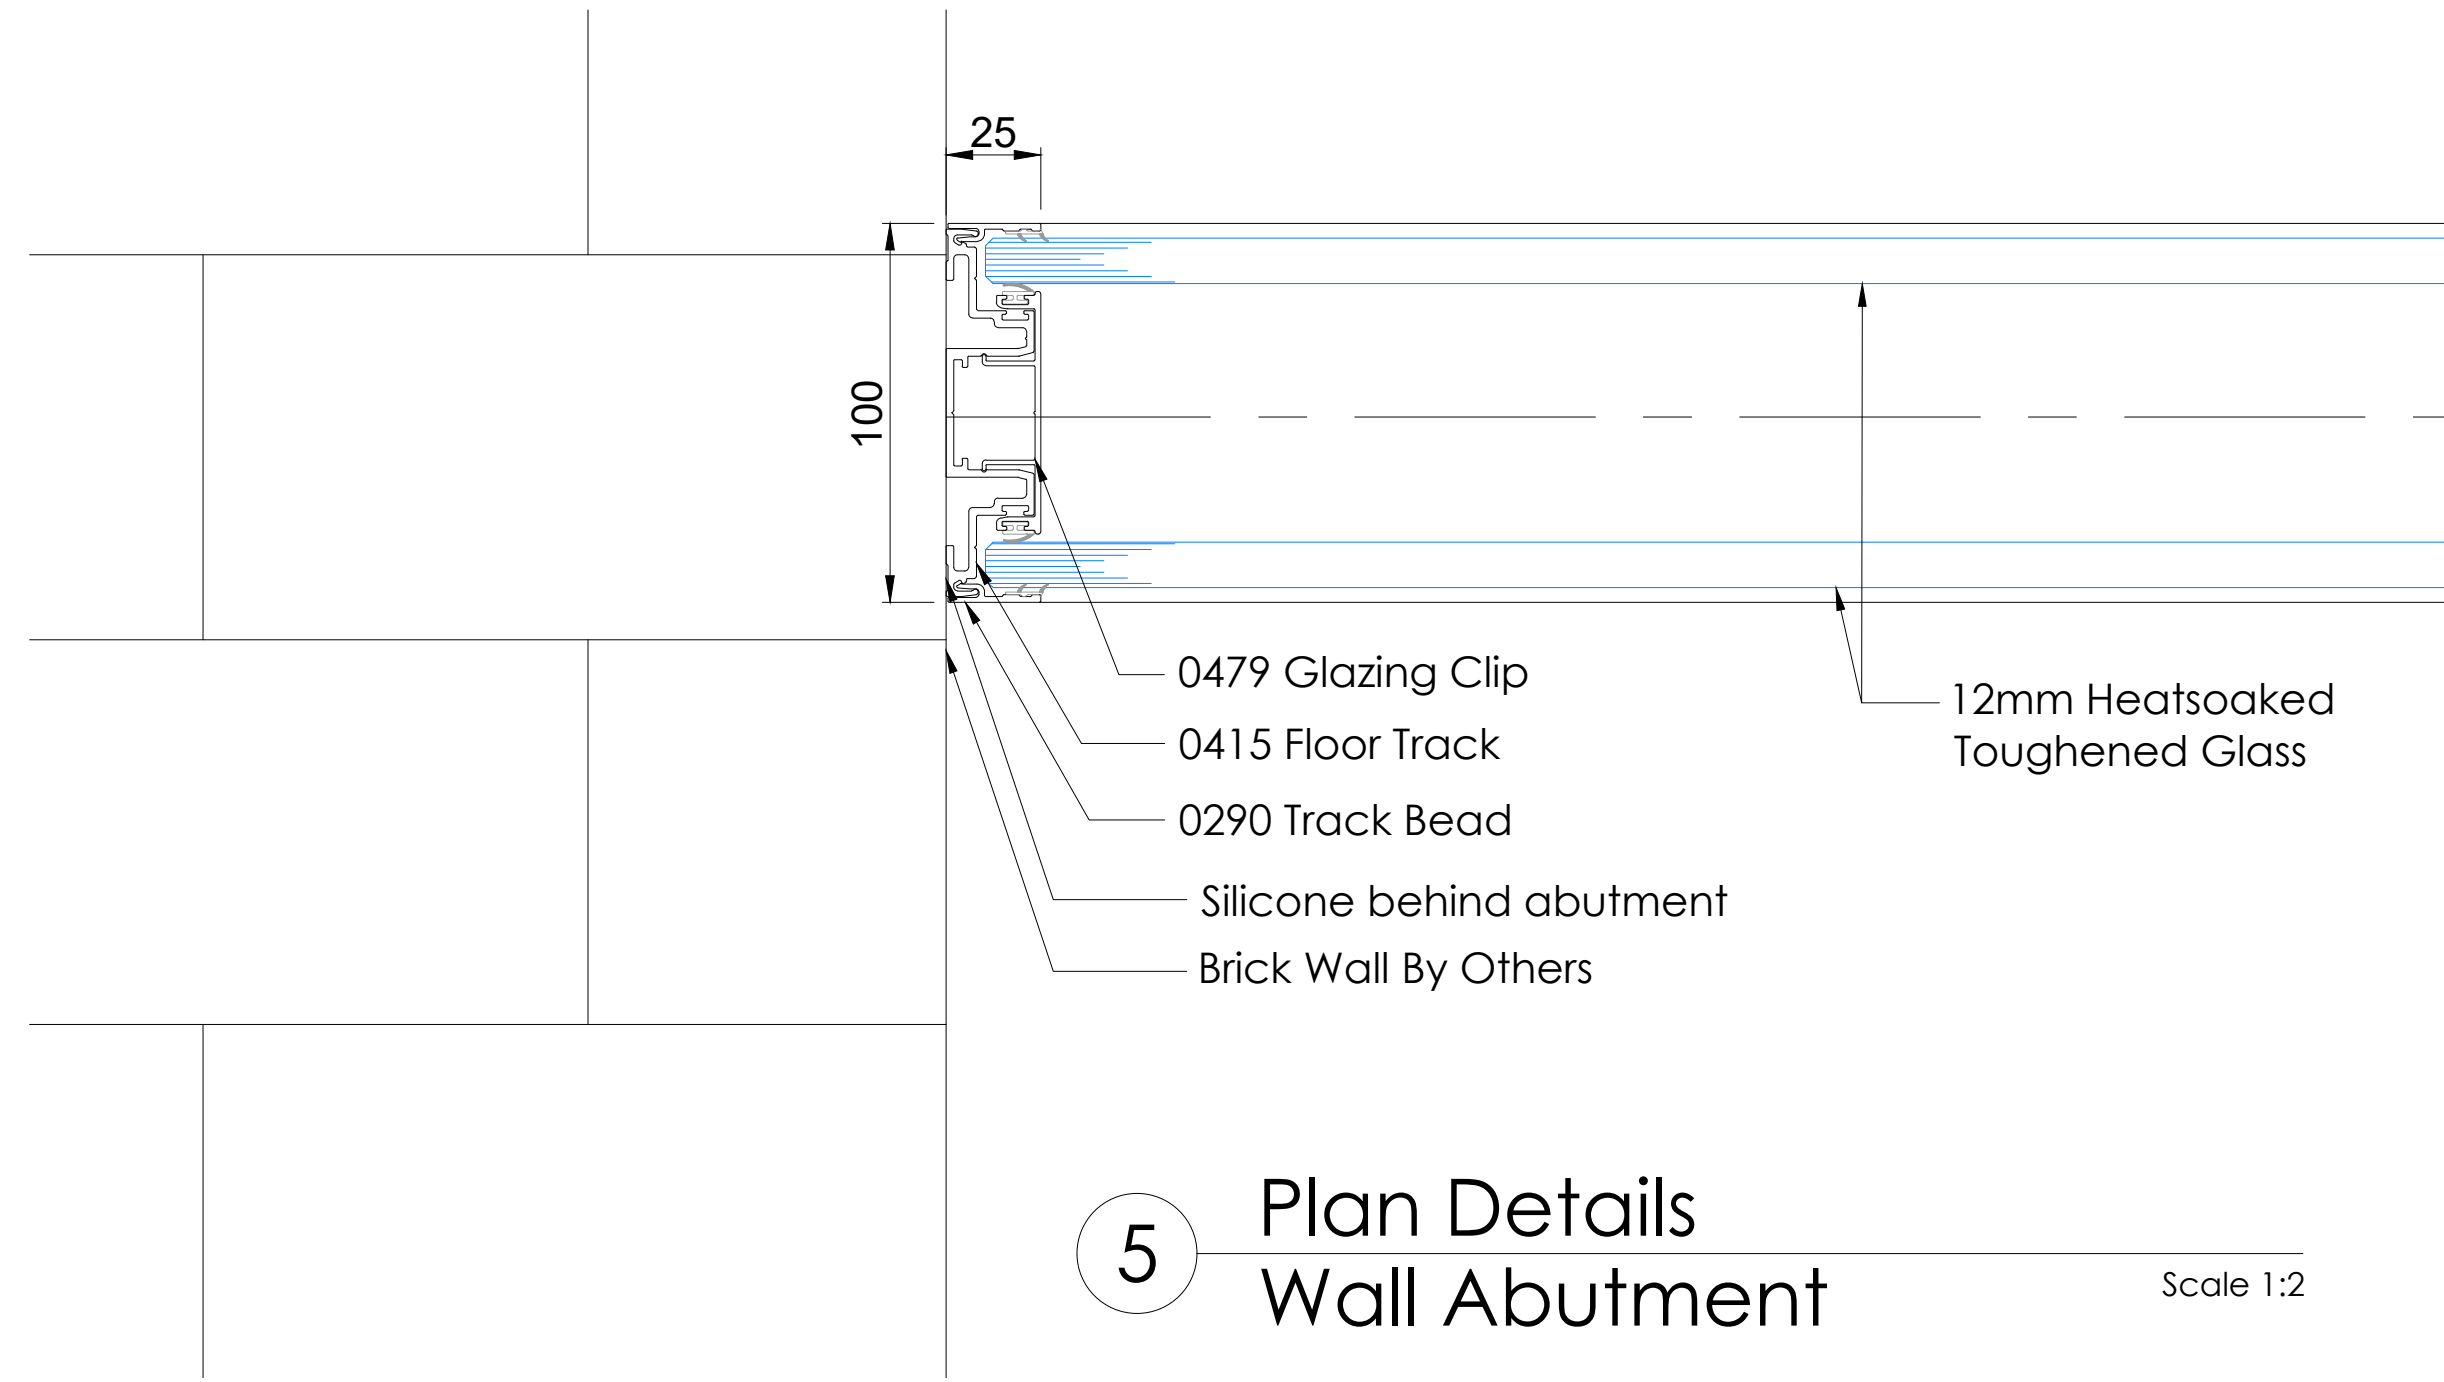


5 Plan Details Wall Abutment Scale 1:2

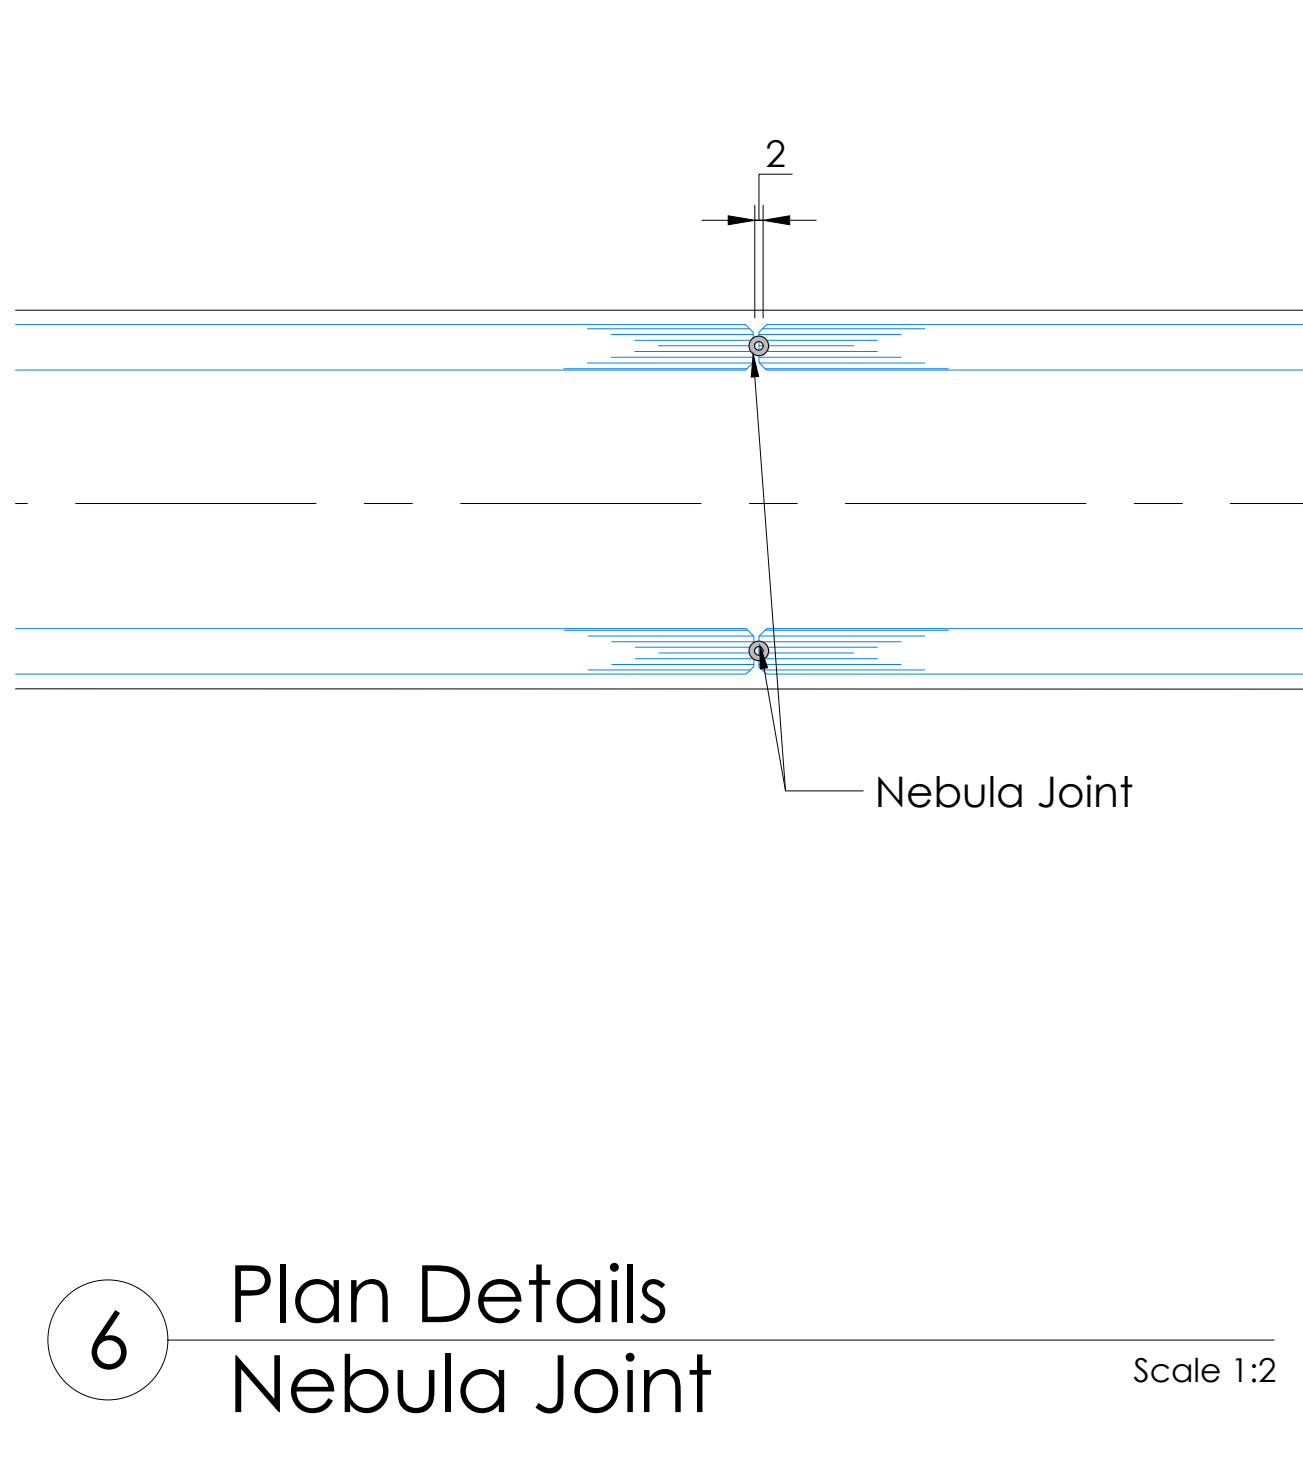

6 Plan Details Nebula Joint Scale 1:2

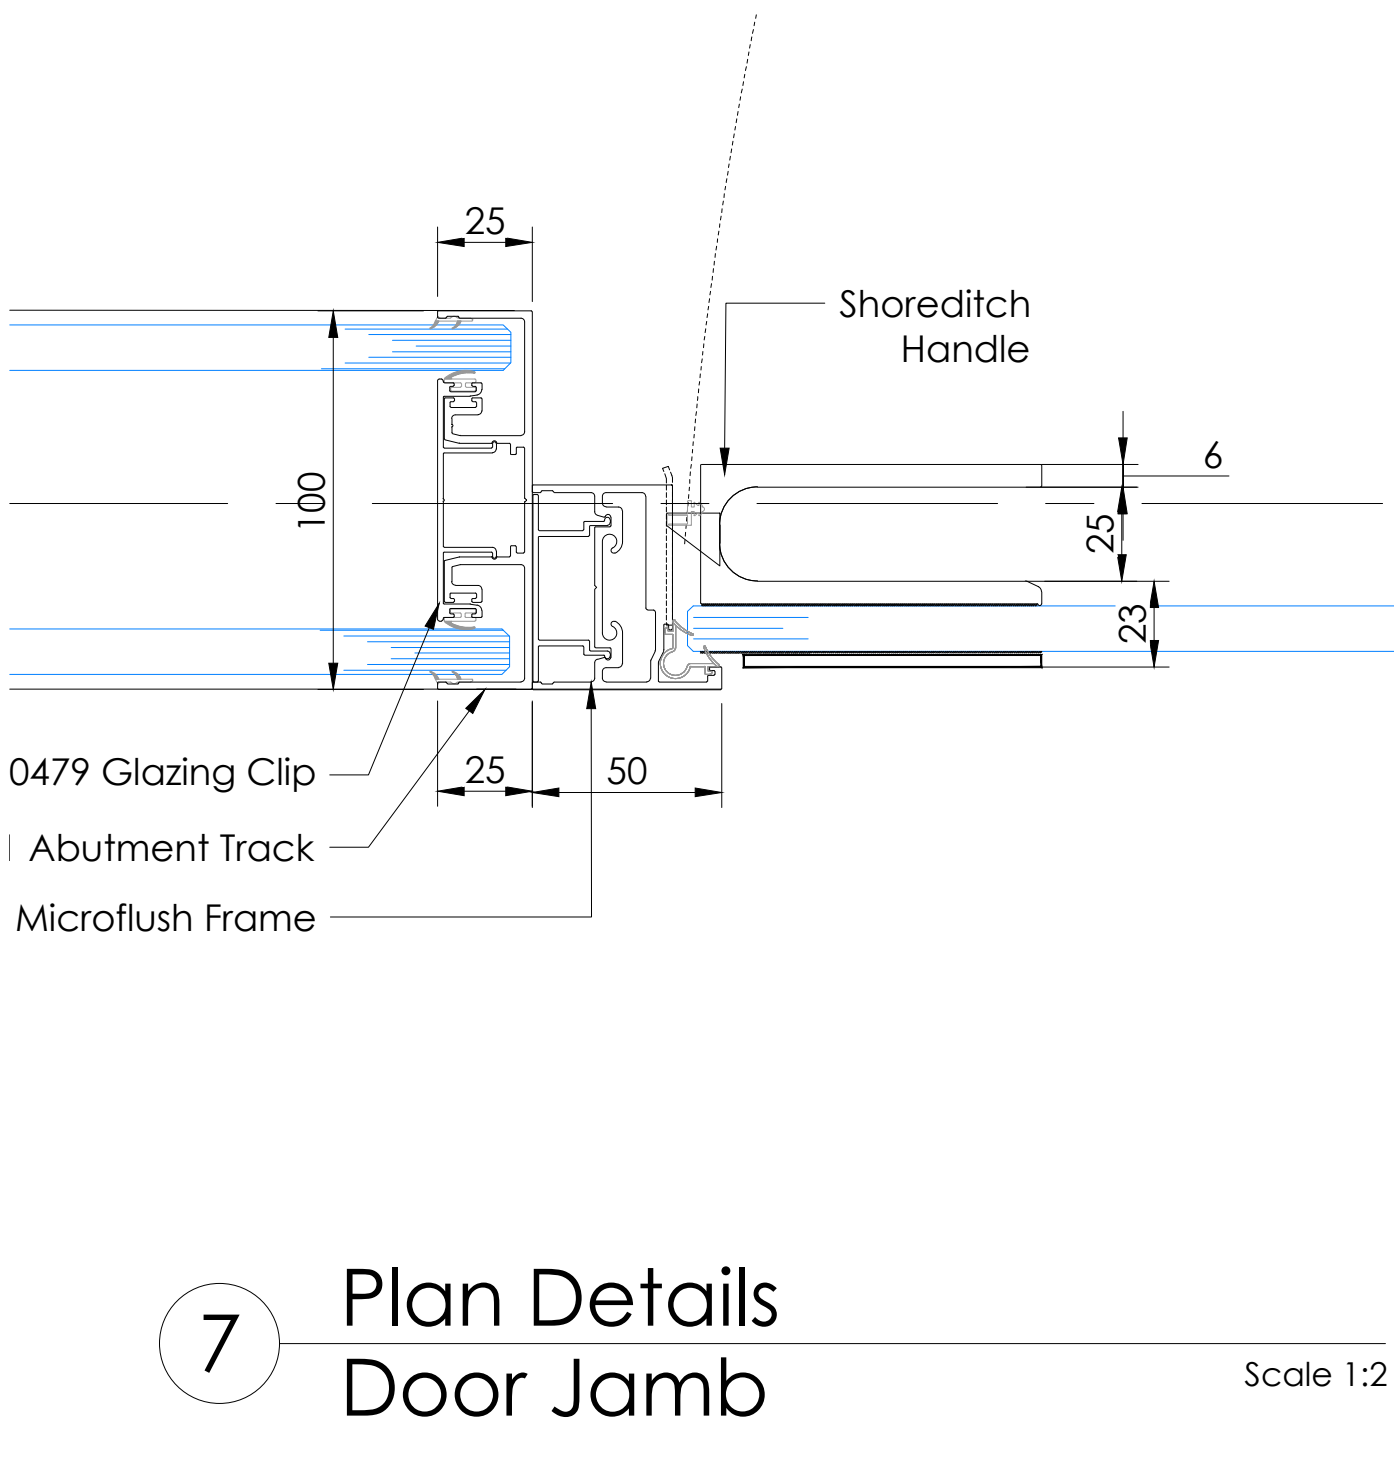

7 Plan Details Door Jamb Scale 1:2

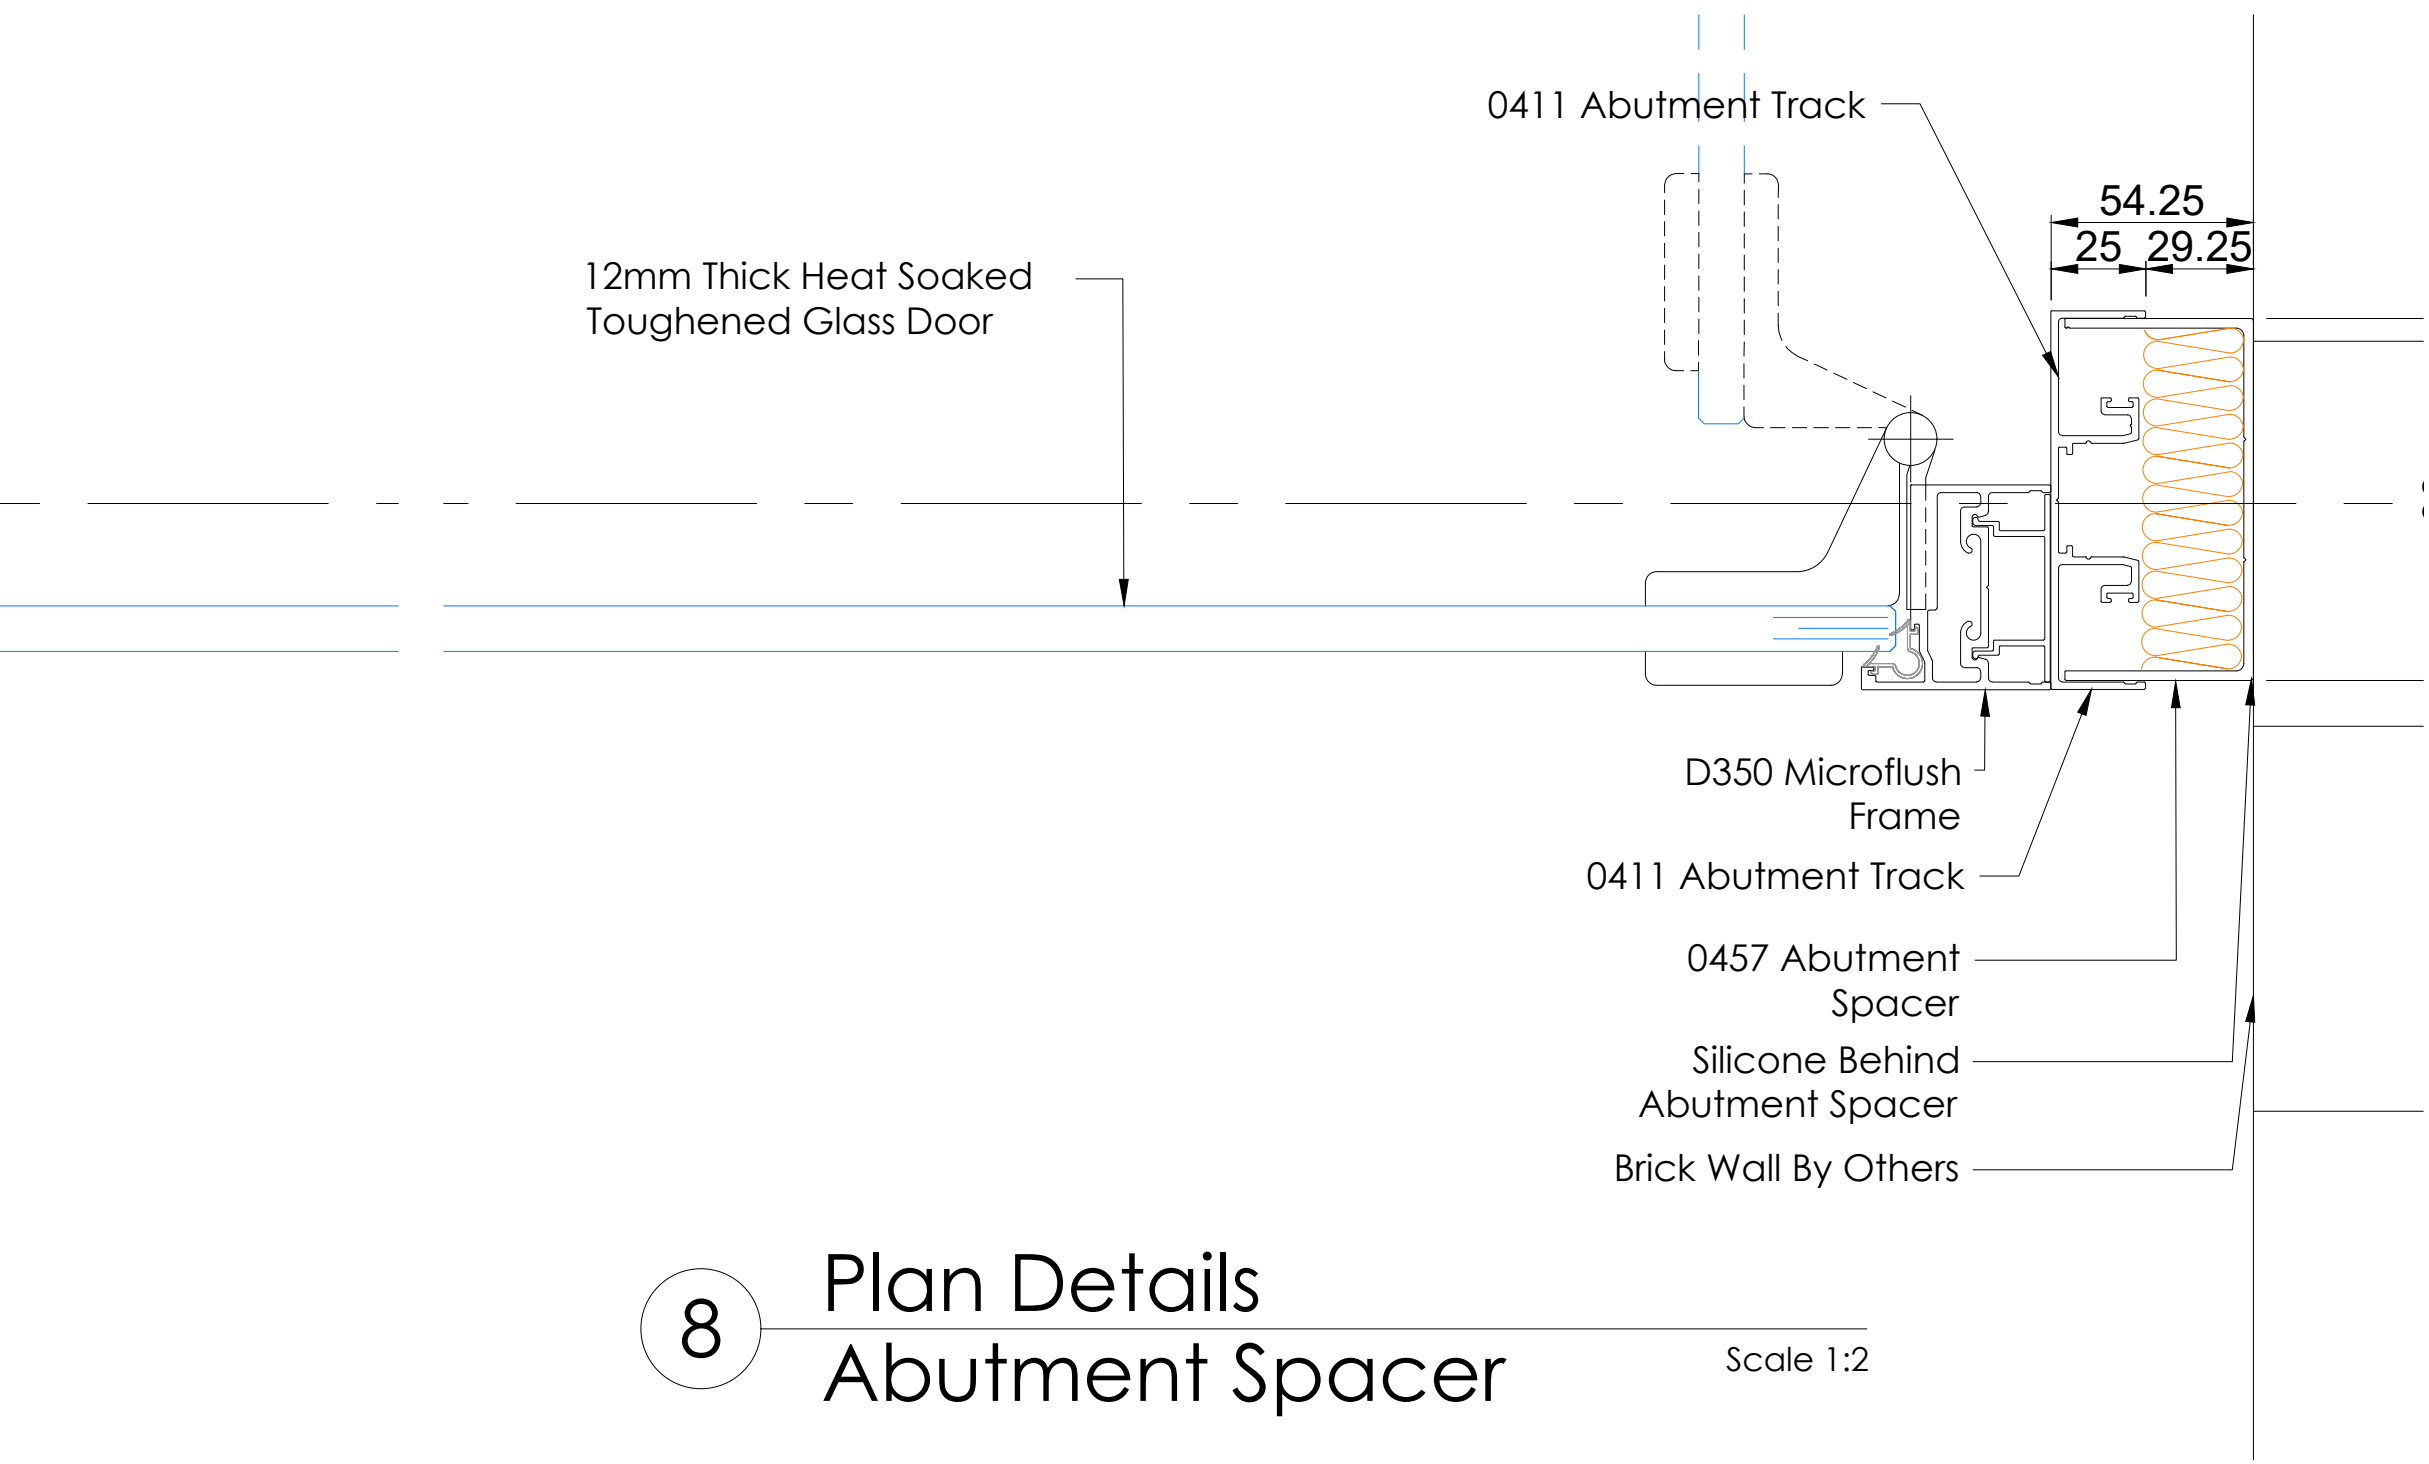

8 Plan Details Abutment Spacer Scale 1:2

Safety Health & Environmental Information Box	
Construction Risks	This project uses only materials that have been used in this region before. From a Designer viewpoint, Optima do not envisage any specific Construction Issues to communicate.
Maintenance / Cleaning Risks	Optima, in the main, provide office partitioning, the components (specifically the glass) are tested to the relevant national or international standards of the glass. As such CLEANING and MAINTENANCE of this product is not a specific risk. However, Optima would point out that all persons involved with maintenance and cleaning should themselves be subject to their own employer's specific risk assessment policies. Special care should be taken if working at height. In such cases the regulations of the day apply. Optima do not recommend any loadings against its products.
Demolition / Adaptation Risks	From the viewpoint of a Designer, Optima have identified no significant risks for demolition and adaptation. However, the usual risk assessments are presumed to be implemented by the company proposing demolition and/or adaptation.
Environmental / Recycling	Much of the Optima range of product is recyclable, cable. See original terms and conditions for clarification. Environmental issues are subject to the law of the day.
In addition to the hazards / risks normally associated with the types of work detailed on this drawing take note of the above. It is assumed that all work on this drawing will be carried out by competent contractors meeting where appropriate, to an approved method statement.	

General Information Table 1005

Door/Partition	
Door/Partition Type	Revolution 100 - Screen 4/ Axile Clarity Door
Floors	2
Acoustic Rating	Screen: Rw45dB/ Door: N/A
Ironmongery Set	Shoreditch Pull Handles/ Door Closer/ patch fittings RAL 9005
Door Finish	N/A
Frame Finish	RAL 9005
Deflection	N/A
Glass	12mm thick heat soaked toughened/ X2 12mm thick heat soaked toughened

Structural Openings To Be Checked On Site

ISSUED
31/03/20
Rev: Rev00
AS BUILT

AB	31.03.20	As Built	CC	CT	GM
Rev	Date	Description	Dr	App	Ck

Status:

As Built

Optima

© Optima Products Ltd.
OPTIMA CONTRACTING LIMITED
COURTYARD HOUSE
WEST END ROAD
HIGH WYCOMBE
BUCKINGHAMSHIRE
HP11 2QB
Tel: +44 (0) 1494 492600
Web: www.optimaystems.com

Project:
50195 Bonded Warehouse L2

Title:
Revolution 100
Screen 4 With Axile Clarity Door

Scale @ A0: Varies
Drawing No.: OPT-DRG-1005
Revision: AB