


Do not scale from this drawing. All dimensions to be checked on-site by contractor to ensure accuracy prior to any installation. All design work produced by Ampsec Ltd is for indicative purposes only. It is the client and contractors responsibility to ensure that building control and fire officer approval have been met prior to commencement of site work

	FLOOR FINISHES
	Existing timber floor
	Floor Elements Birch Vornen Vinyl
WALL FINISHES	
	Black Diamond PEG 900
	Black MF mat, white Black White Emulsion
	Paint to existing metal columns
	Paint to new plasterboard partition
BALUSTRADES / HANDRAILS	
	Black lacquered metal balustrade
CEILING TYPES	
	CL-01
	New painted plasterboard MF ceiling with suspended brick soffits and steel beams
CEILING FINISHES	
	Paint to plasterboard MF ceiling
	Paint to existing steel beams
LIGHT FITTINGS	
	LI-04
	Existing linear lights - adjusted to be surface mounted

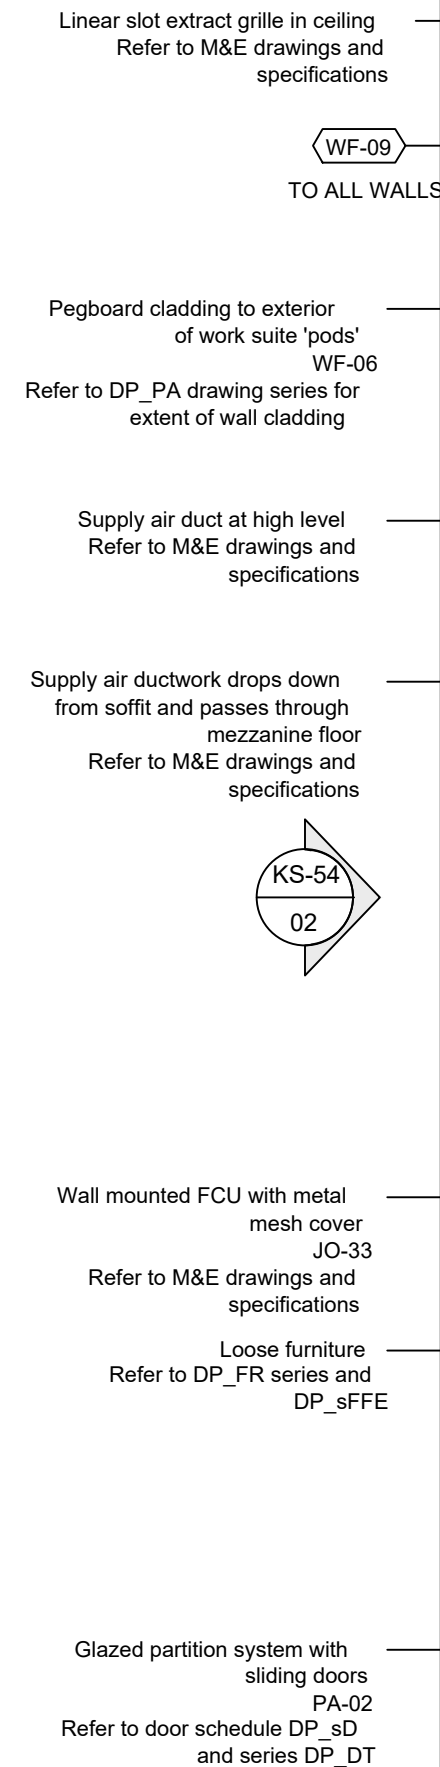

REV:	DESCRIPTION:	BY:	DATE:
STATUS: AS BUILT			
			
DESIGN & BUILD SOLUTIONS			
t: 01942 421342 f: 01942 226552 www.amspec.co.uk			
CUSTOMER:	OBI 80 MOSELY STREET MANCHESTER M2 3FX		
ARCHITECT:			
SITE:	18 LOWER BYROM STREET MANCHESTER		
TITLE:	LEVEL 3 DP WORKS HUB TYPICAL WORK SUITES POD PLAN		
SCALE: A1:	DATE:	DRAWN:	CHECKED:
1:30	27.06.19	CR	IC
PROJECT NO:	DRAWING NO:		REVISION:
1683	DP_KS-50		