

Morgan Sindall

GCH-WID-XX-EL-RP-X-0001




Thursday, 9 June

Revisions
08-06-2022_P01

Drawing State



Draft

MORGAN SINDALL		S4-Construction/Info Exchange
	A	Information Exchange – No Comments
	B	Information Exchange – With Comments. Please revise and resubmit with comments incorporated
	AC	For Construction – No Comments
X	BC	For Construction – With Comments. Please revise and resubmit with comments incorporated
	C	Rejected - Please revise and resubmit with comments incorporated
Reviewed by (Sign and Date):		
PB 14/06/2022		

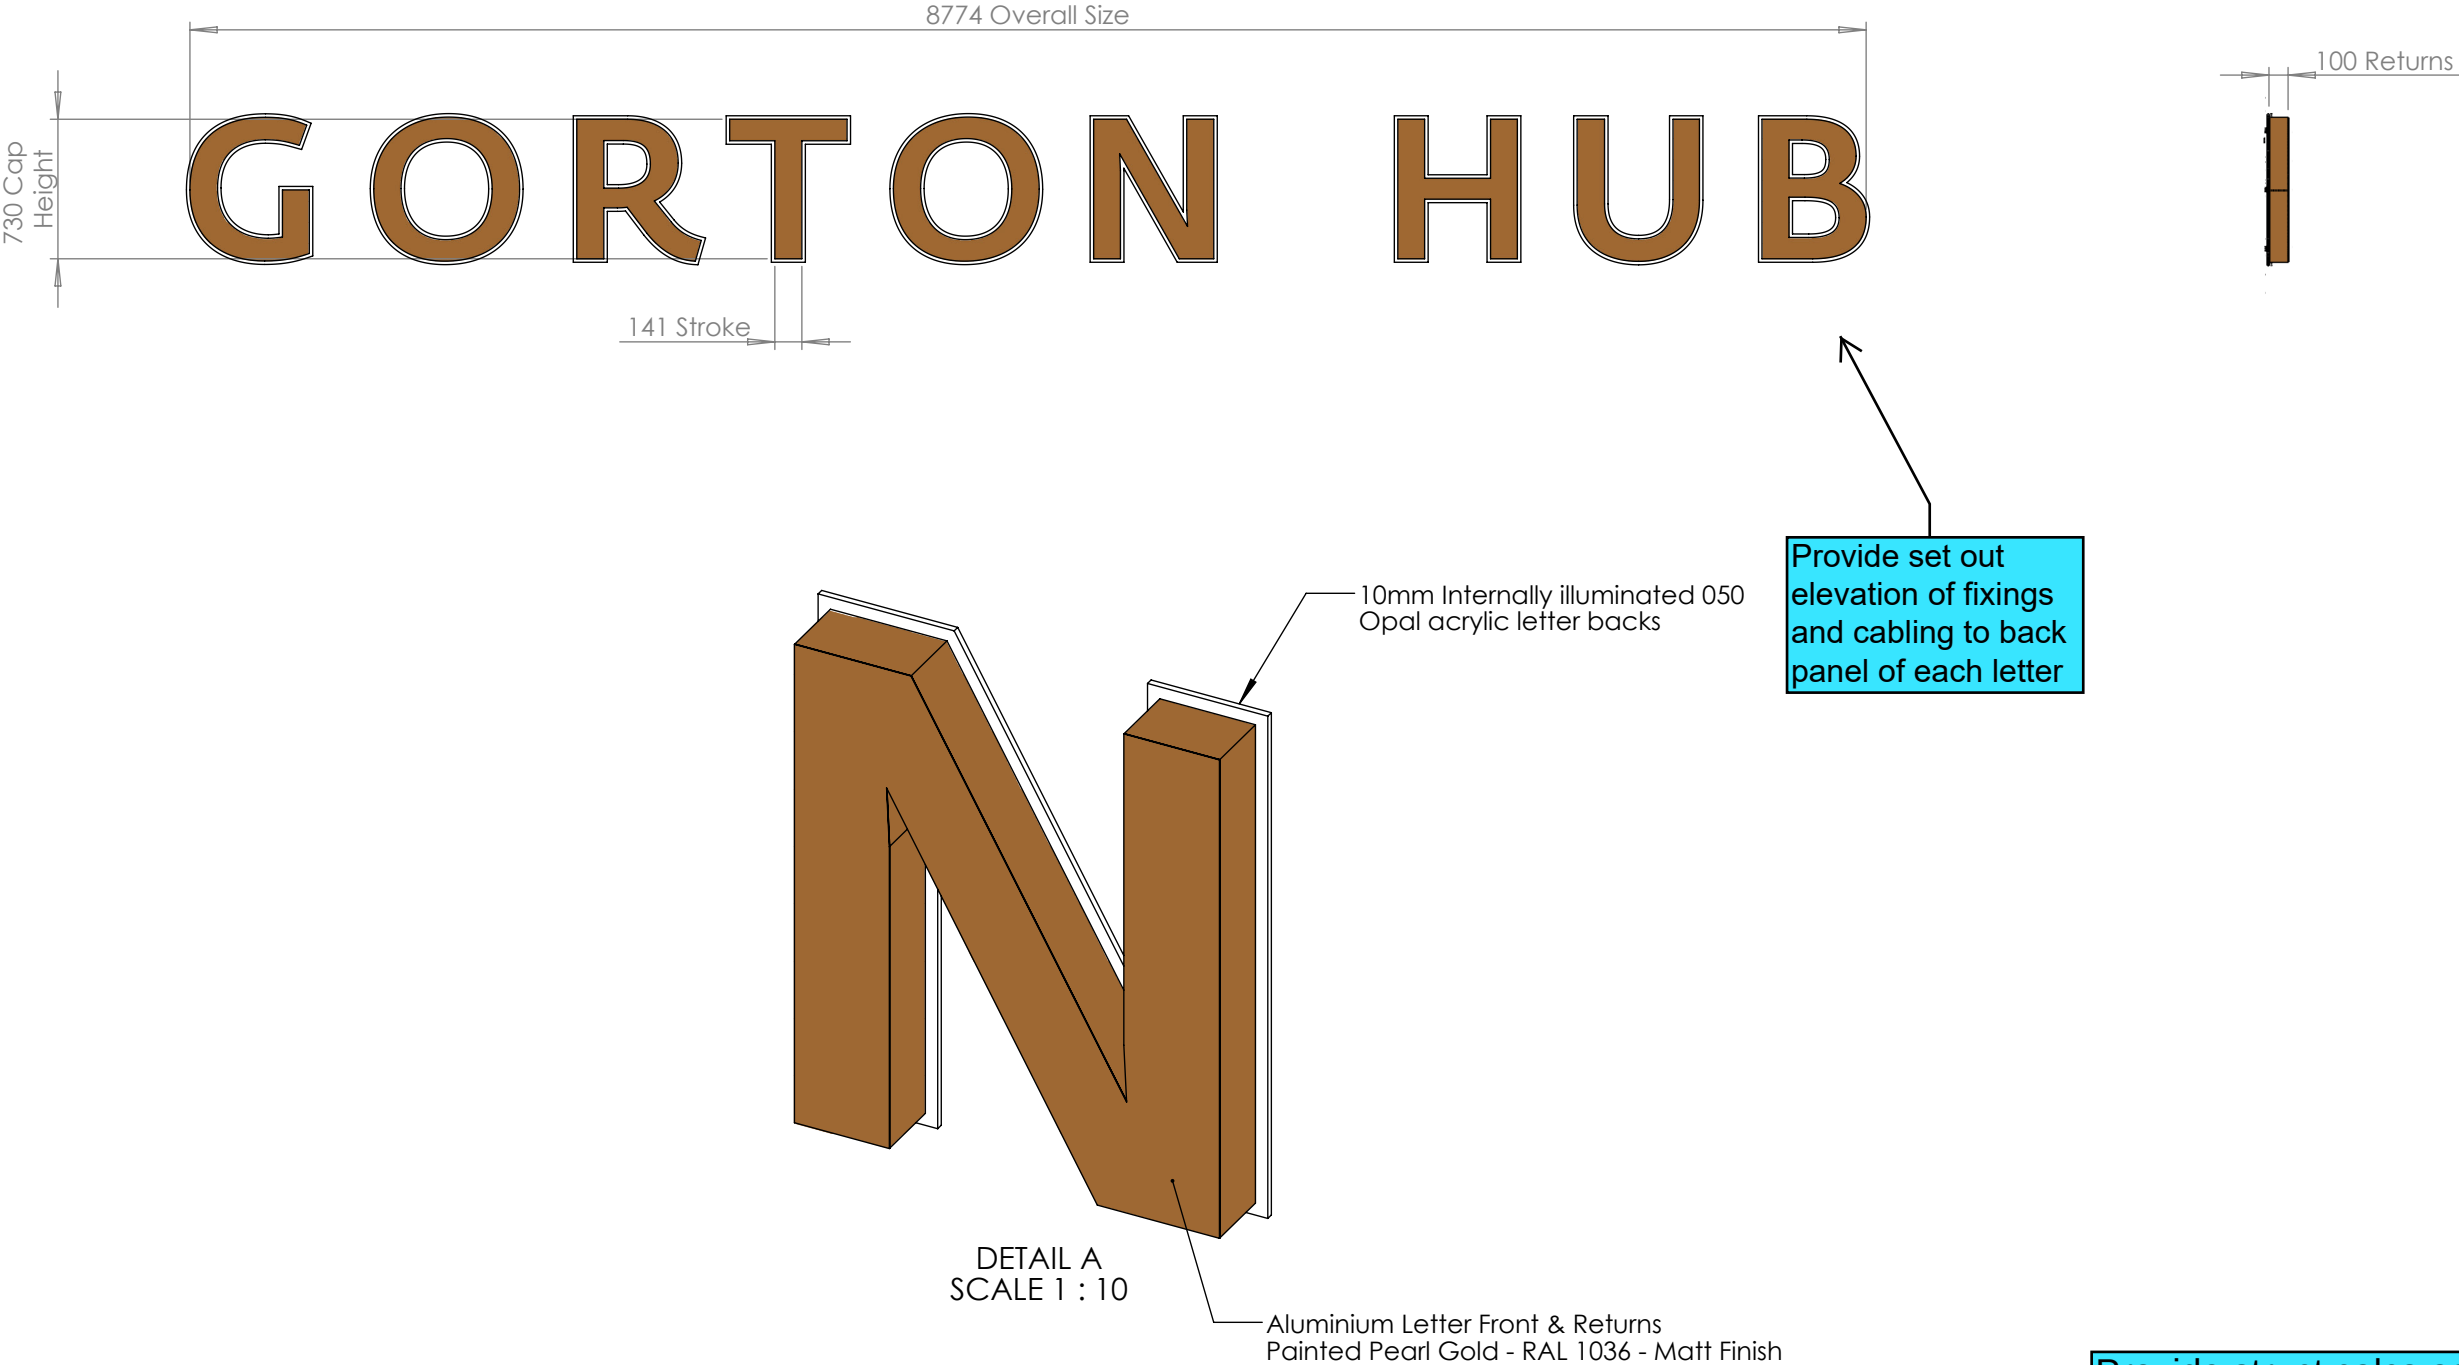

- 01 - General Arrangement
- Individual built-up letters reading "GORTON HUB"
 - 800mm cap height with 100mm returns
 - 2mm aluminium fronts & returns painted Pearl Gold RAL 1036 Matt
 - 10mm 050 Opal acrylic oversized letter backs
 - Internally illuminated with Sloan spectrum with individually controlled RGBW LEDs, controlled with Casambi wireless software system
 - Mechanically fixed to brick work with screws & plugs on parapet wall
 - LED drivers to be housed in IP 65 rated enclosure unit mounted on roof side of parapet wall
 - Font: Fedra Sans Medium (As received)
 - Size: 8774mm x 730mm
 - Quantity: 2 (North & South Elevations)


Draft	
Vinyl	NA
Paint	Pearl Gold - RAL 1036 Matt
Print	NA
Scale	1 : 40
Rev	0

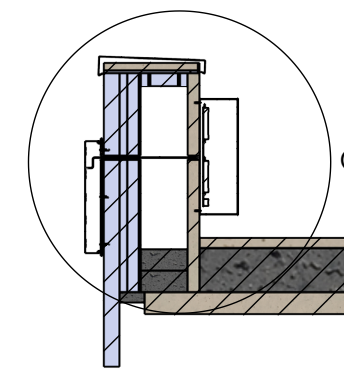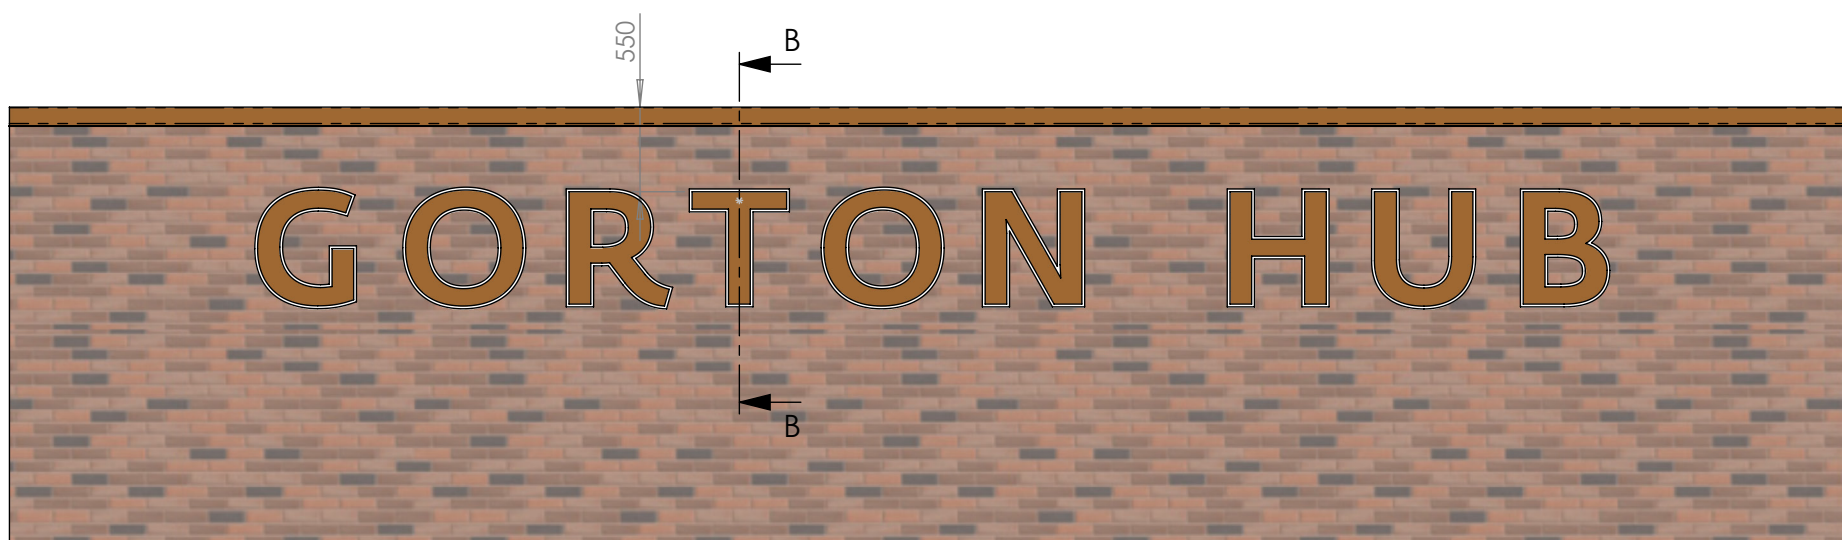

SECTION B-B



01 - South Elevation

- Individual built-up letters reading "GORTON HUB"
- 800mm cap height with 100mm returns
- 2mm aluminium fronts & returns painted Pearl Gold RAL 1036 Matt
- 10mm 050 Opal acrylic oversized letter backs
- Internally illuminated with Sloan spectrum with individually controlled RGBW LEDs, controlled with Casambi wireless software system
- Mechanically fixed to brick work with screws & plugs on parapet wall
- LED drivers to be housed in IP 65 rated enclosure unit mounted on roof side of parapet wall
- Font: Fedra Sans Medium (As received)
- Size: 8774mm x 730mm
- Quantity: 2 (North & South Elevations)

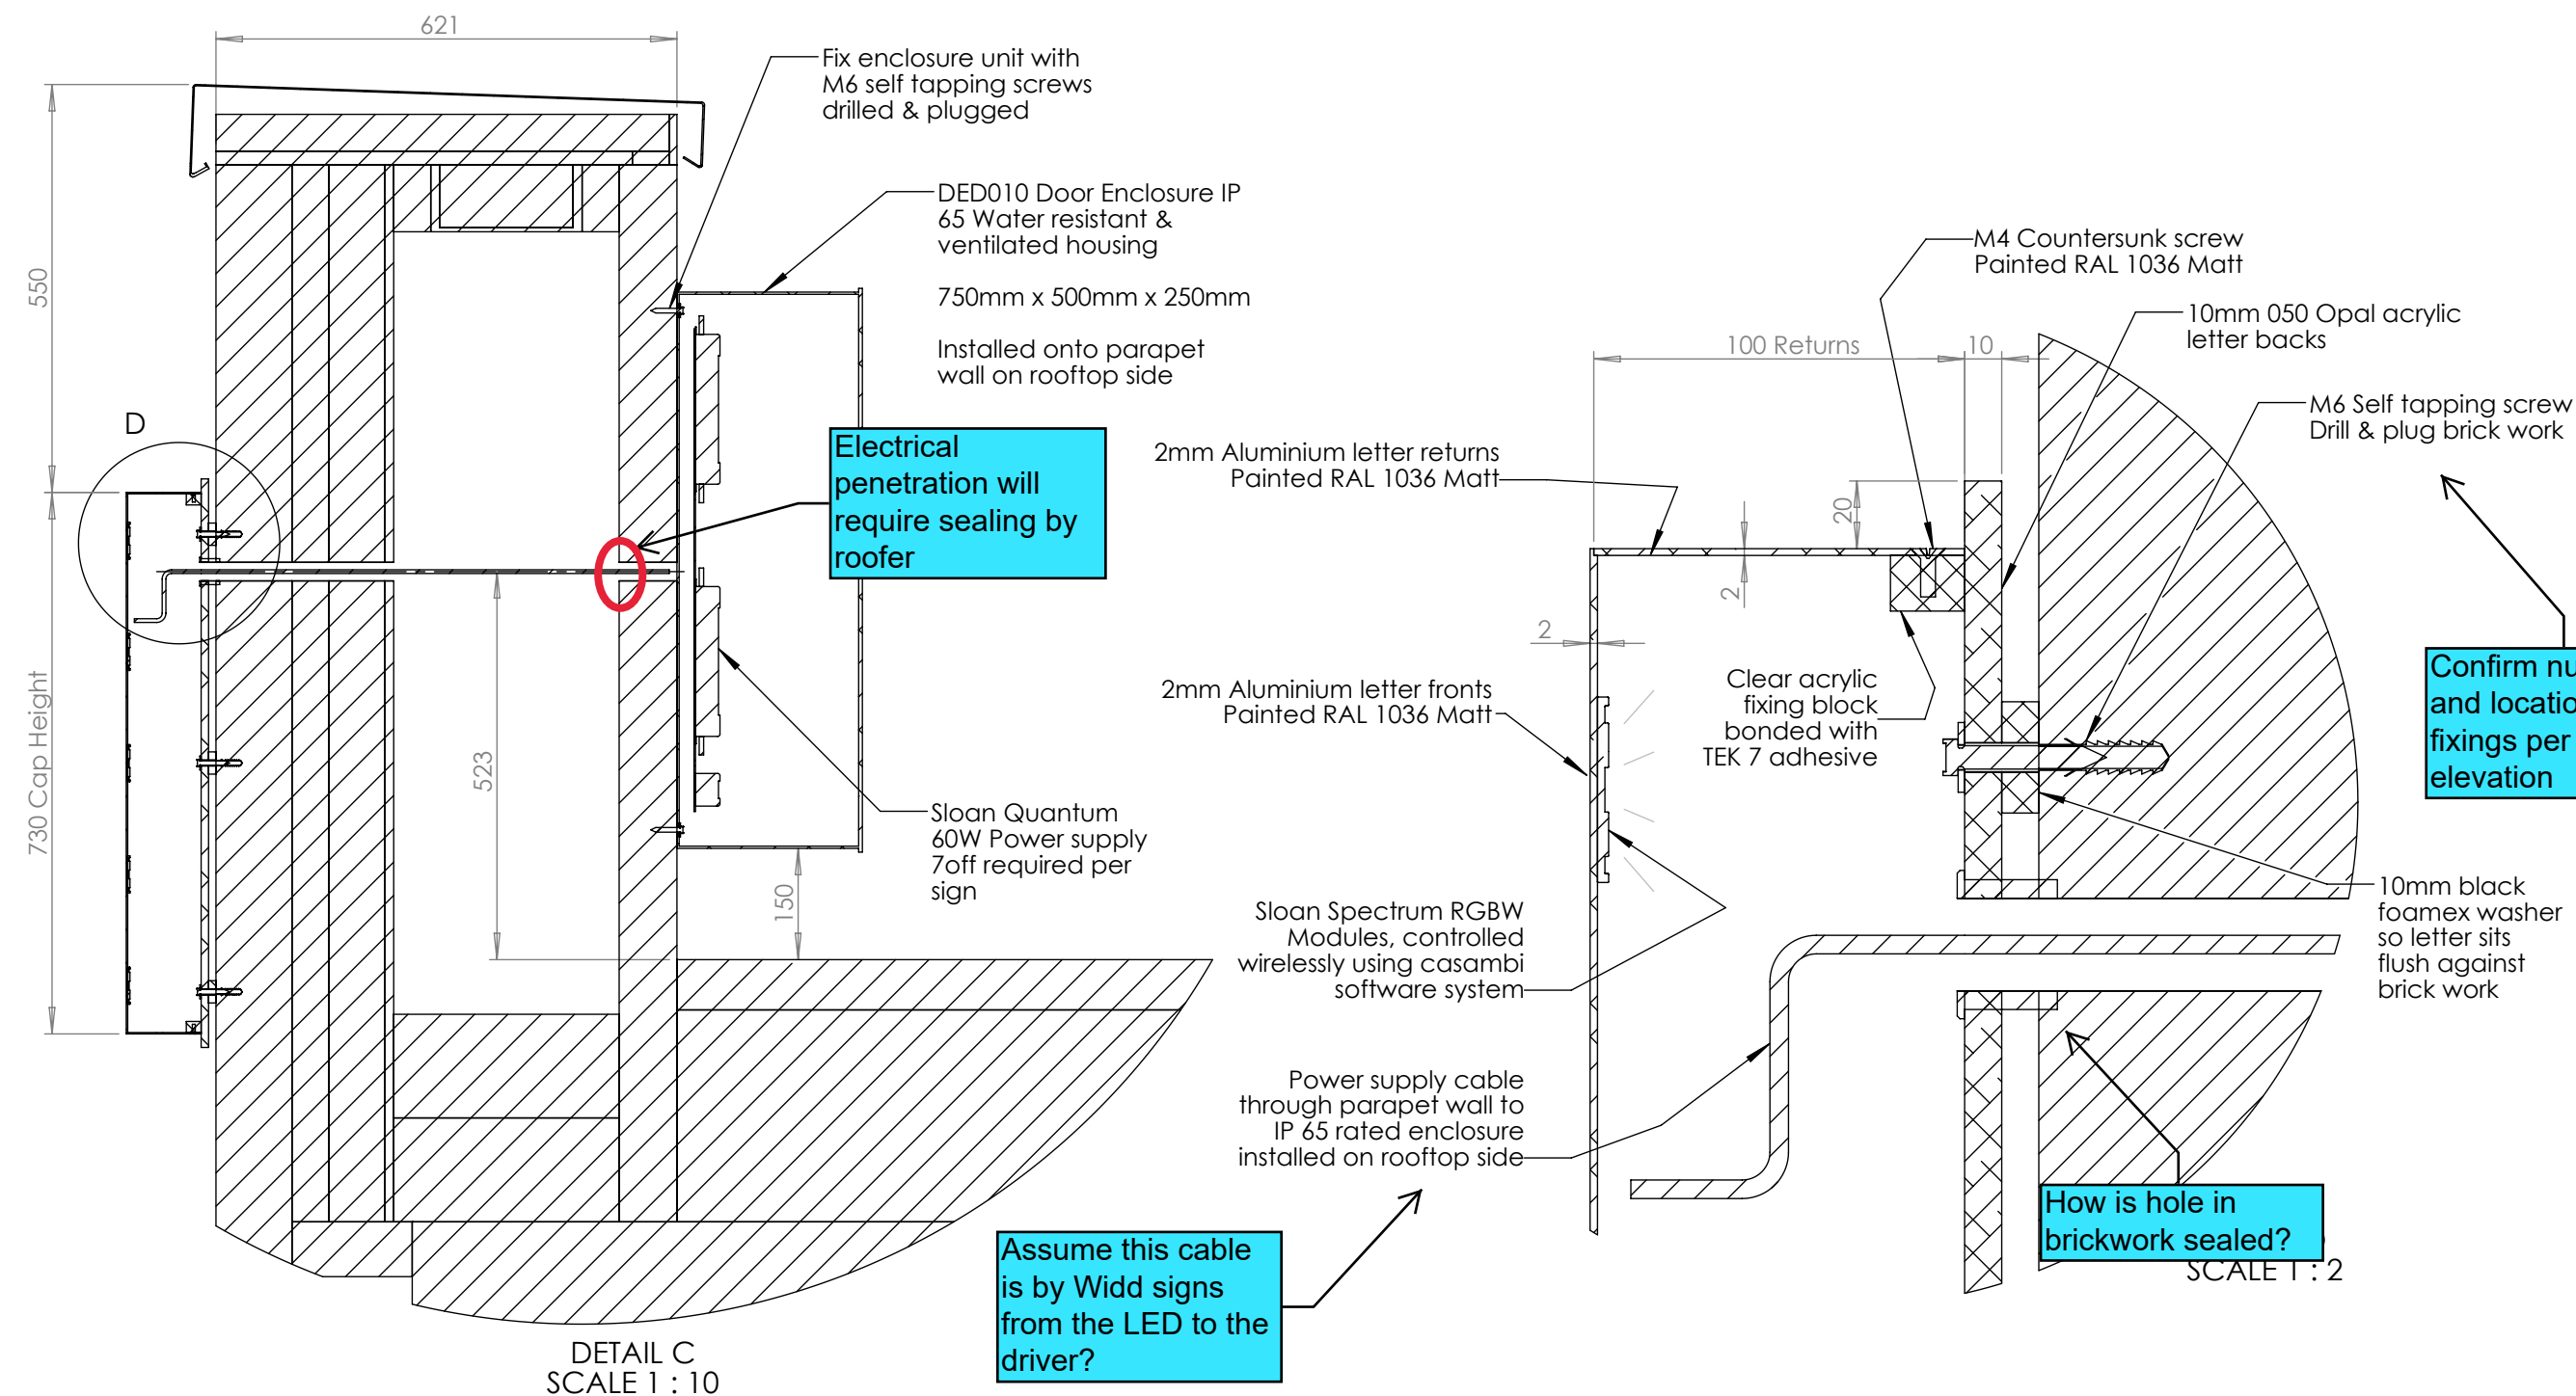


Draft

Vinyl NA
 Paint Pearl Gold - RAL 1036 Matt
 Print NA
 Scale 1: 50
 Rev 0

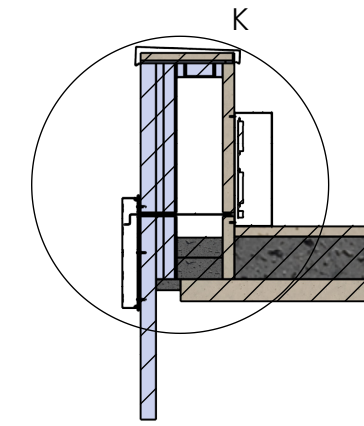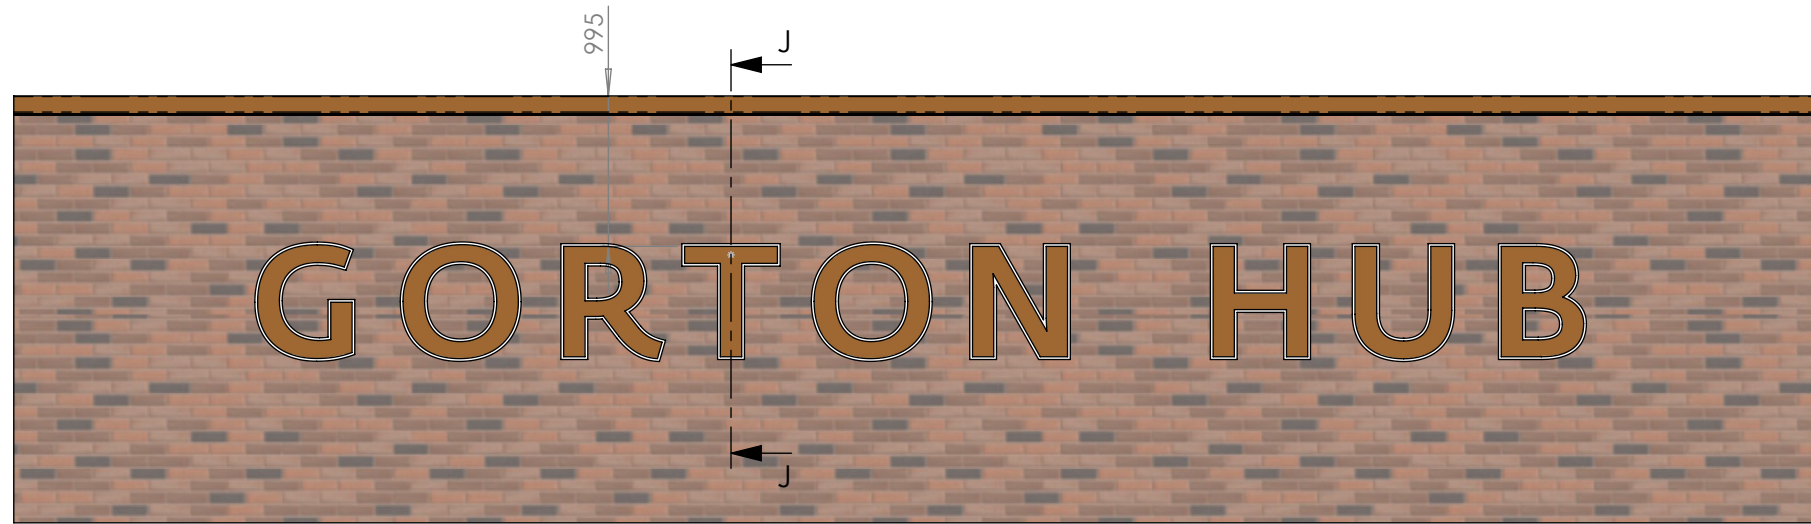

SECTION J-J

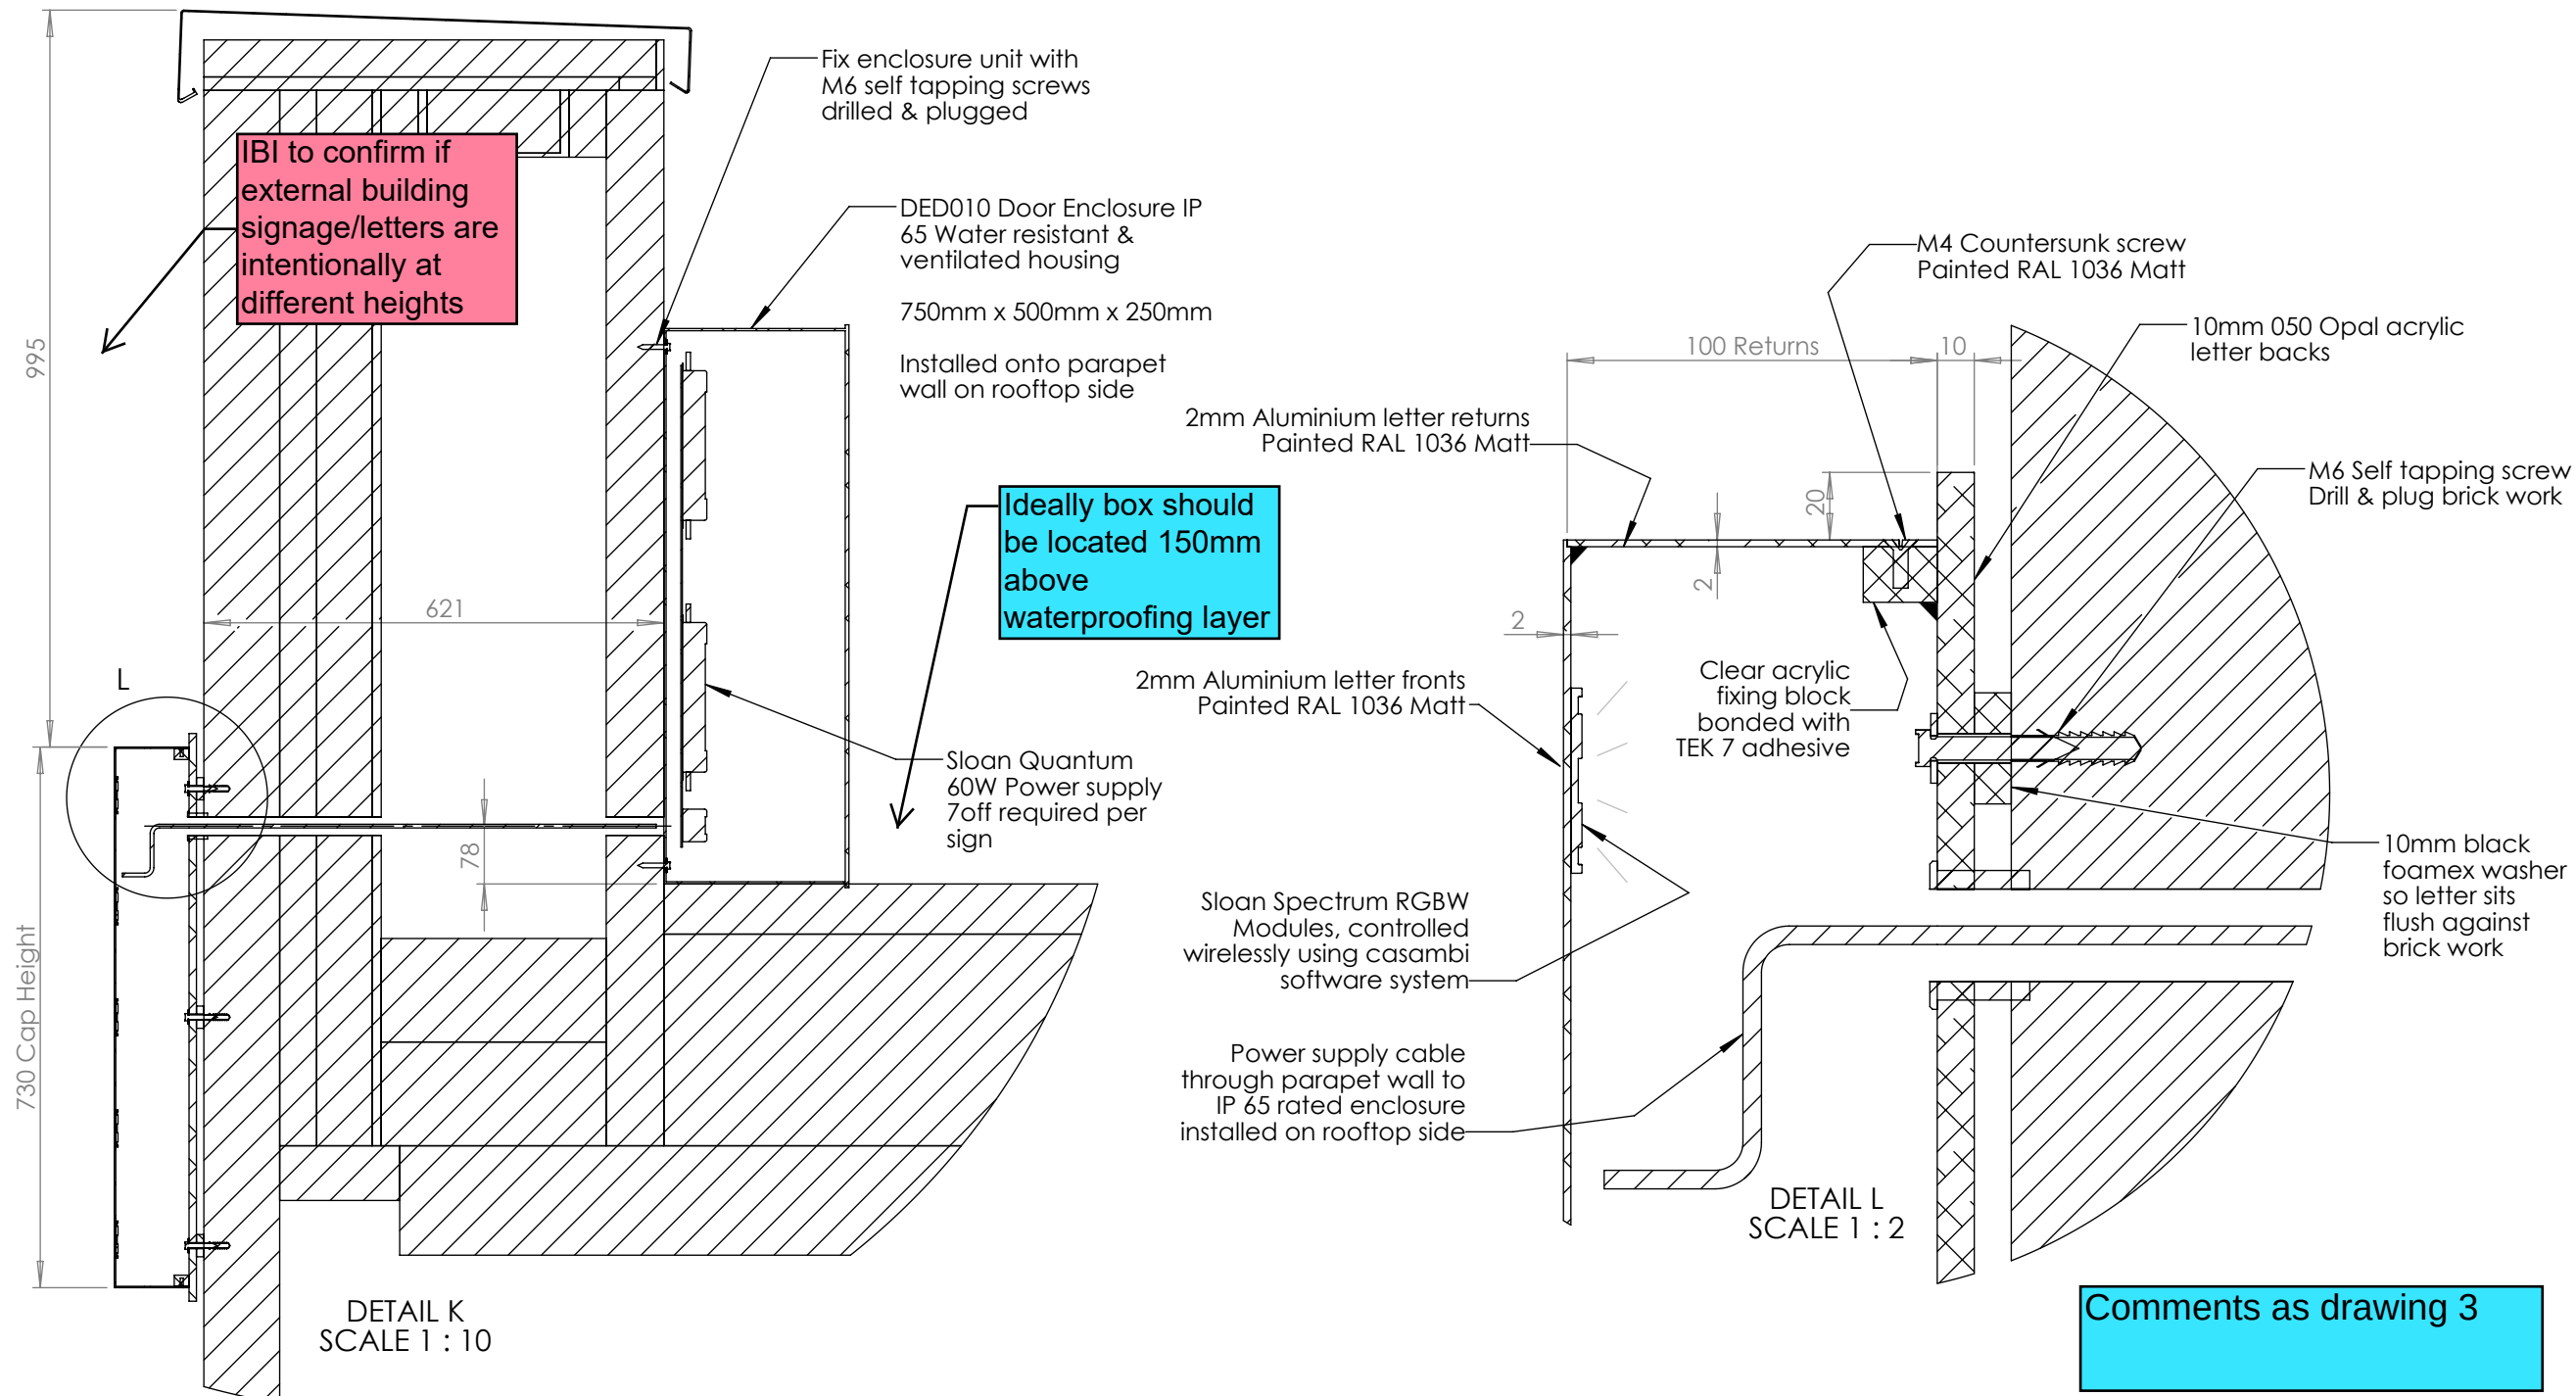


- 01 - North Elevation**
- Individual built-up letters reading "GORTON HUB"
 - 800mm cap height with 100mm returns
 - 2mm aluminium fronts & returns painted Pearl Gold RAL 1036 Matt
 - 10mm 050 Opal acrylic oversized letter backs
 - Internally illuminated with Sloan spectrum with individually controlled RGBW LEDs, controlled with Casambi wireless software system
 - Mechanically fixed to brick work with screws & plugs on parapet wall
 - LED drivers to be housed in IP 65 rated enclosure unit mounted on roof side of parapet wall
 - Font: Fedra Sans Medium (As received)
 - Size: 8774mm x 730mm
 - Quantity: 2 (North & South Elevations)

Draft

Vinyl NA
 Paint Pearl Gold - RAL 1036 Matt
 Print NA
 Scale 1 : 50
 Rev 0

Comments as drawing 3

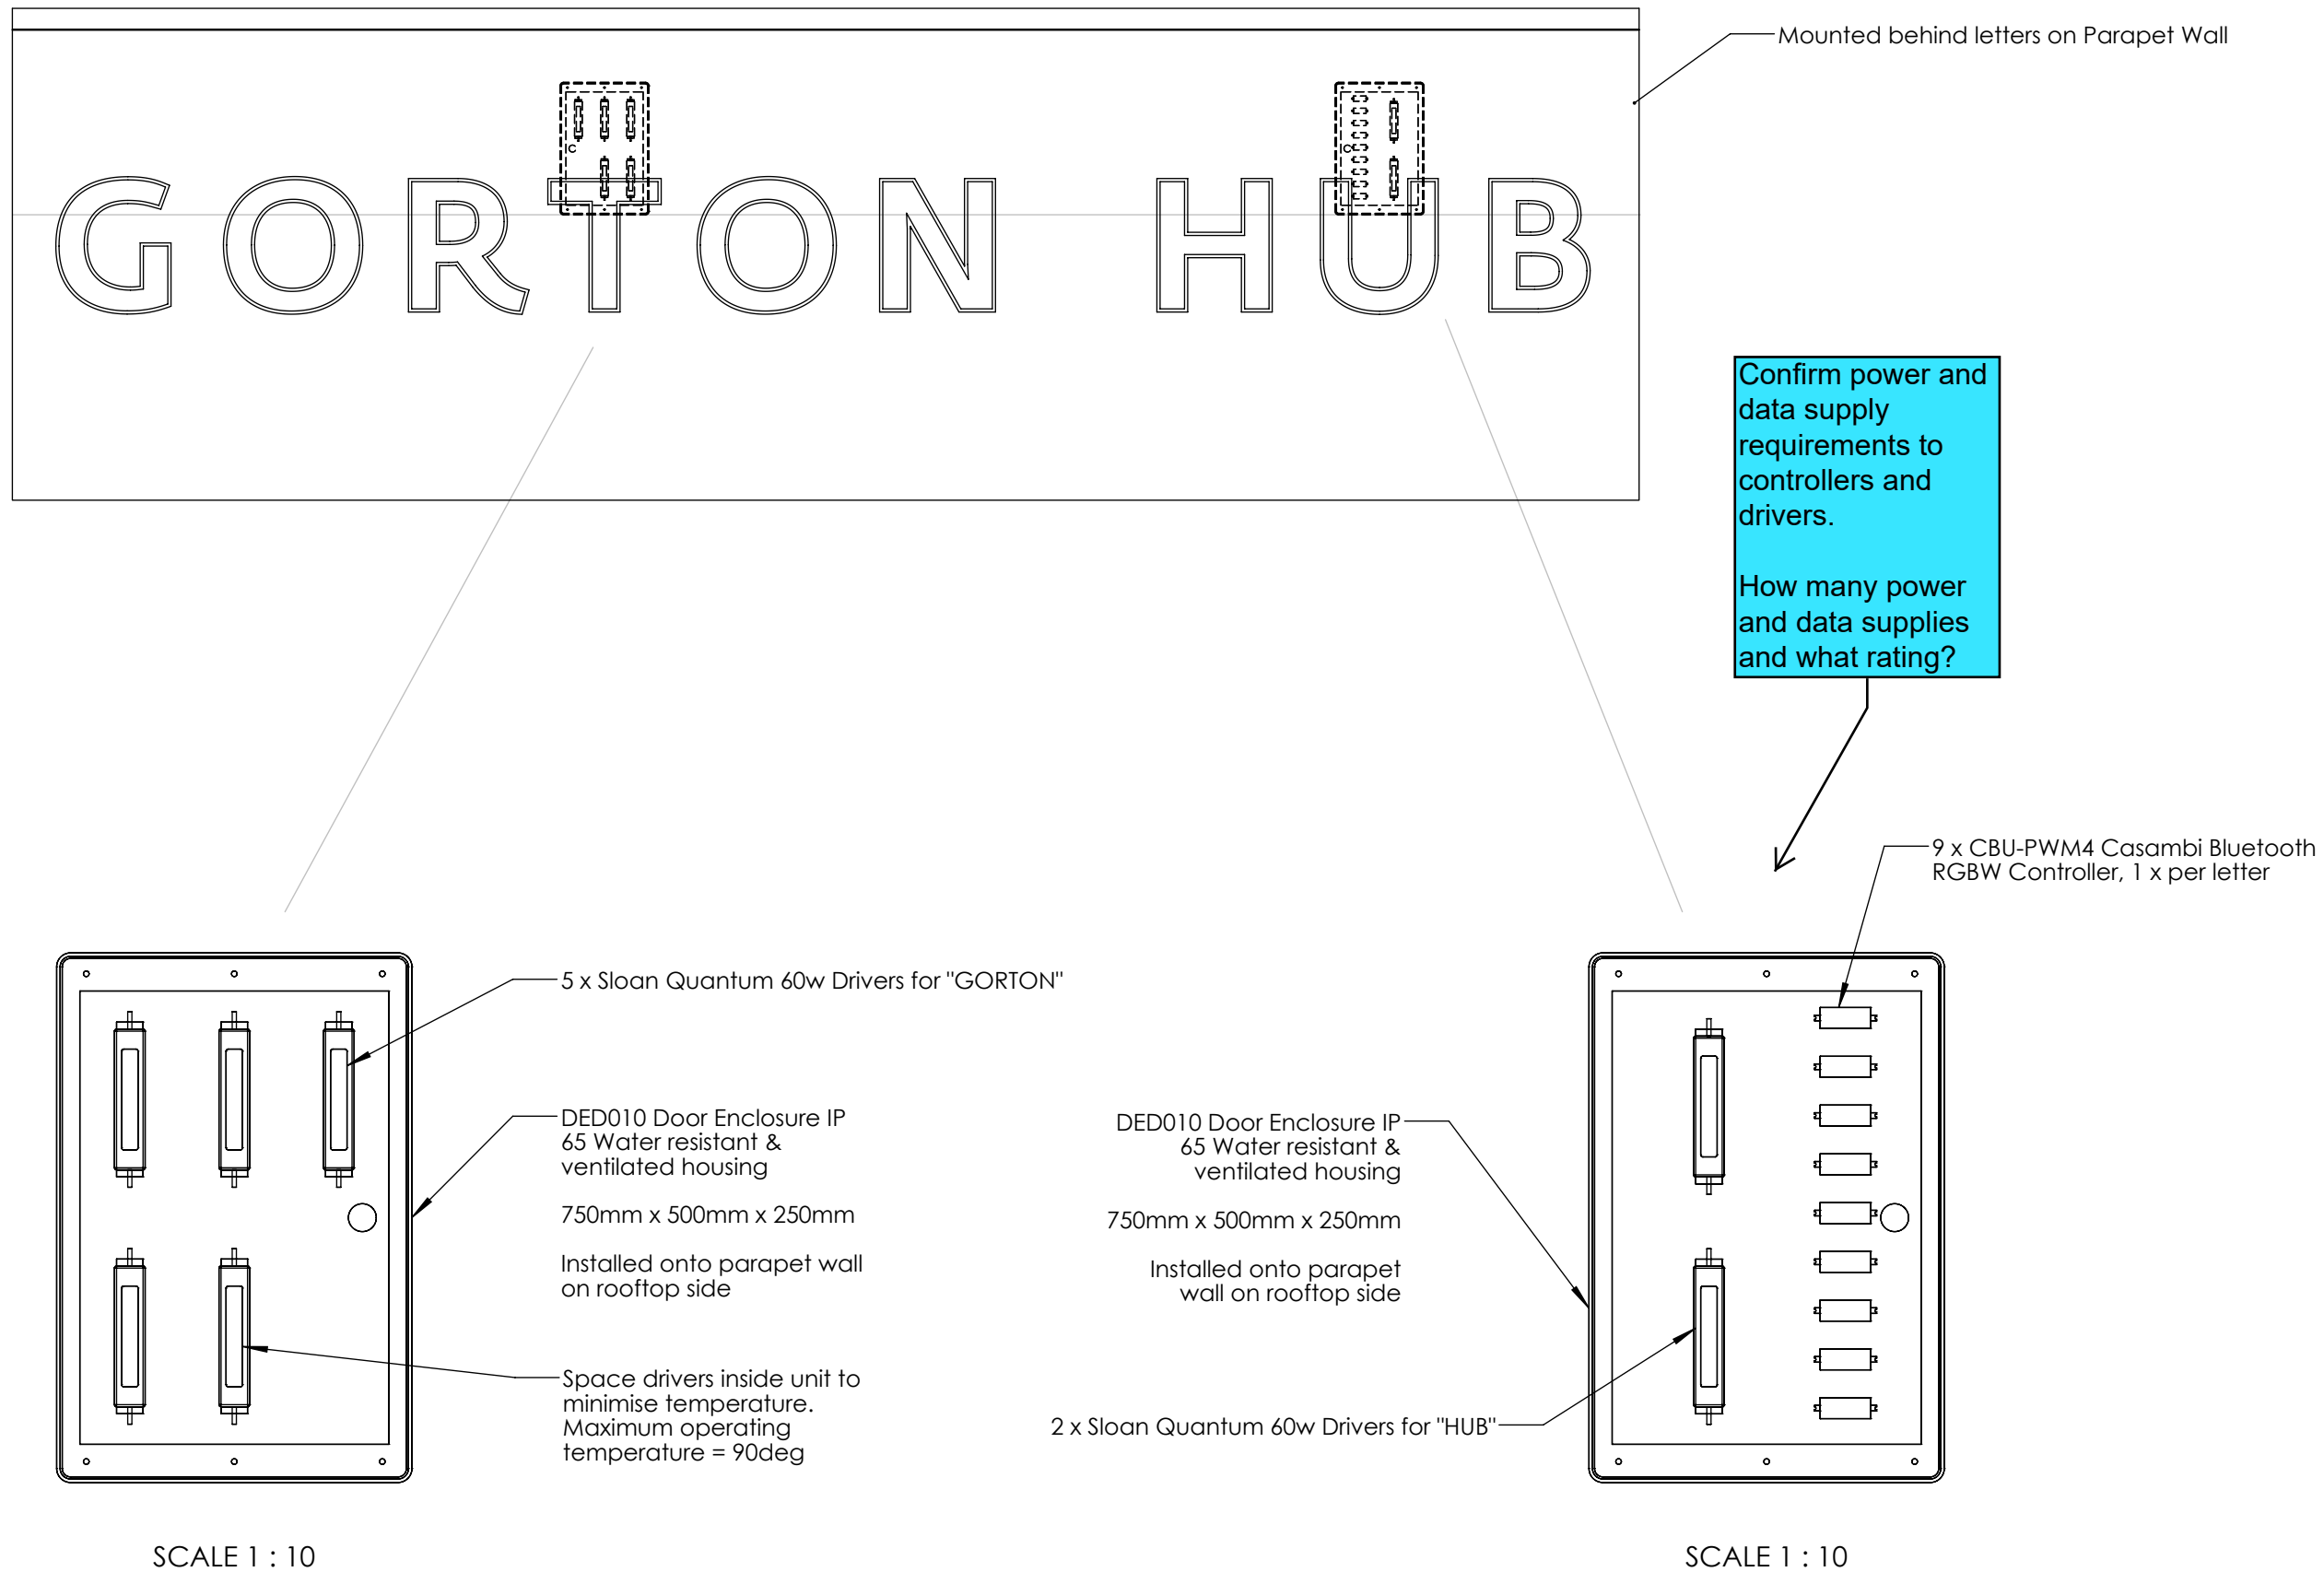

- 01 - Installation Detail**
- Individual built-up letters reading "GORTON HUB"
 - 800mm cap height with 100mm returns
 - 2mm aluminium fronts & returns painted Pearl Gold RAL 1036 Matt
 - 10mm 050 Opal acrylic oversized letter backs
 - Internally illuminated with Sloan spectrum with individually controlled RGBW LEDs, controlled with Casambi wireless software system
 - Mechanically fixed to brick work with screws & plugs on parapet wall
 - LED drivers to be housed in IP 65 rated enclosure unit mounted on roof side of parapet wall
 - Font: Fedra Sans Medium (As received)
 - Size: 8774mm x 730mm
 - Quantity: 2 (North & South Elevations)

Draft

Vinyl NA


Paint Pearl Gold - RAL 1036 Matt

Print NA

Scale 1 : 50

Rev 0

Provide setting out dimensions for signage on elevations

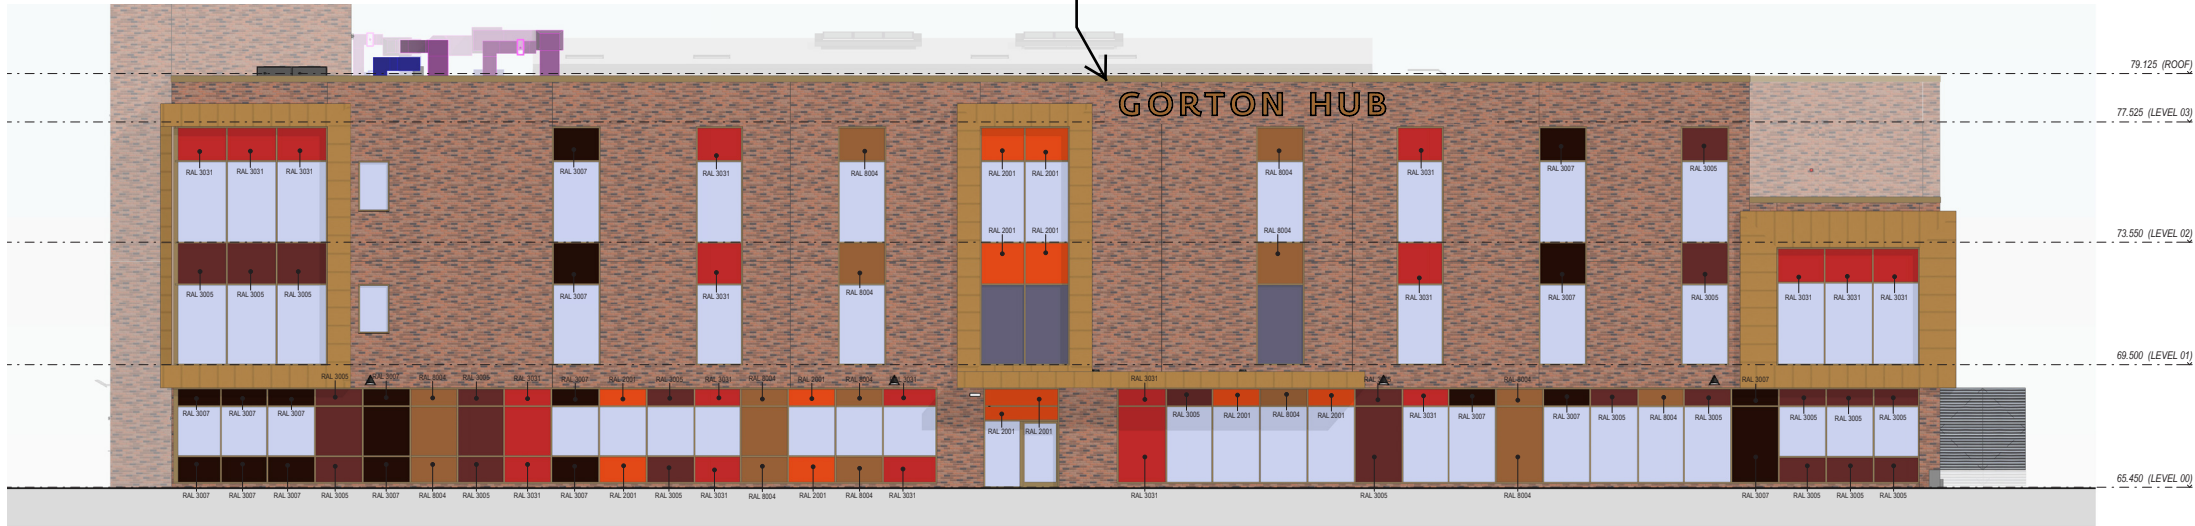

South Elevation - 1 : 250



North Elevation - 1 : 250

- 01 - Elevations**
- Individual built-up letters reading “GORTON HUB”
 - 800mm cap height with 100mm returns
 - 2mm aluminium fronts & returns painted Pearl Gold RAL 1036 Matt
 - 10mm 050 Opal acrylic oversized letter backs
 - Internally illuminated with Sloan spectrum with individually controlled RGBW LEDs, controlled with Casambi wireless software system
 - Mechanically fixed to brick work with screws & plugs on parapet wall
 - LED drivers to be housed in IP 65 rated enclosure unit mounted on roof side of parapet wall
-
- Font: Fedra Sans Medium (As received)
 - Size: 8774mm x 730mm
 - Quantity: 2 (North & South Elevations)

Draft

Vinyl NA
Paint Pearl Gold - RAL 1036 Matt
Print NA
Scale 1 : 250
Rev 0



- 01 – Day Time Render
- Individual built-up letters reading “GORTON HUB”
 - 800mm cap height with 100mm returns
 - 2mm aluminium fronts & returns painted Pearl Gold RAL 1036 Matt
 - 10mm 050 Opal acrylic oversized letter backs
 - Internally illuminated with Sloan spectrum with individually controlled RGBW LEDS, controlled with Casambi wireless software system
 - Mechanically fixed to brick work with screws & plugs on parapet wall
 - LED drivers to be housed in IP 65 rated enclosure unit mounted on roof side of parapet wall
- Font: Fedra Sans Medium (As received)
- Size: 8774mm x 730mm
- Quantity: 2 (North & South Elevations)

Draft

Vinyl	NA
Paint	Pearl Gold – RAL 1036 Matt
Print	NA
Scale	Not to scale
Rev	0



01 - Night Time Renders

- Individual built-up letters reading “GORTON HUB”
- 800mm cap height with 100mm returns
- 2mm aluminium fronts & returns painted Pearl Gold RAL 1036 Matt
- 10mm 050 Opal acrylic oversized letter backs
- Internally illuminated with Sloan spectrum with individually controlled RGBW LEDs, controlled with Casambi wireless software system
- Mechanically fixed to brick work with screws & plugs on parapet wall
- LED drivers to be housed in IP 65 rated enclosure unit mounted on roof side of parapet wall

- Font: Fedra Sans Medium (As received)

- Size: 8774mm x 730mm
- Quantity: 2 (North & South Elevations)

Draft

Vinyl	NA
Paint	Pearl Gold - RAL 1036 Matt
Print	NA
Scale	Not to scale
Rev	0