



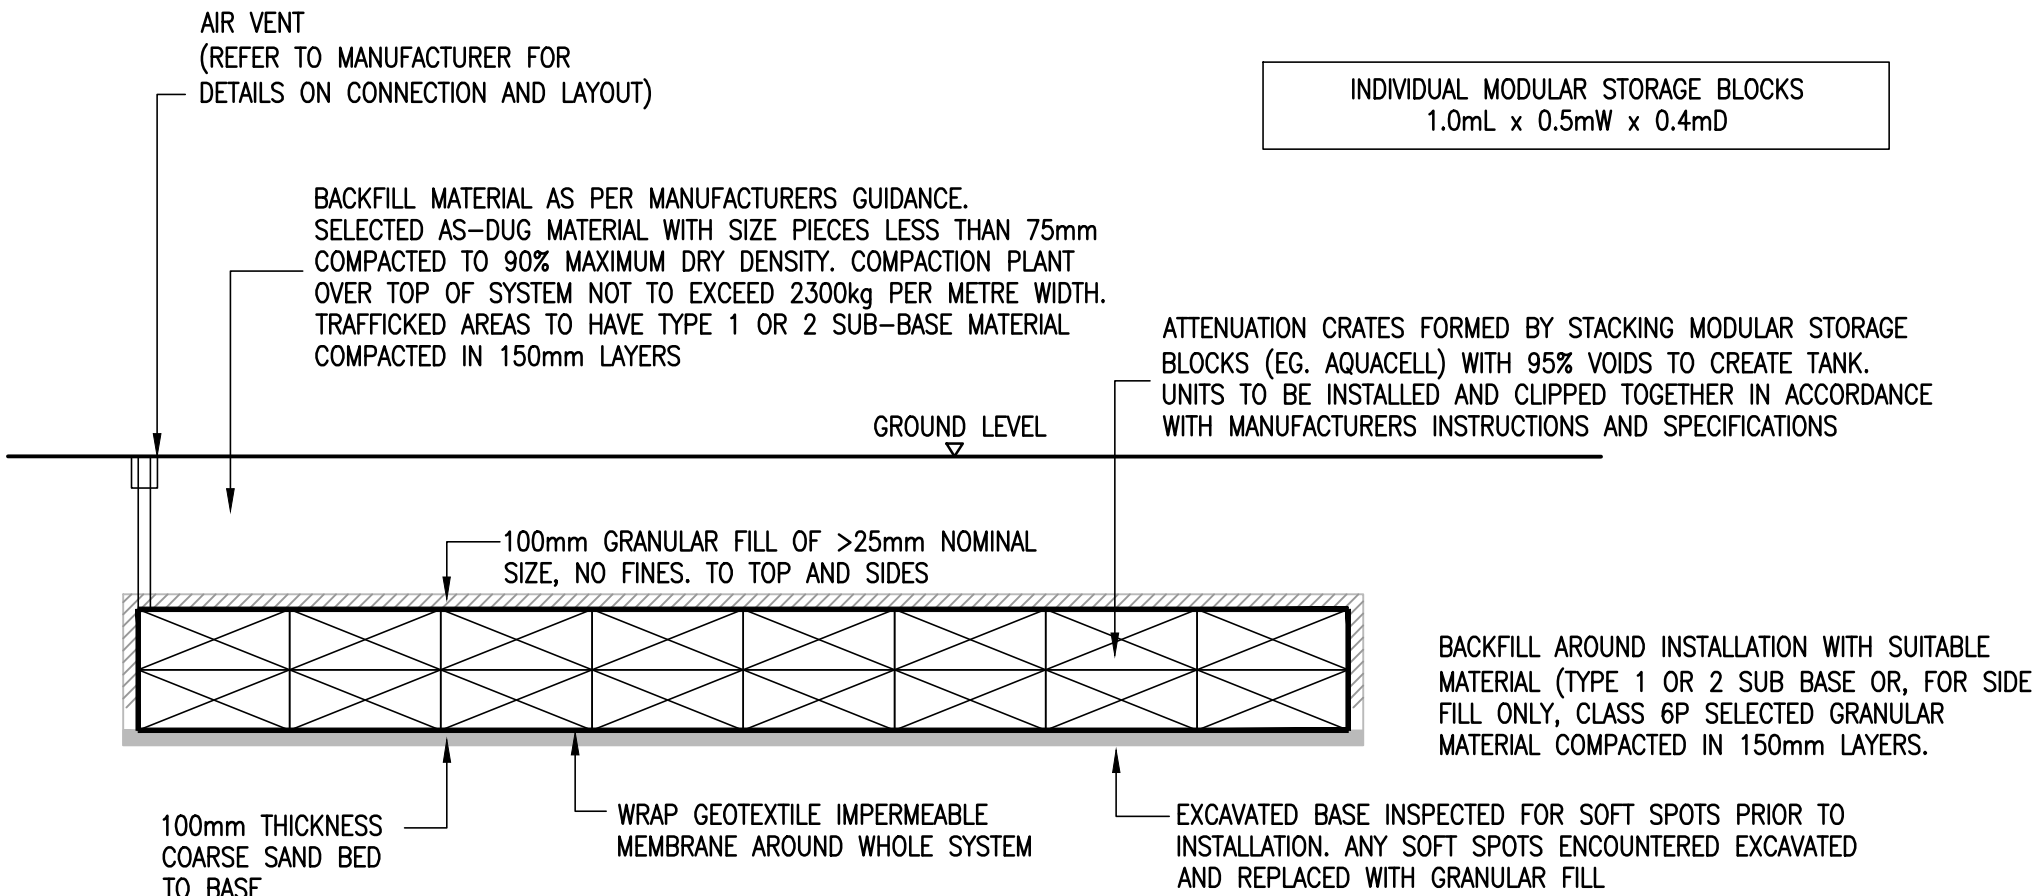

TYPICAL SECTION THROUGH ATTENUATION CRATES
SCALE 1:50

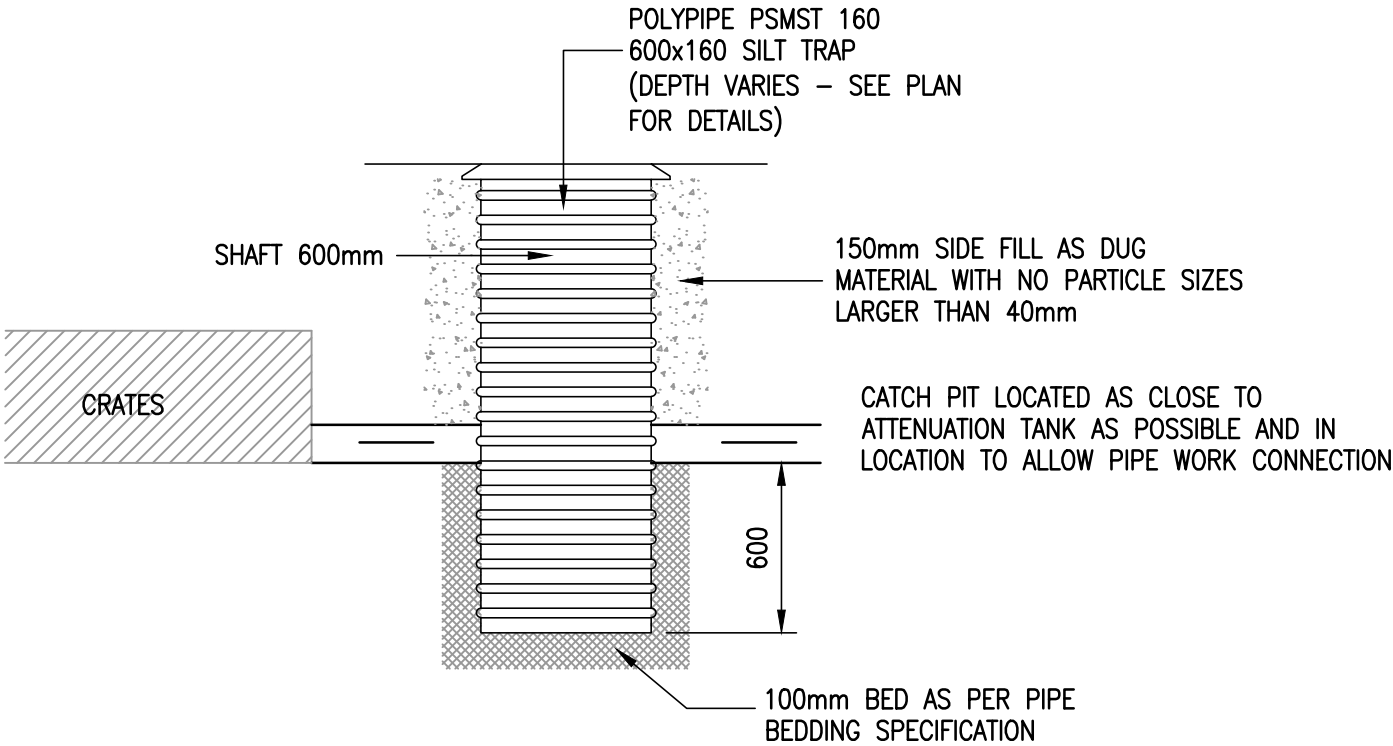

CATCH PIT DETAIL
SCALE 1:20

AB01	PB	As Built Issue		05/03/2026
Rev	By	Description		Date
Revision Schedule				
Status	-	Purpose of Issue As Built		
Designed By PB		Approved By NM	Drawn By PB	
Project No. 2109			Sheet No. 2109-SCE-00-00-DR-C-0003	
Scale (@ A3) 1:20		DATE 05/03/2026	Rev AB01	



SHAPE
ENGINEERING

Liverpool Innovation House | Edge Lane | Liverpool | L7 9NJ
T: 0151 305 0700 | W: www.shapeengineering.co.uk | Tweet Us: @shapetweets

Client Irwell Valley Homes

PROJECT Plant Hill, Blackley Manchester

TITLE Attenuation Tank and Catchpit Detail

Status -

Purpose of Issue

As Built

Designed By

PB

Approved By

NM

Drawn By

PB

Project No.

2109

Sheet No.

2109-SCE-00-00-DR-C-0003

Scale (@ A3)

1:20

DATE

05/03/2026

Rev

AB01