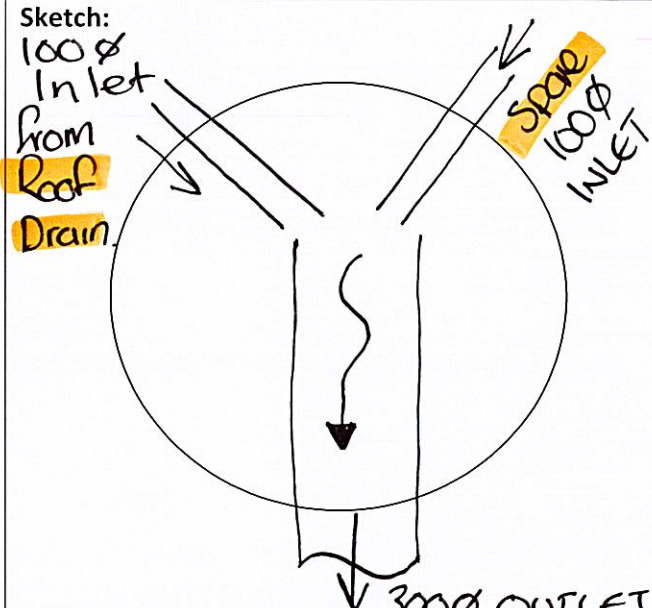


QA Form - Manholes

Installation of Manhole			Sheet No:	2.
Project	C376 WITHINGTON CDC		Date:	28/04/2025
Location:	S1	Drawing No:	22182-CCS-WCH006-XX-DR-S-93000	
As built coordinates:	383737.756			
Cover Level:	392030.818			
Manhole No:	MH S1	Type:	FOUL/SURFACE WATER/COMBINED	
Invert:	31.846 BAM 31.858.	(circle as appropriate)		
Inverts and Diameter of pipes:	Upstream: END OF LINE Dia: N/A Downstream: 31.846 Dia: 300mm Inlet 1: 31.950 Dia: 100mm Inlet 2: 31.950 Dia: 100mm Inlet 3: Dia: Inlet 4: Dia: Inlet 5: Dia:		 Sketch: 100mm Inlet from Roof Drain 100mm Inlet 300mm OUTLET TO Position of step irons/fittings, orientation of cover/slab and branches (including backdrops) to be detailed. MHSW-4!	
Chamber Details:	Dia. Size: Overall depth: Cover Depth: Biscuit Depth: Reducing Slab:			
WORK TO BE INSPECTED	Accepted Yes/ No or N/a	Comments	MW Construction Eng/QA Signed as Checked:-	
Setting out to drawing	Yes	Given Level on drawing incorrect laid to grade Δ400.	B.H. S	
Trench excavation supported	Yes	Stepped as required	B.H. S	
Installation of concrete to channel	Yes	+ Half Barrel Pipe Installed	B.H. S	
Installation of drainage channel/first manhole ring	Yes		B.H. S	

QA Form - Manholes

MWC Signature confirming invert/positioning check	B.H.S	Date	25/06/2025
Client Signature confirming invert/positioning check	Daniel Allen.	Date	26/6/2025

WORK TO BE INSPECTED	Accepted Yes/ No or N/A	Comments	MW Construction Eng/QA Signed as Checked:-
Installation of manhole rings to required levels	Yes	Depths and No's of rings: 1x 1500 x 500	B.H.S
Installation of dropshafts/inlets above manhole invert	yes		B.H.S
Manhole Surround	Yes	Details: Concrete	B.H.S
Backfilling to manhole to required level and layers as instructed in spec	Yes		B.H.S
Biscuit Installation	Yes	Type: 150mm PCC	B.H.S
Benching/Water proofing to Manhole			B.H.S
Installation of Step Irons	NA	Type & Numbers: Shallow Manhole	B.H.S
Brickwork		No of courses:	B.H.S
Lid and Frame		Cover Type:	B.H.S
Client Signature confirming Handover of Manhole:-		Date	

QA Form - Manholes

**MWC Signature confirming
Handover of Manhole:-**

B.H.S

Date 25/06/2025

