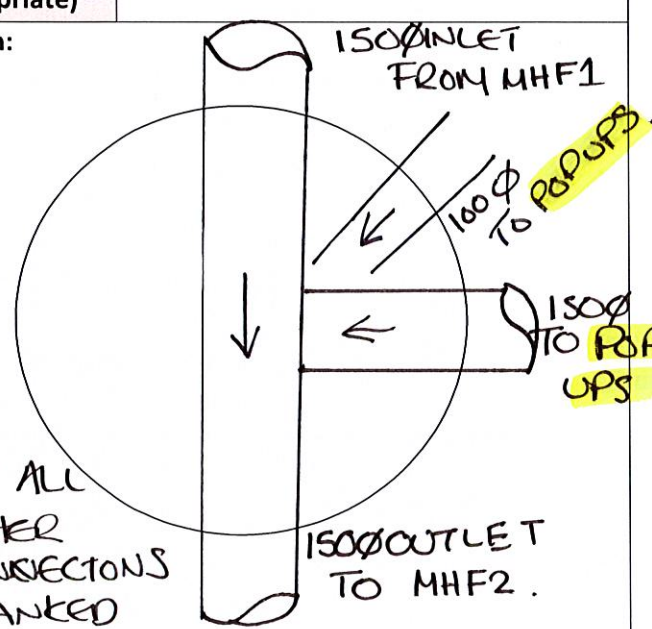
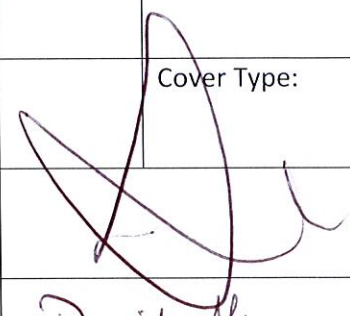


QA Form - Manholes

Installation of Manhole			Sheet No:
Project	C376 WITHINGTON CDC		Date:
Location:	F8	Drawing No:	22182-CCS-WCH006-XX-DR-S-93000
As built coordinates:	383738.122		
Cover Level:	32.830		
Manhole No:	F8	Type:	FOUL/SURFACE WATER/COMBINED
Invert:	31.631 ✓ to .	(circle as appropriate)	
Inverts and Diameter of pipes:	Upstream: 31.639 Dia: 150 DIA Downstream: 31.627 Dia: 150 DIA Inlet 1: 31.672 Dia: 150 DIA Inlet 2: 31.701 Dia: 100 DIA Inlet 3: Dia: Inlet 4: Dia: Inlet 5: Dia:	Sketch: 	
Chamber Details:	Dia. Size: 450 PPIC Overall depth: 1199MM Cover Depth: 100MM Biscuit Depth: NA Reducing Slab: NA		
WORK TO BE INSPECTED	Accepted Yes/ No or N/a	Comments	MW Construction Eng/QA Signed as Checked:-
Setting out to drawing	YES	CENTRE LINE OF LINE MOVED TO ALLOW WORKING ROOM	B.H.S
Trench excavation supported	YES	STEPPED AS REQUIRED	B.H.S
Installation of concrete to channel	YES	BENEITH PPIC UNIT	B.H.S
Installation of drainage channel/first manhole ring	YES		B.H.S

QA Form - Manholes

MWC Signature confirming invert/positioning check	B.H.S	Date	26/06/2025
Client Signature confirming invert/positioning check	Daniel Allen	Date	18/9/25

WORK TO BE INSPECTED	Accepted Yes/ No or N/A	Comments	MW Construction Eng/QA Signed as Checked:-
Installation of manhole rings to required levels	NA	Depths and No's of rings: PPIC	B.H.S
Installation of dropshafts/inlets above manhole invert	YES	PPIC	B.H.S
Manhole Surround	YES	Details: CONCRETE	B.H.S
Backfilling to manhole to required level and layers as instructed in spec	YES		B.H.S
Biscuit Installation		Type:	B.H.S
Benching/Water proofing to Manhole	YES	SHAFT SEALING RING USED	B.H.S
Installation of Step Irons	NA	Type & Numbers: PPIC	B.H.S
Brickwork		No of courses:	
Lid and Frame		Cover Type:	
Client Signature confirming Handover of Manhole:-			Date 18/9/25
MWC Signature confirming Handover of Manhole:-	Daniel Allen		Date 18/9/2025



