


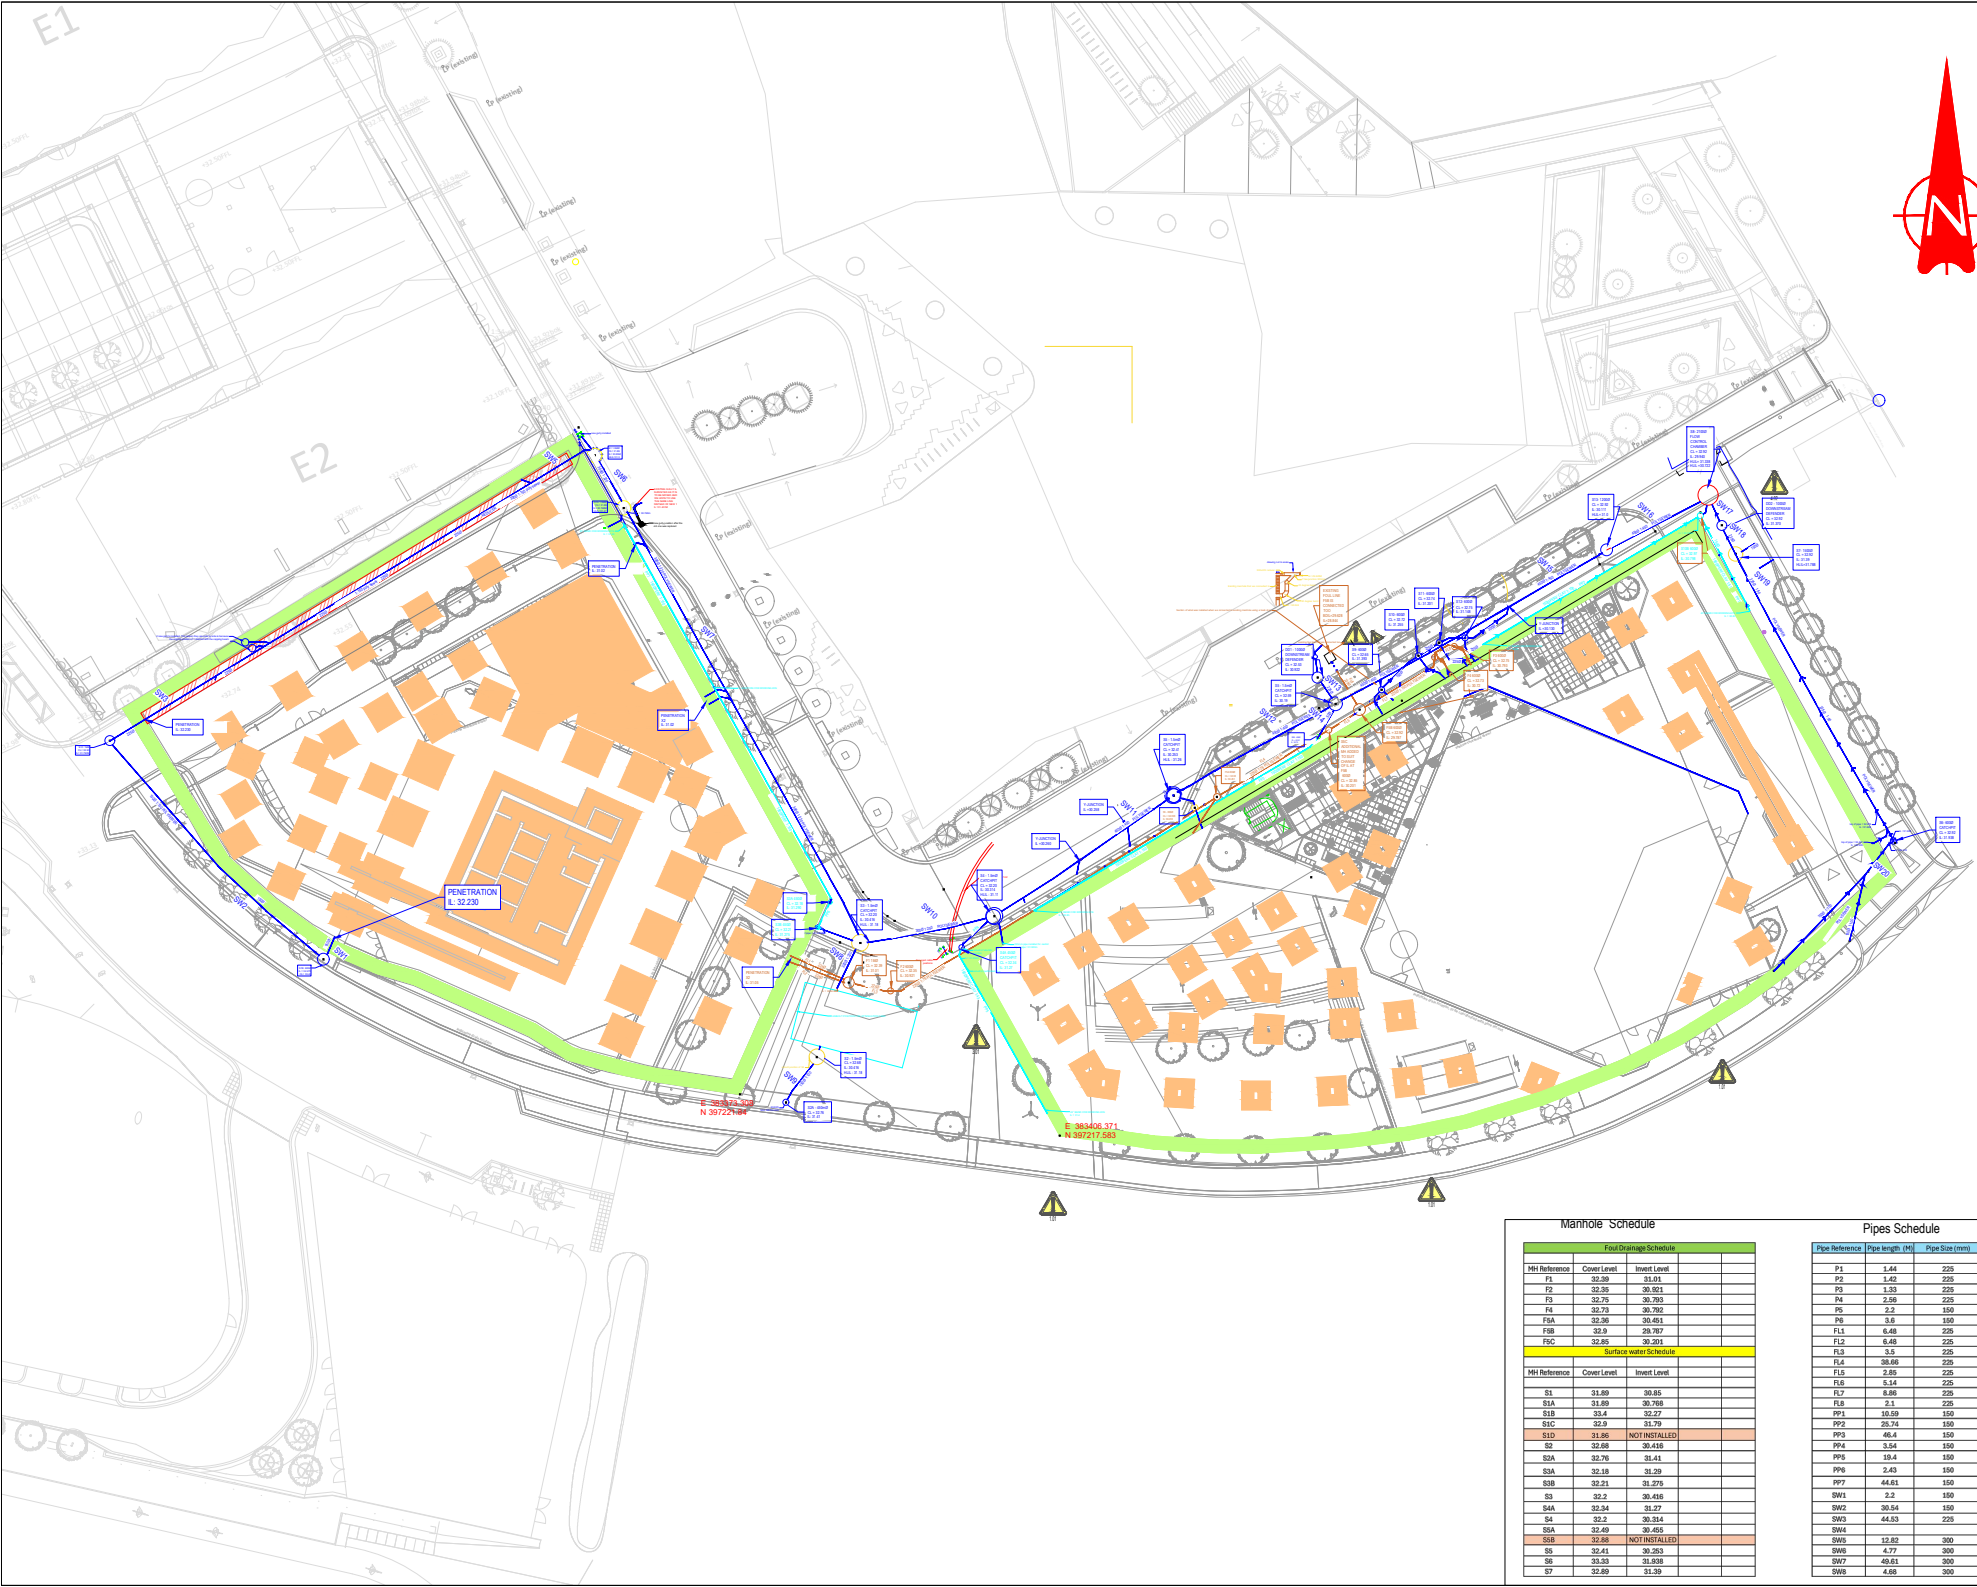

Key:

- BLUE LINE = SURFACE WATER
- ORANGE LINE = FOGS
- CYAN LINE = FIBRE OPTIC

DRAWING REFERENCE

21-03-20	0000	11	0000	0000
21-03-20	0000	11	0000	0000
21-03-20	0000	11	0000	0000

Sheet Layout

Drawn By	Initials - MAM		
Proj	11/07/2020	Updated	MAM 2 G
Proj	00000000	Original Issue	MAM 2 G
Rev	Rev. Date	Purpose of revision	Issue Number

Project

Plot F2- F1

Drawing title

Plot F - Drainage As-Built

Scale

1:50 @ A3

DO NOT SCALE

Sheet No

XXXXXXX

Drawing Number

RNRK-FX-ASB-DR-001

Rev

A

This drawing is not to be used in whole or part other than for the intended purpose and project as defined on this drawing. Refer to the contract for full terms and conditions.