
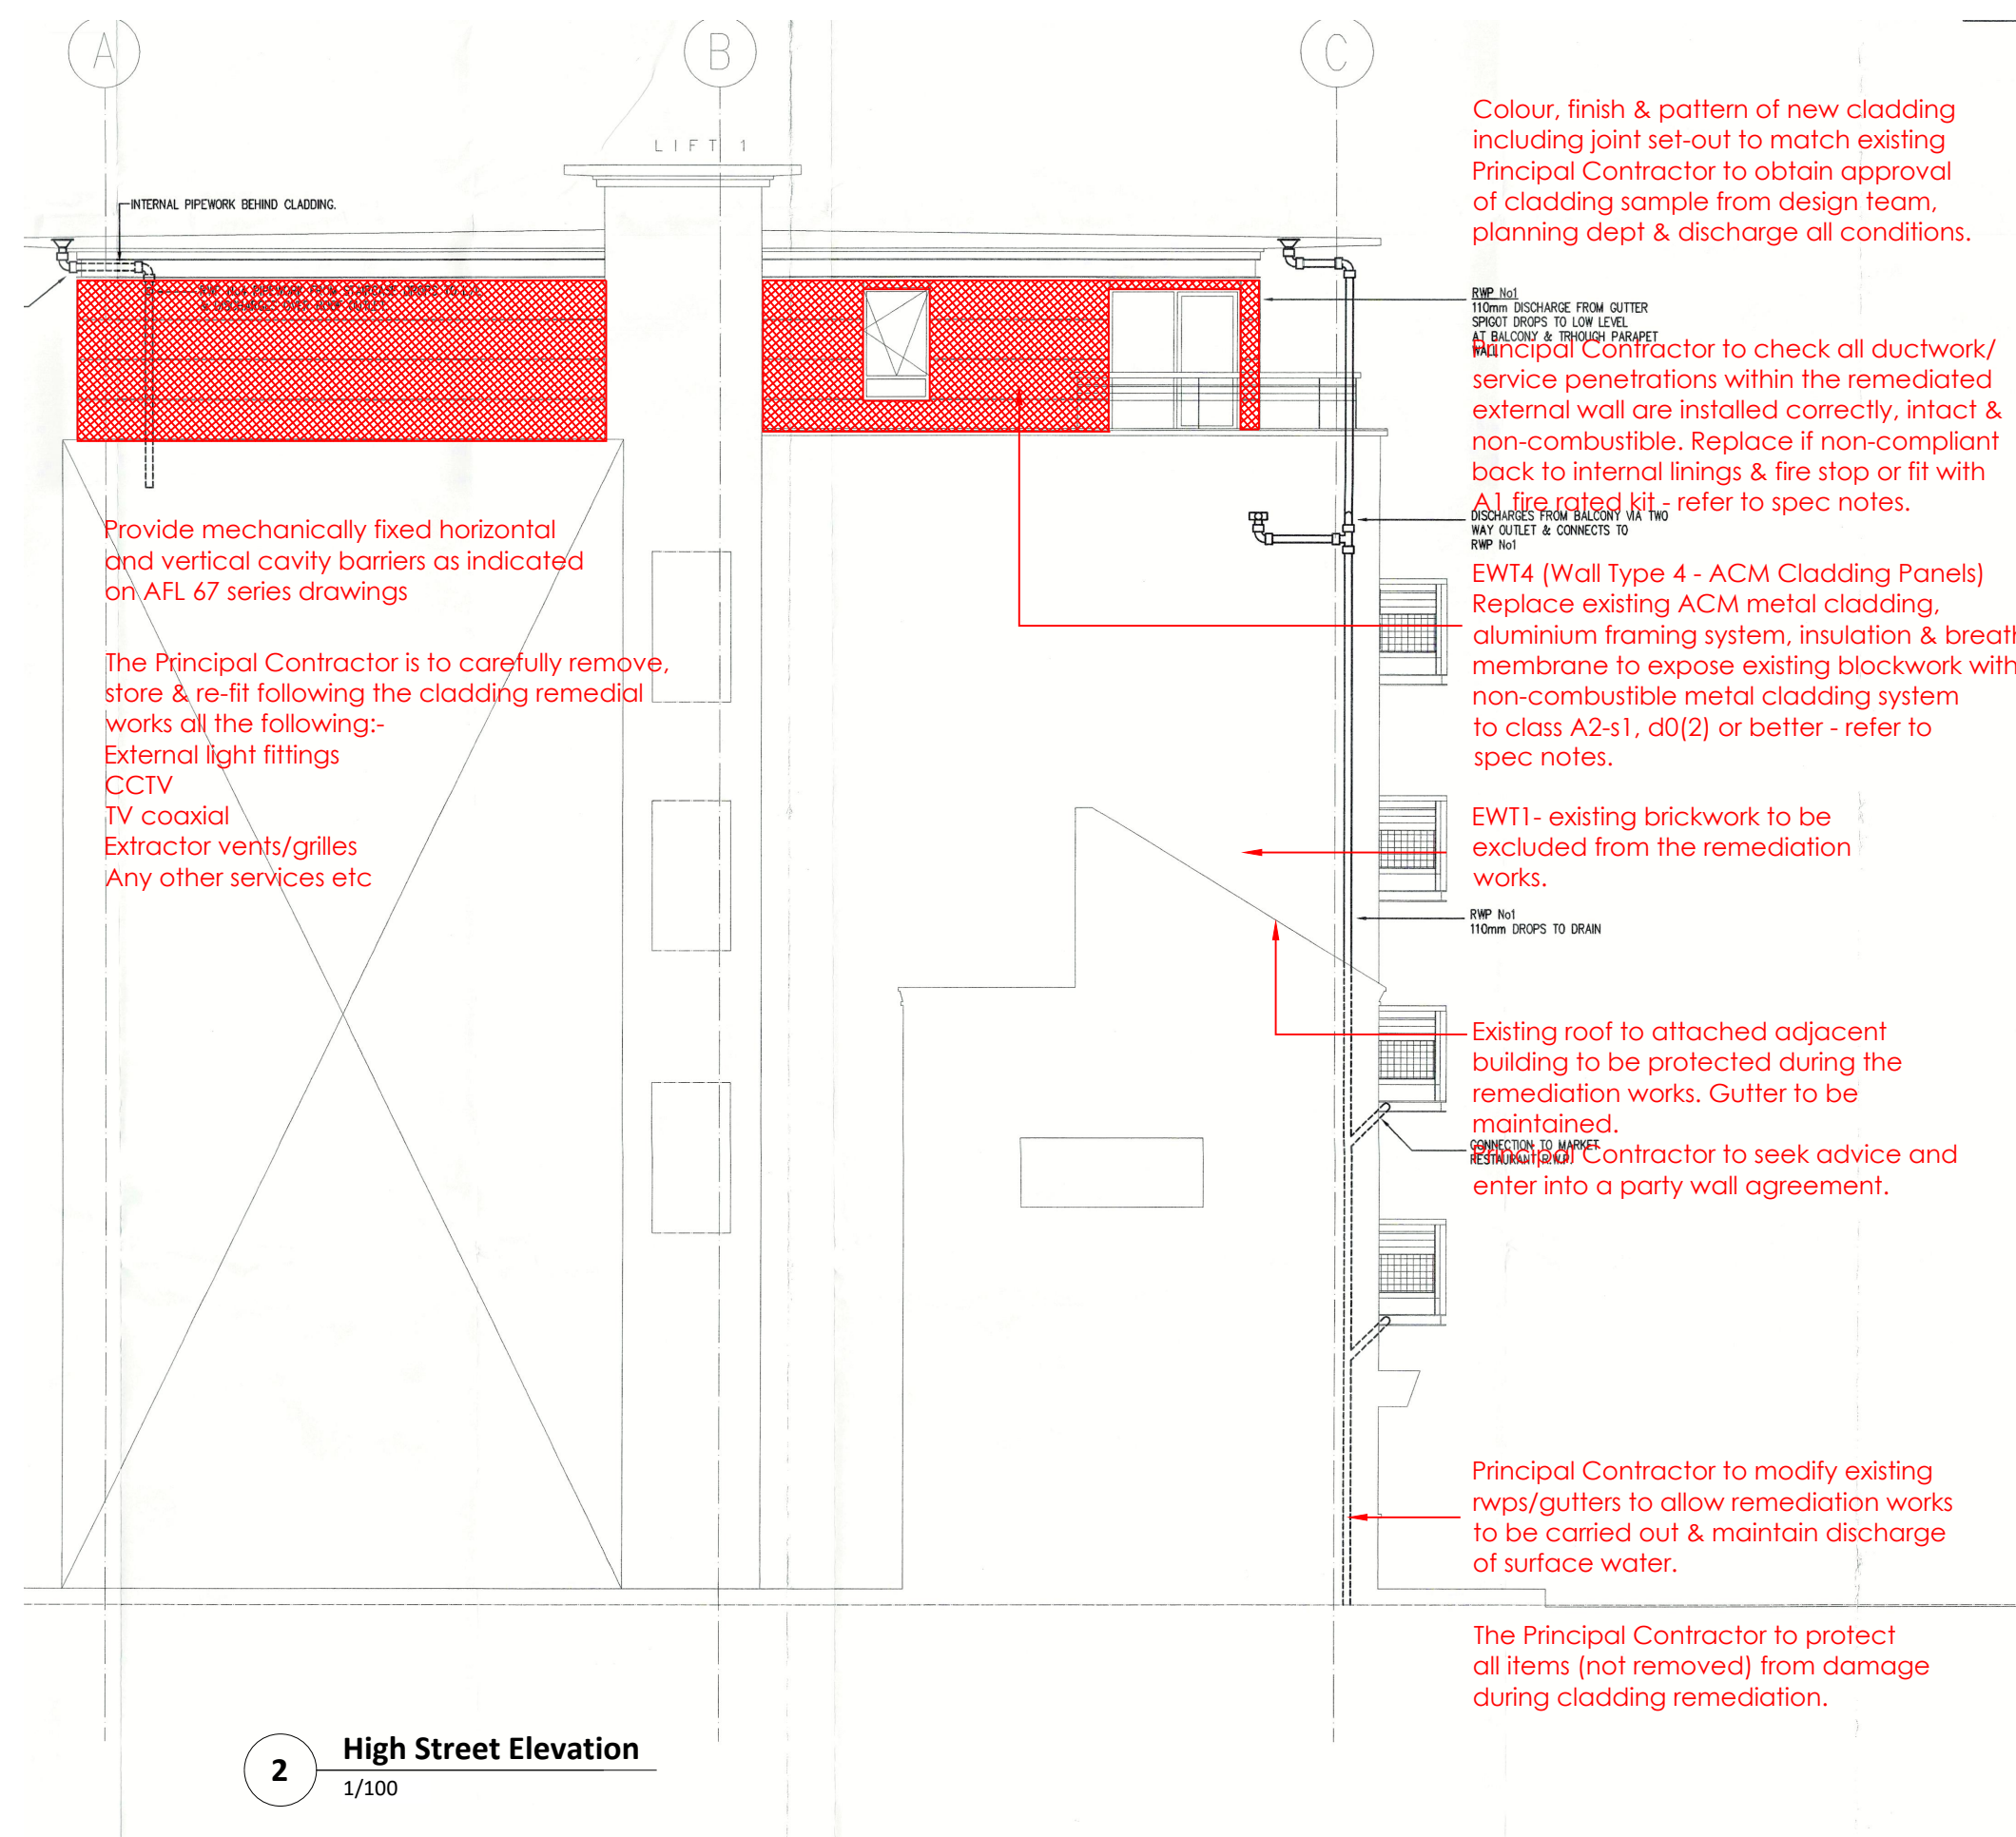
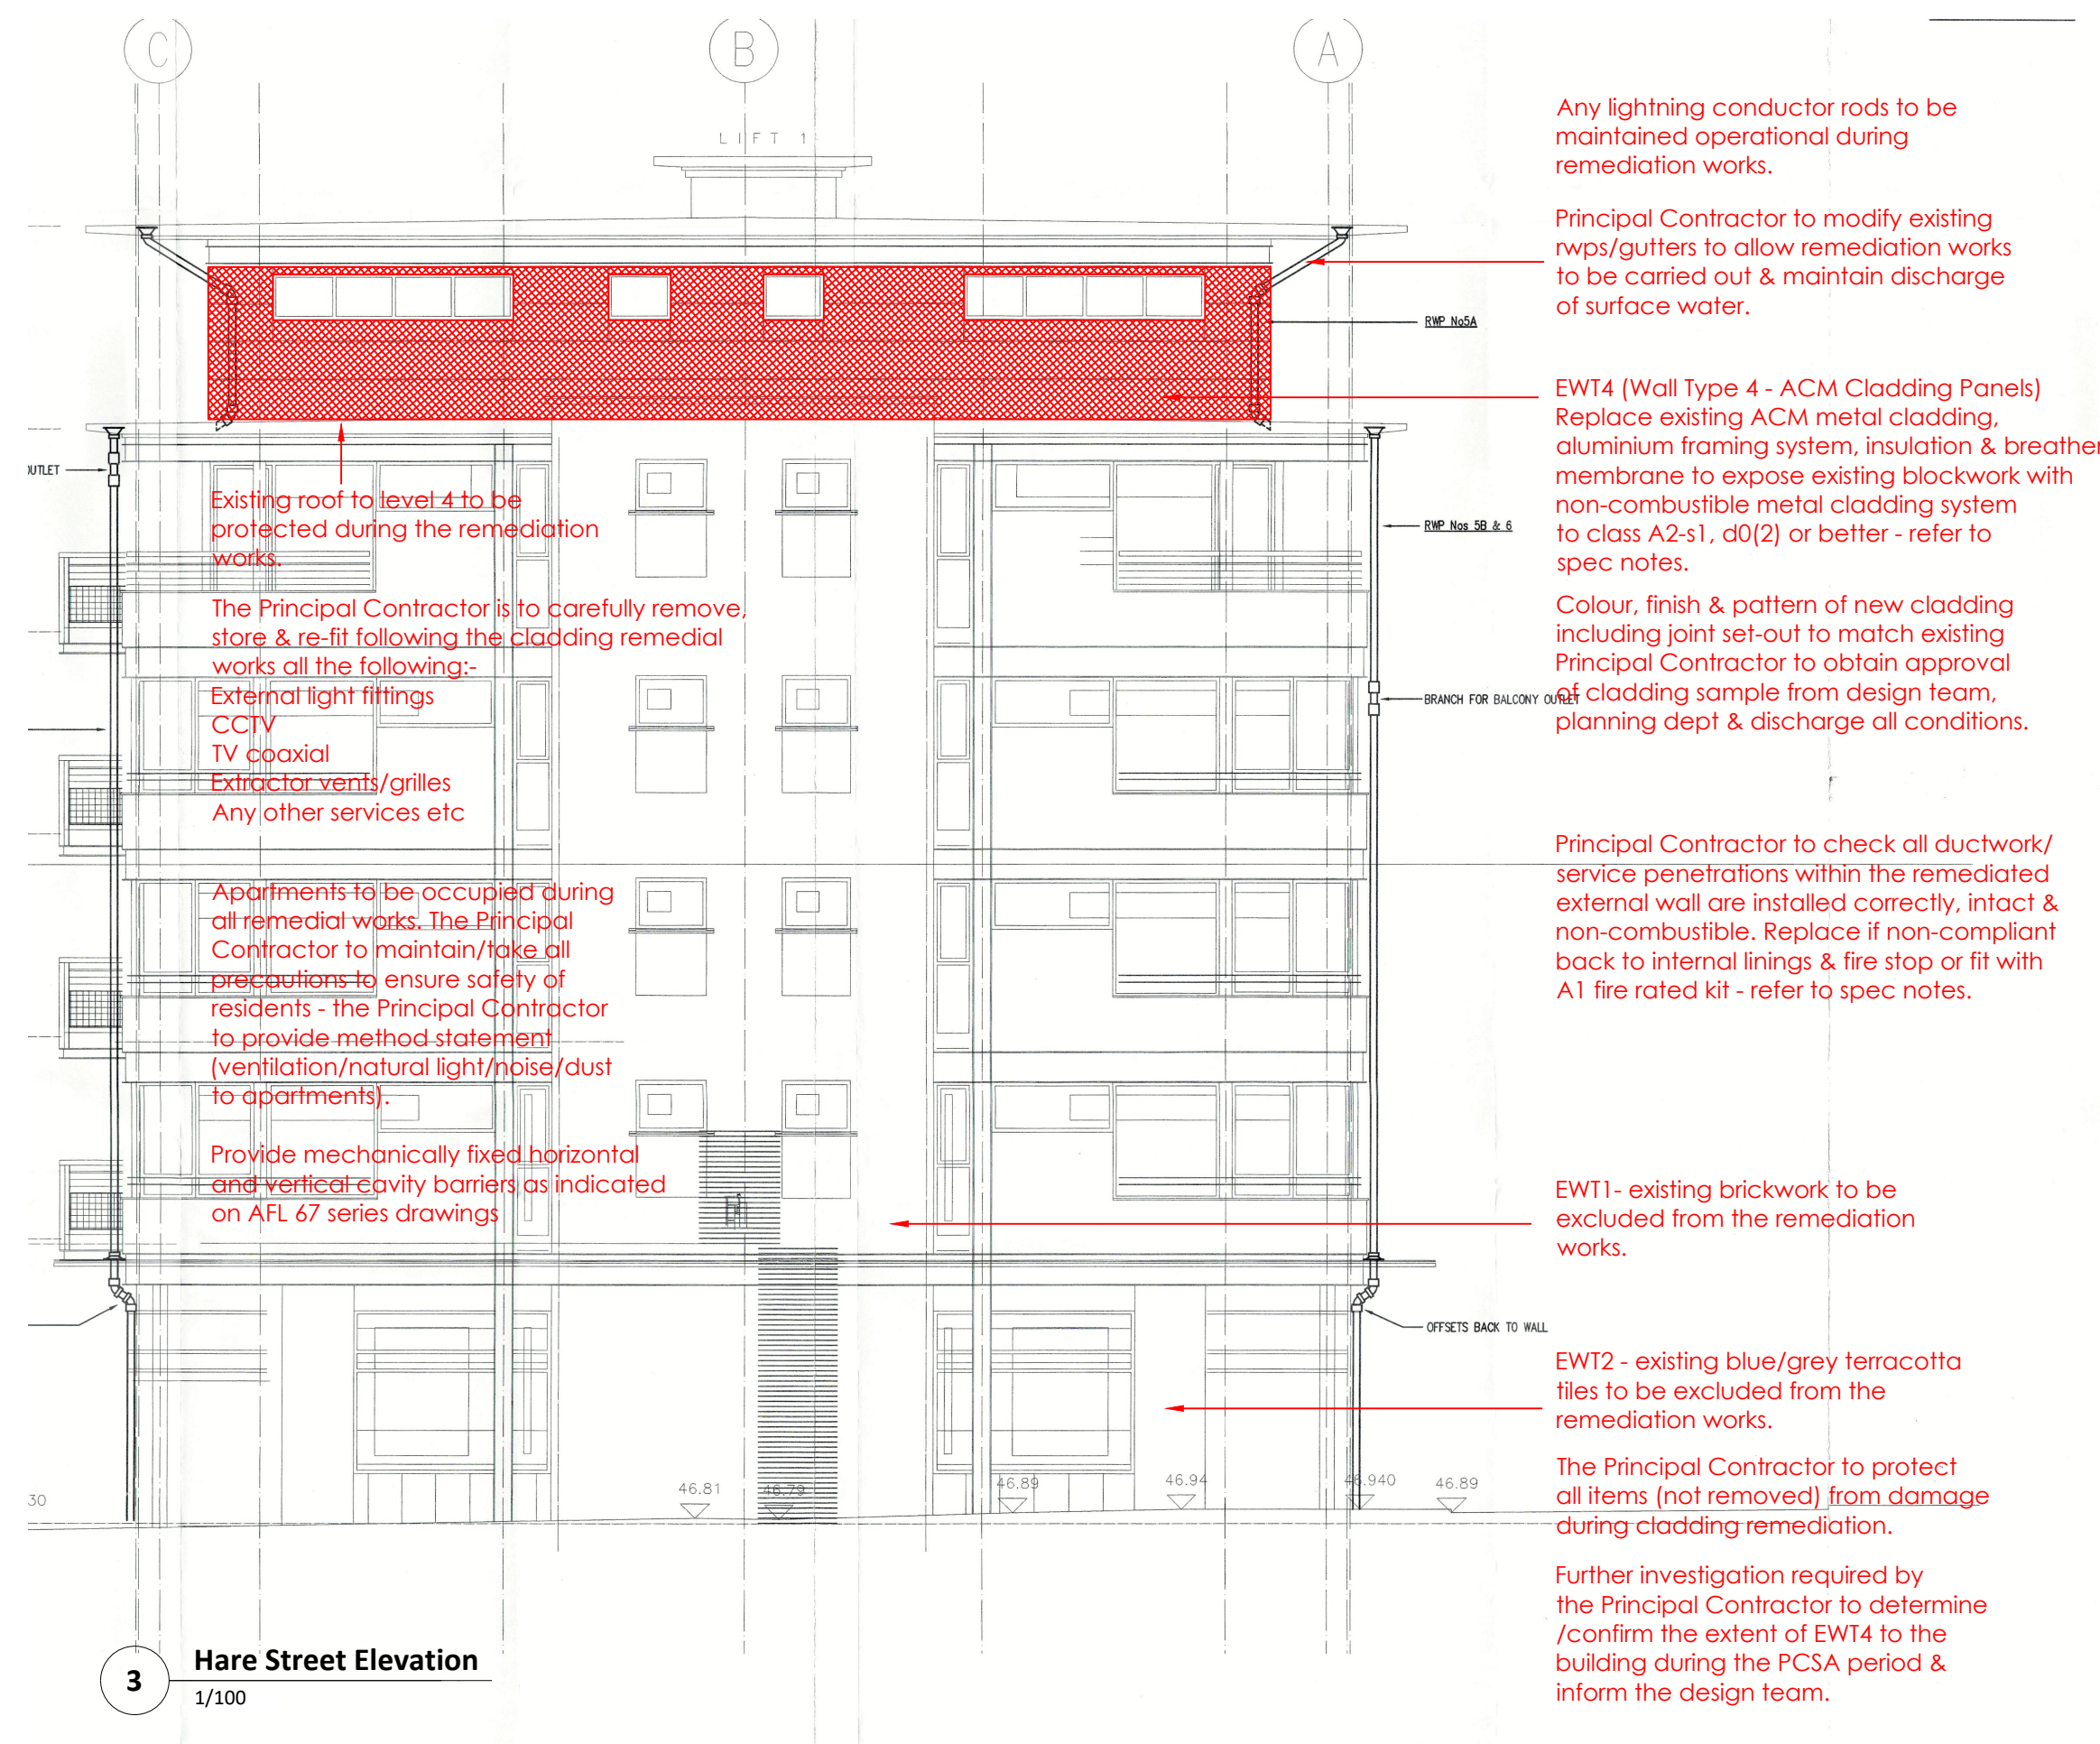


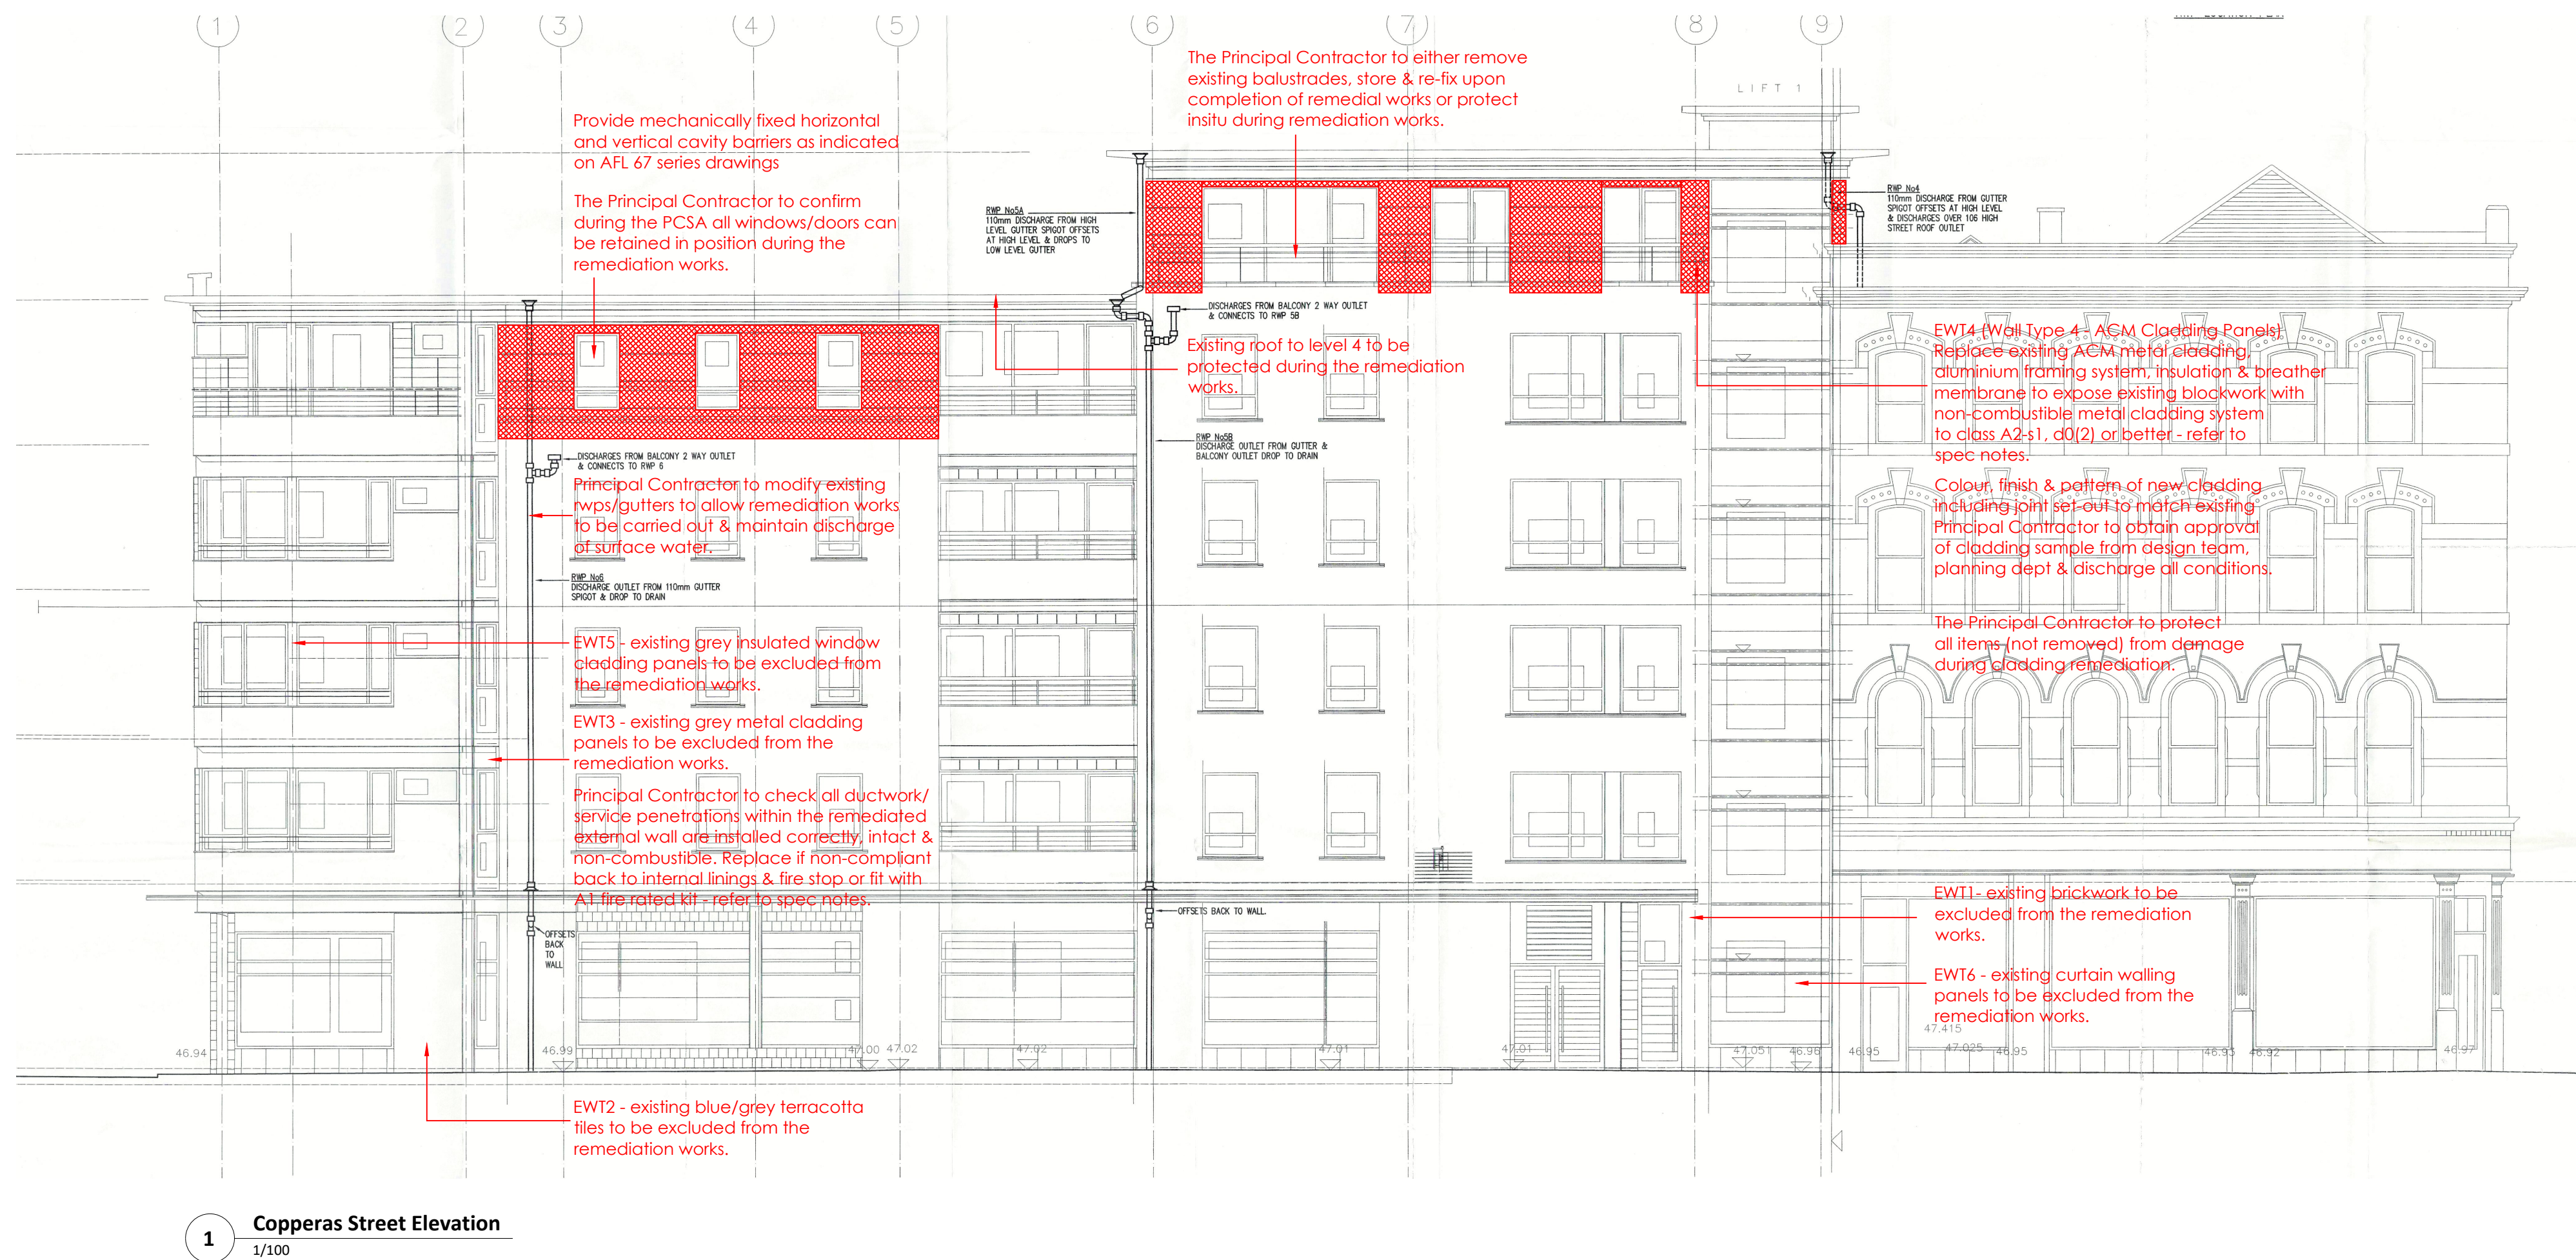

No as-built drawings provided for Edge Street elevation - refer to proposed photographic elevations for information.

**4 Edge Street Elevation**  
1/100

THE PRINCIPAL CONTRACTOR IS TO BASE THE TENDER ON THE ARCHITECTURAL DRAWINGS LISTED TOGETHER WITH THE FOLLOWING DOCUMENTS / INFORMATION:-

- OCTA FIRE RISK APPRAISAL FOR EXTERNAL WALLS (FRAEW) REF: OF00178  
VERSION 01 DATED: 25/02/2025

THE PRINCIPAL CONTRACTOR IS TO PROVIDE FULL SPEC & WARRANTY FOR ALL WORKS. ALL MATERIALS TO HAVE REQUISITE TEST CERTIFICATION AND OR ASSESSMENTS - ALL TO BE AGREED WITH THE CLIENTS TEAM NAMELY:  
PROJECT MANAGER  
ARCHITECT  
FIRE ENGINEER  
BUILDING CONTROL/NHBC GUIDANCE  
CLIENT INSURERS.

ALL PRIOR TO COMPLETING DESIGN, SUPPLY AND FIX.

ALL ASPECTS OF THE FACADE NOT HIGHLIGHTED IN THE WALL BUILD UP LEGEND - AFL PROPOSED PHOTOGRAPHIC ELEVATION DRAWINGS, ARE OMITTED FROM THE SCOPE OF WORKS AS PER OCTA EXTERNAL WALL ASSESSMENT AND THE APPROPRIATE FIRE STOPPING IS IN PLACE.

**ALL PROPOSED CAVITY BARRIER DETAILS, SPECIFICATIONS & LOCATIONS TO BE CONFIRMED TO MEET THE DESIGN INTENT CRITERIA BY THE FIRE ENGINEER AS PART OF THE PCSA.**

**ALL AFL DRAWINGS ARE TO BE PRINTED IN COLOUR.**

**ALSO REFER TO THE FOLLOWING BS REFS:**  
**BS EN 13823 - FIRE TEST METHOD (SBI TEST)**  
**BS EN ISO 1182 - NON-COMBUSTIBILITY TEST**

**NOTES**  
All dimensions and levels to be checked on site  
Any discrepancies are to be reported to the Architect before any work commences  
This drawing shall not be scaled to ascertain any dimensions, work to figured dimensions only  
This drawing shall not be reproduced without express written permission from AFL Architects Ltd.

**DISCLAIMER**  
When this drawing is issued in CAD, it is an uncontrolled version issued for information only, to enable the recipient to prepare their own documents/drawings for which they are solely responsible.

**SOFTWARE INTEROPERABILITY**  
AFL prepared this drawing using Autodesk REVIT Architecture.

AFL does not accept liability for any loss or degradation of any information held in the drawing resulting from the translation from the original file format to any other file format or from the recipients reading of it in any other programme.

Refer to the following AFL drawing nos for scope of work to facade:  
Existing Block Plan - 00100  
Proposed Floor Plans - 20100 to 20105  
Proposed Photographic Elevations - 20200 & 20201  
Proposed Elevations - 20202  
Proposed Typical Cavity Barrier Photo Elevations - 67200 & 67201  
Proposed Cavity Barrier Elevations - 67202  
Typical Existing & Proposed Wall Details - 21400 & 21401  
Typical Cavity Barrier & Fire Stopping Locations - 67400

All cavity barriers are to be re-designed, located, specified & warranted by the manufacturer. All cavity barriers are to be fitted by an approved installer & in accordance with manufacturers spec / details. All AFL drawings are design intent only to maintain the outer face of the building & are based on site investigation by OCTA, site photos & limited existing drawings supplied by the client. All wall build-ups are to be verified on site by the Principal Contractor during the PCSA.

If no project specific wind load calculations are available, the Principal Contractor should supply appropriate localised wind load calculations in support of their proposals.

#### WALL BUILD-UP

**EW4 (Wall Type 4 - ACM Cladding Panels)**  
Replace existing silver ACM cladding and build-up back to existing blockwork including metal cladding support rails, glass wool insulation & membrane. New build-up to consist of non-combustible cladding system to class A2-s1, d0 or better to match existing in accordance with BS EN 13501-1:2018 on aluminium support frame, cavity barriers, breather membrane & insulation to face of existing blockwork. Extent of cladding to be remediated based on OCTA Fire Risk Appraisal.

P2 30-10-25 SIB Stage 3 tender issue  
P1 17-09-25 SIB First issue

| rev no. | rev date | rev by | description |
|---------|----------|--------|-------------|
|         |          |        |             |

Project  
**Agcroft House  
Cladding Remediation Works**

Location  
**34 Copperas Street  
Manchester M4 1HQ**

Employer  
**Dooleys Construction Consultants  
3000 Aviator Way  
Manchester Business Park  
Manchester  
M22 5TG**

Client  
**Agcroft Investment Co Ltd  
14-32 Hewitt Street  
Manchester  
M15 4GB**

AFL Architects  
1st Floor  
St Georges House  
56 Peter Street  
Manchester M2 3NQ

T: +44(0)161 236 6263  
F: +44(0)161 236 6484

W: www.afl-architects.com  
E: mail@afl-uk.com

Twitter.com/AFLArchitects

Key plan



Drawing title

**Proposed Elevations  
Scope of Works  
PCSA**

| AFL job number | scale @ A1 | drawn | SIB | checked | GR |
|----------------|------------|-------|-----|---------|----|
| 254108         | 1/100      |       |     |         |    |

| dwg purpose    | status | rev |
|----------------|--------|-----|
| Stage 3 Tender | S4     | P2  |

bin project origin zone level type role 5-digit no.

**AH-AFL-ZZ-EL-DR-A-20202**