




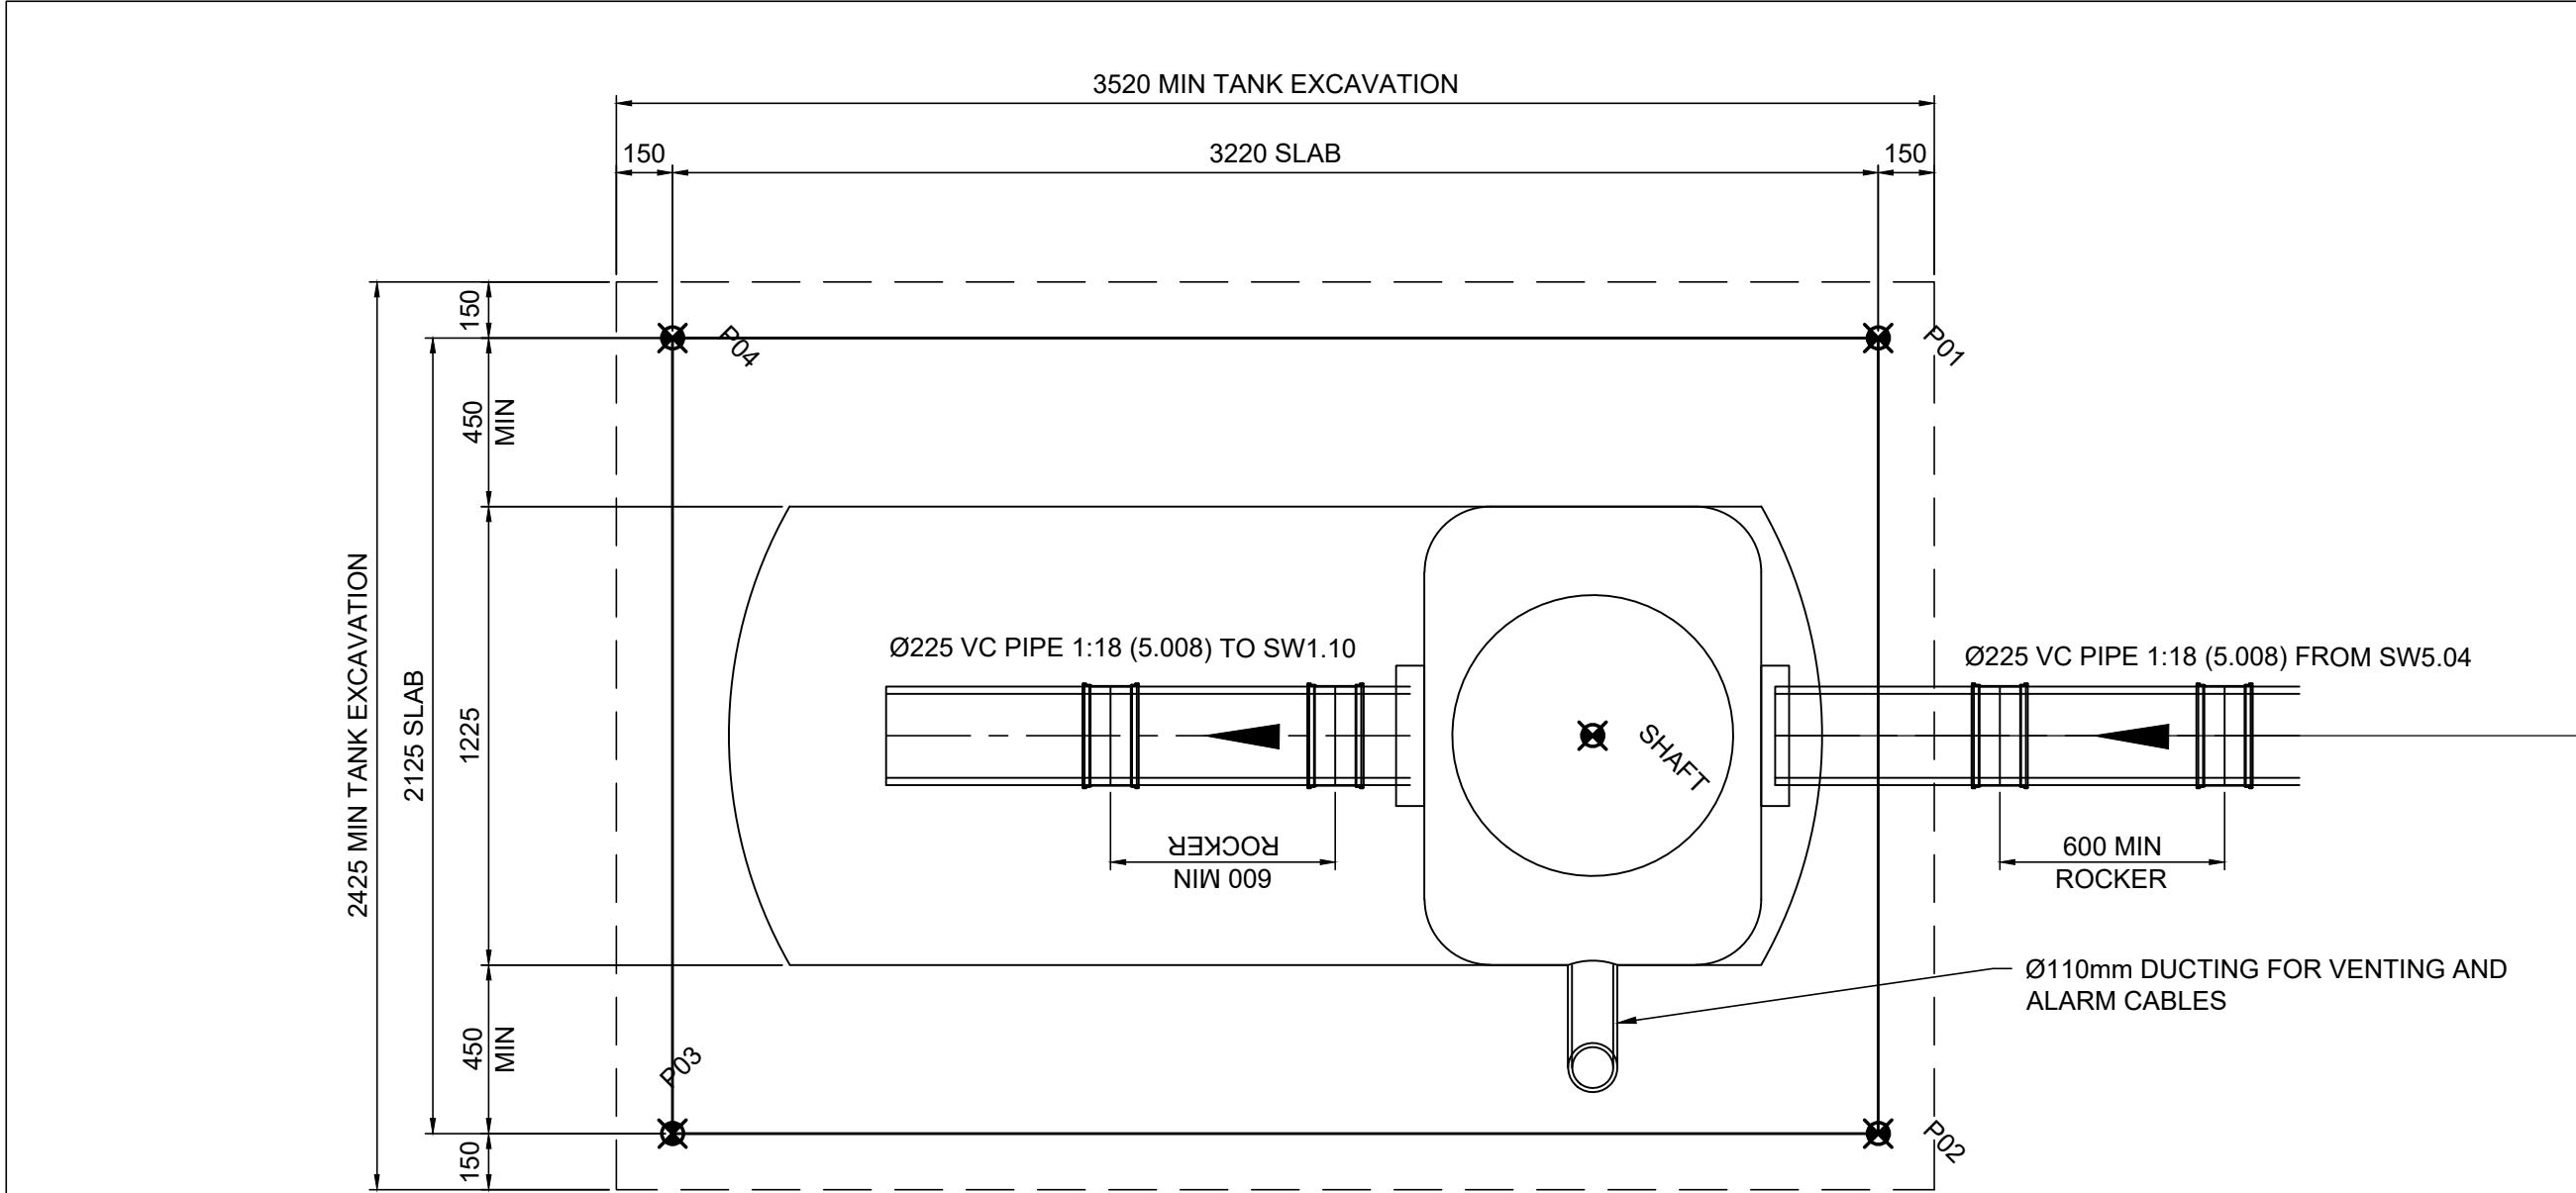


PETROL INTERCEPTOR PLAN
SCALE 1:20

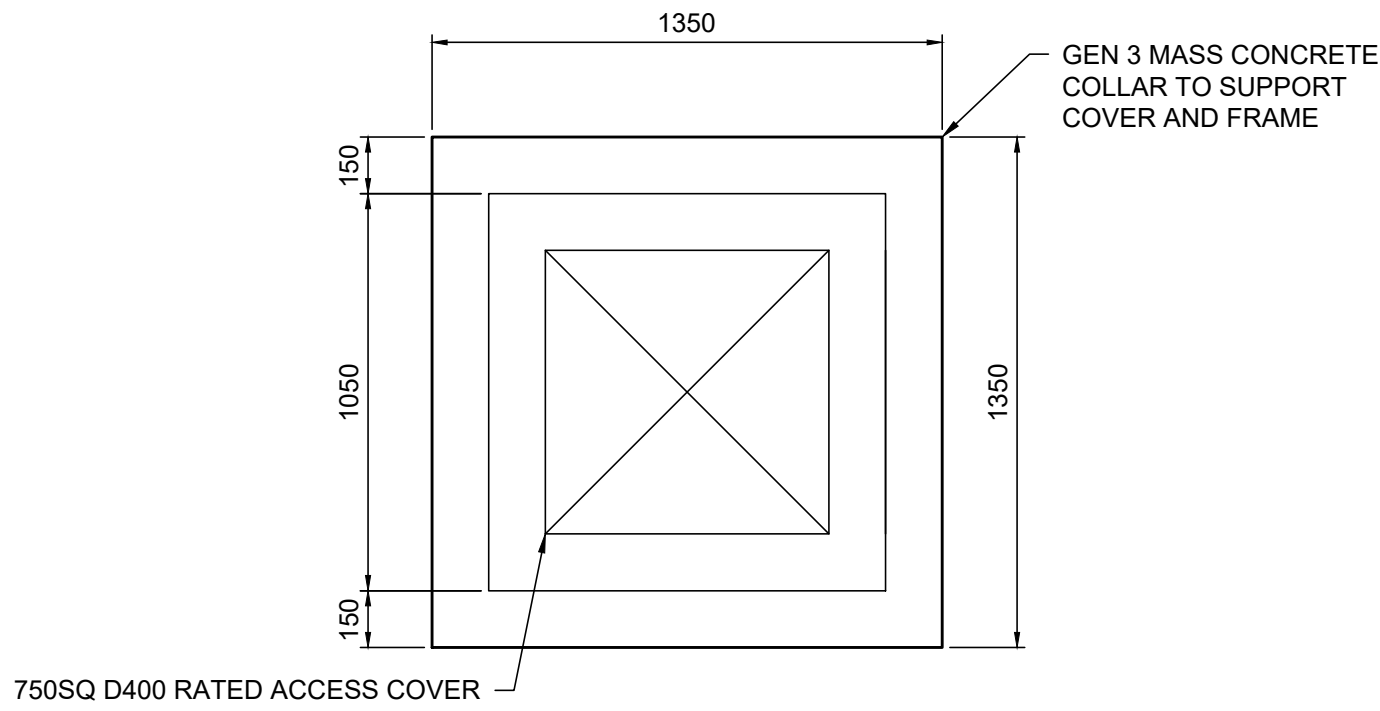

COVER LEVEL PLAN
SCALE 1:20

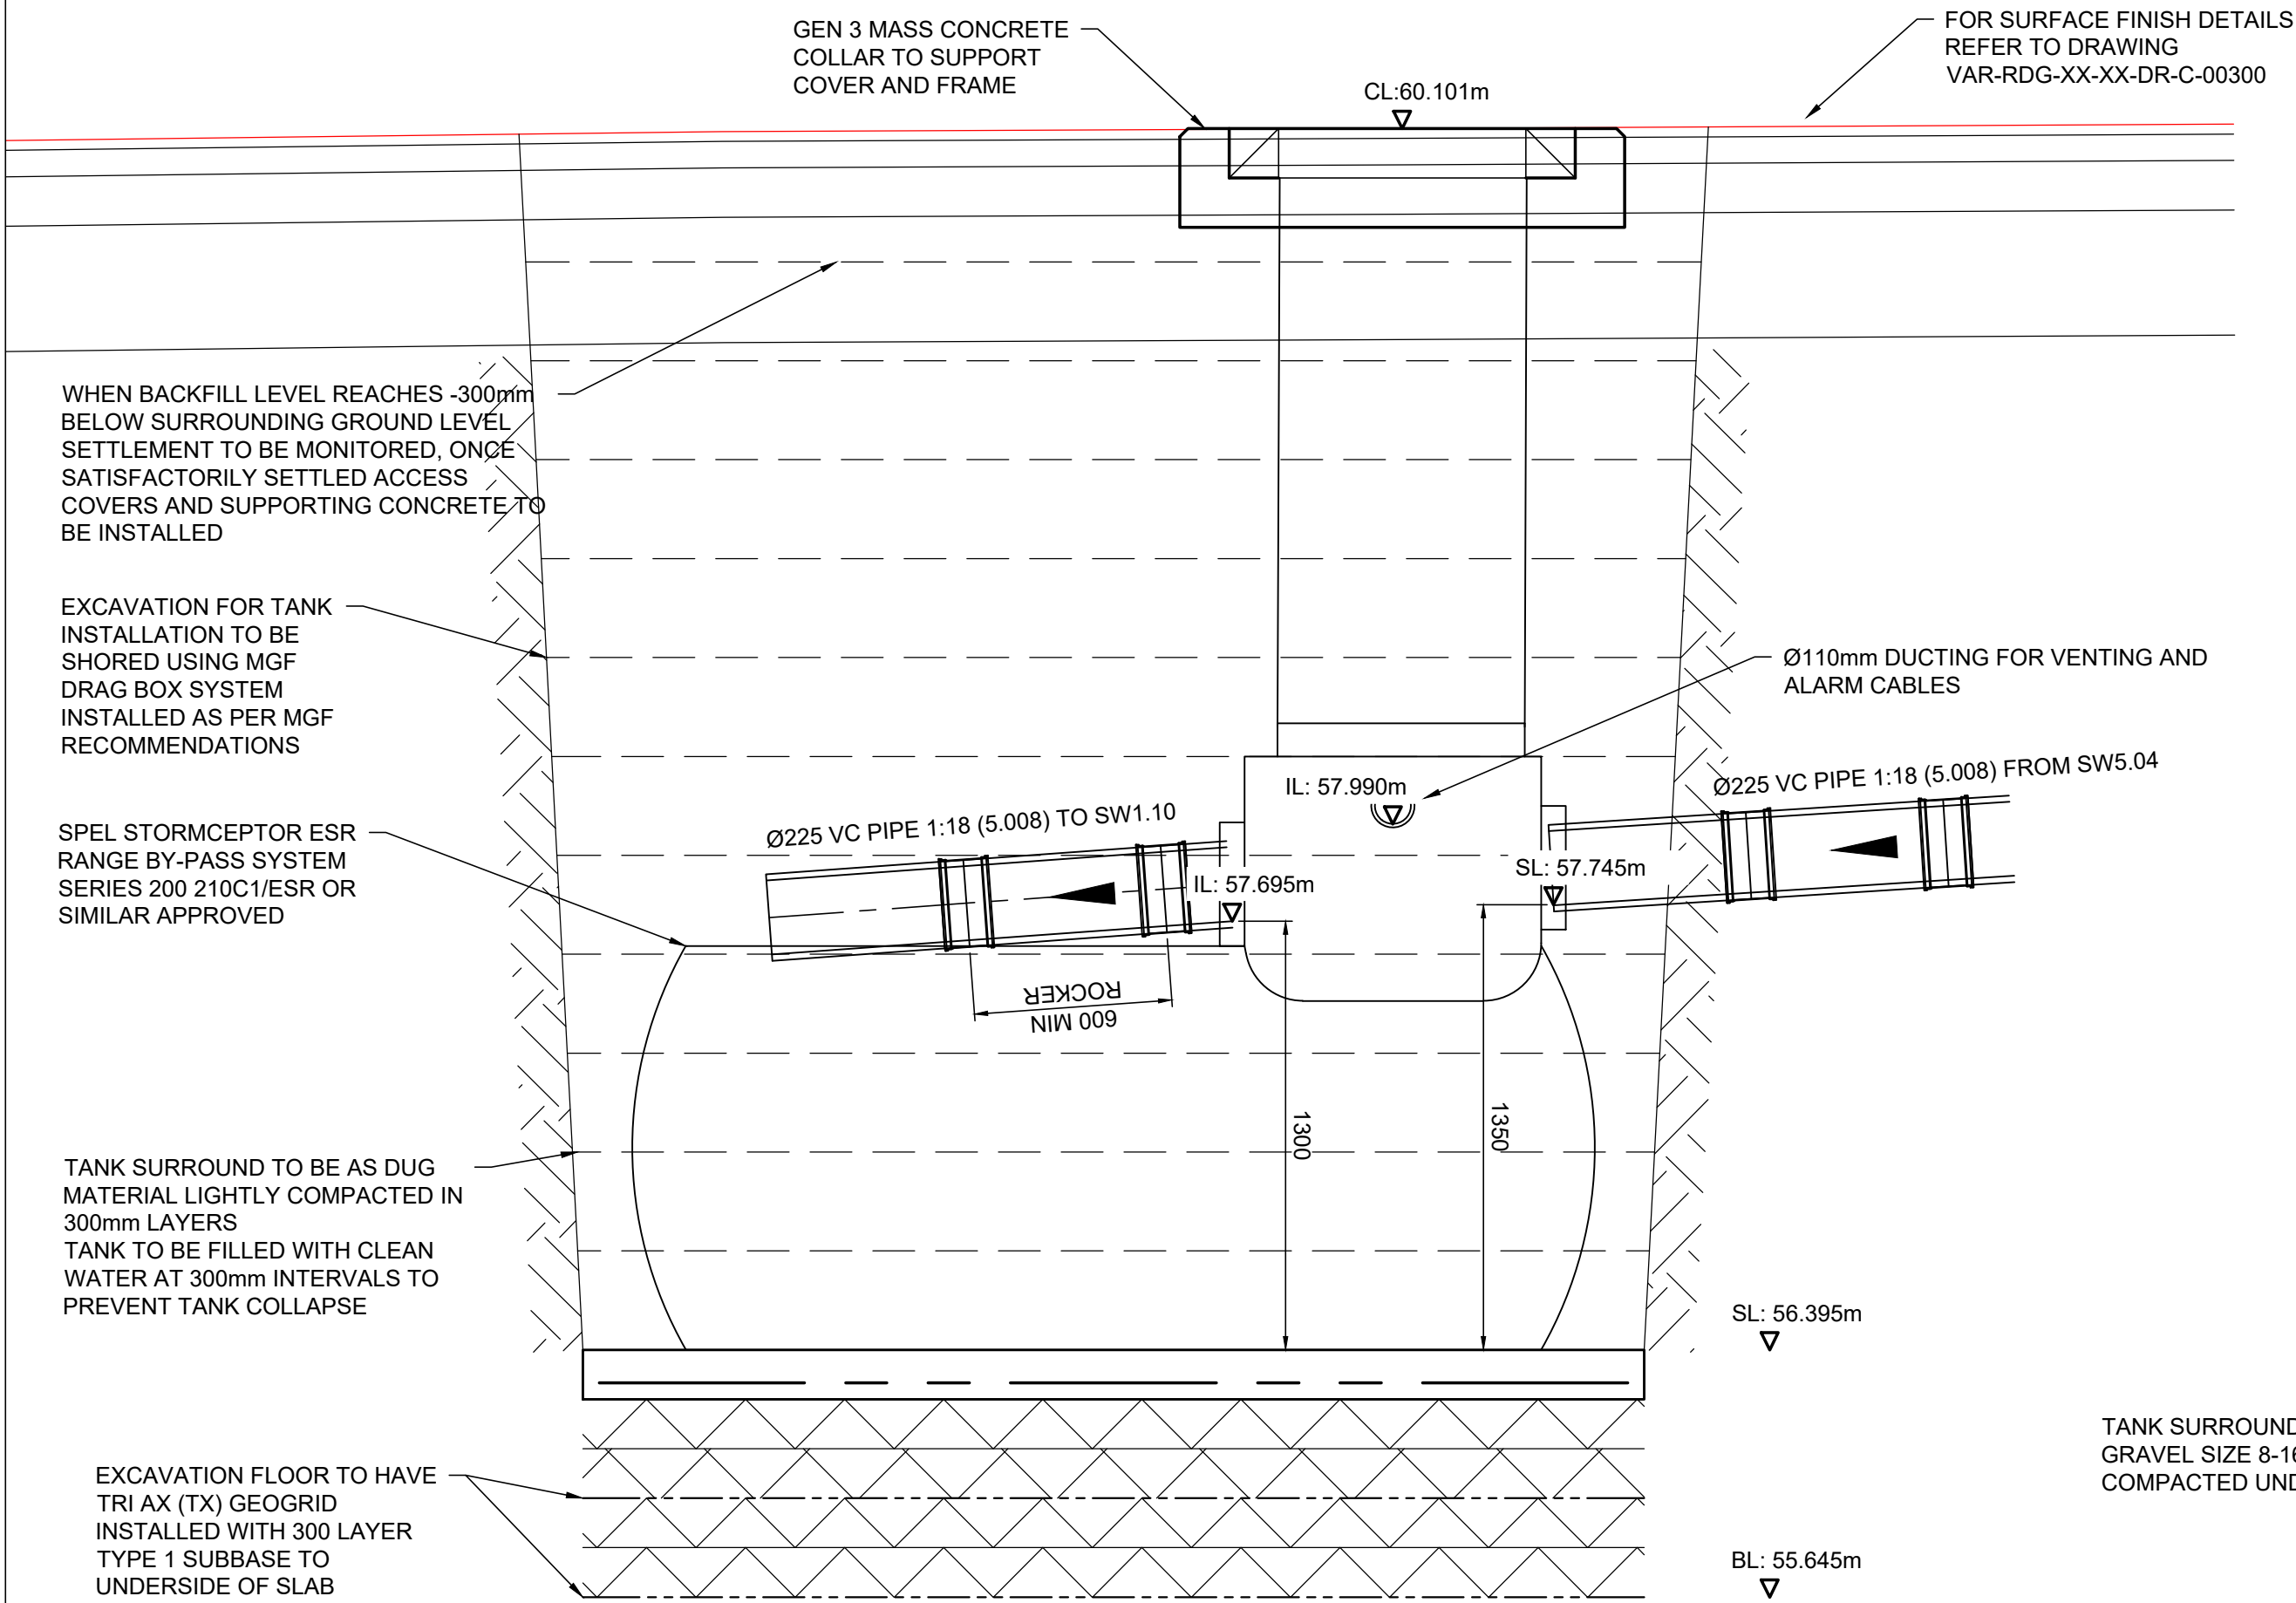

SECTION A-A
SCALE 1:20

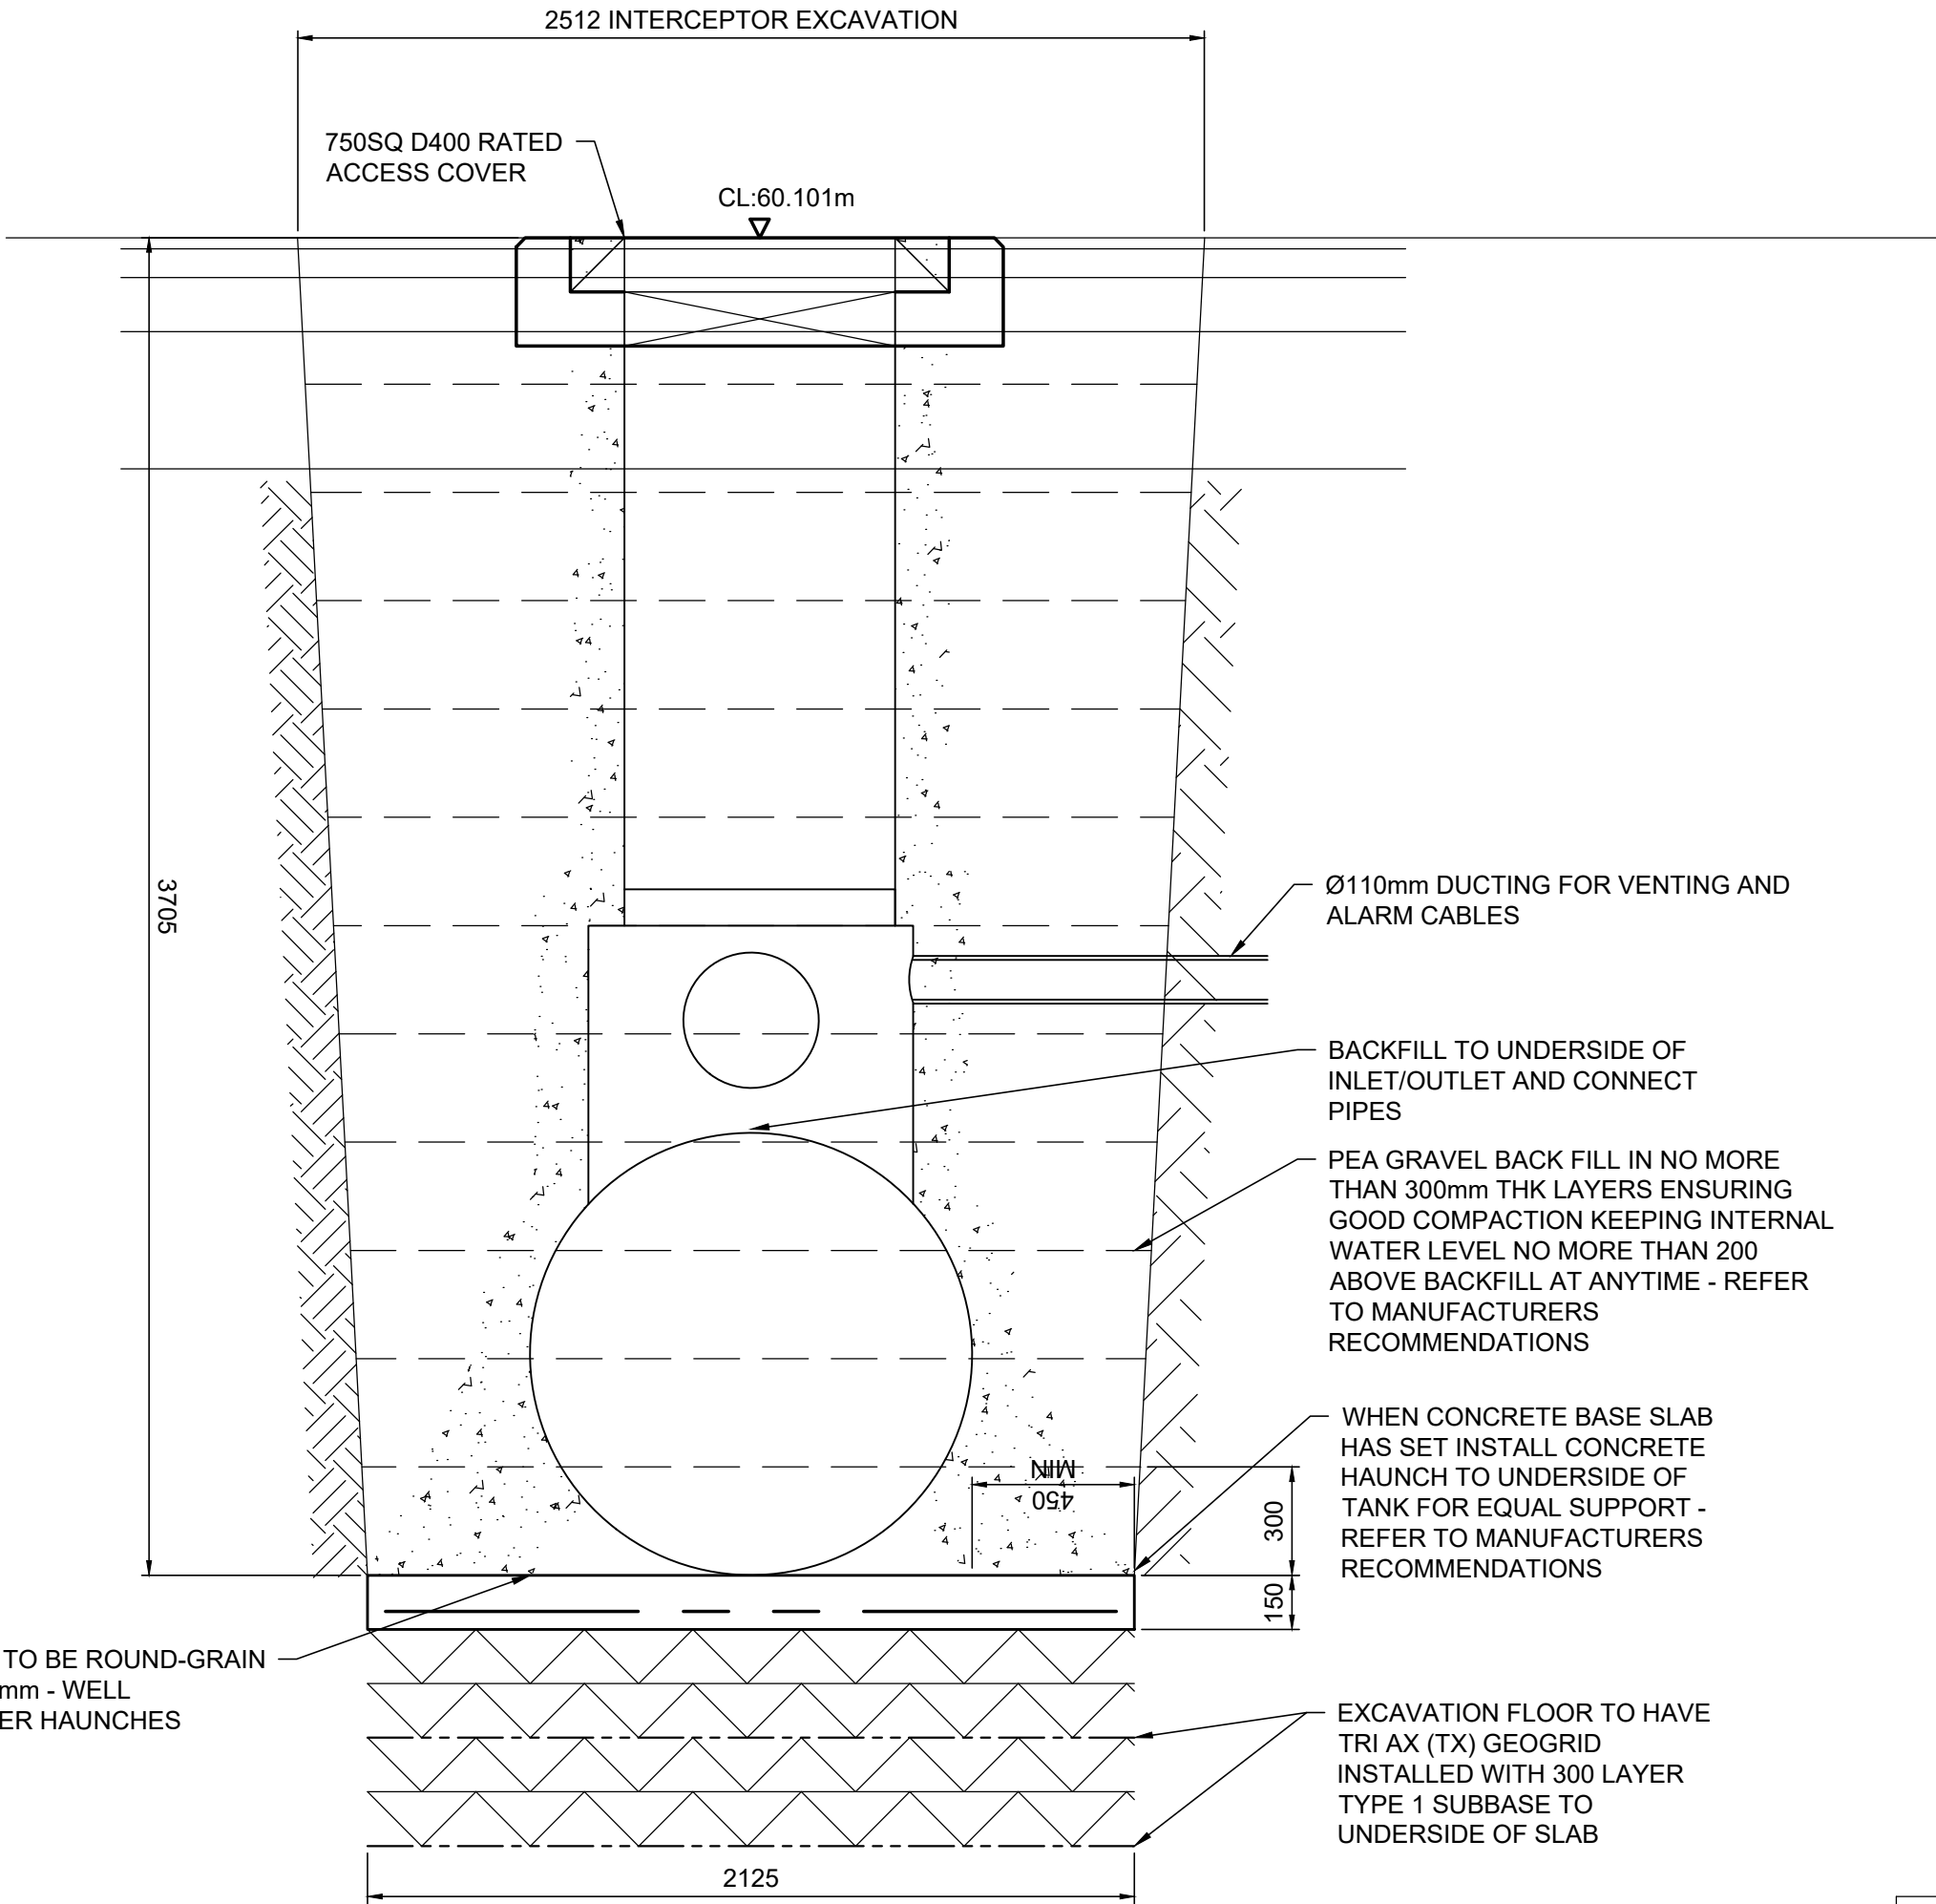

SECTION B-B
SCALE 1:20


CONSTRUCTION RECORD DRAWING

Note:
The information shown on this Construction Record drawing is based on the latest issued Construction drawings which have been modified as necessary with information supplied by the Contractor to incorporate changes made during construction. Information obtained from third parties has not been verified by Ridge and Partners LLP and may not be wholly accurate. Any party seeking to use this drawing must first verify its fitness for the intended purpose with suitable site inspections/investigations as deemed appropriate.

DISCLAIMER NOTES:

- THIS DOCUMENT IS COPYRIGHT OF THE ORIGINATOR AND MUST BE TREATED AS CONFIDENTIAL.
- THIS DOCUMENT MUST NOT BE ALTERED, REPRODUCED OR DISTRIBUTED WITHOUT PRIOR WRITTEN CONSENT OF THE ORIGINATOR
- THIS DOCUMENT MUST NOT BE ALTERED - THE ORIGINATOR ACCEPTS NO RESPONSIBILITY FOR ANY DISCREPANCIES ARISING AS A RESULT OF THE ORIGINATOR'S INFORMATION BEING ALTERED BY OTHERS
- ANY DISCREPANCY MUST BE REPORTED TO THE ORIGINATOR
- DO NOT SCALE THIS DOCUMENT - USE FIGURED DIMENSIONS ONLY
- ALL DIMENSIONS MUST BE CHECKED ON SITE PRIOR TO COMMENCEMENT OF ANY RELATED WORKS
- THIS DOCUMENT MUST BE READ IN CONJUNCTION WITH ALL SUPPORTING DOCUMENTS PRODUCED BY THE ORIGINATOR AND OTHER PROJECT DISCIPLINES
- THE ORIGINATOR ACCEPTS NO RESPONSIBILITY FOR THE ACCURACY OF BACKGROUND INFORMATION PRODUCED BY THIRD PARTIES - THIS MUST BE TREATED AS INDICATIVE ONLY
- USERS OF THIS DOCUMENT ARE RESPONSIBLE FOR CHECKING WHICH REVISION IS CURRENT
- THE DOCUMENT STATUS "INFORMATION" OR "PRELIMINARY", INDICATES THAT THIS DRAWING IS FOR REFERENCE PURPOSES ONLY - THE ORIGINATOR WILL ACCEPT NO RESPONSIBILITY FOR THE COMPLETENESS OF INFORMATION UNDER THIS STATUS
- THE DOCUMENT STATUS "RECORD" OR "AS BUILT" HAS BEEN PREPARED, IN PART, BASED UPON INFORMATION FURNISHED BY OTHERS. WHILE THIS INFORMATION IS BELIEVED TO BE RELIABLE, THE ORIGINATOR ASSUMES NO RESPONSIBILITY FOR THE ACCURACY OF THIS "RECORD" OR "AS BUILT" DOCUMENT OR FOR ANY ERRORS OR OMISSIONS THAT MAY HAVE BEEN INCORPORATED INTO IT AS A RESULT OF INCORRECT INFORMATION PROVIDED TO THE ORIGINATOR. THOSE RELYING ON THE "RECORD" OR "AS BUILT" DOCUMENT ARE ADVISED TO OBTAIN INDEPENDENT VERIFICATION OF ITS ACCURACY

CDM REGULATIONS 2015
SIGNIFICANT OR NON-OBVIOUS RISKS AND RISKS WHICH ARE DIFFICULT TO MANAGE ARE IDENTIFIED ON THIS DRAWING USING THE FOLLOWING SYMBOL IDENTIFIED TO THE RIGHT WITH BRIEF ACCOMPANYING TEXT. FOR FURTHER DETAILS OF THE RISKS IDENTIFIED BY DESIGNERS, REFERENCE SHOULD BE MADE TO CDM HAZARD REGISTER.

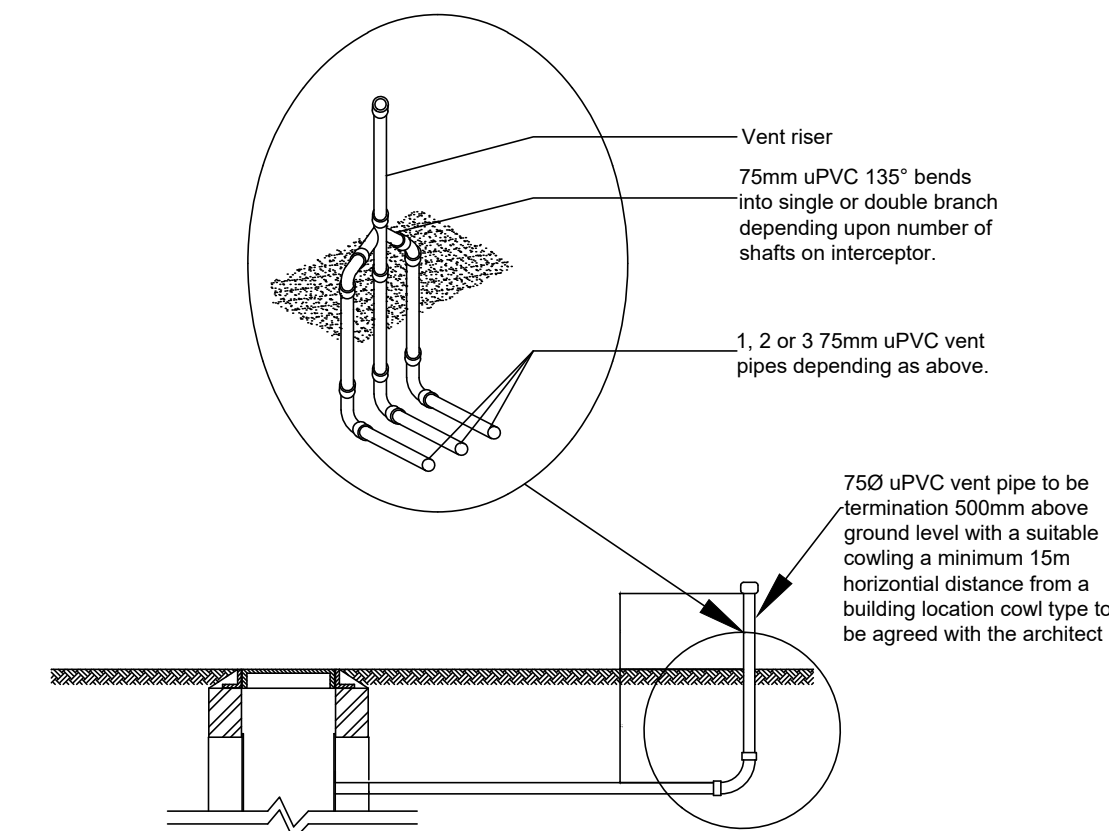

DETAILS OF SURROUNDS TO VENT PIPES

SAFETY, HEALTH & ENVIRONMENT (SHE) INFORMATION

In addition to hazards/risks normally associated with the types of work detailed on this drawing, note the following:


- CONSTRUCTION
- UNCHARTED SERVICES MAYBE PRESENT. KNOWN SERVICES ARE SHOWN ON THIS DRAWING.
 - DEEP EXCAVATION - CONTRACTOR TO HAVE APPROVED SAFE WORKING PRACTICES IN PLACE
 - WORKING OVER EX COAL MINES - COAL AUTHORITY REPORT TO BE USED AND CONTRACTOR TO HAVE SAFE WORK AND GROUND MONITORING METHODS IN PLACE.

MAINTENANCE / CLEANING

- REFER TO

DECOMMISSIONING / DEMOLITION

- REFER TO

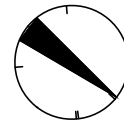

200 0 200 400 600 800 1000
SCALE 1:20 mm

SETTING OUT POINTS		
SOP	EASTING	NORTHING
P01	386074306	399534527
P02	386075988	399535825
P03	386077955	399533275
P04	386076272	399531977

No	DATE	DRAWN	REV'D ENG.	AMENDMENT

No	DATE	DRAWN	REV'D ENG.	AMENDMENT
C04	29.09.25	AP	AM	CONSTRUCTION RECORD

C03	13.05.24	JF	PB	CARPARK LEVELS REVERTED TO PREVIOUS REVISION
C02	22.02.24	JF	PB	CARPARK LEVELS LOWERED - COVER LEVEL UPDATED
C01	23.10.23	JF	AM	CONSTRUCTION ISSUE
P02	25.08.23	JF	PR	STAGE 4 ISSUE
P01	07.07.23	JF	PR	STAGE 4 ISSUE
No	DATE	DRAWN	REV'D ENG.	AMENDMENT

STATUS	PURPOSE OF ISSUE
A6	FINAL ISSUE
COPYRIGHT: The concepts and the information contained in this document are the copyright of Ridge and Partners LLP. Use or copying of the document in whole or in part without written permission of Ridge and Partners LLP constitutes an infringement of copyright.	



CLIENT	ISG
PROJECT	VARLEY STREET, SEN SCHOOL
DRAFTER	JF
ENGINEER	PR

TITLE	PROPOSED DRAINAGE DETAILS SH3 PETROL INTERCEPTOR AND VENTS
SCALE	1:20
SHEET	A1
DRAWING No	VAR-RDG-XX-XX-DR-C-00507
REV	C04