
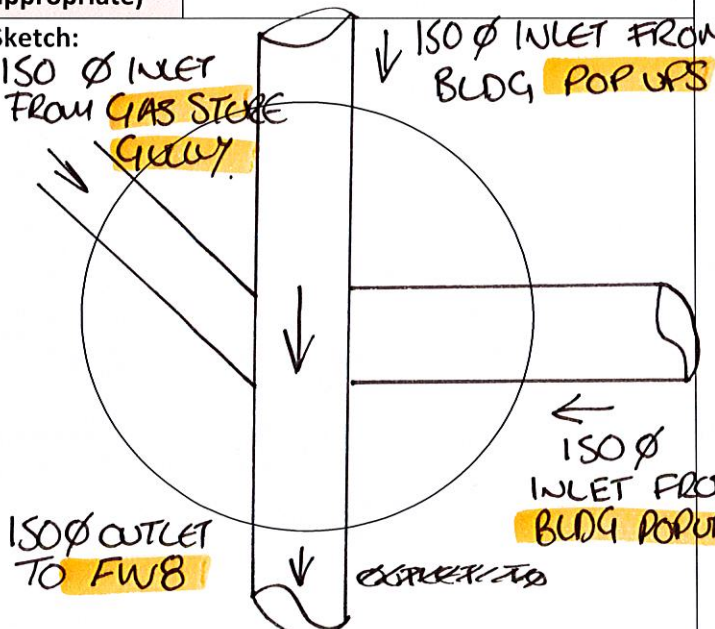


Installation of Manhole			Sheet No:	9.
Project	C376 WITHINGTON CDC		Date:	28/04/2025
Location:	F1	Drawing No:	22182-CCS-WCH006-XX-DR-S-93000	
As built coordinates:	383733.658			
Cover Level:	392002.901			
Manhole No:	MHF1	Type:	FOUL/SURFACE WATER/COMBINED	
Invert:	31.681	(circle as appropriate)		
Inverts and Diameter of pipes:	Upstream: 150mm dia Dia: 31.690 Downstream: 150mm dia Dia: 31.728 Inlet 1: 150dia Dia: 100dia Inlet 2: 31.751 Dia: Inlet 3: Dia: Inlet 4: Dia: Inlet 5: Dia:	Sketch: ISO Ø INLET FROM GAS STORE GUY ISO Ø INLET FROM BLDG POP UPS ISO Ø INLET FROM BLDG POP UPS ISO Ø OUTLET TO FW8 POSITION TO		
Chamber Details:	Dia. Size: 450mm PPIC Overall depth: 1149mm Cover Depth: 100mm Biscuit Depth: 100mm Reducing Slab:			
WORK TO BE INSPECTED	Accepted Yes/ No or N/a	Comments	MW Construction Eng/QA Signed as Checked:-	
Setting out to drawing	YES	moved away from ground beam to allow for buildability.	B.H. S	
Trench excavation supported	YES	Stepped as Required	B.H. S	
Installation of concrete to channel	YES	PPIC CONCRETE BELOW	B.H. S	
Installation of drainage channel/first manhole ring	YES	PPIC	B.H. S	

QA Form - Manholes

MWC Signature confirming invert/positioning check	B.H.S	Date	26/06/2025
Client Signature confirming invert/positioning check	Daniel Allen	Date	27/6/2025

WORK TO BE INSPECTED	Accepted Yes/ No or N/A	Comments	MW Construction Eng/QA Signed as Checked:-
Installation of manhole rings to required levels	YES	Depths and No's of rings: PPIC	B.H.S
Installation of dropshafts/inlets above manhole invert	YES	PPIC	B.H.S
Manhole Surround	YES	Details: CONCRETE	B.H.S
Backfilling to manhole to required level and layers as instructed in spec	YES		B.H.S
Biscuit Installation		Type:	B.H.S
Benching/Water proofing to Manhole	YES	PPIC Shaft Seal Used	B.H.S
Installation of Step Irons	NA	Type & Numbers: PPIC	B.H.S
Brickwork		No of courses:	B.H.S
Lid and Frame		Cover Type:	B.H.S
Client Signature confirming Handover of Manhole:-	Daniel Allen		Date 12/4/25
MWC Signature confirming Handover of Manhole:-			Date 19-9-25

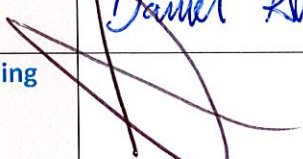

