


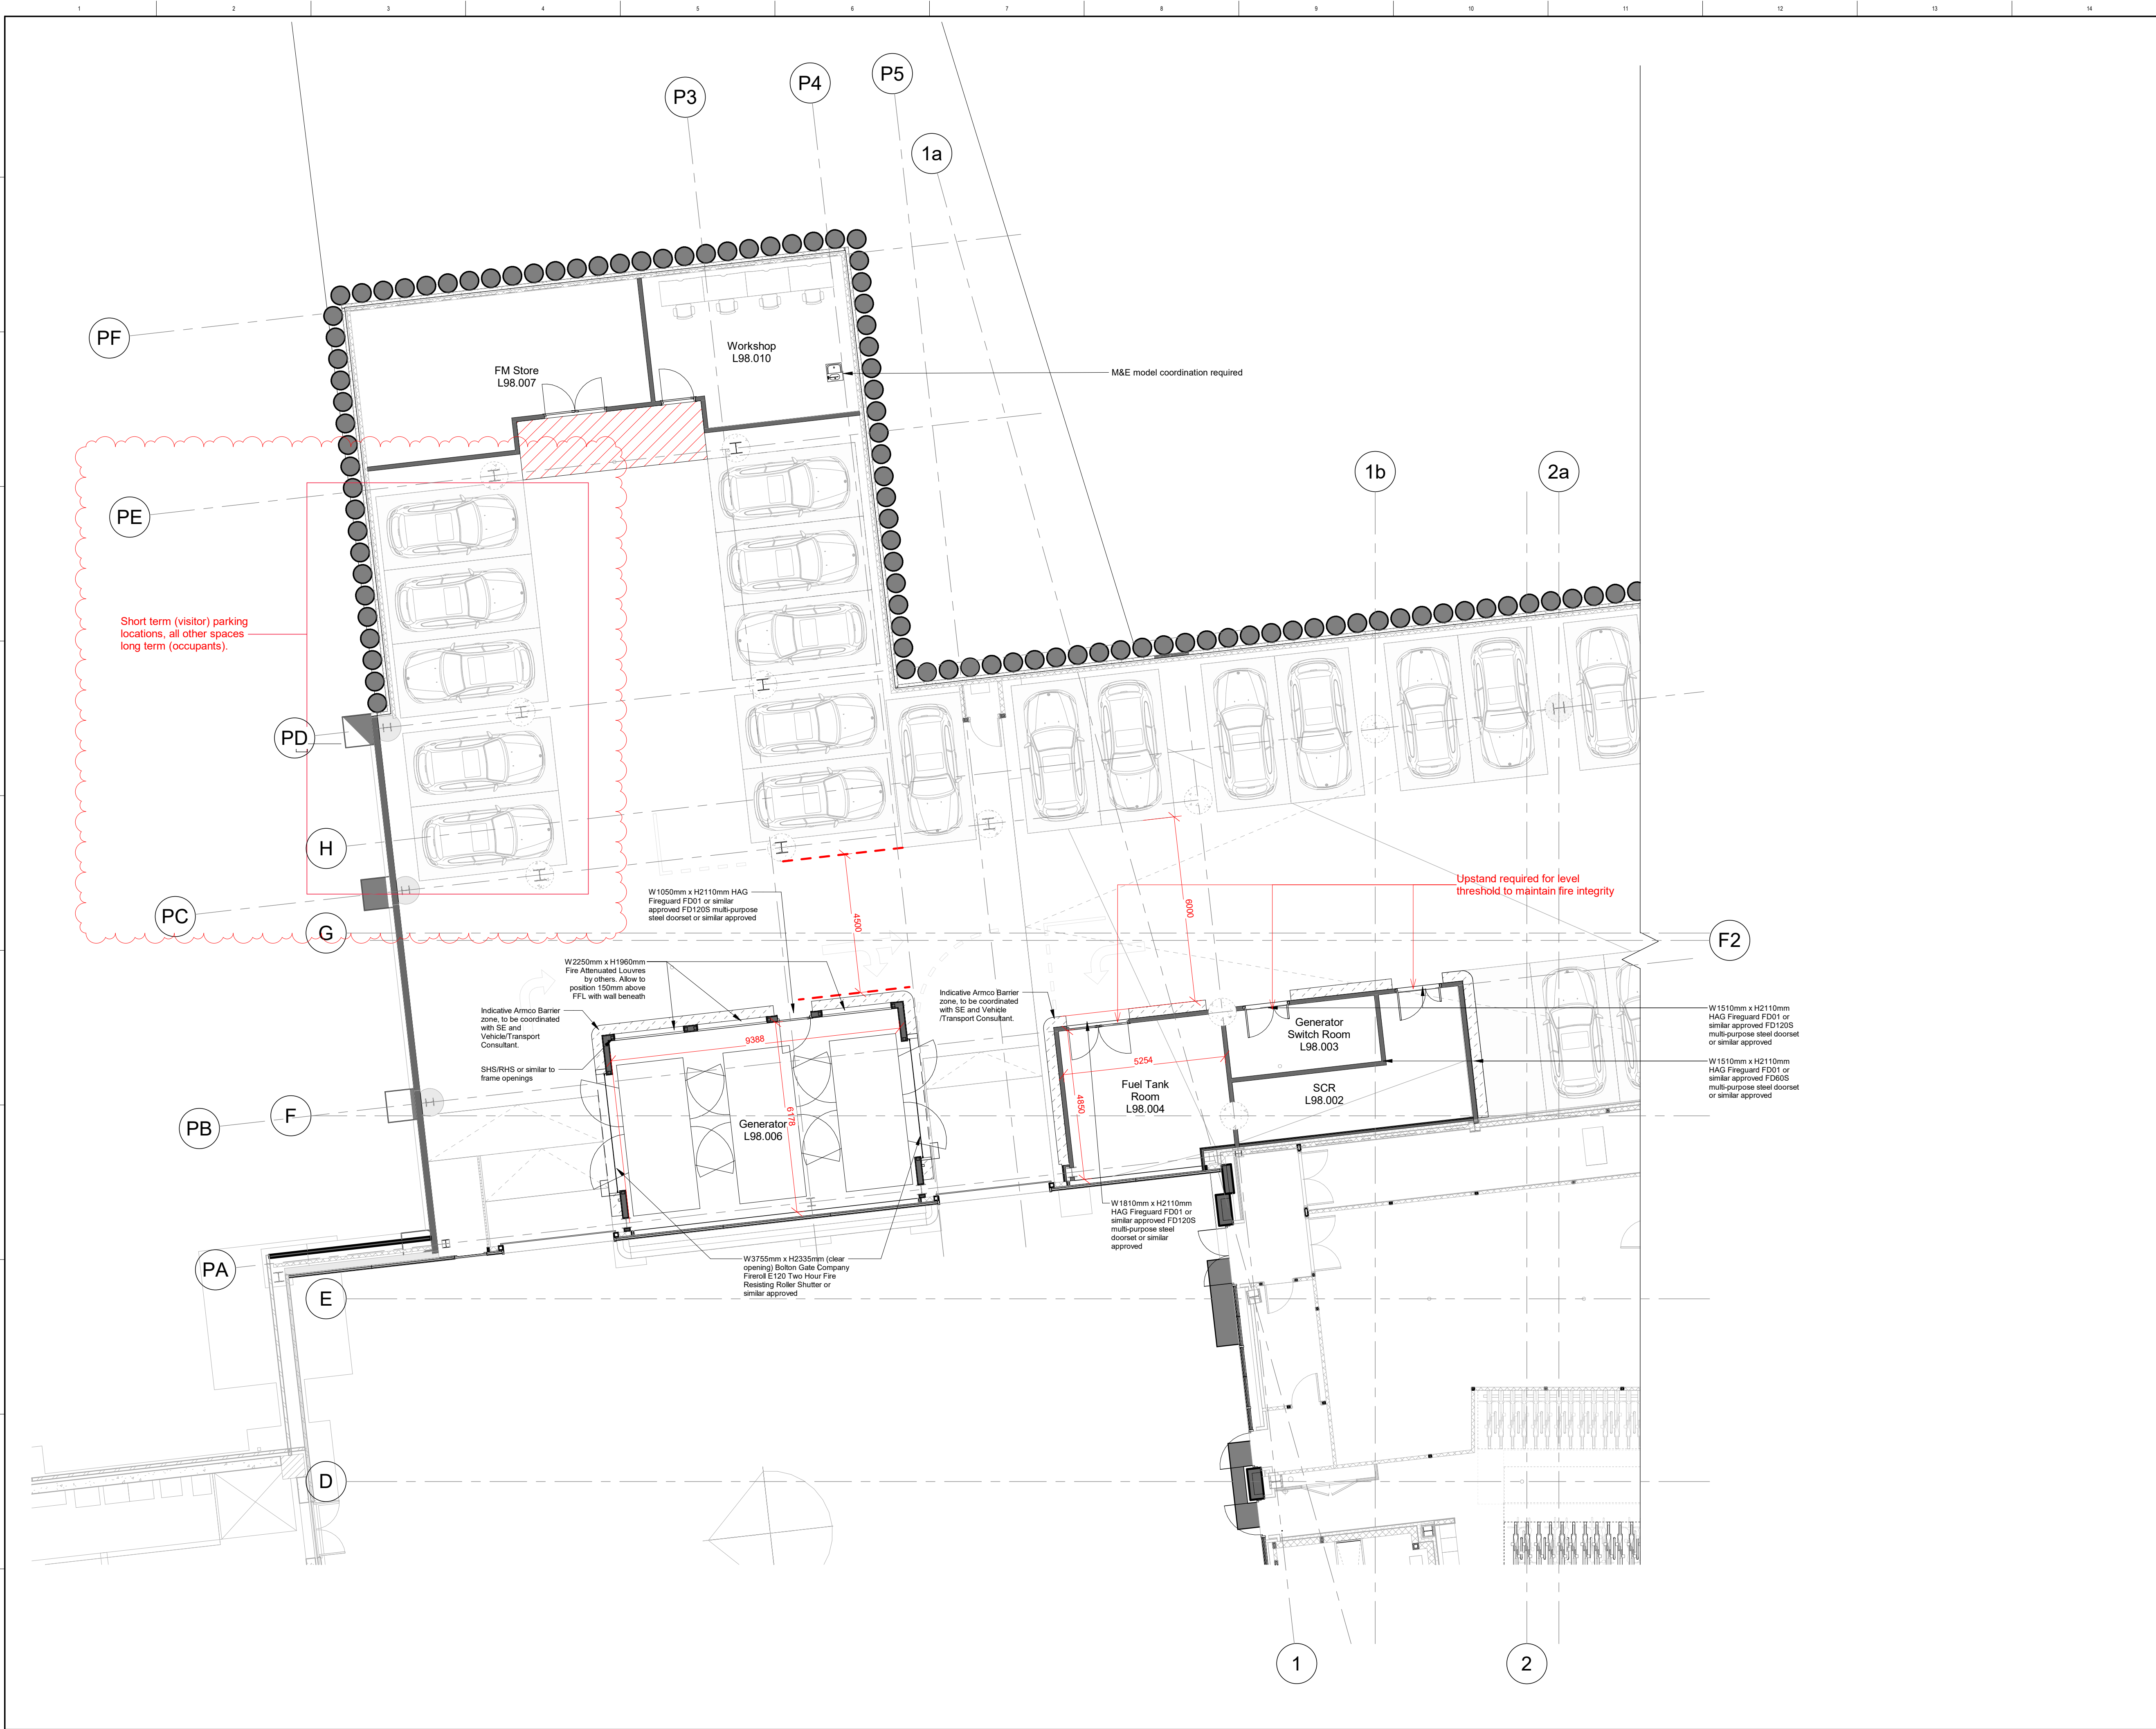


Client Name
Overbury

Structural Engineer Name
Buro Happold

Services Engineer Name
Crookes Walker

Consultant Name
Walker Sime

Key plan

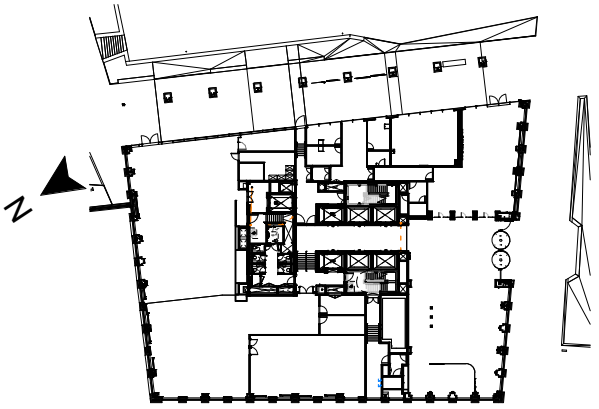

Notes:
Do not scale. Figured dimensions only to be taken from this drawing. Check dimensions on site & report discrepancies to the architect.

This Drawing is protected by copyright. ©

All areas have been measured from current drawings. They may vary because of (EG) survey, design development, construction tolerances, statutory requirements or re-definition of the areas to be measured.

C11	12-02-2025	Drawings amended to align with requirements for LEED accreditation	SOF	PPR
C10	14-01-2025	Drawing updated as per EAI12	TLB	PPR
C09	03-12-2024	Drawing updated to suit Change Request 6 = EAI's 02, 03, 04 & 05	SOF	PPR
C08	13-11-2025	Drawings amended in line with the Schedule of Derogation	SOF	AMN
C07	31-10-2025	Drawing updated in line with EAI's 16-19	SOF	AMN
C06	28-10-2025	Comments removed and CWC model filtered off/SOF as requested by Overbury	AMN	
C05	27-10-2025	Sketch option to show SCR proposed change	SOF	AMN
C04	10-10-2025	Furniture model updated and necessary coordination notes amended	SOF	AMN
C03	08-10-2025	Workshop relocated in line with Change Request 4. Generator Switch Room and SCR updated in line with CWC sketch following BNY comments.	TSV	AMN
C02	03-10-2025	Updated Layouts as per CWC sketch	SOF	AMN
C01	30-09-2025	Stage 4 Issue Drawing Incorporating Version 1 and 2 design change mark-ups	SOF	AMN
P06	25-09-2025	Furniture model linked in halftone with relevant coordination notes where required	SOF	PPR
P05	12-09-2025	FD120S door specifications & roller shutter size amended. Louvers added to Generator room.	JTU	PPR
P04	10-09-2025	Basement Generator room layout updated to suit vehicle movement allowance.	DWI	TSV
P03	09-09-2025	Generator and generator room changed to blockwork partitions and layout updated.	SOF	TSV
P02	20-08-2025	FR lining added to Fuel Tank room. Generator room name amended to LV Switch Room. Existing Armo barrier omitted	JTH	AMN
P01	01-08-2025	First Issue	SOF	AMN

Rev.	Date	Comment	Drawn	Checked

Issue Purpose
Construction

tp bennett

Royal Mills Unit 2B 17 Redhill Street Manchester M4 5BA | UK +44 (0) 161 694 7700
www.tpbenett.com

Project
**Bank of New York
4 Angel Square M4 4FW
Manchester**

Drawing Title
**Basement Zone 2
General Arrangement Plan**

Drawn	Date	Scale @ A1	Alt. Ref.
NGR	31/03/2025	1:100	U8912

Project	Originator	Volume	Level	Type	Role	Number	Subsity	Revision
BNYM	TPB	ZZ	B1	DR	ID	201002	A4	C11

Model Ref.: BNYM-TPB-ZZ-B1-DR-ID-201002-A4-C11-SH001