
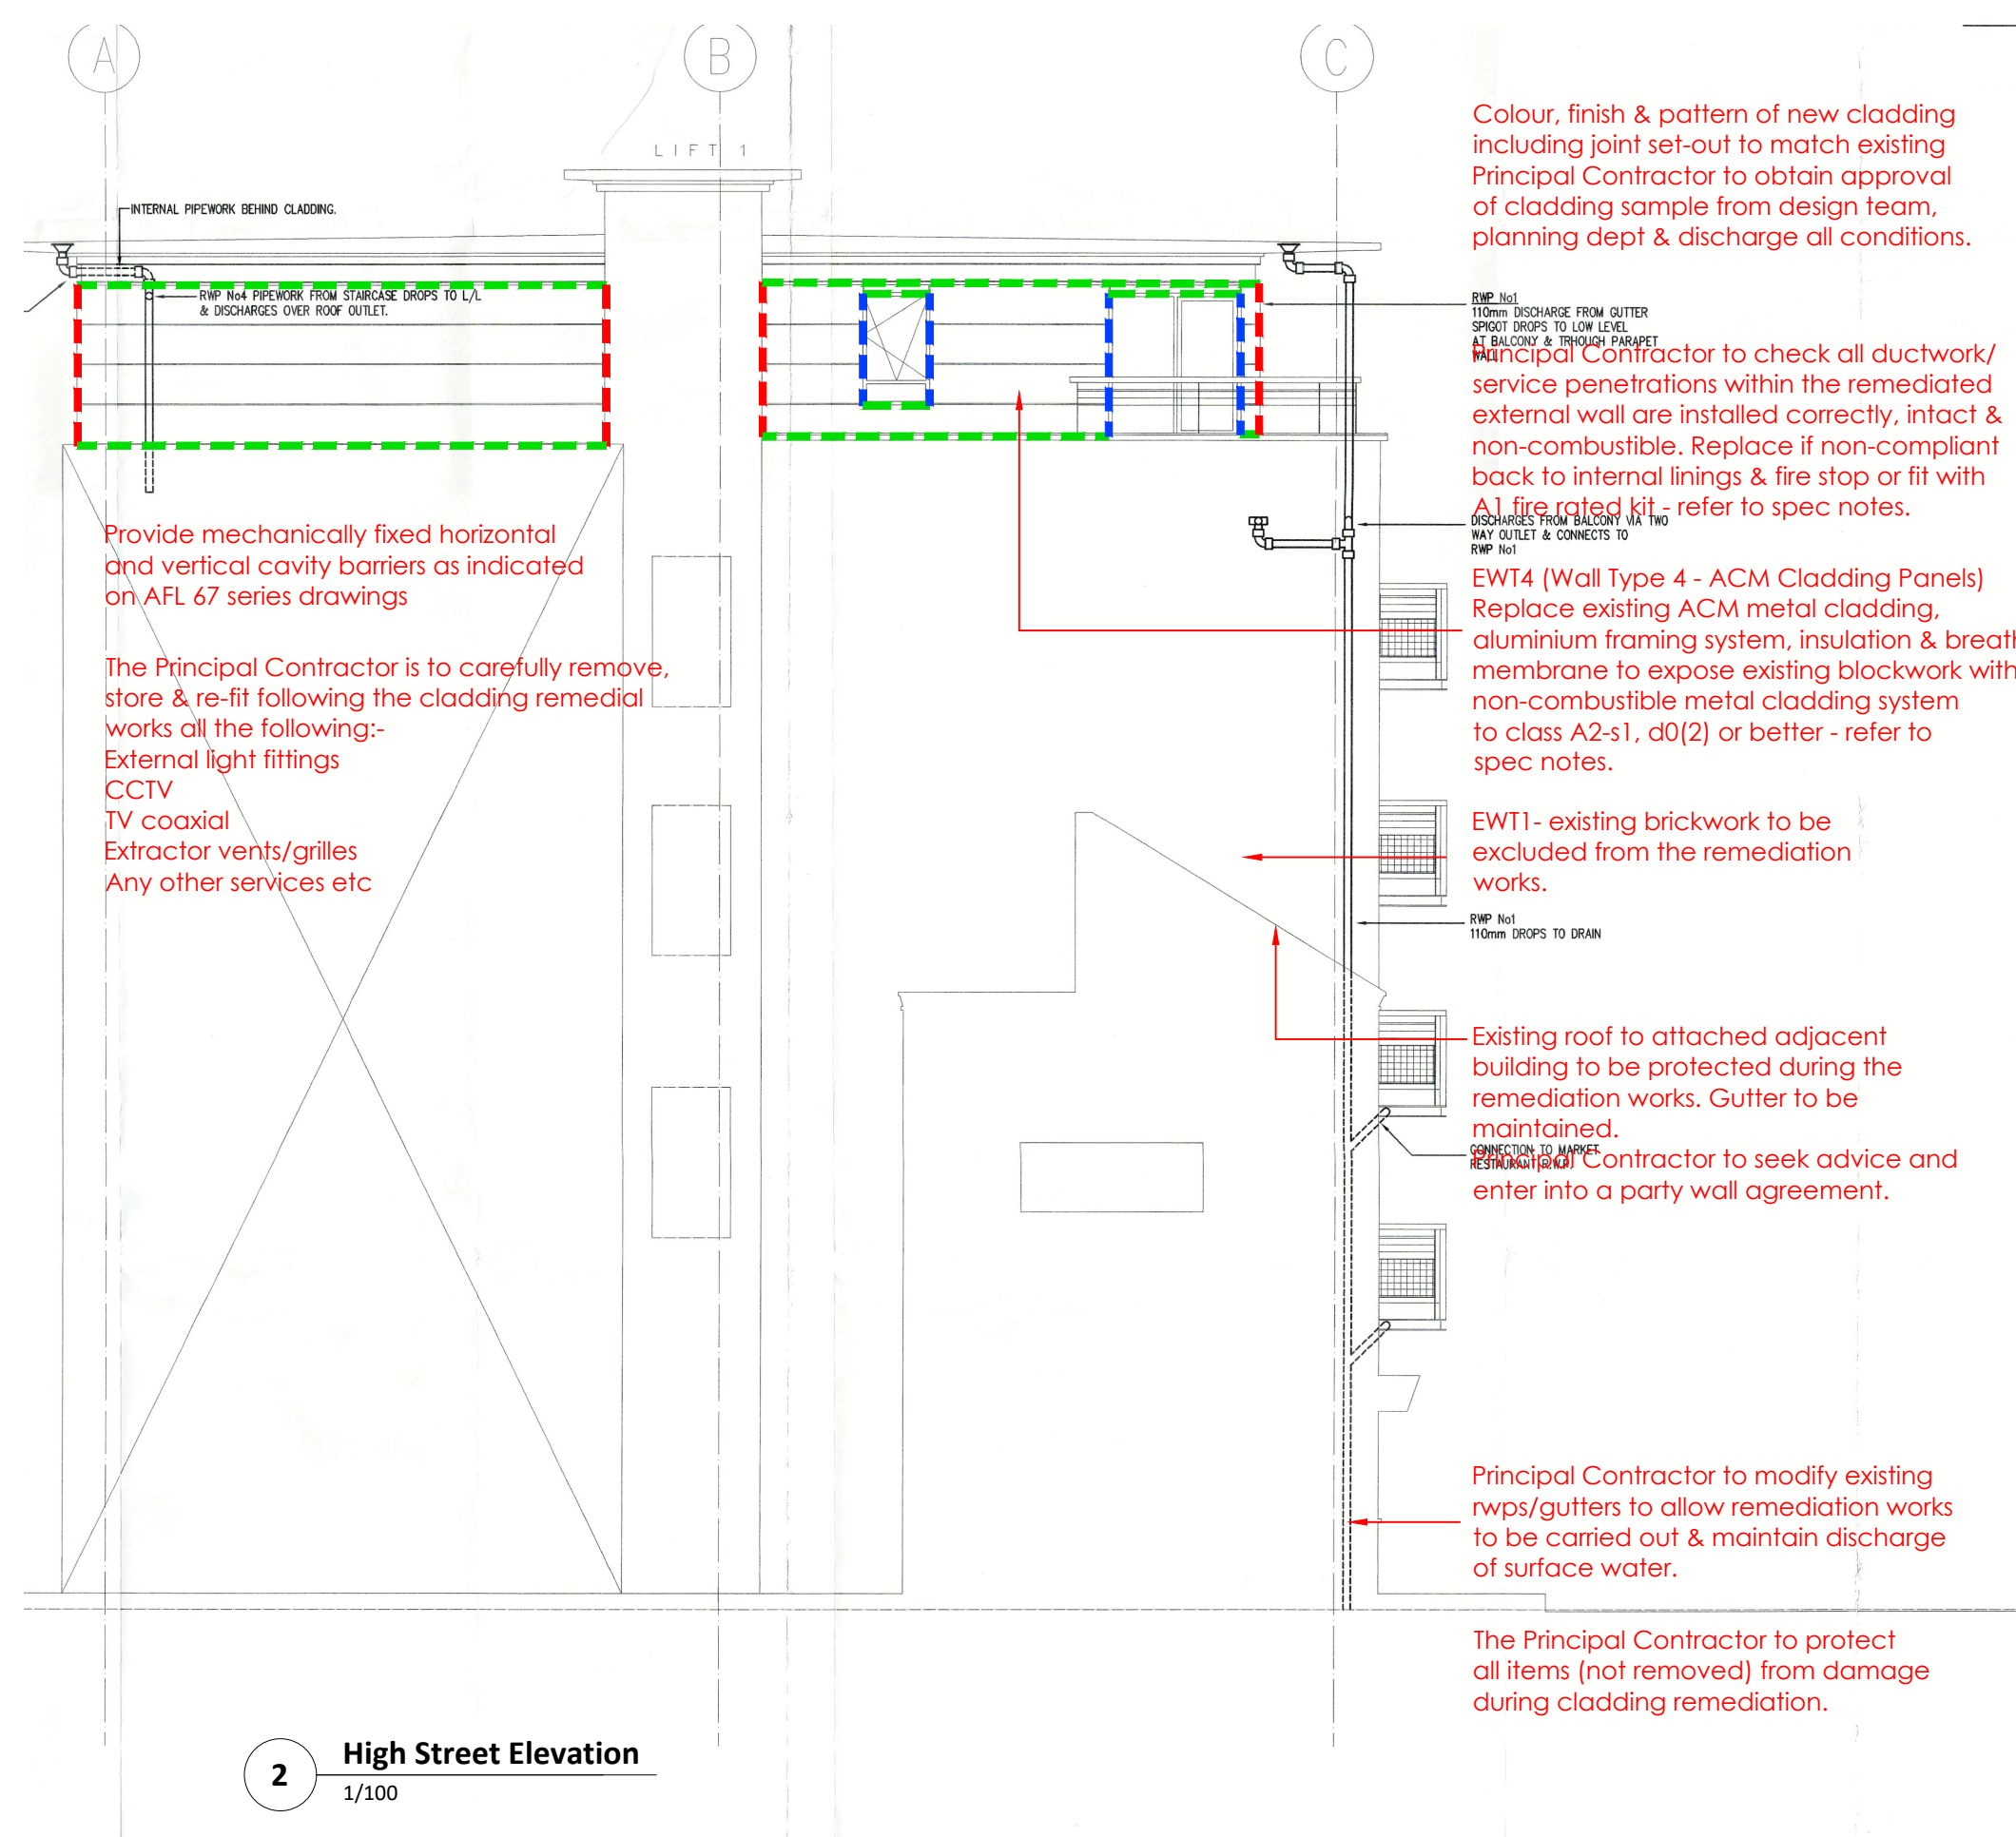
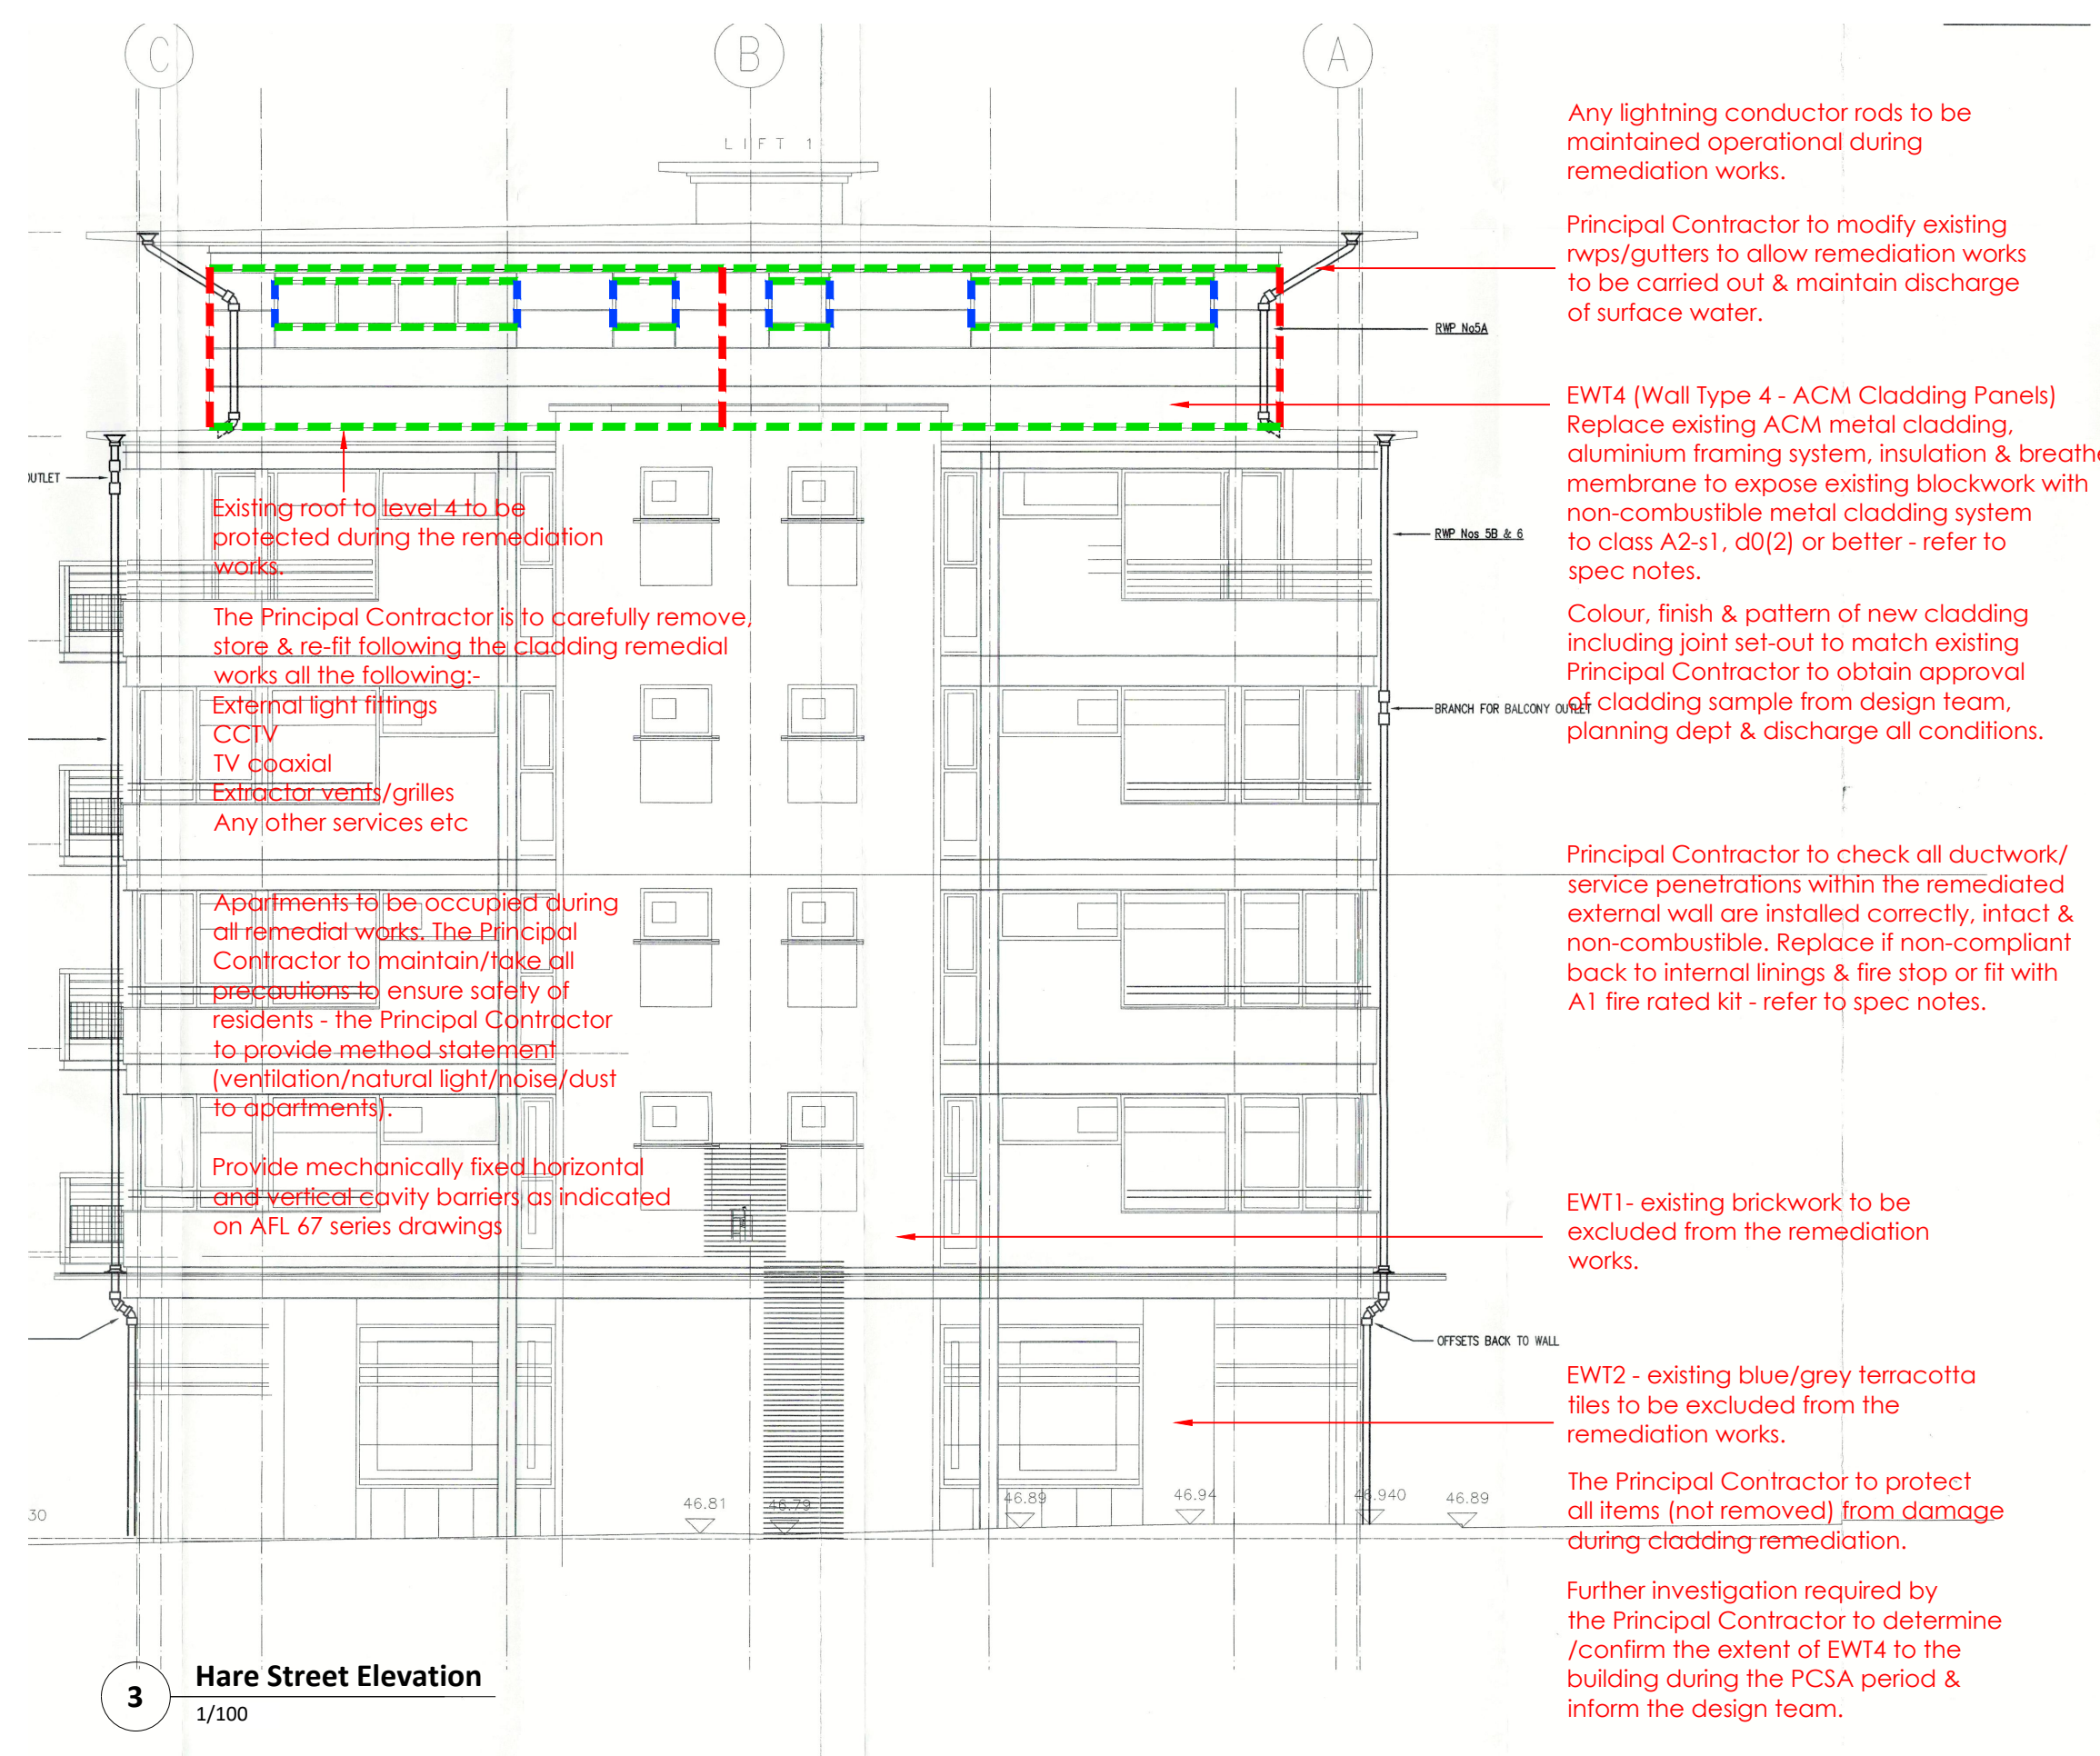


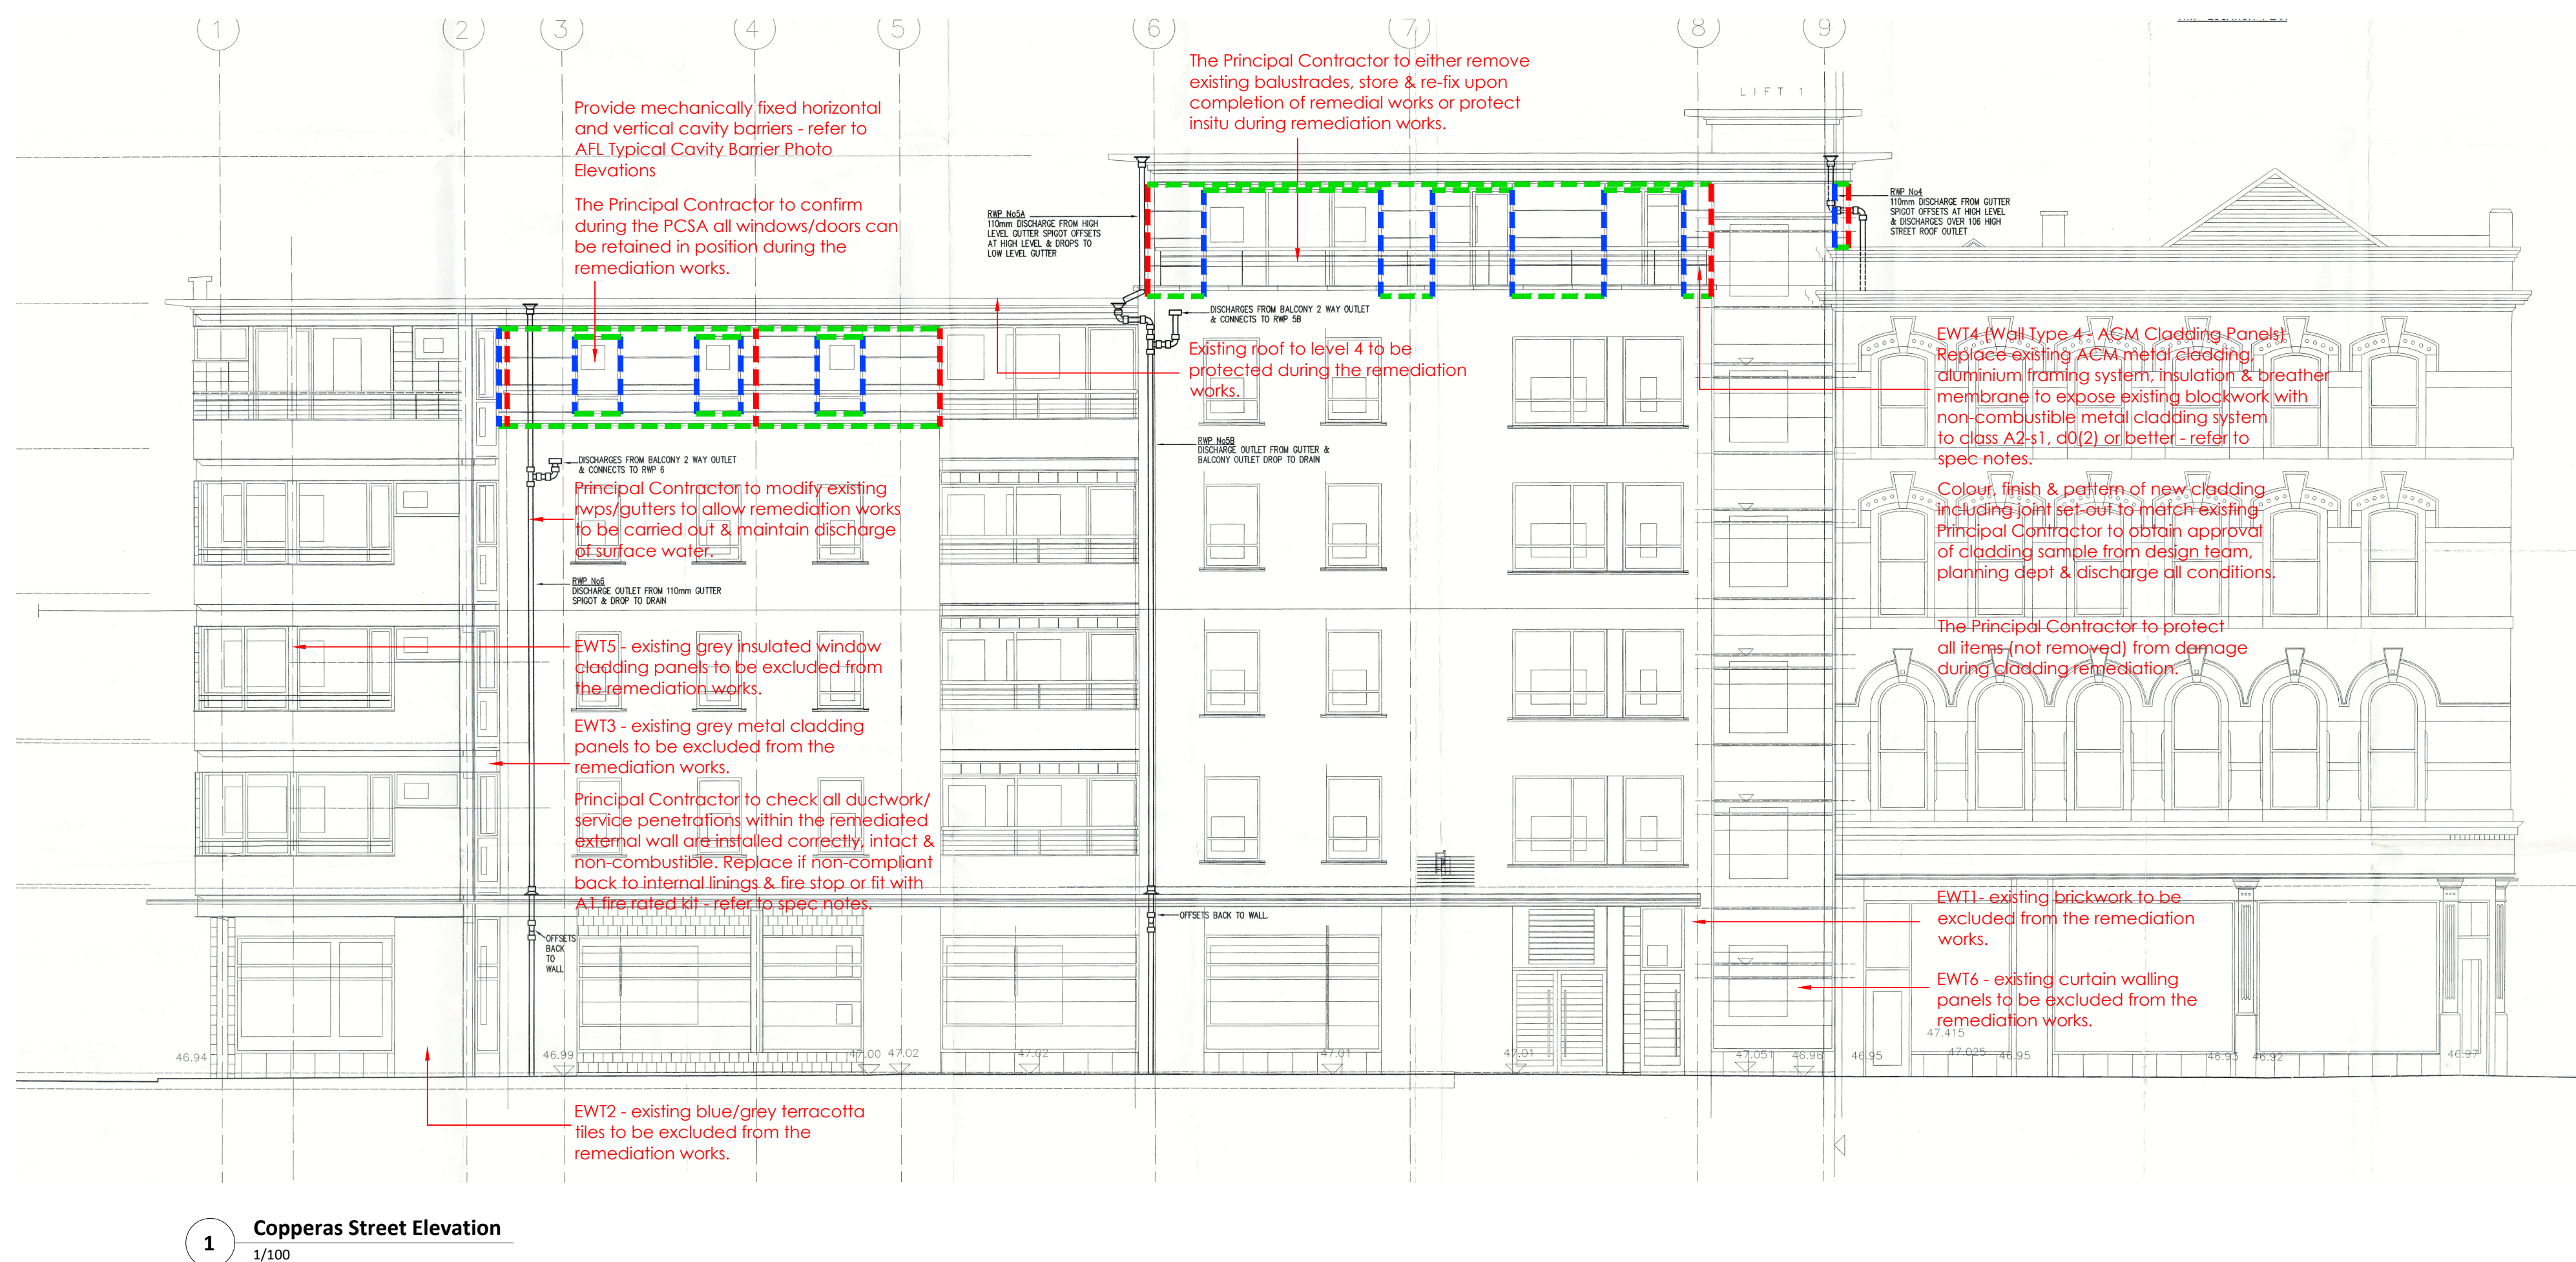

THE PRINCIPAL CONTRACTOR IS TO BASE THE TENDER ON THE ARCHITECTURAL DRAWINGS LISTED TOGETHER WITH THE FOLLOWING DOCUMENTS / INFORMATION:-

- OCTA FIRE RISK APPRAISAL FOR EXTERNAL WALLS (FRAEW) REF: OF00178
VERSION 01 DATED: 25/02/2025

THE PRINCIPAL CONTRACTOR IS TO PROVIDE FULL SPEC & WARRANTY FOR ALL WORKS. ALL MATERIALS TO HAVE REQUISITE TEST CERTIFICATION AND OR ASSESSMENTS - ALL TO BE AGREED WITH THE CLIENTS TEAM NAMELY:
PROJECT MANAGER
ARCHITECT
FIRE ENGINEER
BUILDING CONTROL/NHBC GUIDANCE
CLIENT INSURERS.

ALL PRIOR TO COMPLETING DESIGN, SUPPLY AND FIX.

ALL ASPECTS OF THE FACADE NOT HIGHLIGHTED IN THE WALL BUILD UP LEGEND - AFL PROPOSED PHOTOGRAPHIC ELEVATION DRAWINGS, ARE OMITTED FROM THE SCOPE OF WORKS AS PER OCTA EXTERNAL WALL ASSESSMENT AND THE APPROPRIATE FIRE STOPPING IS IN PLACE.

ALL PROPOSED CAVITY BARRIER DETAILS, SPECIFICATIONS & LOCATIONS TO BE CONFIRMED TO MEET THE DESIGN INTENT CRITERIA BY THE FIRE ENGINEER AS PART OF THE PCSA.

ALL AFL DRAWINGS ARE TO BE PRINTED IN COLOUR.

ALSO REFER TO THE FOLLOWING BS REFS:
BS EN 13823 - FIRE TEST METHOD (SBI TEST)
BS EN ISO 1182 - NON-COMBUSTIBILITY TEST

FIRE BARRIER LEGEND

CB1 - at compartment walls & closing the edges of cavity in rainscreen cladding:
Tenmat NVFB vertical cavity barrier compressed by 5mm within the cladding zone.

CB2 - Around openings in rainscreen cladding:
Tenmat VFB horizontal cavity barrier in cladding zone.
Tenmat NVFB cassette infill in the cladding panel.

CB3 - Around openings in rainscreen cladding:
Tenmat NVFB cavity closer compressed by 5mm within the cladding zone.

CB4 - Service Penetrations:
New Rytons A1 galvanised steel duct kit, intumescent sealant & weatherproof sealant to existing service penetrations within rainscreen cladding.
(Not indicated on the as-built drawings - Principal Contractor to carry out full survey of penetrations within the cladding to be remediated during the PCSA).

All cavity barriers to be mechanically fixed in line with manufacturers instructions.

NOTES
All dimensions and levels to be checked on site

Any discrepancies are to be reported to the Architect before any work commences

This drawing shall not be scaled to ascertain any dimensions, work to figured dimensions only

This drawing shall not be reproduced without express written permission from AFL Architects Ltd.

DISCLAIMER

When this drawing is issued in CAD, it is an uncontrolled version issued for information only, to enable the recipient to prepare their own documents/drawings for which they are solely responsible.

SOFTWARE INTEROPERABILITY

AFL prepared this drawing using Autodesk REVIT Architecture.

AFL does not accept liability for any loss or degradation of any information held in the drawing resulting from the translation from the original file format to any other file format or from the recipients reading of it in any other programme.

Refer to the following AFL drawing nos for scope of work to facade:

Existing Block Plan - 00100
Proposed Floor Plans - 20100 to 20105
Proposed Photographic Elevations - 20200 & 20201
Proposed Elevations - 20202
Proposed Typical Cavity Barrier Photo Elevations - 67200 & 67201
Proposed Cavity Barrier Elevations - 67202
Typical Existing & Proposed Wall Details - 21400 & 21401
Typical Cavity Barrier & Fire Stopping Locations - 67400

All cavity barriers are to be re-designed, located, specified & warranted by the manufacturer. All cavity barriers are to be fitted by an approved installer & in accordance with manufacturers spec / details. All AFL drawings are design intent only to maintain the outer face of the building & are based on site investigation by OCTA, site photos & limited existing drawings supplied by the client. All wall build-ups are to be verified on site by the Principal Contractor during the PCSA.

If no project specific wind load calculations are available, the Principal Contractor should supply appropriate localised wind load calculations in support of their proposals.

P2 30-10-25 SIB Stage 3 tender issue
P1 17-09-25 SIB First issue

rev no.	rev date	rev by	description

project
Agcroft House

location
Cladding Remediation Works

34 Copperas Street
Manchester M4 1HQ

Employer
Dooleys Construction Consultants
3000 Aviator Way
Manchester Business Park
Manchester
M22 5TG

client
Agcroft Investment Co Ltd
14-32 Hewitt Street
Manchester
M15 4GB


AFL Architects
1st Floor
St Georges House
56 Peter Street
Manchester M2 3NQ

t: +44(0)161 236 6263
f: +44(0)161 236 6484

w: www.afl-architects.com
e: mail@afl-uk.com

twitter.com/AFLArchitects

key plan

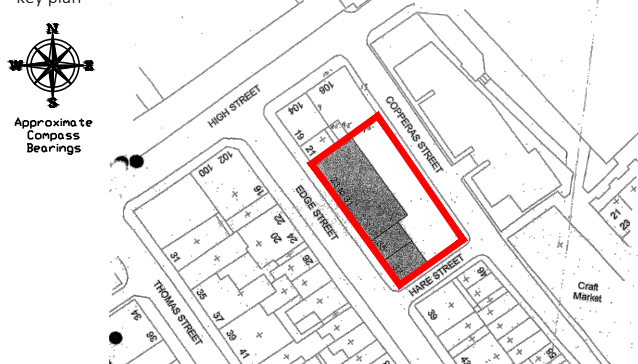

drawing title

Proposed Cavity Barrier Elevations
Scope of Works
PCSA

AFL job number scale @ A1 drawn SIB checked GR

254108 1/100 rev date 30-10-25

dwg purpose status rev

Stage 3 Tender **S4** **P2**

bim project origin zone level type role 5-digit no.

AH-AFL-ZZ-EL-DR-A-67202

No as-built drawings provided for Edge Street elevation - refer to proposed photographic elevations for information.

4 Edge Street Elevation
1/100